



City of Beaumont

550 E. 6th Street
Beaumont, CA 92223
(951) 769-8520
www.ci.beaumont.ca.us

Case No. <u>PW2024-0093</u>
Receipt No. <u>R01580940</u>
Fee \$ <u>3,915.00</u>
Date Paid <u>7/12/2024</u>

BOND EXONERATION APPLICATION

Bond Type: Performance Maintenance Final Monument Inspection Other: _____

1. Contact's Name Chris Carlaccini Phone 657-292-5781

2. Contact's Address 6440 Oak Canyon Suite 200 Irvine CA 92618
City/State/Zip


5. Contact's E-mail ccarlaccini@taylormorrison.com

3. Developer Name Taylor Morrison Phone 647-292-5781
(If corporation or partnership application must include names of principal officers or partners)

4. Developer Address 6440 Oak Canyon Suite 200
City/St/Zip

5. Description of Bonds (including Bond Number, Tract Map/Application number, Lot number, and description of improvements covered):
Olivewood Monumentation for TR 27971-10 (PA10) - Perf/Payment Bonds
Bond # CMS0348855

6. **CERTIFICATION OF ACCURACY AND COMPLETENESS:** I hereby certify that to the best of my knowledge the information in this application and all attached answers and exhibits are true, complete, and correct.

Chris Carlaccini  6/20/2024
Print Name and Sign – Contact/Applicant Date

7. Contractor shall indemnify, defend, and hold harmless the City and its officers, officials, employees and volunteers from and against any and all liability, loss, damage, expense, costs (including without limitation costs and fees of litigation) of every nature arising out of or in connection with contractor's performance of work hereunder or its failure to comply with any of its obligations for which this Bond exoneration is requested, except for such loss or damage which was caused by the active negligence of the City.

Chris Carlaccini  6/20/2024
Print Name and Sign – Contact/Applicant Date

8. Developer/Contractor has completed all the following items prior to requesting release or has included them in the application.

- Remove and replace concrete and AC as needed where lifting.
- Provide AC crack fill as needed. Crack fill/seal shall be hot asphaltic emulsion.
- Provide Type II slurry coat for all road surfaces.
- Restore/Verify pavement striping/markings.
- Restore/Verify blue dots and signage as needed.
- Clean and camera sewer. Provide report and video copy of camera survey.
- Provide all final geotechnical reports.
- Provide Engineers' certification for line and grade within Right-of-Way.
- Provide Landscape Architects Certification as required.

Chris Carlacini



6/20/2024

Print Name and Sign – Contact/Applicant

Date

RECORDING REQUESTED BY: CITY CLERK WHEN RECORDED RETURN TO: City Clerk City of Beaumont 550 E. 6th Street Beaumont, CA 92223	DOC # 2023-0305764 10/17/2023 03:52 PM Fees: \$0.00 Page 1 of 30 Recorded in Official Records County of Riverside Peter Aldana Assessor-County Clerk-Recorder **This document was electronically submitted to the County of Riverside for recording** Received by: TERESA #134
SPACE ABOVE THIS LINE FOR RECORDER'S USE	

**CITY OF BEAUMONT
SUBDIVISION IMPROVEMENT AGREEMENT
TRACT NO. 27971-10**

DATE OF AGREEMENT: <u>8/16/2022</u>		
NAME OF SUBDIVIDER: <u>RSI Communities-California LLC</u> , a <u>Delaware limited liability company</u> referred to as "Subdivider").		
NAME/NUMBER OF DEVELOPMENT: <u>Olivewood</u> subdivision consisting of <u>981</u> residential lots, <u>Parcel Map No. 34880</u> , originally approved on <u>July 16, 2014</u> , and Tentative Tract <u>27971</u> ("Tract" or "Tentative Tract Map"), originally approved on <u>December 16, 2014</u>		
FINAL TRACT MAP <u>27971-10</u> APPROVED ON <u>December 16, 2014</u> RECORDED ON <u>December 28, 201</u> AS INSTRUMENT NUMBER: <u>2014-0489252</u> ("Final Tract Map")		
PROPERTY SUBJECT TO AGREEMENT: The real property which is the subject of this Agreement is located in the City of Beaumont, County of Riverside and is described in Exhibit "A" attached hereto and incorporated herein (hereinafter the "Property").		
EST. TOTAL COST OF PUBLIC IMPROVEMENTS: \$ <u>NA</u> (see Exhibit "B")	EST. TOTAL COST OF PRIVATE IMPROVEMENTS: \$ <u>NA</u> (see Exhibit "B")	EST. TOTAL COST OF MONUMENTATION: \$ <u>51,000.00</u> (see Exhibit "B")
BOND NUMBERS: <u>CMS0348855</u>		
LETTER OF CREDIT NUMBERS: _____		
FINANCIAL INSTITUTION: <u>RLI Insurance Company</u>		

THIS SUBDIVISION IMPROVEMENT AGREEMENT ("Agreement") is made and entered into by and between the City of Beaumont, a California municipal corporation (hereinafter referred to as "City"), and RSI Communities-California LLC, a Delaware limited liability company, (hereinafter referred to as "Subdivider"). City and Subdivider are sometimes referred to hereinafter individually as a "Party", and collectively as the "Parties".

RECITALS

A. Subdivider is the owner of certain real property located in the City of Beaumont legally described on Exhibit "A" attached hereto and incorporated and made part of this Agreement by this reference (the "Property").

B. The conditions of approval of the above referenced Tentative Tract Map and any related entitlements, which are hereby incorporated herein by this reference, require that prior to the issuance of building permits, the Subdivider and the City shall enter into a subdivision improvement agreement, secured with sufficient security, as a guarantee of the construction and completion of all public and private improvements and land development work required by said conditions of approval and by the City subdivision laws and codes.

D. In consideration of the approval of a final map by the City Council, Subdivider desires to enter into this Agreement, whereby Subdivider promises to install and complete, at Subdivider's own expense, all the public improvement work required by City in connection with the proposed subdivisoion. Subdivider has secured this Agreement by improvement security required by the Subdivision Laws.

E. Improvement Plans (the "Plans") for the construction, installation, and completion of the public and private improvements are being or have been prepared by Subdivider and will be subject to approval by the Director of Engineering/Public Works ("City Engineer"). The City has adopted standards (hereinafter "Standards") for the construction and installation of improvements within the City, and the Plans will be prepared in conformance with the Standards in effect on the date of the approval of the Application. The Plans will be on file in the Office of the City Engineer and are incorporated into this Agreement by this reference as if set forth fully herein. All references in this Agreement to the Plans shall be deemed to include reference to any specifications for all of the improvements as approved by the City Engineer.

F. An estimate of the cost for construction of the public and private improvements and performing the land development work according to the Plans has been made and approved by the City Engineer. The estimated cost of these improvements is set forth on Page One (1) of this Agreement, and the basis for the estimate is attached hereto as Exhibit "B" and incorporated and made part of this Agreement by this reference. The amounts of the Improvement Securities required to be posted with this Agreement are also based upon the estimate in Exhibit "B".

G. For the purposes of this Agreement, the term "Public Improvements" means all those improvements within the Tract intended for transfer or conveyance to the City or other public agency. The estimated cost of their construction is included in the above estimate included herein as Exhibit "B".

NOW, THEREFORE, in consideration of the issuance of the Final Tract map, Subdivider and City hereby agree as follows:

1. Subdivider's Obligation to Construct Improvements.

(a) In constructing and installing the improvements, Subdivider shall comply with all of the requirements and conditions of approval of in the Tentative Tract Map, related entitlements as well as the provisions of the Municipal Code and Subdivision Laws.

(b) Subdivider shall complete, at its own expense, all the public and private improvements and related work on the Development, as required by the conditions of approval of the Tentative Map and related entitlements in conformance with the approved Plans and City Standards, including without limitation, those improvements set forth in Exhibit "B" (hereinafter collectively the "Improvements") within twenty-four (24) months of the date of this Agreement, unless a time extension is granted by the City as authorized by Section 20 of this Agreement.

(c) Notwithstanding the time limits specified in Section 1(b) above, no single family dwelling unit or group of units shall be given final inspection and clearance for occupancy by City unless the private and public streets providing access to and fronting such units are completed, the final lifts of pavement on the streets are in place, and all wet and dry utility services (e.g. sewer, water, electrical power, telephone, gas, etc.) to such units are in place and are operational.

(d) Subdivider shall furnish the necessary materials for completion of the Improvements in conformity with the Plans and City Standards.

(e) Subdivider shall acquire and dedicate, or pay the cost of acquisition by the City, of all right-of-way, easements and other interests in real property required for construction or installation of the Improvements, free and clear of all liens and encumbrances. Subdivider's obligations relating to acquisition by City of off-site rights-of-way, easements and other interests in real property shall be subject to a separate agreement between Subdivider and City. Subdivider shall also be responsible for obtaining any public or private drainage easements or authorizations therefor to accommodate the Development.

(f) Subdivider shall furnish and install all monuments, stakes and property corners on the lots and streets in the Property as specified on the final recorded tract maps for the Development in accordance with the provisions of the Subdivision Laws, and shall submit centerline tie sheets to City, within thirty (30) days after completion of the Improvements, or as specified in any separate monument agreement with the City, but in any event prior to their acceptance by the City.

2. Improvement Securities.

(a) Subdivider agrees to secure this Agreement with good and sufficient improvement securities in a form approved by the City Attorney (referred collectively hereinafter as "Improvement Securities" and individually as "Improvement Security") to guarantee the construction and completion of all the improvements in the Development. All such improvement securities shall be posted with the City prior to the City's final building inspection and issuance of a Certificate of Occupancy for any single family dwelling constructed by Subdivider, its agents, assigns or contractors, on any lot within the Development, as described in Exhibit "A". Said securities are estimated at this time in Exhibit "B" to be in the following amounts, and shall be for the purposes described as follows:

- (i) Fifty One thousand (\$51,000.00)
and 00/100 DOLLARS (\$XXX,XXX.XX) to ensure faithful performance of the construction and installation of the public and private Improvements required by this Agreement ("Performance Security"), which amount is 100% of the estimated cost of the Improvements as set forth in Exhibit "B"; and
- (ii) Fifty One thousand (\$51,000.00)
and 00/100 DOLLARS (\$XXX,XXX.XX) to secure payment to any contractor, subcontractor, persons renting equipment or furnishing labor materials for the Improvements required to be constructed or installed pursuant to this Agreement ("Labor & Materials Security"), which amount is one-hundred percent (100%) of the estimated cost of the Improvements; and
- (iii) NA and 00/100 DOLLARS (\$ XX,XXX.XX) in the form of a Warranty Bond or cash deposit with the City to guarantee or warranty the Improvement work done pursuant to this Agreement for a period of one (1) year following acceptance/certification thereof by City, against any defective work or labor done or defective materials furnished ("Warranty Security"). The Warranty Security is 10% of the estimated cost of the Performance Security amount described above, and such Warranty Security must be provided by Subdivider to City prior to the City's release of any bonds or Improvement Securities filed with this Agreement.
- (iv) NA and 00/100 Dollars (\$X,XXX.XX) in the form of a cash deposit, which is 100% of the estimated cost of setting all final subdivision monuments, boundary corners, front and rear lot corners and centerline ties not previously set or submitted on the lots and streets within the Property as described in Exhibit "A", and for the preparation and recordation of any related Certificate of Correction, as required by Section 66469 of the State Subdivision Map Act.

(b) The Improvement Securities required by this Agreement shall be kept on file with the City Clerk. If surety bonds are used, they must be issued by a surety company currently admitted to transact surety insurance business in California by the California Department of Insurance, with a Best's Insurance Guide rating of no less than A-. The terms of any documents evidencing such Improvement Securities as set forth in this Section 2 or

referenced on Page One (1) of this Agreement, are incorporated into this Agreement by this reference as if set forth fully herein. If any Improvement Security is replaced by another type or kind of approved Improvement Security, subject to the approval of the form thereof by the City Attorney, the replacement shall be filed with City Clerk and, upon filing, shall be deemed to have been made a part of and incorporated into this Agreement. Upon filing of a satisfactory replacement Improvement Security with the City Clerk, the former Improvement Security shall be released.

(c) Subdivider agrees to keep its Improvement Securities in full force and effect until they are reduced or released by City. If any Improvement Security provided by Subdivider is cancelled or terminated for any reason by the action of a surety, financial institution or other party, it shall be the responsibility of the Subdivider to immediately, upon written notice from City, provide a substitute Improvement Security which conforms to all the requirements of this Section 2 in the same amount or amounts.

(d) Any additions, changes, alterations, or modifications of this Agreement or to the Plans, Specifications and Improvements referred to herein, including any extension of time within which the work hereunder may be completed, shall not release or exonerate any surety or sureties on the Improvement Security given in connection with this Agreement.

3. Alterations to Improvement Plans; Modification of City Standards.

(a) Any changes, alterations or additions to the Plans or to the Improvements, not exceeding 10% of the original estimated cost of the Improvements, which are mutually agreed upon by City and Subdivider, shall not require Subdivider to increase any Improvement Securities provided under this Agreement. In the event such changes, alterations, or additions exceed 10% of the original estimated cost of the Improvements, Subdivider shall provide additional Performance Security as required by Section 2 of this Agreement for 100% of the total estimated cost of the Improvements as changed, altered, or amended, minus any completed partial releases allowed by Section 7 of this Agreement. Subdivider shall also provide additional Labor & Materials Security as required by Section 2 of this Agreement for 50 % of the total estimated cost of the Improvements as changed, altered, or amended.

(b) Subdivider shall construct all Improvements in a good and workman like manner and in accordance with the City Standards in effect as of the date of the Approval Action specified on Page One (1) hereof. The City reserves the right to modify the Standards applicable to the Subdivision and this Agreement, when necessary to protect the public safety or welfare or to comply with applicable State or Federal law or City zoning ordinances. If Subdivider requests and is granted an extension of time for completion of the Improvements, the City may apply the Standards in effect at the time the extension is granted.

4. Modification of Drainage Plan. Subdivider agrees that if during the course of construction and installation of Improvements it shall be determined by the City Engineer that revision of the

drainage plan is necessary in the public interest, it will undertake such design and construction changes as may be reasonable and as are indicated by the City Engineer and approved by City. Said changes, if any, shall be confined to the Property.

5. Reserved.

6. Inspections; Final Acceptance and Certification of Improvements.

(a) Subdivider shall at all times maintain proper facilities and safe access for inspection of the Improvements by City inspectors and to the shops wherein any work is in preparation.

(b) Upon completion of the Improvements covered in this Agreement, the Subdivider shall request a final inspection by the City Engineer or his/her authorized representative. Following receipt of such request, the City Engineer shall inspect the Improvements, make certain determinations and take certain actions as follows:

(i) If the City Engineer, or his/her authorized representative, determines that the Public Improvements requiring acceptance by another public agency have been completed in accordance with this Agreement, then the City Engineer shall request said agency to make a final inspection of such improvements and certify to the City that such improvements have been completed and installed to the satisfaction of said agency. Upon receipt of such certification, the City Engineer may release or reduce the securities held for such improvements. Any certification and/or acceptance of the Public Improvements shall not constitute a waiver of any defects by City.

(ii) For Improvements not requiring dedication to or acceptance by the a public agency (the "Private Improvements"), the City Engineer or his/her authorized representative shall inspect such improvements, and/or shall have the discretion to accept a certification from Subdivider's registered civil engineer stating that the Private Improvements have been completed in accordance with the approved Plans, City Standards and the Tentative Map. If the City Engineer, or his/her authorized representative, makes a finding, based on his/her own inspection (and/or any certification submitted by Subdivider's registered civil engineer) that the Private Improvements have been installed and constructed in accordance with the approved Plans, City Standards and the Tentative Map, the City Engineer shall recommend certification of the completion of the Private Improvements by placing an item on the next most convenient City Council agenda requesting certification and authorization to release the Improvement Securities. Said determination by the City Engineer and agendization of the certification and release shall not be unreasonably withheld or delayed.

(c) Subdivider shall bear all costs of inspection and certification of the Improvements.

7. Release of Improvement Securities.

(a) The Performance Security shall be fully released only upon the final completion and certification of all Private Improvements and Public Improvements. Partial releases may be permitted subject to the provisions of Subsections (a)(i) and (a)(ii) hereof. Upon final completion of the Public and Private Improvements under this Agreement, and after City Council acceptance/certification, the City shall file a Notice of Completion in accordance with the California Civil Code.

(i) The City Engineer may release a portion of the Performance Security, as work on the Improvements progresses, upon written application thereof by the Subdivider; provided, however, that no such release shall be considered by City for an amount less the cost estimate of the remaining work does not exceed twenty percent (20%) or less of the estimate of the total amount of work to be done as shown in Exhibit "B". Upon approval of a partial release or the reduction of Performance Security, the City shall not reduce such Performance Security to an amount less than two-hundred- percent (200%) of the value of the work remaining to be done. City and Subdivider agree that not more than two requests for reduction or partial release of Performance Security shall be considered between the start of construction and the completion and acceptance/certification of the Improvements by the City.

(ii) In no event shall the City Engineer authorize a release or reduction of the Performance Security which would reduce such security to an amount below that required to guarantee the completion of the Improvements and any other obligations imposed upon Subdivider by this Agreement.

(iii) No partial reduction or release of the Performance Security shall constitute or be construed as the City's acceptance or certification of any Improvements or related work. Such partial reductions or releases (if any) will merely reflect that a certain portion of the required work has been done.

(b) The Labor & Materials Security shall, ninety (90) days after the City's recordation of the Notice of Completion described in Subsection 7(a), be reduced to an amount equal to the total claimed by all claimants for whom liens have been filed and of which notice has been given to City, plus an amount reasonably determined by the City Engineer to be required to assure the performance of any other obligations secured by the Labor & Materials Security and to cover related legal costs. The balance shall be released upon the settlement of all claims and obligations for which the Labor & Materials Security was given. If no claims or liens have been filed and no notice has been given to City within said ninety (90) day period, then the Labor & Materials Security shall be released in full.

(c) The Warranty Security shall not be released until after the expiration of the one-year (1-year) warranty period and until any claims filed during the warranty period have been settled. As provided in Section 11, below, the warranty period shall not commence until final acceptance/certification of the Improvements and related work by the City Council.

(d) The Monumentation Security may be released in full by the City Engineer in accordance with the terms of the separate monument agreement with the City, or if there is none, upon submittal of the following:

(i) a written certification from the professional engineer or surveyor responsible for setting the monuments stating that all the final monuments for the Subdivision have been set in accordance with the Professional Land Surveyors Act and the Subdivision Map Act, and that the professional engineer or surveyor has been paid in full by Subdivider for such services; and

(ii) centerline tie sheets prepared in a manner acceptable to the City Engineer showing the locations of centerline monuments in existing public or private streets; and

(iii) any Record of Survey required by this Agreement has been filed with the County of Riverside and recorded.

(e) The City may retain from any Improvement Securities released an amount sufficient to cover costs and reasonable expenses and fees, including reasonable attorneys' fees.

8. Injury to Public Improvements, Public Property or Public Utilities Facilities.

Subdivider shall replace or repair, or cause the repair or replacement of any and all public or private improvements, public utilities facilities and survey or subdivision monuments which are destroyed or damaged as a result of any work under this Agreement. Subdivider shall bear the entire cost of replacement or repairs of any and all public or private improvements or utility property damaged or destroyed by reason of any work done under this Agreement, whether such property is owned by the United States or any agency thereof, or the State of California, or any agency or political subdivision thereof, or by the City or any public or private utility corporation or by any combination of such owners. Any repair or replacement shall be made to the reasonable satisfaction, and subject to the approval of the City Engineer and the owner of any such public or private improvement.

9. Permits. Subdivider shall, at Subdivider's expense, obtain all necessary permits and licenses for the construction and installation of the Improvements, give all necessary notices and pay all fees and taxes required by law.

10. Notice of Breach/Default of Subdivider.

(a) Default of Subdivider shall include, but not be limited to: (1) Subdivider's failure to timely complete construction of the Improvements; (2) Subdivider's unwarranted failure to timely cure any defect in the Improvements; (3) Subdivider's failure to perform substantial construction work for a period of twenty (20) consecutive calendar days after commencement of the work; (4) Subdivider's insolvency, appointment of a receiver, or the filing of any petition in bankruptcy either voluntary or involuntary which Subdivider fails to discharge within thirty (30) days; (5) the commencement of a foreclosure action against the

Property or a portion thereof, or any conveyance in lieu or in avoidance of foreclosure; (6) Subdivider's failure to keep the Improvement Securities in full force and effect; (7) Subdivider's failure to notify the City of any sale, transfer or other disposition of the Property to a purported new Subdivider; (8) Subdivider's failure to maintain insurance; or (9) the failure of Subdivider or Subdivider's contractors, subcontractors, agents or employees to comply with any other terms and provisions of this Agreement.

(b) In the event of any such default, the City Engineer or the City Council may serve written notice to Subdivider specifying in reasonable detail the nature of the default. Subdivider shall have thirty (30) days from receipt of said notice to cure the default; provided that, if the default is not reasonably susceptible to being cured within said thirty (30) days, Subdivider shall have a reasonable period of time to cure the default so long as Subdivider commences to cure the default within said thirty (30) days and diligently prosecutes the cure to completion.

(c) If following service of such written notice of default, Subdivider fails to cure or commence curing the default to the satisfaction of City within the cure period specified in Subsection 10(b), above, the City Engineer or the City Council may serve notice of Subdivider's default upon Subdivider and where applicable Subdivider's surety, or the holder(s) of any other Improvement Securities, in accordance with the notice provisions set forth in Section 22 of this Agreement.

(d) In the event of service of the notice of default specified in Subsection 10(c), above, Subdivider's surety shall have the duty to take over and complete the Improvements and related work required under this Agreement; provided; however, that if the surety, within twenty (20) days after the serving upon it of such notice of default, does not give the City written notice of its intention to take over the construction of said Improvements or does not, within ten (10) days after giving City notice of such election, commence to complete the Improvements, City may take over the work and prosecute the Improvements to completion, by contract or by any other method City may deem advisable, for the account and at the expense of Subdivider, and Subdivider's surety shall be liable to City for any costs or damages occasioned City thereby; and, in such event, City, without liability for so doing, may take possession of, and utilize in completing the Improvements, such materials, appliances, plant and other property belonging to Subdivider as may be on the site of the work and necessary for the completion of same.

(e) The City reserves to itself all remedies available to it at law or in equity for Subdivider's default under this Agreement. The City shall have the right, subject to this Section, to draw upon or utilize the appropriate Improvement Securities to mitigate City's damages in event of default by Subdivider. The right of City to draw upon or utilize the Improvement Securities is additional to and not in lieu of any other remedy available to City. It is specifically recognized that the estimated costs and amounts of Improvement Securities may not reflect the actual cost of construction or installation of the Improvements, and therefore, City's damages for Subdivider's default shall be measured by the actual cost of completing the required Improvements. The sums provided by the

Improvement Securities may be used by City for the completion of the Improvements in accordance with the Plans.

(f) Failure of Subdivider to comply with the terms of this Agreement, including but not limited to, construction of all the Improvements as set forth herein and as required by the Tentative Map, shall constitute Subdivider's consent to: (1) the filing by City of a notice of violation against all of the lots in the Subdivision; (2) withholding of Building permits, utility connections and/or Certificates of Occupancy. The remedies provided by this Subsection (f) are in addition to and not in lieu of any other remedies available to City at law or in equity. Subdivider agrees that the choice of remedy or remedies for Subdivider's default or breach shall be in the sole discretion of City.

(g) In the event that Subdivider fails to perform any obligation hereunder, Subdivider agrees to pay all costs and expenses incurred by City in securing performances of such obligations, including costs of suit and reasonable attorney's fees.

(h) The failure of City to take an enforcement action with respect to a default, or to declare a default or breach, shall not be construed as a waiver of that default or breach, or of any subsequent default or breach of Subdivider. Any failure by the City to enforce any provision of this Agreement shall not be construed as a waiver of the right to compel enforcement of such provision(s) and further shall not act to release any surety from its obligations under this Agreement.

11. Warranty.

(a) For a period of one (1) year after final acceptance/certification by the City Council of the Improvements, Subdivider shall guarantee or warranty all the Improvements against any defective work or labor done or defective materials furnished. If within the warranty period any work relating to the Improvements or any part of thereof furnished, installed, constructed or caused to be done, furnished, installed or constructed by Subdivider fails to fulfill any of the requirements of this Agreement or the Plans, Subdivider shall without delay and without any cost to City, commence to repair or replace or reconstruct any defective or otherwise unsatisfactory part or parts of the work or structure within thirty (30) days of receiving written notice from City of the defect and diligently prosecute the repair or replacement work to completion.

(b) Should Subdivider fail to act promptly or in accordance with the repair/replacement requirements set forth herein, Subdivider hereby authorizes City, at City's option, to perform the repair/replacement work twenty (20) days after mailing written notice to Subdivider and to Subdivider's surety, and Subdivider agrees to pay City for the cost of such work.

(c) Should the City determine that an emergency or a threat to the public safety and welfare exists from the condition of the Improvements which require repairs, replacements or remedial measures to be made before Subdivider can be notified, City may, in its sole

discretion, make the necessary repairs or replacements or perform the necessary work and Subdivider shall pay to City the cost of such repairs.

12. Subdivider Not Agent of City. Neither Subdivider nor any of Subdivider's agents, officers, employees, or contractors are or shall be considered to be agents of City in connection with the performance of Subdivider's obligations under this Agreement.

13. Injury to Improvement Work; Risk of Loss. Until such time as the Public Improvements are accepted by City, Subdivider shall be responsible for and bear the risk of loss to any of the Public Improvements constructed or installed and shall be responsible for the care, maintenance of and any damage to such Public Improvements. Neither City, nor any of its agents, officers or employees shall be liable or responsible for any accident, loss or damage, regardless of cause, happening or occurring to the Public Improvements specified in this Agreement prior to the completion and acceptance of the Public Improvements by City. All such risks shall be the responsibility of and are hereby assumed by Subdivider. Subdivider is responsible for and shall bear the risk of loss for all Private Improvements at all times.

14. Other Agreements. Nothing contained in this Agreement shall preclude City from expending monies pursuant to agreements concurrently or previously executed between the Parties, or from entering into agreements with other Subdividers for the apportionment of costs of water and sewer mains, or other improvements, pursuant to the provisions of City ordinances providing therefor, nor shall anything in this Agreement commit to any such apportionment.

15. Subdivider's Obligation to Warn Public During Construction. Until final acceptance/certification of the Public Improvements pursuant to Section 6(b)(i), and final certification of construction of the Private Improvements pursuant to Section 6(b)(ii), Subdivider shall give good and adequate warning to the public of each and every dangerous condition existent in said Improvements, and will take all reasonable actions to protect the public from such dangerous conditions in, on or around the work site.

16. Vesting of Ownership. Upon acceptance of the Public Improvements and related work on behalf of the City, and after recordation of the Notice of Completion, ownership of the Public Improvements constructed within the Private streets in the Development shall vest in the name of the City, or applicable government agency or utility company, and any improvement constructed on any public street pursuant to this Agreement shall vest in City.

17. Indemnity/Hold Harmless.

(a) Neither the City, nor any official, officer, employee, contractor or agent thereof, shall be liable for any injury to persons or property occasioned by reason of the acts or omissions of Subdivider, its agents, subcontractors or employees in the performance of this Agreement. Subdivider hereby agrees to, and shall defend and hold harmless City, its elective and appointive boards, commissions and officers, and its agents, contractors and

employees from and against any and all claims, demands, causes of action, damages, costs, expenses, actual attorneys' fees, consultant's fees, expert's fees, losses or liability, in law or in equity, of every kind and nature whatsoever arising out of or in connection with Subdivider's operations, or any subcontractor's operations, to be performed under this Agreement for Subdivider's or subcontractor's tort negligence including active or passive, or strict negligence, including but not limited to personal injury including, but not limited to bodily injury, emotional injury, sickness or disease, or death to persons and/or damage to property of anyone, including loss of use thereof, caused or alleged to be caused by any act or omission of Subdivider or any subcontractor, or anyone directly or indirectly employed by any of them or anyone for the full period of time allowed by law, with the exception of the sole negligence or willful misconduct of City.

(b) Subdivider's indemnity, defense and hold harmless obligations under this Section 17 are not conditioned or dependent upon whether City, or its elective and appointive boards, commissions and officers, or its agents, contractors and employees, prepared, supplied or reviewed any Plans or related specifications in connection with the Improvements, or whether City or Subdivider has insurance or other indemnification covering any of these matters.

(c) Subdivider's obligation to indemnify, hold harmless and defend City shall extend to injuries to persons and damages to or alleged taking of property resulting from the design or construction of the Improvements. City's acceptance and/or certification of the Improvements shall not constitute an assumption by City of any responsibility or liability for any damage or alleged taking of property referenced herein. City shall not be responsible or liable for the design or construction of the Improvements constructed or installed pursuant to the Plans, unless the particular Improvement design was required by City over the written objection of Subdivider, which objection stated that the Improvement design was potentially dangerous or defective and set forth a safe and feasible alternative design. After City's acceptance/certification of the Improvements, Subdivider shall remain obligated to correct or eliminate all dangerous conditions caused by defects in design or construction; provided, however, that the Subdivider shall not be responsible for routine maintenance. Subdivider acknowledges and agrees that Subdivider shall be responsible and liable for the design and construction of the Improvements and other work done pursuant to this Agreement, and except as may be provided above, City shall not be liable for any acts or omissions in approving, reviewing, checking, correcting or modifying any Plans, or in inspecting, reviewing or approving any work or construction of Improvements. Subdivider's Improvement Securities shall not be required to secure Subdivider's obligations under this Section 17.

18. Sale or Disposition of Subdivision; Assignment.

(a) Subdivider acknowledges and agrees that sale, transfer or other disposition of the Property prior to completion of the Improvements required hereunder will not relieve Subdivider from the obligations set forth in this Agreement, and Subdivider shall be required to notify City sixty (60) days in advance of any sale or transfer of ownership of the Property or any proposed assignment of this Agreement. If Subdivider sells or otherwise

transfers the Property to any other person or entity prior to final completion of the Improvements, or wishes to assign this Agreement, Subdivider may request a novation of this Agreement and a substitution of Improvement Securities by the new owner or proposed assignee (hereinafter collectively for purposes of this Section, "Successor"). Subdivider shall be required to provide any documentation reasonably required by City to determine the appropriateness of any proposed Successor.

(b) Any proposed Successor must demonstrate to the City its ability to perform and complete the obligations of Subdivider under this Agreement, as determined by objective standards of financial capability, creditworthiness and experience required for such performance, and the City shall have the right to compel the Successor to disclose all documents, information and other material which, in City's sole reasonable discretion, may establish or tend to establish that the proposed Successor meets the standards specified herein. Following approval by City and full execution of a novation (or other such release or assignment and assumption agreement(s) entered into by Subdivider, Successor and City), posting of satisfactory Improvement Securities and submission of required insurance by Successor, City shall release or reduce the securities posted by Subdivider in accordance with the provisions of such novation and release Subdivider of its obligations under this Agreement. Nothing in the novation (or other such release or assignment and assumption agreement entered into by Subdivider, Successor and City) shall relieve Subdivider of its obligations under any other Section of this Agreement for work or Improvements performed by Subdivider prior to the novation.

19. Time of the Essence. Time is of the essence in this Agreement.

20. Time for Completion of Improvements; Extensions.

(a) Subdivider shall commence and diligently prosecute to completion construction of all the Improvements required by this Agreement. The time for completion of the Improvements as specified in Subsection 1(b) of this Agreement may be extended as permitted by City ordinance. The City Manager may grant an extension of time for such period as may be in the public interest upon the showing of the Subdivider of good cause. Any such extension granted shall be subject to the limitations and conditions set forth in Subsections 20(b) and (c), below, and shall be made by a writing executed by the in a form as approved by the City Attorney.

(b) Any such extension may be granted without notice to Subdivider's surety and shall not affect the validity of this Agreement or release the surety or sureties on any Improvement Securities given for this Agreement. However, City reserves the right to require as part of any extension amendment a written assurance from the surety acceptable to the City Attorney that the Improvement Securities required by Section 2 of this Agreement shall remain enforceable throughout the term of any extension.

(c) The City Manager shall be the sole and final judge as to whether or not good cause has been shown to entitle Subdivider to an extension. In addition, the time for completion of the Improvements shall be extended for any delay resulting from an act of City, or from

an act of God, which Subdivider could not have reasonably foreseen, or by storm or inclement weather which prevents the conducting of work, or by strikes, boycotts, similar actions by employees or labor organizations, which prevent the conducting of work, and which were not caused by or contributed to by Subdivider, provided that Subdivider provides City with written notice of the delaying event within fifteen (15) days of the commencement of the delay. In the event of such delaying event, Subdivider shall use all reasonable efforts to remedy same and resume completion of the Improvements as promptly as practicable.

(d) As a condition of granting an extension of time to complete the Improvements required by this Agreement, the City Manager may require Subdivider to furnish new or additional Improvement Securities guaranteeing performance of this Agreement as extended in an increased amount as necessary to compensate for any increase in construction costs as determined by the City Engineer.

21. Notice. All notices required by or provided for under this Agreement shall be in writing and delivered in person or sent by certified or registered mail, postage prepaid and addressed as provided in this Section. Notice shall be effective on the date it is delivered in person, or, if mailed, on the date of deposit in the United States Mail. Notices shall be addressed as follows unless a written change of address is filed with City:

Notice to City:	City of Beaumont 550 E. 6th Street Beaumont, CA 92223
Attn: City Manager	
With a Copy to:	John Pinkney, Esq. SBEMP 1800 East Tahquitz Canyon Way Palm Springs, CA 92262

Notice to Subdivider:

22. Severability. The provisions of this Agreement are severable. If any portion of this Agreement is held invalid by a court of competent jurisdiction, the remainder of the Agreement shall remain in full force and effect unless amended or modified in writing by the mutual consent of the Parties.

23. Captions. The captions of this Agreement are for convenience and reference only and shall not define, explain, modify, limit, exemplify, or aid in the interpretation, construction or meaning of any provisions of this Agreement.

24. Insurance.

(a) Subdivider shall, at all times during the construction of the Improvements, obtain, carry, maintain, and keep in full force and effect, at its sole cost and expense, policies of insurance of the types and in at least the minimum amounts described below:

(i) Commercial General Liability policy with a minimum combined single limit of One Million Dollars (\$1,000,000) for each occurrence and Two Million Dollars (\$2,000,000) in the aggregate for bodily injury, death, personal injury and property damage arising out of or in connection with the activities of the Subdivider and its contractors and subcontractors in performance of the work under this Agreement. Coverage shall be at least as broad as Insurance Services Office Commercial General Liability coverage (Occurrence Form CG 0001) and shall, in addition to the other coverages specified in this subsection, include coverage for independent contractors, ongoing operations, products and completed operations, contractual liability and personal and advertising injury.

(ii) Commercial Vehicle/Automotive Liability policy covering personal injury and property damage, with minimum limits of One Million Dollars (\$1,000,000) per occurrence, combined single limit, covering any vehicle utilized by Subdivider, its officers, agents, employees, subcontractors or independent contractors in performing the work required by this Agreement.

(iii) Workers' Compensation and Employer's Liability policy for all Subdivider's employees, with Workers' Compensation limits as required by State law and Employer's Liability coverage of \$1,000,000 per accident for bodily injury or disease. In case any work is sublet, Subdivider shall require any contractor or subcontractor similarly to provide Workers' Compensation and Employer's Liability Insurance for all contractor's or subcontractor's employees, unless such employees are covered by the protection afforded by Subdivider.

(1) In case any class of employees engaged in work under this Agreement at the work site(s) is not protected under any Workers' Compensation law, Subdivider shall provide and shall cause each contractor or subcontractor to provide, adequate insurance for the protection of employees not otherwise protected.

(2) Subdivider hereby indemnifies City for any damages or claims resulting from failure of either Subdivider or any contractor or subcontractor to take out or maintain such liability or Workers' Compensation insurance.

(b) Insurer Rating; Acceptability. Except as set forth otherwise herein, the policies required by this Section shall be issued by a California-admitted insurer with a rating of at least a A-; VII in the latest edition of Best's Insurance Guide. A Commercial General Liability policy issued by an insurer that is on the California Department of Insurance's List of Approved Surplus Line Insurers ("LASLI") will be acceptable, if no coverage from an

admitted insurer can be obtained by Subdivider, and further provided that such insurer maintains a Best's rating of at least "A-; X" and remains on the LASLI during the term hereof. Workers' Compensation coverage issued by the State Compensation Insurance Fund shall be acceptable if no other coverage can be obtained by Subdivider, and further provided such insurer remains admitted in California and is otherwise financially acceptable to City.

(c) Deductibles. Any deductibles or self-insured retentions must be declared in writing by Subdivider to City and subsequently approved by City prior to its execution of this Agreement and prior to commencement of any work hereunder. At City's option, Subdivider shall either reduce or eliminate the deductibles or self-insured retentions with respect to City, or Subdivider shall procure a bond guaranteeing payment of losses and expenses.

(d) Certificates and Endorsements Verification. Subdivider shall submit to the City original certificates of insurance and endorsements evidencing the coverages required by this Section. The certificates and endorsements for each insurance policy shall be signed by a person authorized by that insurer to bind coverage on its behalf. The City reserves the right to require complete, certified copies of all required insurance policies at any time and/or to require Subdivider to provide reports or status updates to evidence compliance of its contractors and subcontractors with the provisions of this Section.

(e) Required Endorsements.

(i) The Commercial General Liability and Commercial Vehicle/Automotive Liability policies are to contain or be endorsed to contain the following provisions:

(1) Additional Insureds. The City of Beaumont, its officials, officers, employees, agents and independent contractors shall be named as additional insureds with respect to liability arising out of automobiles owned, leased, hired or borrowed by or on behalf of the Subdivider; and with respect to liability arising out of work or operations performed by or on behalf of the Subdivider including materials, parts or equipment furnished in connection with such work or operations.

(2) Primary Insurance. For any claims related to this project, the Subdivider's insurance coverage shall be primary insurance as respects the City of Beaumont, its officials, officers, employees, agents and independent contractors. Any insurance or self-insurance maintained by the City of Beaumont, its officials, officers, employees, agents and independent contractors shall be excess of the Subdivider's insurance and shall not contribute with it. This endorsement is not applicable to the Commercial Vehicle/Automotive Liability Policy.

(3) Waiver of Subrogation. Endorsements waiving all rights of subrogation against the City of Beaumont, its officials, officers, employees, agents and independent contractors shall be provided.

(ii) The Workers' Compensation policy shall be endorsed to waive all rights of subrogation against the City of Beaumont, its officials, officers, employees, agents and independent contractors.

(f) Other Insurance Requirements. All policies required under this Agreement shall contain provisions stating that such policies cannot be canceled or reduced except on at least thirty (30) days prior written notice to Subdivider (ten (10) days' notice for cancellation due to non-payment). Subdivider further agrees to: (1) provide to City copies of any notices relating to cancellation or reduction of insurance within two (2) days of receipt; and (2) cause all certificates of insurance to include language indicating that the issuers or producers of such policies will endeavor to provide copies of any such notices directly to City.

(g) Commencement of Work. Subdivider shall not commence work under this Agreement until Subdivider has obtained all insurance required pursuant to this Section, and such insurance has been obtained by Subdivider and approved by City; nor shall Subdivider allow any contractor or subcontractor to commence work on the Improvements until all similar insurance required of the contractor or subcontractor has been obtained. Certificates, endorsements, and where applicable, full copies of policies shall be maintained on file with the City Clerk.

(h) Higher Limits. If Subdivider maintains higher limits than the minimums specified in this Section 25, the City requires and shall be entitled to coverage for the higher limits maintained by Subdivider. Any available insurance proceeds in excess of the specified minimum limits of insurance and coverage shall be available to the City.

25. Attorneys' Fees. In the event any action at law or in equity is brought to enforce the terms of this Agreement, the prevailing Party shall be entitled to litigation costs and reasonable attorneys' fees.

26. Incorporation of Recitals. The Recitals to this Agreement are hereby incorporated into in the terms of this Agreement.

27. Entire Agreement. This Agreement constitutes the entire agreement of the Parties and supersedes any prior written or oral agreements between them with respect to the subject matter hereof. All modifications, amendments, or waivers of the terms of this Agreement must be in writing and signed by the appropriate representatives of the Parties.

28. Governing Law; Venue. This Agreement shall be governed by and interpreted in accordance with the laws of the State of California. In the event that suit shall be brought by either Party to this contract, the Parties agree that venue shall be exclusively vested in the State courts

of the County of Riverside, California or where appropriate, in the United States District Court, Southern District of California, Riverside, California.

29. Runs with the Land; Recordation.

(a) The Parties agree that the terms and provisions set forth in this Agreement shall be deemed provisions, terms and/or covenants running with the Property in accordance with applicable law, including without limitation, California Civil Code section 1468, and shall pass to and be binding upon the heirs, successors and assigns of the Parties to this Agreement, and on any successor owner of the Property.

(b) The provisions of Subsection 29(a) notwithstanding, Subdivider shall remain jointly and severally liable with its heirs, successors, assigns or successor owners of the Property for the responsibilities and liabilities imposed by this Agreement unless a novation or assignment agreement is executed in accordance with the provisions of Section 18 of this Agreement.

(c) Upon execution, this Agreement shall be recorded in the Official Records of Riverside County, and by such recordation, it is the intention of the Parties to give notice to and bind their successors, heirs and assigns hereto.

30. Authority of Executing Parties. Each person executing this Agreement on behalf of a Party represents and warrants that such person is duly and validly authorized to do so all behalf of the entity it purports to bind and that he/she is authorized to enter into contracts on behalf of Subdivider. The undersigned, on behalf of Subdivider, binds Subdivider, its partners, successors, executors, administrators, and assigns with respect to the terms and provisions of this Agreement.

IN WITNESS WHEREOF, this Agreement is executed by the Parties hereto on the date above first written.


Subdivider:

City:

CITY OF BEAUMONT
a Municipal Corporation


RSI Communities-California LLC

By: _____

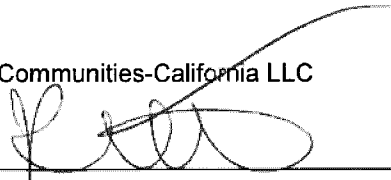

Kimberly Kraft
Authorized Signatory


By: _____

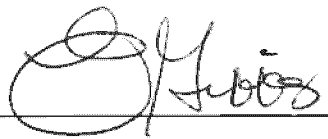

City Manager


ATTEST:

Deputy

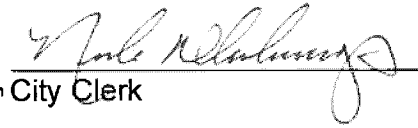


City Clerk

APPROVED AS TO FORM:

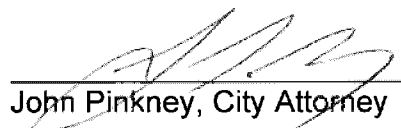

John Pinkney, City Attorney

APPROVED AS TO CONTENT:

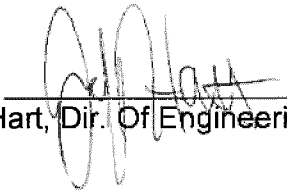

Jeff Hart, Dir. Of Engineering/Public Works

Attachments: Exhibit A
Exhibit B

Legal description of Property
Cost estimates

(Proper Notarization of Subdivider's Signature is required and shall be attached)

ACKNOWLEDGMENT

A notary public or other officer completing this certificate verifies only the identity of the individual who signed the document to which this certificate is attached, and not the truthfulness, accuracy, or validity of that document.


State of California
County of Orange

On August 16, 2022 before me, Crystal Villalobos, Notary Public
(insert name and title of the officer)

personally appeared Kimberly Kraft,
who proved to me on the basis of satisfactory evidence to be the person(s) whose name(s) is/are subscribed to the within instrument and acknowledged to me that he/she/they executed the same in his/her/their authorized capacity(ies), and that by his/her/their signature(s) on the instrument the person(s), or the entity upon behalf of which the person(s) acted, executed the instrument.

I certify under PENALTY OF PERJURY under the laws of the State of California that the foregoing paragraph is true and correct.

WITNESS my hand and official seal.

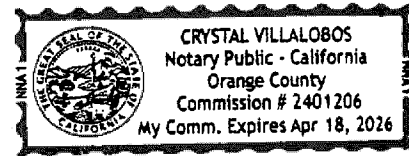

Signature *[Handwritten Signature]* (Seal)

Bond Number: CMS0348855
 Premium: \$179.00

PW #:
 File #: 2042 495810

PERFORMANCE BOND

WHEREAS, the City of Beaumont, State of California, and RSI Communities-California LLC (hereinafter designated as "Principal") have entered into Agreement To Provide Security For Improvements For Tract Map Or Parcel Map Or Plot Plan, dated _____, 20____, whereby Principal agrees to install and complete certain designated public improvements itemized and described on Tract Map, Parcel Map or Plot Plan No. 27971-10 , which is hereby incorporated herein and made a part hereof; and

WHEREAS, Principal is required under the terms of the said agreement to furnish a bond for the faithful performance of said agreement.

NOW, THEREFORE, we, the Principal and RLI Insurance Company, as Surety, are held and firmly bound unto the City of Beaumont (hereinafter called "City"), in the penal sum of Fifty One Thousand and no/100 dollars (\$ 51,000.00) lawful money of the United States, for the payment of which sum well and truly to be made, we bind ourselves, our heirs, successors, executors and administrators, jointly and severally, firmly by these presents.

The condition of this obligation is such that if the above bounded Principal, his or its heirs, executors, administrators, successors or assigns, shall in all things stand to and abide by, and well and truly keep and perform the covenants, conditions and provisions in the said agreement and any alteration thereof made as therein provided, on his or their part to be kept and performed at the time and in the manner therein specified, and in all respects according to their true intent and meaning, and shall indemnify and save harmless the City, its officers, agents and employees as therein stipulated, then this obligation shall become null and void; otherwise it shall be and remain in full force and effect.

As part of the obligation secured hereby and in addition to the face amount specified therefor, there shall be included costs and reasonable expenses and fees, including reasonable attorney's fees, incurred by the City in successfully enforcing such obligation, all to be taxed as costs and included in any judgment therein rendered.

The Surety hereby stipulates and agrees that no change, extension of time, alteration or addition to the terms of the agreement or to the work to be performed thereunder or the specifications accompanying the same shall in any way affect its obligations on this bond, and it does hereby waive notice of any such change, extension of time, alteration or addition to the terms of the agreement or to the work or to the specifications.

[signatures on following page]

IN WITNESS WHEREOF, this instrument has been duly executed by the Principal and Surety above named, on the 15th of August, 2022.

(Seal)

(Seal)

RLI Insurance Company

RSI Communities-California LLC

By: **SURETY**
D. Garcia

By: **PRINCIPAL**
[Signature]

Name: D. Garcia

Name: Kimberly Kraft

Title: Attorney-In-Fact

Title: authorized signatory

Address: 19800 MacArthur Blvd. Ste 1250

By: [Signature]

Irvine, CA 92612

Name: [Signature]

Title: [Signature]

Address: 6440 Oak Canyon
#200 Irvine, CA 92618



ALL SIGNATURES MUST BE ACKNOWLEDGED BEFORE A NOTARY PUBLIC

ACKNOWLEDGMENT

A notary public or other officer completing this certificate verifies only the identity of the individual who signed the document to which this certificate is attached, and not the truthfulness, accuracy, or validity of that document.


State of California
County of Orange)

On August 16, 2022 before me, Crystal Villalobos, Notary Public
(insert name and title of the officer)

personally appeared Kimberly Kraft
who proved to me on the basis of satisfactory evidence to be the person(s) whose name(s) is/are subscribed to the within instrument and acknowledged to me that he/she/they executed the same in his/her/their authorized capacity(ies), and that by his/her/their signature(s) on the instrument the person(s), or the entity upon behalf of which the person(s) acted, executed the instrument.

I certify under PENALTY OF PERJURY under the laws of the State of California that the foregoing paragraph is true and correct.

WITNESS my hand and official seal.

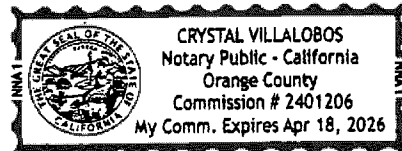

Signature *Crystal Villalobos* (Seal)

CALIFORNIA ALL-PURPOSE ACKNOWLEDGMENT

A Notary Public or other officer completing this certificate verifies only the identity of the individual who signed the document to which this certificate is attached, and not the truthfulness, accuracy, or validity of that document.


State of California


County of Los Angeles

On AUG 15 2022 before me, Edward C. Spector, Notary Public, personally appeared D. Garcia who proved to me on the basis of satisfactory evidence to be the person(s) whose name(s) is/are subscribed to the within instrument and acknowledgment to me that he/she/they executed the same in ~~his/her/their~~ authorized capacity(ies), and that by ~~his/her/their~~ signature(s) on the instrument the person(s), or the entity upon behalf of which the person(s) acted, executed the instrument.

I certify under PENALTY OF PERJURY under the laws of the State of California that the foregoing paragraph is true and correct.

Witness my hand and official seal.

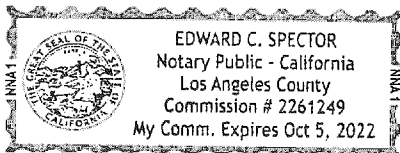

Signature 
Edward C. Spector, Notary Public

POWER OF ATTORNEY

RLI Insurance Company Contractors Bonding and Insurance Company

9025 N. Lindbergh Dr. Peoria, IL 61615
Phone: 800-645-2402

Know All Men by These Presents:

That this Power of Attorney is not valid or in effect unless attached to the bond which it authorizes executed, but may be detached by the approving officer if desired.

That RLI Insurance Company and/or Contractors Bonding and Insurance Company, each an Illinois corporation, (separately and together, the "Company") do hereby make, constitute and appoint:

Janina Monroe, Michelle Haase, Timothy Noonan, Adriana Valenzuela, Jennifer Ochs, Martha Barreras, Sarah Campbell, Rhonda Larson, Charles R. Teter, III, B. Aleman, Erin Brown, D. Garcia, Simone Gerhard, Edward C. Spector, Ethan Spector, Marina Tapia, KD Wapato, Rachel A. Mullen, Lisa Marie Saumur, jointly or severally

in the City of Los Angeles, State of California its true and lawful Agent(s) and Attorney(s) in Fact, with full power and authority hereby conferred, to sign, execute, acknowledge and deliver for and on its behalf as Surety, in general, any and all bonds and undertakings in an amount not to exceed Twenty Five Million Dollars (\$25,000,000.00) for any single obligation.

The acknowledgment and execution of such bond by the said Attorney in Fact shall be as binding upon the Company as if such bond had been executed and acknowledged by the regularly elected officers of the Company.

RLI Insurance Company and/or Contractors Bonding and Insurance Company, as applicable, have each further certified that the following is a true and exact copy of a Resolution adopted by the Board of Directors of each such corporation, and is now in force, to-wit:

"All bonds, policies, undertakings, Powers of Attorney or other obligations of the corporation shall be executed in the corporate name of the Company by the President, Secretary, any Assistant Secretary, Treasurer, or any Vice President, or by such other officers as the Board of Directors may authorize. The President, any Vice President, Secretary, any Assistant Secretary, or the Treasurer may appoint Attorneys in Fact or Agents who shall have authority to issue bonds, policies or undertakings in the name of the Company. The corporate seal is not necessary for the validity of any bonds, policies, undertakings, Powers of Attorney or other obligations of the corporation. The signature of any such officer and the corporate seal may be printed by facsimile."

IN WITNESS WHEREOF, the RLI Insurance Company and/or Contractors Bonding and Insurance Company, as applicable, have caused these presents to be executed by its respective Vice President with its corporate seal affixed this 21st day of February, 2022.



RLI Insurance Company
Contractors Bonding and Insurance Company

By: Barton W. Davis Vice President

State of Illinois }
County of Peoria } SS


CERTIFICATE

On this 21st day of February, 2022, before me, a Notary Public, personally appeared Barton W. Davis, who being by me duly sworn, acknowledged that he signed the above Power of Attorney as the aforesaid officer of the RLI Insurance Company and/or Contractors Bonding and Insurance Company and acknowledged said instrument to be the voluntary act and deed of said corporation.

I, the undersigned officer of RLI Insurance Company and/or Contractors Bonding and Insurance Company, do hereby certify that the attached Power of Attorney is in full force and effect and is irrevocable; and furthermore, that the Resolution of the Company as set forth in the Power of Attorney, is now in force. In testimony whereof, I have hereunto set my hand and the seal of the RLI Insurance Company and/or Contractors Bonding and Insurance Company this 15th day of August, 2022.

By: Catherine D. Glover
Catherine D. Glover Notary Public

RLI Insurance Company
Contractors Bonding and Insurance Company
By: Jeffrey D. Fick Corporate Secretary

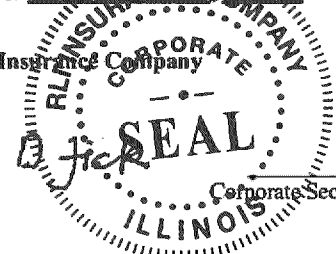

Bond Number: CMS0348855
Premium: included in performance bond

PAYMENT BOND

WHEREAS, the City Council of the City of Beaumont, State of California, and RSI Communities-California LLC _____ (hereafter designated as "the Principal") have entered into Agreement To Provide Security For Improvements For Tract Map Or Parcel Map Or Plot Plan, 27971-10 dated _____, 20__, whereby Principal agrees to install and complete certain designated public improvements which is hereby incorporated herein and made a part hereof; and

WHEREAS, under the terms of the said agreement, the Principal is required before entering upon the performance of the work, to file a good and sufficient payment bond with the City of Beaumont to secure the claims to which reference is made in Title 3 (commencing with Section 9000, et seq.) of Part 6 of Division 4 of the Civil Code of the State of California.

NOW, THEREFORE, the Principal and the undersigned as corporate surety, are held firmly bound unto the City of Beaumont and all contractors, subcontractors, laborers, materialmen, and other persons employed in the performance of the said agreement and referred to at Title 3 (commencing with Section 9000, et seq.) of Part 6 of Division 4 of the Civil Code in the sum of ^{Fifty*} dollars (\$^{51,000.00}), for materials furnished or labor thereon of any kind, or for amounts due under the Unemployment Insurance Act with respect to this work or labor, that the Surety will pay the same in an amount not exceeding the amount hereinabove set forth, and also in case suit is brought upon this bond, will pay, in addition to the face amount thereof, costs and reasonable expenses and fees, including reasonable attorney's fees, incurred by the City in successfully enforcing this obligation, to be awarded and fixed by the court, and to be taxed as costs and to be included in the judgment therein rendered. *One Thousand and no/100

It is hereby expressly stipulated and agreed that this bond shall inure to the benefit of any and all persons, companies, and corporations entitled to file claims under Title 3 (commencing with Section 9000, et seq.) of Part 6 of Division 4 of the Civil Code, so as to give a right of action to them or their assigns in any suit brought upon this bond.

Should the condition of this bond be fully performed, then this obligation shall become null and void, otherwise it shall be and remain in full force and effect.

The Surety hereby stipulates and agrees that no change, extension of time, alteration, or addition to the terms of the agreement or the specifications accompanying the same shall in any manner affect its obligations on this bond, and it does hereby waive notice of any such change, extension, alteration, or addition.

[signatures on following page]

IN WITNESS WHEREOF, this instrument has been duly executed by the Principal and Surety above named, on the 15th of August, 2022.

(Seal)

(Seal)

RLI Insurance Company

RSI-Communities-California LLC

SURETY

PRINCIPAL

By: *D. Garcia*

By: *Kimberley Kraft*

Name: D. Garcia

Name: Kimberley Kraft

Title: Attorney-In-Fact

Title: Authorized Signatory

Address: 19800 MacArthur Blvd. Ste 1250

By: _____

Irvine, CA 92612

Name: _____

Title: _____

Address: 6440 Oak Canyon
#200 Irvine, CA 92618



ALL SIGNATURES MUST BE ACKNOWLEDGED BEFORE A NOTARY PUBLIC

ACKNOWLEDGMENT

A notary public or other officer completing this certificate verifies only the identity of the individual who signed the document to which this certificate is attached, and not the truthfulness, accuracy, or validity of that document.

State of California
County of Orange)


On August 16, 2022 before me, Crystal Villalobos, Notary Public
(insert name and title of the officer)

personally appeared Kimberly Kraft,
who proved to me on the basis of satisfactory evidence to be the person(s) whose name(s) is/are
subscribed to the within instrument and acknowledged to me that he/she/they executed the same in
his/her/their authorized capacity(ies), and that by his/her/their signature(s) on the instrument the
person(s), or the entity upon behalf of which the person(s) acted, executed the instrument.

I certify under PENALTY OF PERJURY under the laws of the State of California that the foregoing
paragraph is true and correct.

WITNESS my hand and official seal.

Signature *Crystal Villalobos* (Seal)

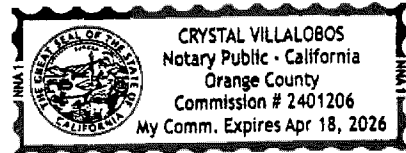

CALIFORNIA ALL-PURPOSE ACKNOWLEDGMENT

A Notary Public or other officer completing this certificate verifies only the identity of the individual who signed the document to which this certificate is attached, and not the truthfulness, accuracy, or validity of that document.

State of California


County of Los Angeles


AUG 15 2022

On _____ before me, Edward C. Spector, Notary Public, personally appeared D. Garcia who proved to me on the basis of satisfactory evidence to be the person(s) whose name(s) is/are subscribed to the within instrument and acknowledgment to me that he/she/~~they~~ executed the same in his/her/~~their~~ authorized capacity(ies), and that by his/her/~~their~~ signature(s) on the instrument the person(s), or the entity upon behalf of which the person(s) acted, executed the instrument.

I certify under PENALTY OF PERJURY under the laws of the State of California that the foregoing paragraph is true and correct.

Witness my hand and official seal.

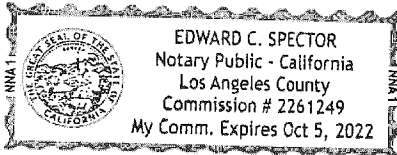

Signature 
Edward C. Spector, Notary Public

POWER OF ATTORNEY

RLI Insurance Company Contractors Bonding and Insurance Company

9025 N. Lindbergh Dr. Peoria, IL 61615
Phone: 800-645-2402

Know All Men by These Presents:

That this Power of Attorney is not valid or in effect unless attached to the bond which it authorizes executed, but may be detached by the approving officer if desired.

That RLI Insurance Company and/or Contractors Bonding and Insurance Company, each an Illinois corporation, (separately and together, the "Company") do hereby make, constitute and appoint:

Janina Monroe, Michelle Haase, Timothy Noonan, Adriana Valenzuela, Jennifer Ochs, Martha Barreras, Sarah Campbell, Rhonda Larson, Charles R. Teter, III, B. Aleman, Erin Brown, D. Garcia, Simone Gerhard, Edward C. Spector, Ethan Spector, Marina Tapia, KD Wapato, Rachel A. Mullen, Lisa Marie Saumur, jointly or severally


in the City of Los Angeles, State of California its true and lawful Agent(s) and Attorney(s) in Fact, with full power and authority hereby conferred, to sign, execute, acknowledge and deliver for and on its behalf as Surety, in general, any and all bonds and undertakings in an amount not to exceed Twenty Five Million Dollars (\$25,000,000.00) for any single obligation.

The acknowledgment and execution of such bond by the said Attorney in Fact shall be as binding upon the Company as if such bond had been executed and acknowledged by the regularly elected officers of the Company.

RLI Insurance Company and/or Contractors Bonding and Insurance Company, as applicable, have each further certified that the following is a true and exact copy of a Resolution adopted by the Board of Directors of each such corporation, and is now in force, to-wit:

"All bonds, policies, undertakings, Powers of Attorney or other obligations of the corporation shall be executed in the corporate name of the Company by the President, Secretary, any Assistant Secretary, Treasurer, or any Vice President, or by such other officers as the Board of Directors may authorize. The President, any Vice President, Secretary, any Assistant Secretary, or the Treasurer may appoint Attorneys in Fact or Agents who shall have authority to issue bonds, policies or undertakings in the name of the Company. The corporate seal is not necessary for the validity of any bonds, policies, undertakings, Powers of Attorney or other obligations of the corporation. The signature of any such officer and the corporate seal may be printed by facsimile."

IN WITNESS WHEREOF, the RLI Insurance Company and/or Contractors Bonding and Insurance Company, as applicable, have caused these presents to be executed by its respective Vice President with its corporate seal affixed this 21st day of February, 2022.

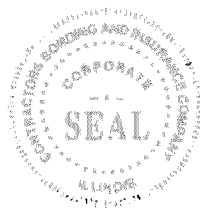

RLI Insurance Company
Contractors Bonding and Insurance Company

By: Barton W. Davis
Barton W. Davis Vice President

State of Illinois }
County of Peoria } SS

CERTIFICATE

On this 21st day of February, 2022, before me, a Notary Public, personally appeared Barton W. Davis, who being by me duly sworn, acknowledged that he signed the above Power of Attorney as the aforesaid officer of the RLI Insurance Company and/or Contractors Bonding and Insurance Company and acknowledged said instrument to be the voluntary act and deed of said corporation.

I, the undersigned officer of RLI Insurance Company and/or Contractors Bonding and Insurance Company, do hereby certify that the attached Power of Attorney is in full force and effect and is irrevocable; and furthermore, that the Resolution of the Company as set forth in the Power of Attorney, is now in force. In testimony whereof, I have hereunto set my hand and the seal of the RLI Insurance Company and/or Contractors Bonding and Insurance Company this 15th day of August, 2022.

By: Catherine D. Glover
Catherine D. Glover Notary Public

RLI Insurance Company
Contractors Bonding and Insurance Company

By: Jeffrey D. Fick
Jeffrey D. Fick Corporate Secretary





Stantec Consulting Services Inc.

735 East Carnegie Drive Suite 280, San Bernardino CA 92408-3588

July 30, 2024
File: 2042 495812

Robert Vestal

City of Beaumont
Public Works Department
550 E. 6th Street
Beaumont, CA 92223

Reference: Final Monuments – Tract No. 27971-10

Dear Robert,

Please be advised that the final monuments for Tract No. 27971-10 have been set. The centerline ties for this map are enclosed for your review and approval.

The developer has compensated us for the setting of these monuments. Please release the monument bond or cash deposit for this map.

Thank you for your help in this matter.


Regards,



Stantec Consulting Services Inc.

Ray E. Mansur, PLS

Senior Principal, Geospatial Services
Phone: (949) 923-6012
Ray.Mansur@stantec.com

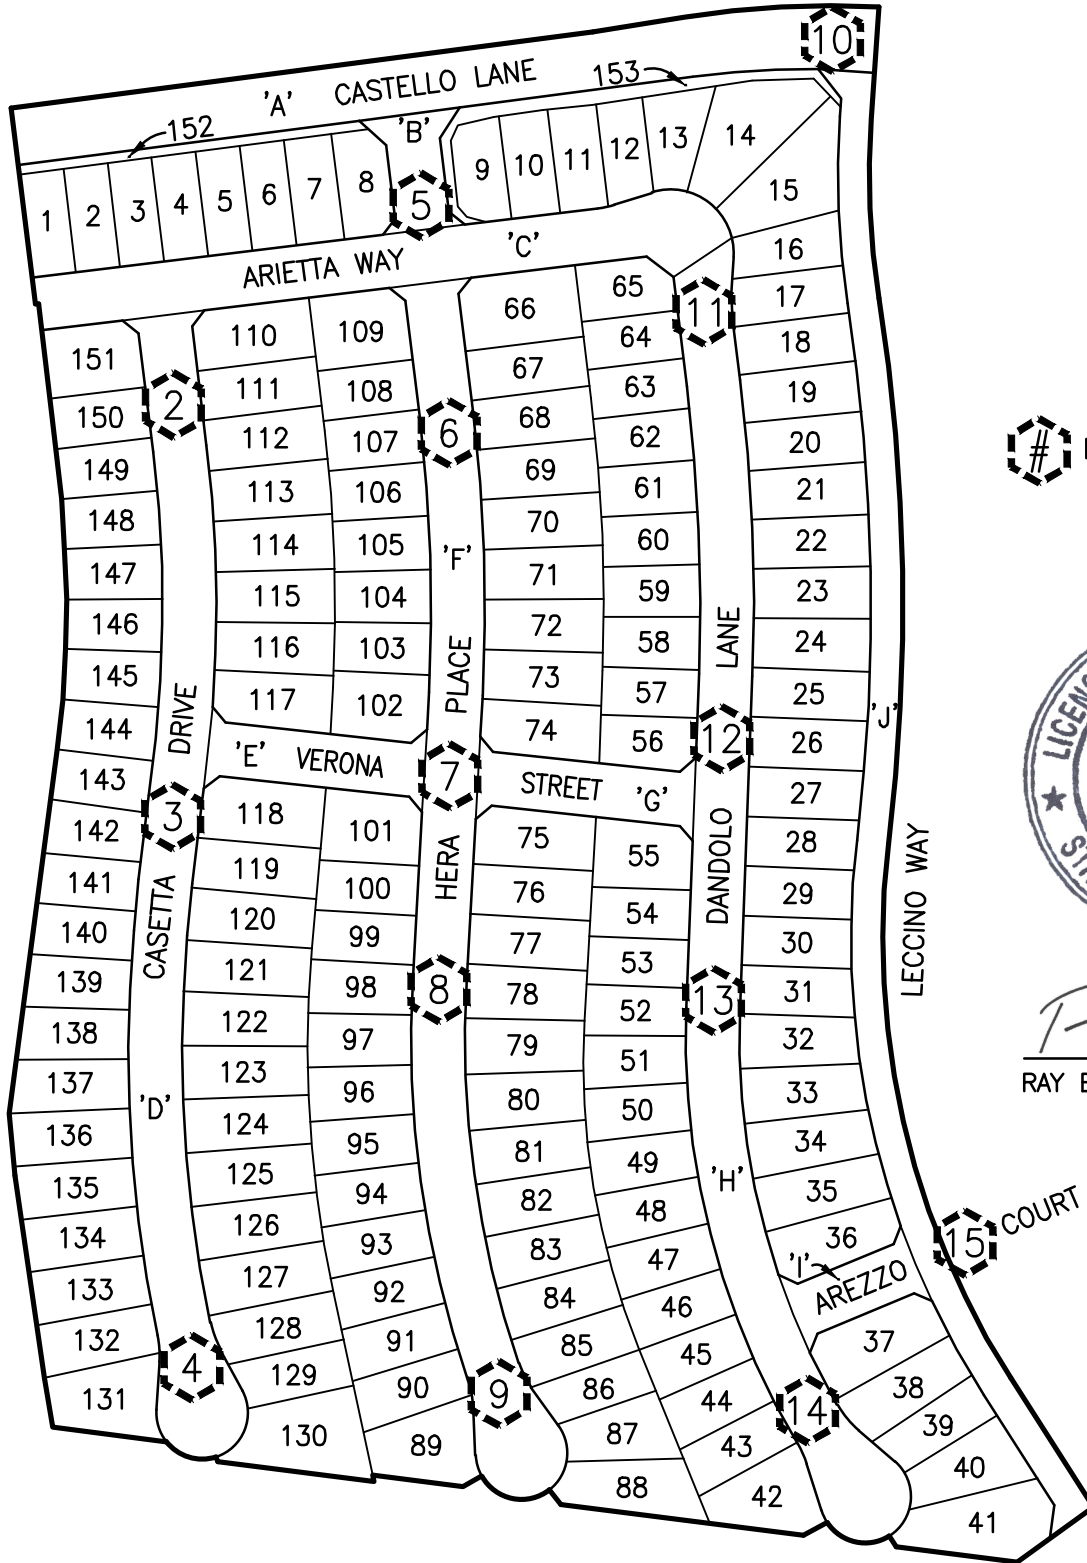\\us0328-ppfss02\2042\active\2042495810\record\mapping\cl_ties\tr27971-10\monu_map no 27971-10_let.docx




INDEX MAP
 INDICATES SHEET NO.




 RAY E. MANSUR, P.L.S. 7185



Stantec
 735 East Carnegie Drive, Suite 280
 San Bernardino, CA 92408
 909-335-6116 stantec.com

CENTERLINE TIES
TRACT NO. 27971-10
M.B. 444 / 31-36

PUBLIC WORKS DEPARTMENT CITY OF BEAUMONT

SCALE: 1" = 200'
 JN: 2042 495812
 FILE: 495810V-MX7173

DATE: 7/30/24

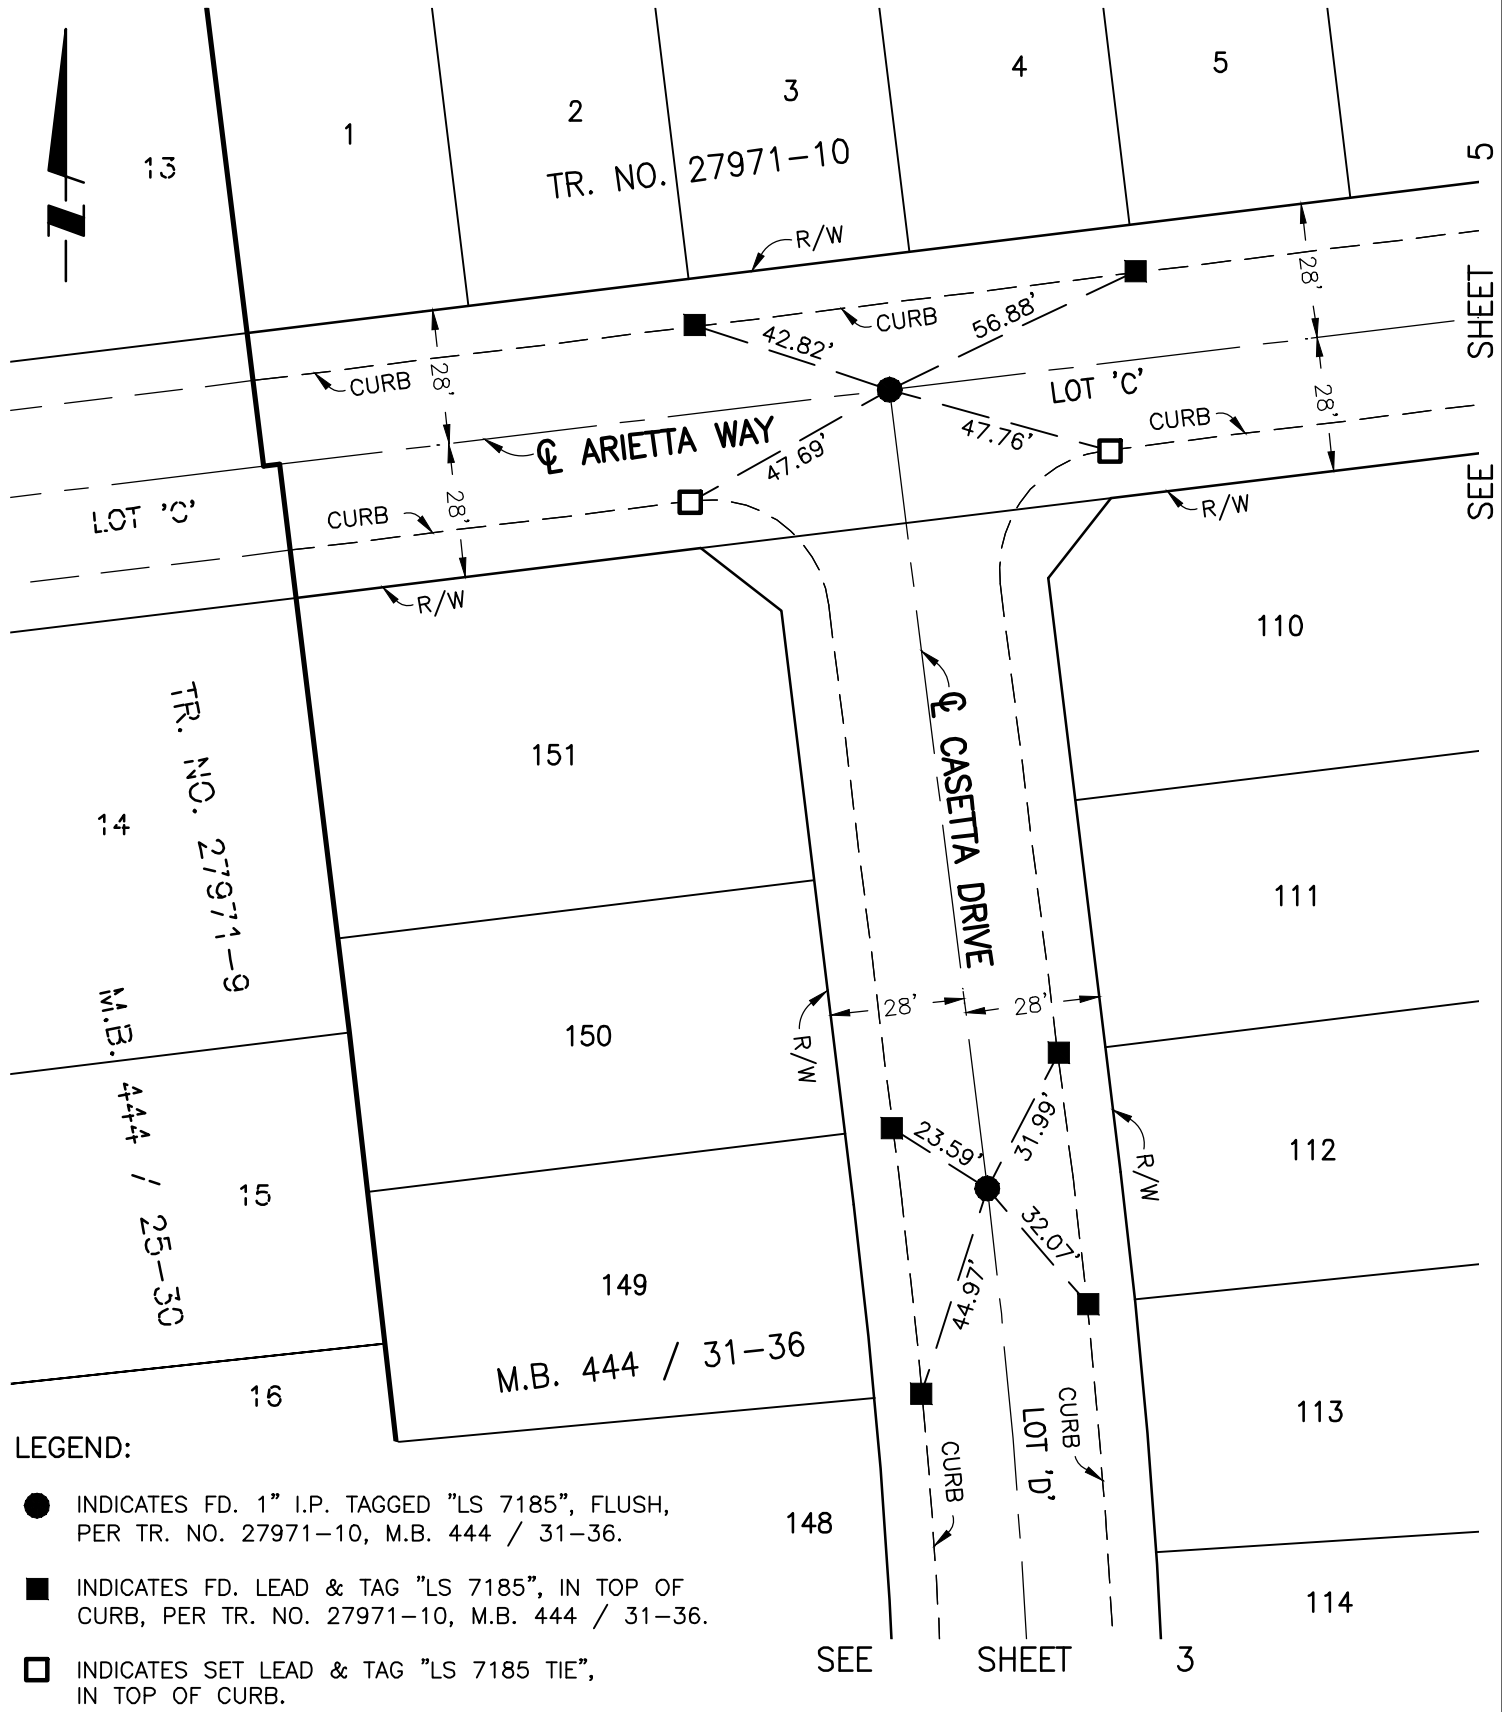

LEGEND:

- INDICATES FD. 1" I.P. TAGGED "LS 7185", FLUSH, PER TR. NO. 27971-10, M.B. 444 / 31-36.
- INDICATES FD. LEAD & TAG "LS 7185", IN TOP OF CURB, PER TR. NO. 27971-10, M.B. 444 / 31-36.
- ◻ INDICATES SET LEAD & TAG "LS 7185 TIE", IN TOP OF CURB.

Stantec
 735 East Carnegie Drive, Suite 280
 San Bernardino, CA 92408
 909-335-6116 stantec.com

DATE: 7/30/24

CENTERLINE TIES
 TRACT NO. 27971-10
 M.B. 444 / 31-36

PUBLIC WORKS DEPARTMENT CITY OF BEAUMONT


SCALE: 1" = 40'
 JN: 2042 495812
 FILE: 495810V-MX7174

LEGEND:

- INDICATES FD. 1" I.P. TAGGED "LS 7185", FLUSH, PER TR. NO. 27971-10, M.B. 444 / 31-36.
- INDICATES FD. LEAD & TAG "LS 7185", IN TOP OF CURB, PER TR. NO. 27971-10, M.B. 444 / 31-36.

LEGEND:

- INDICATES SET LEAD & TAG "LS 7185 TIE", IN TOP OF CURB.

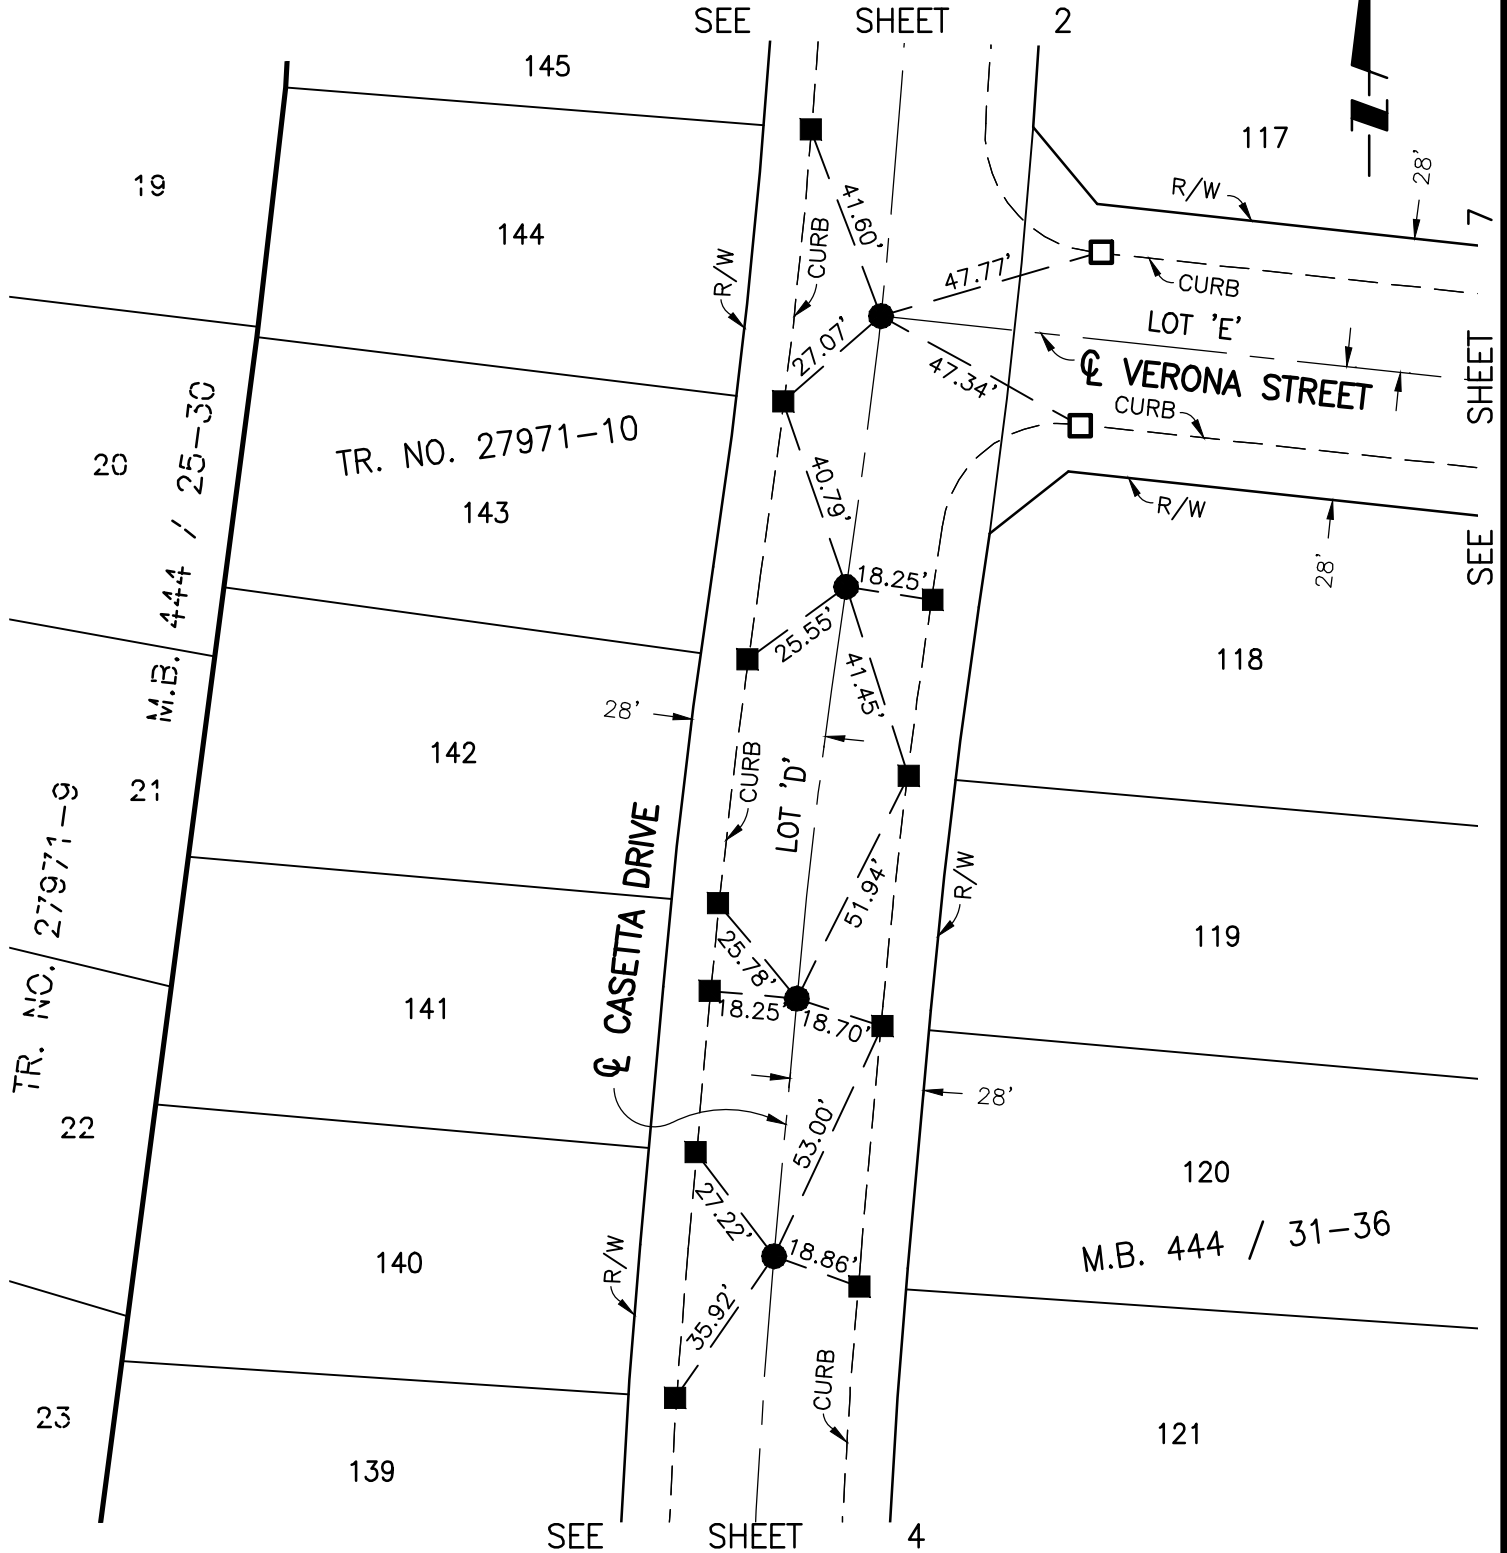

Stantec

735 East Carnegie Drive, Suite 280
 San Bernardino, CA 92408
 909-335-6116 stantec.com

CENTERLINE TIES
TRACT NO. 27971-10
M.B. 444 / 31-36

SCALE: 1" = 40'

JN: 2042 495812


DATE: 7/30/24

PUBLIC WORKS DEPARTMENT CITY OF BEAUMONT

FILE: 495810V-MX7174

LEGEND:

- INDICATES FD. 1" I.P. TAGGED "LS 7185", FLUSH, PER TR. NO. 27971-10, M.B. 444 / 31-36.
- INDICATES FD. LEAD & TAG "LS 7185", IN TOP OF CURB, PER TR. NO. 27971-10, M.B. 444 / 31-36.

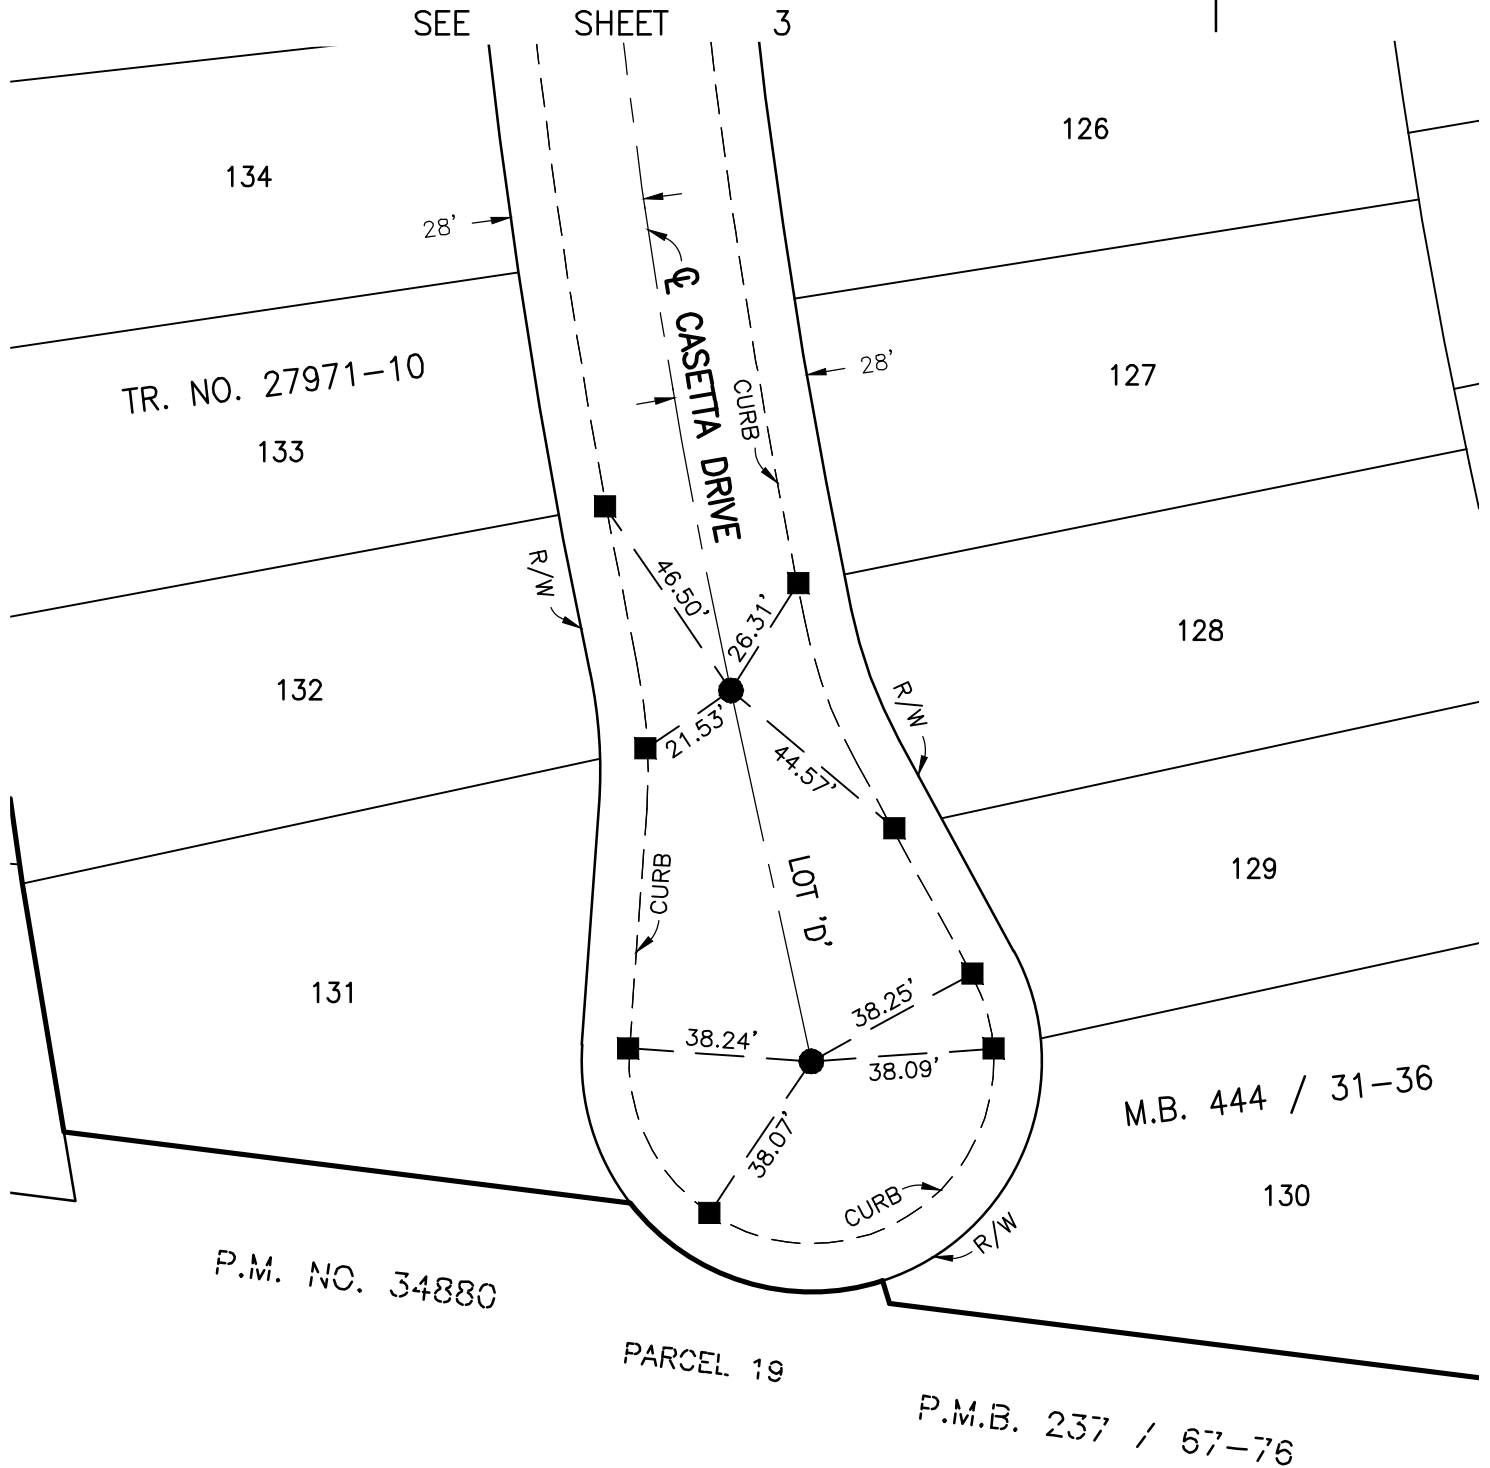

Stantec

735 East Carnegie Drive, Suite 280
 San Bernardino, CA 92408
 909-335-6116 stantec.com

CENTERLINE TIES
TRACT NO. 27971-10
M.B. 444 / 31-36

SCALE: 1" = 40'

JN: 2042 495812


DATE: 7/30/24

PUBLIC WORKS DEPARTMENT CITY OF BEAUMONT

FILE: 495810V-MX7174

LEGEND:

- INDICATES FD. 1" I.P. TAGGED "LS 7185", FLUSH, PER TR. NO. 27971-10, M.B. 444 / 31-36.
- INDICATES SET LEAD & TAG "LS 7185 TIE", IN TOP OF CURB.

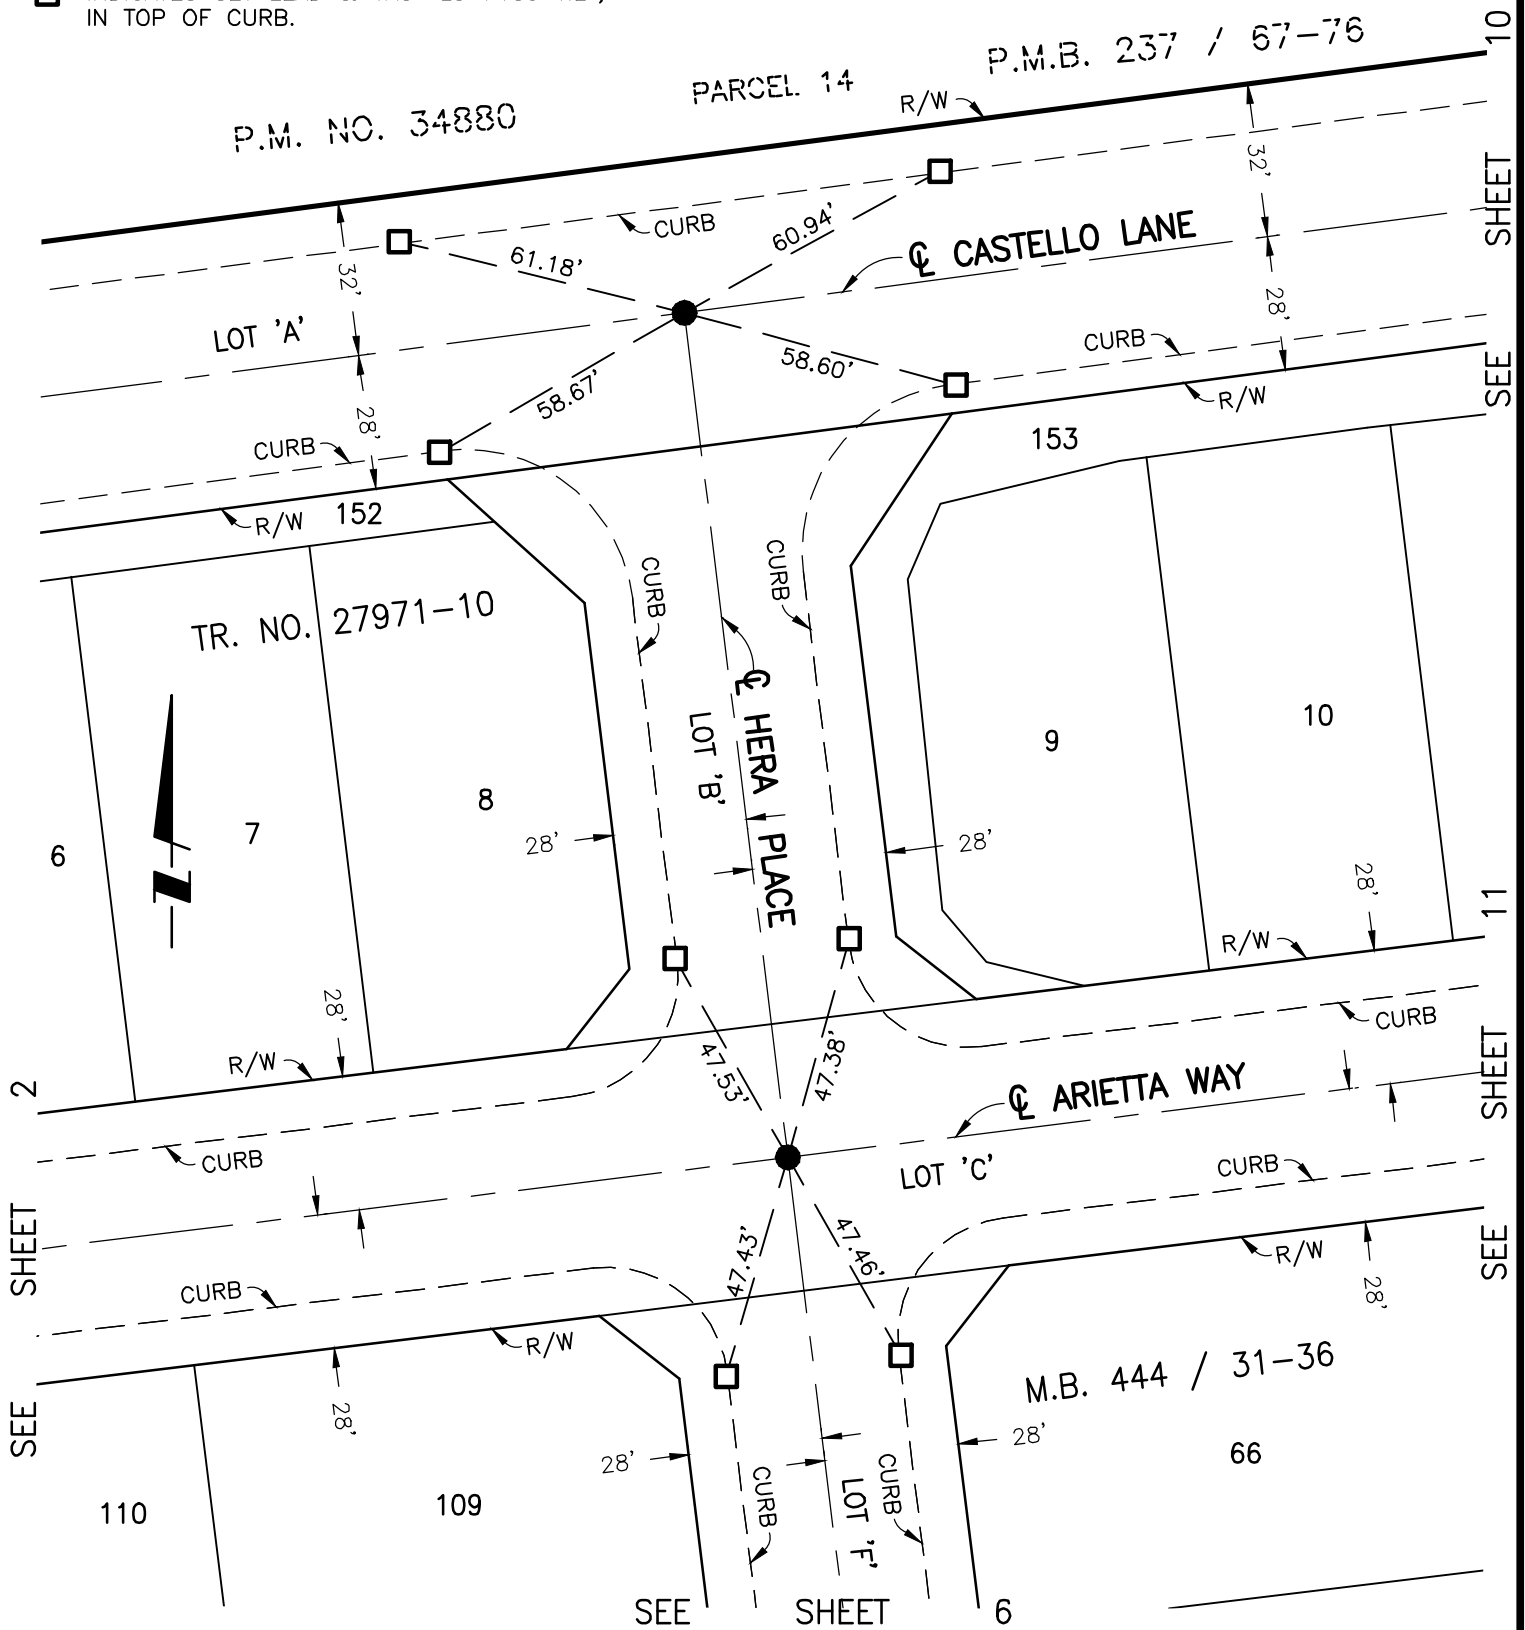

Stantec
 735 East Carnegie Drive, Suite 280
 San Bernardino, CA 92408
 909-335-6116 stantec.com


CENTERLINE TIES
TRACT NO. 27971-10
M.B. 444 / 31-36

DATE: 7/30/24 PUBLIC WORKS DEPARTMENT CITY OF BEAUMONT

SCALE: 1" = 40'
 JN: 2042 495812
 FILE: 495810V-MX7174

LEGEND:

- INDICATES FD. 1" I.P. TAGGED "LS 7185", FLUSH, PER TR. NO. 27971-10, M.B. 444 / 31-36.
- INDICATES FD. LEAD & TAG "LS 7185", IN TOP OF CURB, PER TR. NO. 27971-10, M.B. 444 / 31-36.

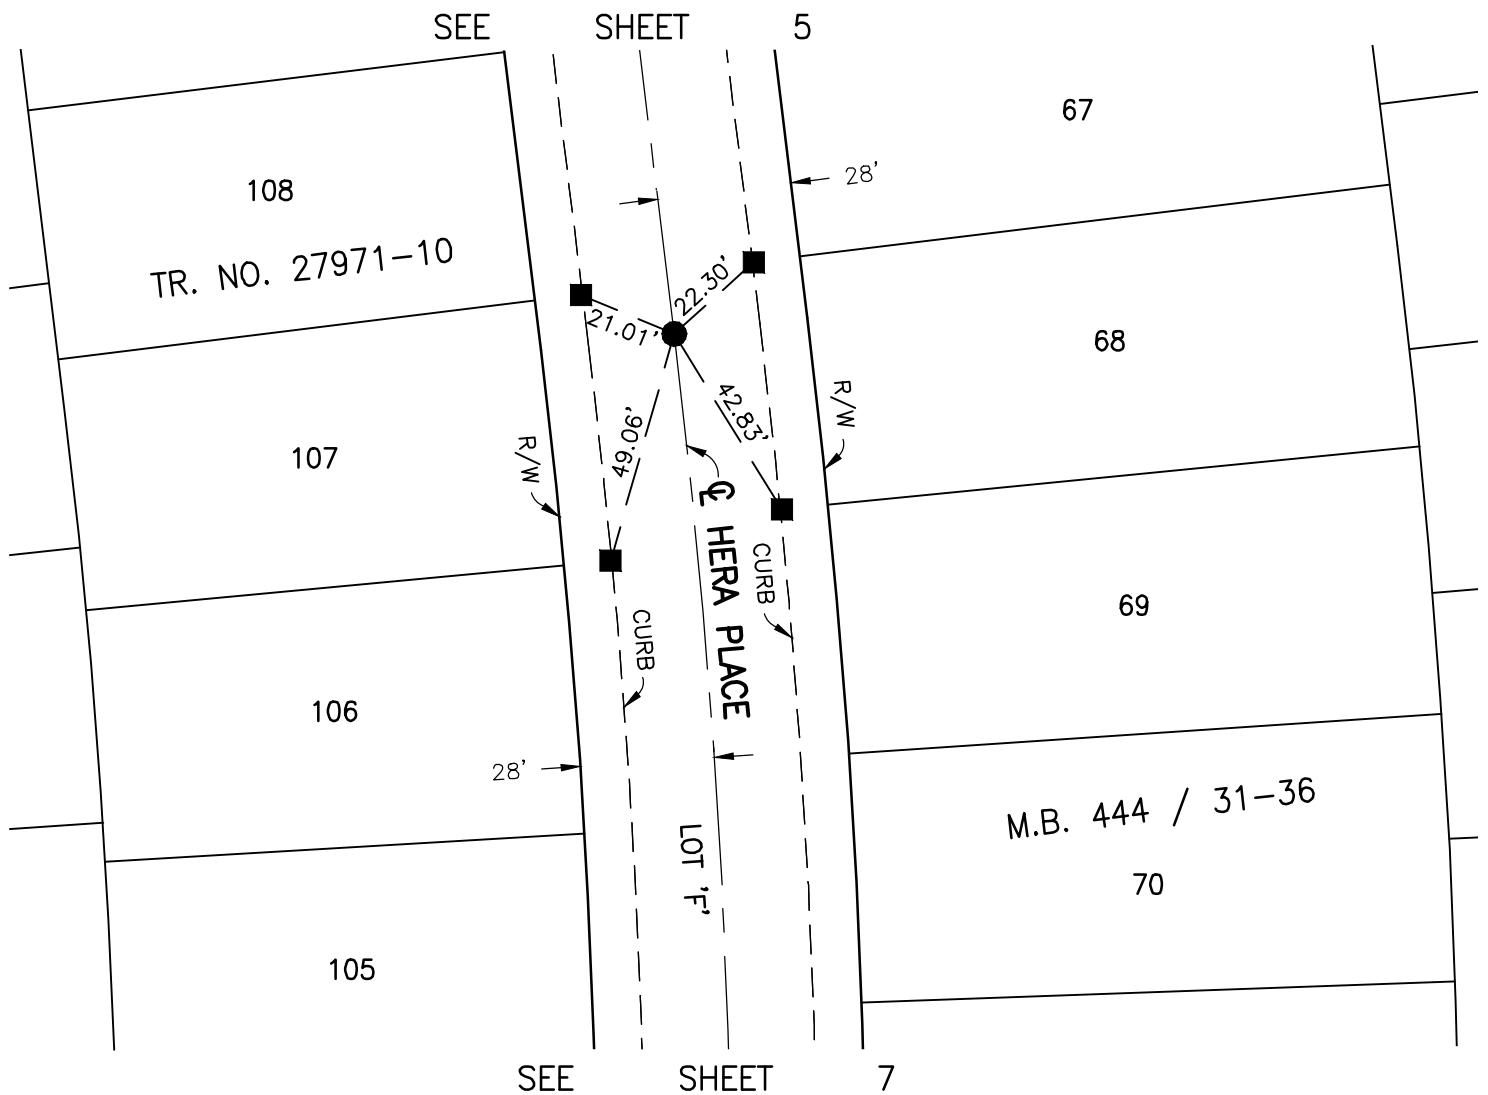

Stantec

735 East Carnegie Drive, Suite 280
 San Bernardino, CA 92408
 909-335-6116 stantec.com

CENTERLINE TIES
TRACT NO. 27971-10
M.B. 444 / 31-36

SCALE: 1" = 40'

JN: 2042 495812


DATE: 7/30/24

PUBLIC WORKS DEPARTMENT CITY OF BEAUMONT

FILE: 495810V-MX7174

LEGEND:

- INDICATES FD. 1" I.P. TAGGED "LS 7185", FLUSH, PER TR. NO. 27971-10, M.B. 444 / 31-36.
- INDICATES FD. LEAD & TAG "LS 7185", IN TOP OF CURB, PER TR. NO. 27971-10, M.B. 444 / 31-36.
- INDICATES SET LEAD & TAG "LS 7185 TIE", IN TOP OF CURB.

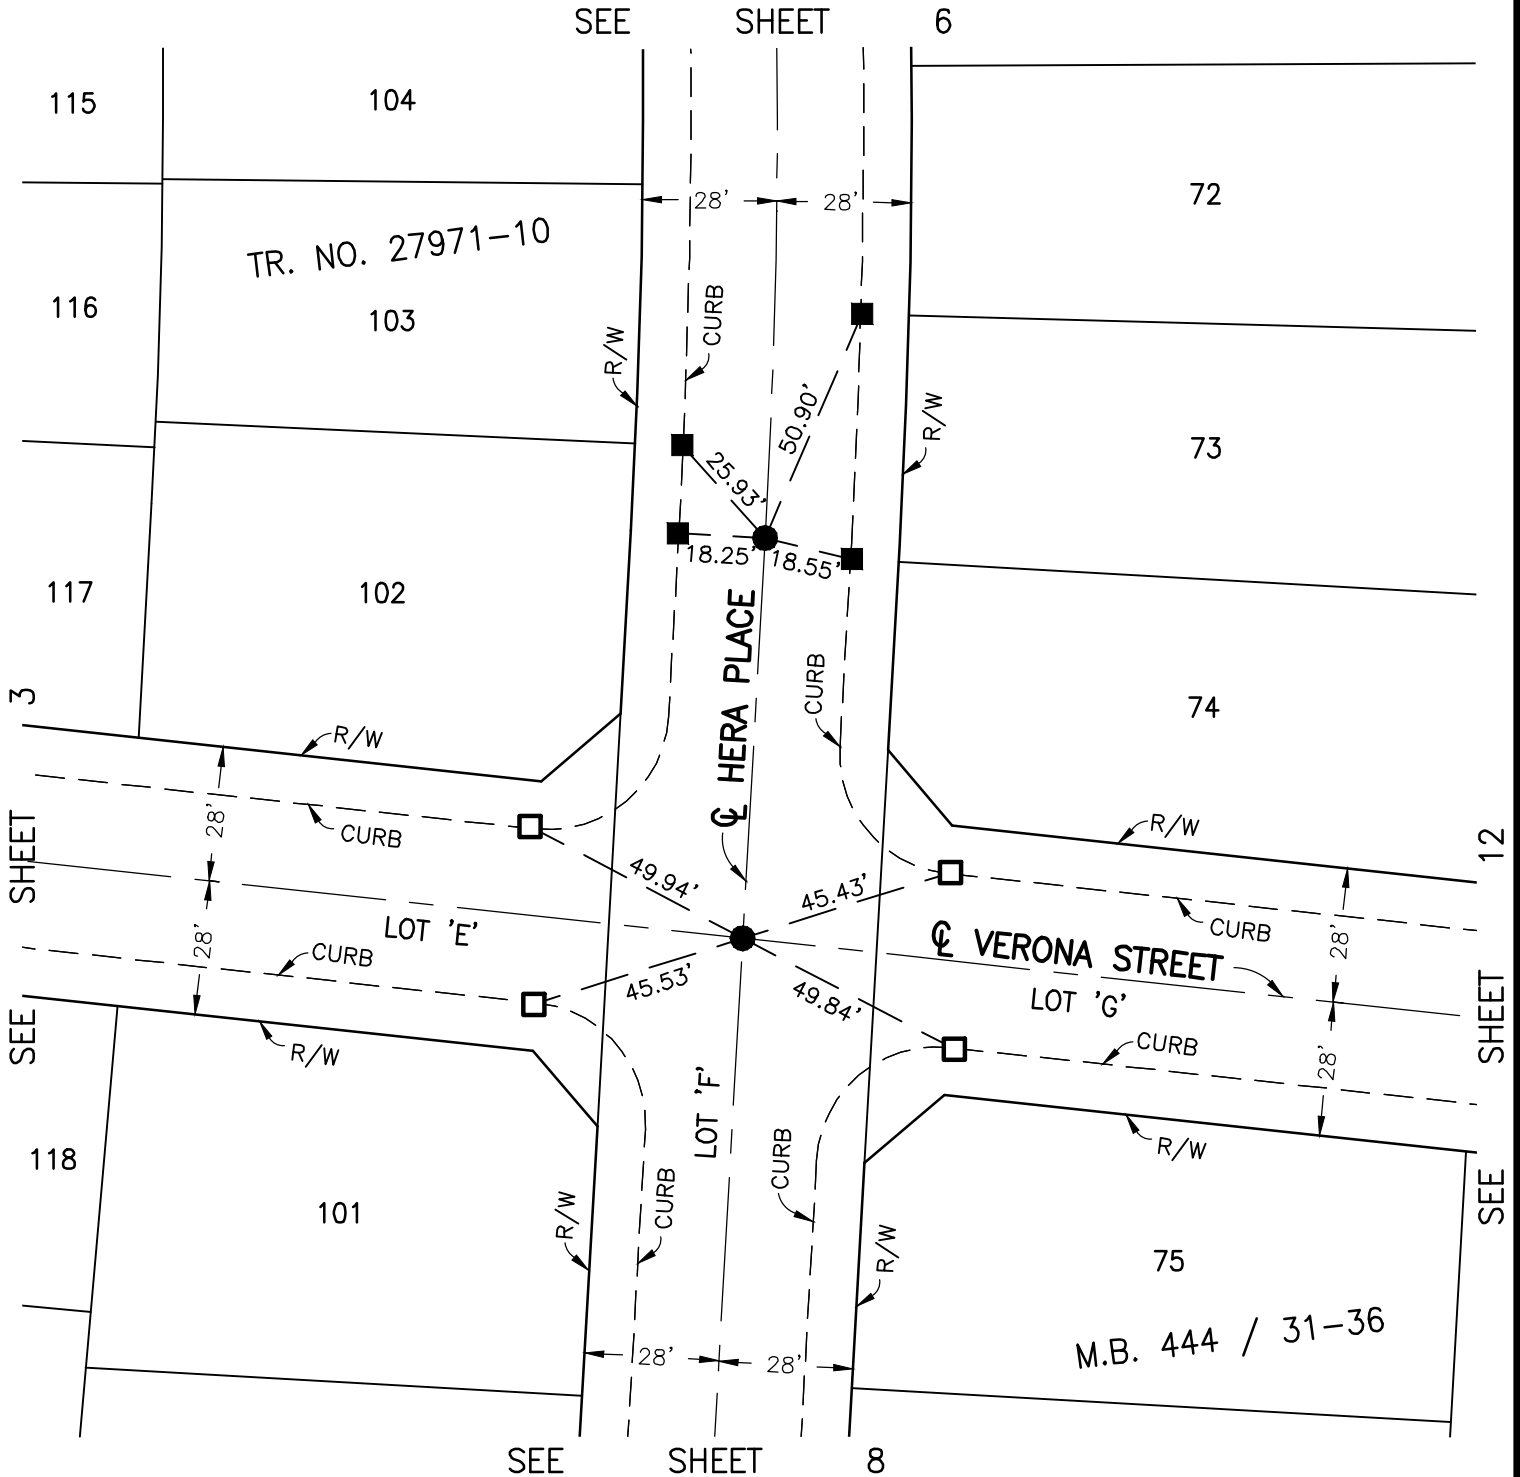

Stantec

735 East Carnegie Drive, Suite 280
San Bernardino, CA 92408
909-335-6116 stantec.com

CENTERLINE TIES

TRACT NO. 27971-10

M.B. 444 / 31-36

SCALE: 1" = 40'

JN: 2042 495812

DATE: 7/30/24


PUBLIC WORKS DEPARTMENT

CITY OF BEAUMONT

FILE: 495810V-MX7174

LEGEND:

- INDICATES FD. 1" I.P. TAGGED "LS 7185", FLUSH, PER TR. NO. 27971-10, M.B. 444 / 31-36.
- INDICATES FD. LEAD & TAG "LS 7185", IN TOP OF CURB, PER TR. NO. 27971-10, M.B. 444 / 31-36.

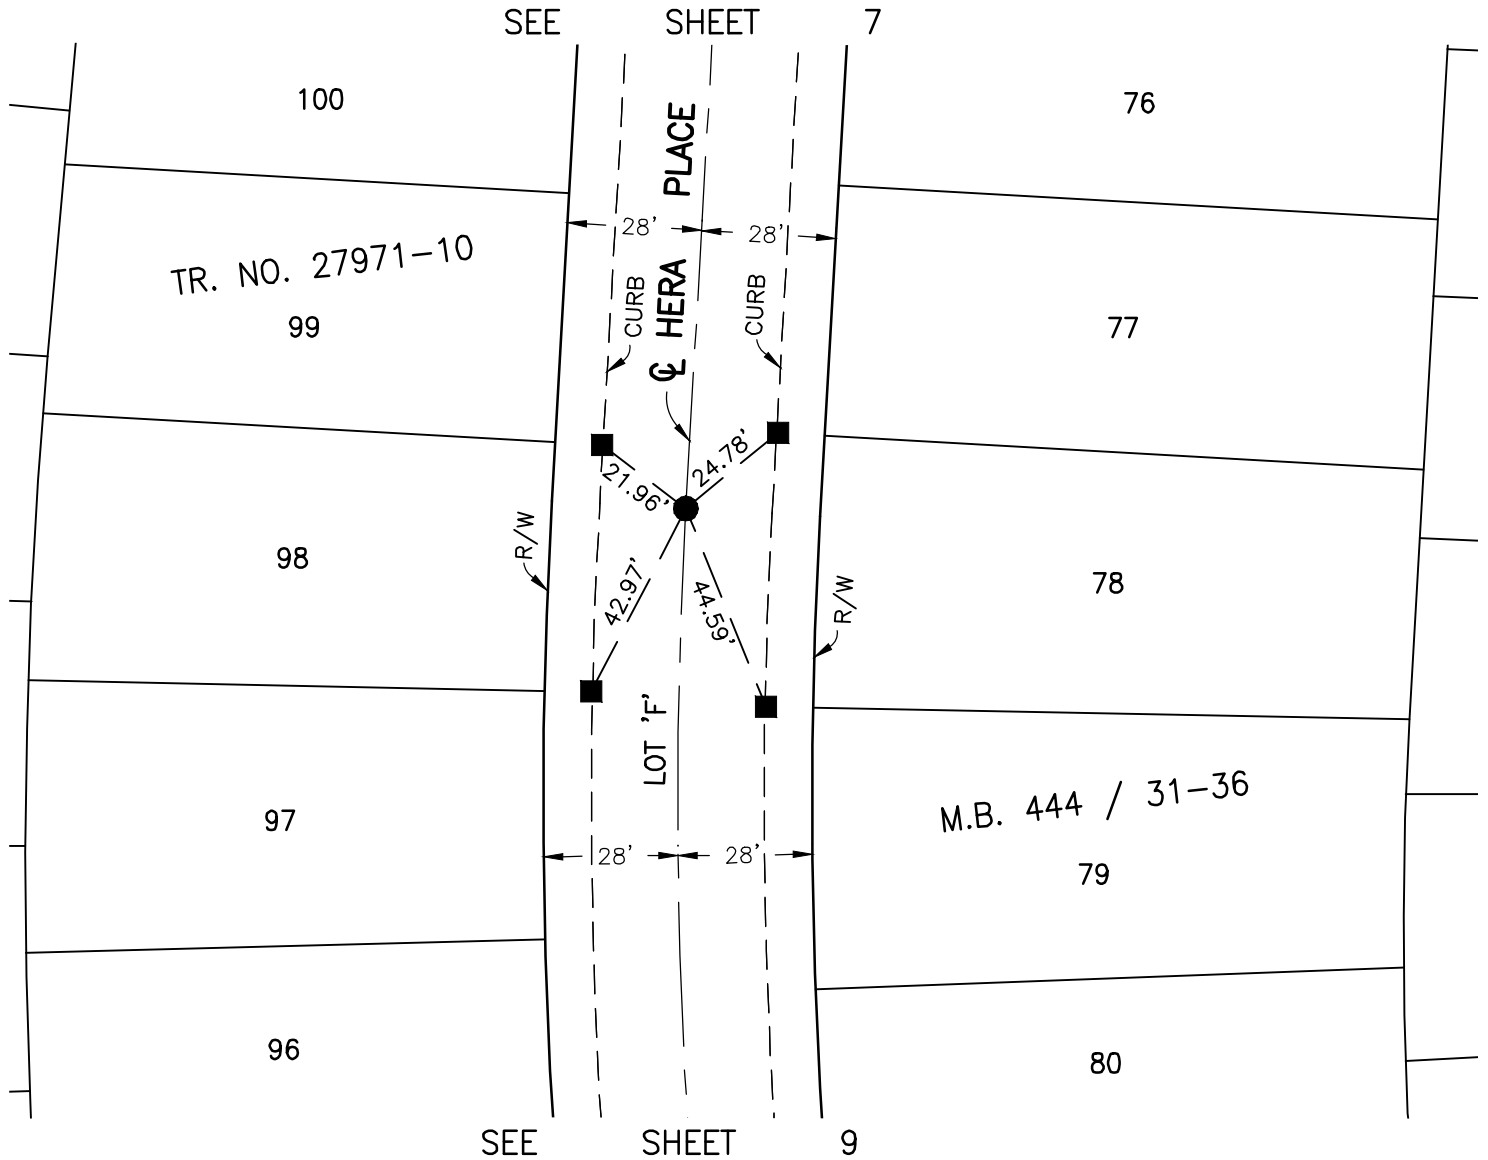

Stantec

735 East Carnegie Drive, Suite 280
 San Bernardino, CA 92408
 909-335-6116 stantec.com

CENTERLINE TIES
TRACT NO. 27971-10
M.B. 444 / 31-36

SCALE: 1" = 40'

JN: 2042 495812


DATE: 7/30/24

PUBLIC WORKS DEPARTMENT CITY OF BEAUMONT

FILE: 495810V-MX7174

LEGEND:

- INDICATES FD. 1" I.P. TAGGED "LS 7185", FLUSH, PER TR. NO. 27971-10, M.B. 444 / 31-36.
- INDICATES FD. LEAD & TAG "LS 7185", IN TOP OF CURB, PER TR. NO. 27971-10, M.B. 444 / 31-36.

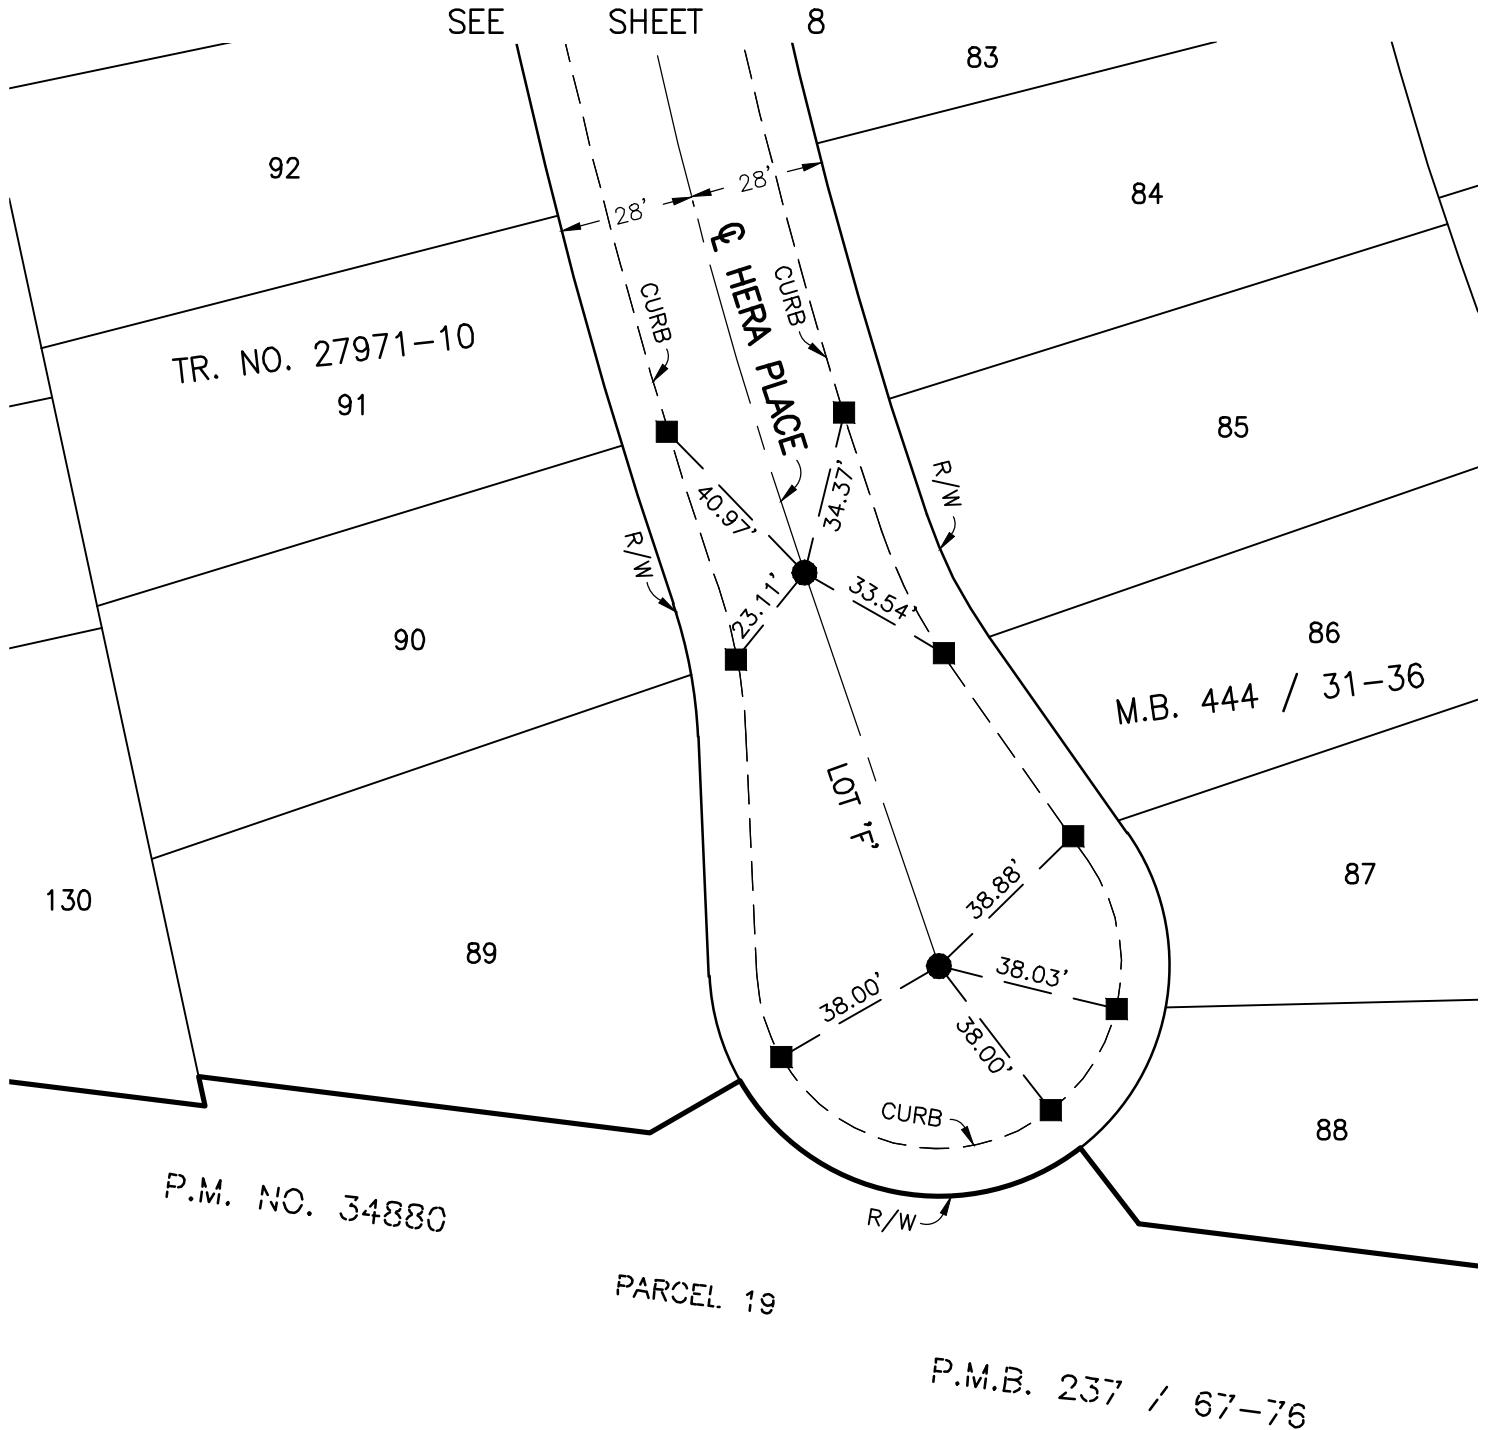

Stantec

735 East Carnegie Drive, Suite 280
 San Bernardino, CA 92408
 909-335-6116 stantec.com

CENTERLINE TIES
TRACT NO. 27971-10
M.B. 444 / 31-36

SCALE: 1" = 40'

JN: 2042 495812


DATE: 7/30/24

PUBLIC WORKS DEPARTMENT CITY OF BEAUMONT

FILE: 495810V-MX7174

LEGEND:

- INDICATES FD. 1" I.P. TAGGED "LS 7185", FLUSH, PER TR. NO. 27971-10, M.B. 444 / 31-36.
- INDICATES SET LEAD & TAG "LS 7185 TIE", IN TOP OF CURB.

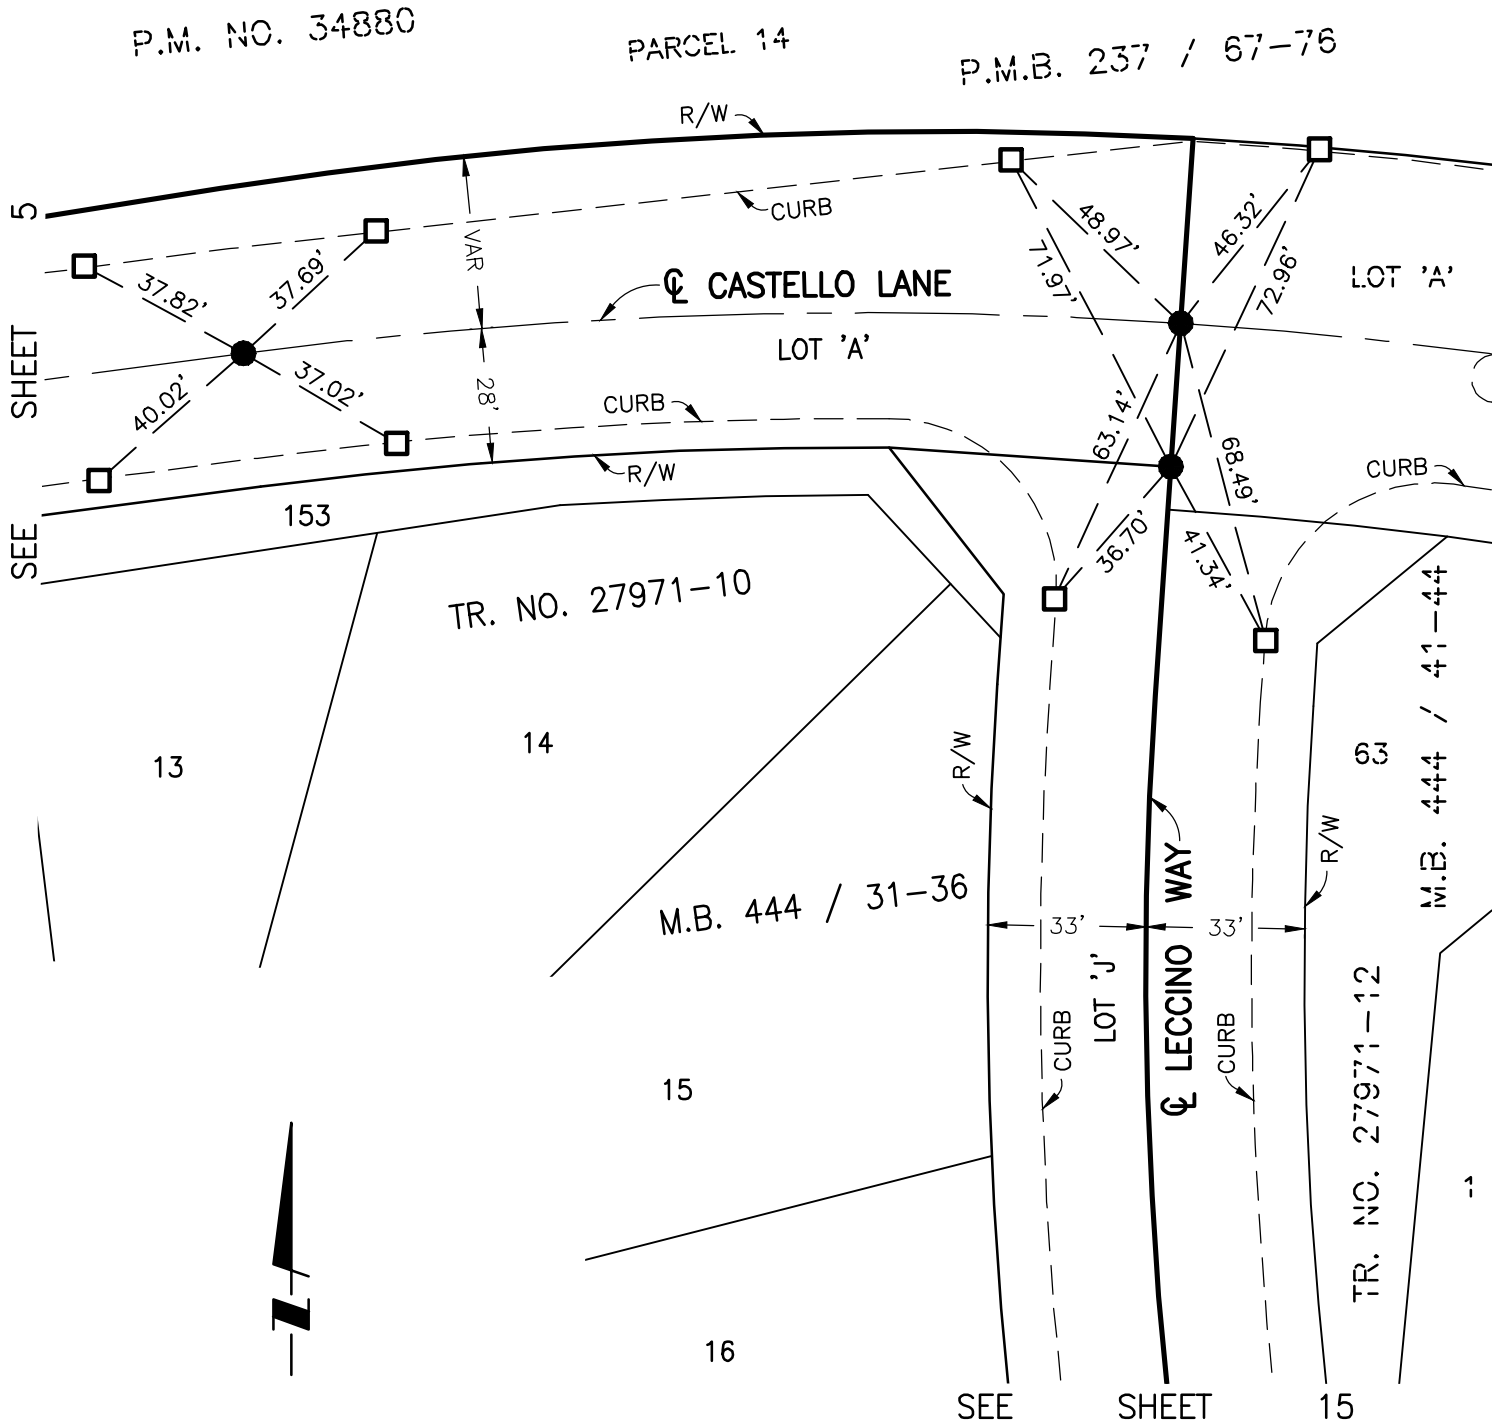

Stantec
 735 East Carnegie Drive, Suite 280
 San Bernardino, CA 92408
 909-335-6116 stantec.com

CENTERLINE TIES
TRACT NO. 27971-10
M.B. 444 / 31-36

SCALE: 1" = 40'
 JN: 2042 495812


DATE: 7/30/24

PUBLIC WORKS DEPARTMENT CITY OF BEAUMONT

FILE: 495810V-MX7174

LEGEND:

- INDICATES FD. 1" I.P. TAGGED "LS 7185", FLUSH, PER TR. NO. 27971-10, M.B. 444 / 31-36.
- INDICATES FD. LEAD & TAG "LS 7185", IN TOP OF CURB, PER TR. NO. 27971-10, M.B. 444 / 31-36.
- INDICATES SET LEAD & TAG "LS 7185 TIE", IN TOP OF CURB.

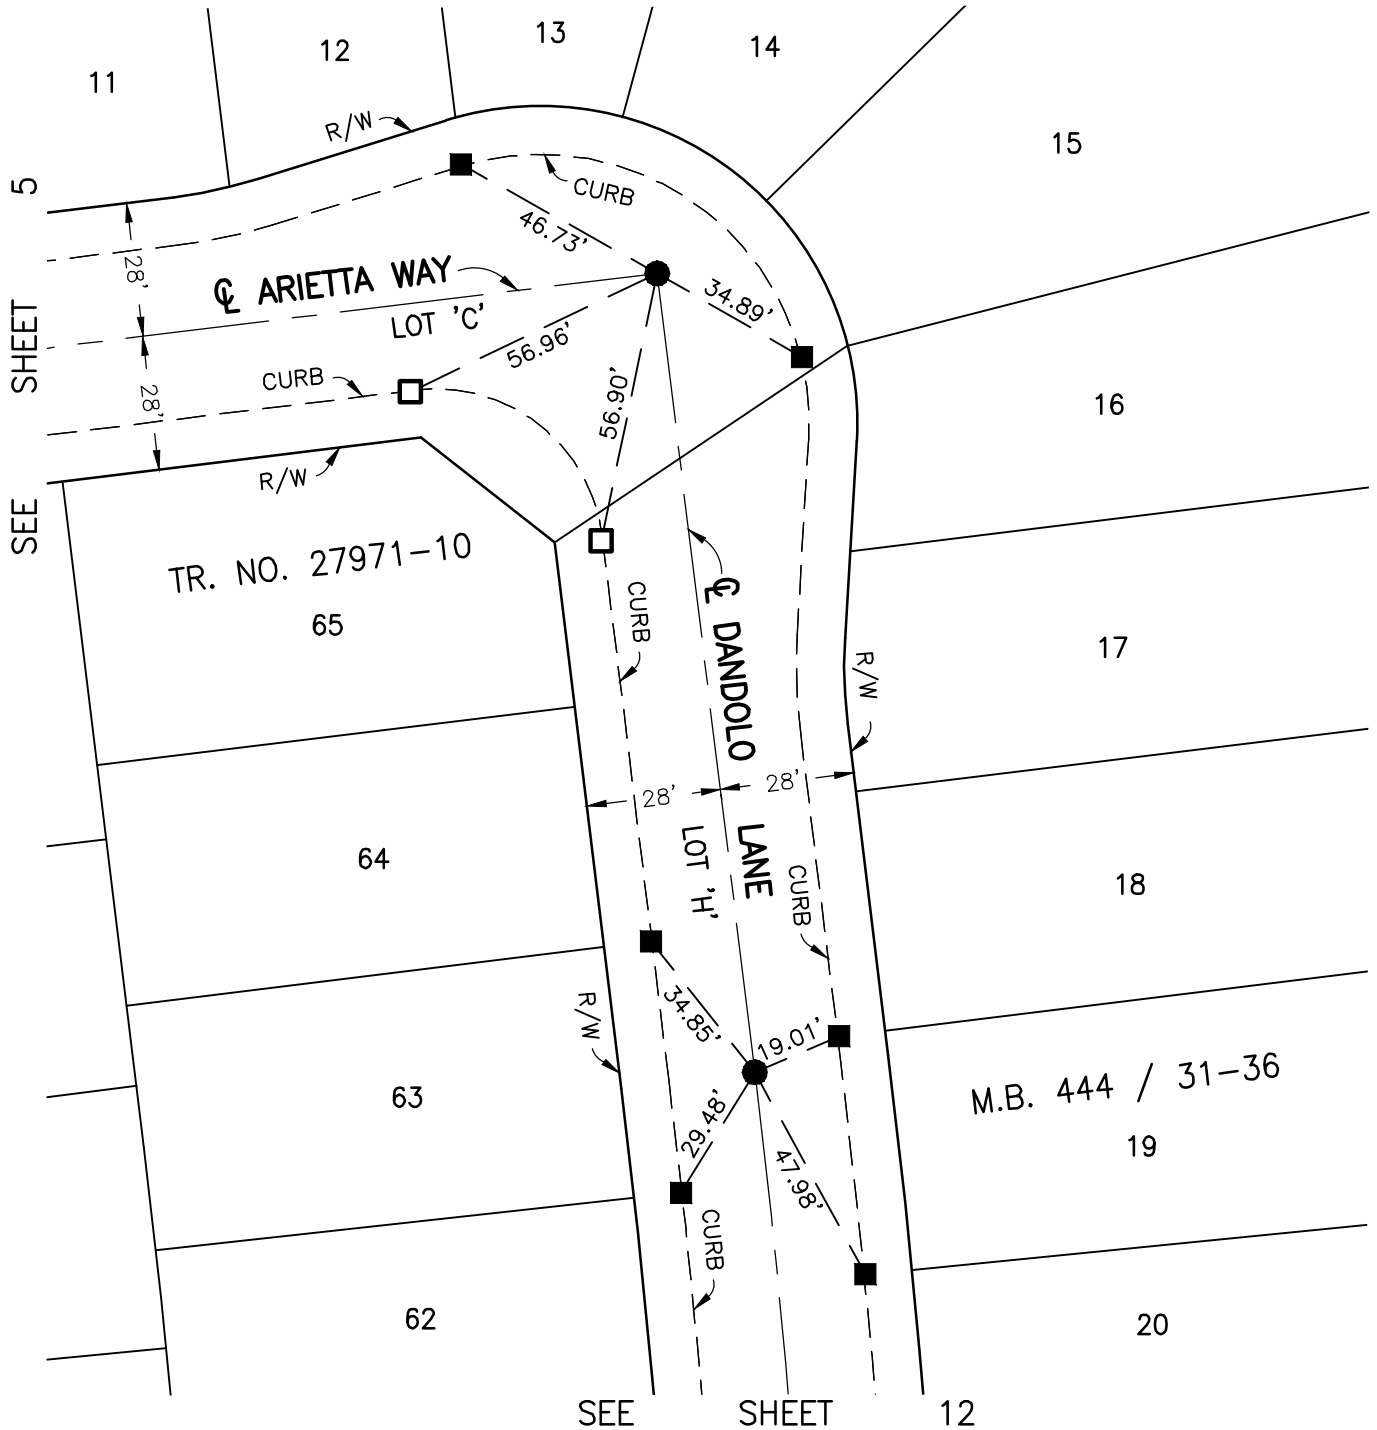

Stantec

735 East Carnegie Drive, Suite 280
 San Bernardino, CA 92408
 909-335-6116 stantec.com

CENTERLINE TIES

TRACT NO. 27971-10

M.B. 444 / 31-36

SCALE: 1" = 40'

JN: 2042 495812


DATE: 7/30/24

PUBLIC WORKS DEPARTMENT CITY OF BEAUMONT

FILE: 495810V-MX7174

LEGEND:

- INDICATES FD. 1" I.P. TAGGED "LS 7185", FLUSH, PER TR. NO. 27971-10, M.B. 444 / 31-36.
- INDICATES FD. LEAD & TAG "LS 7185", IN TOP OF CURB, PER TR. NO. 27971-10, M.B. 444 / 31-36.
- INDICATES SET LEAD & TAG "LS 7185 TIE", IN TOP OF CURB.

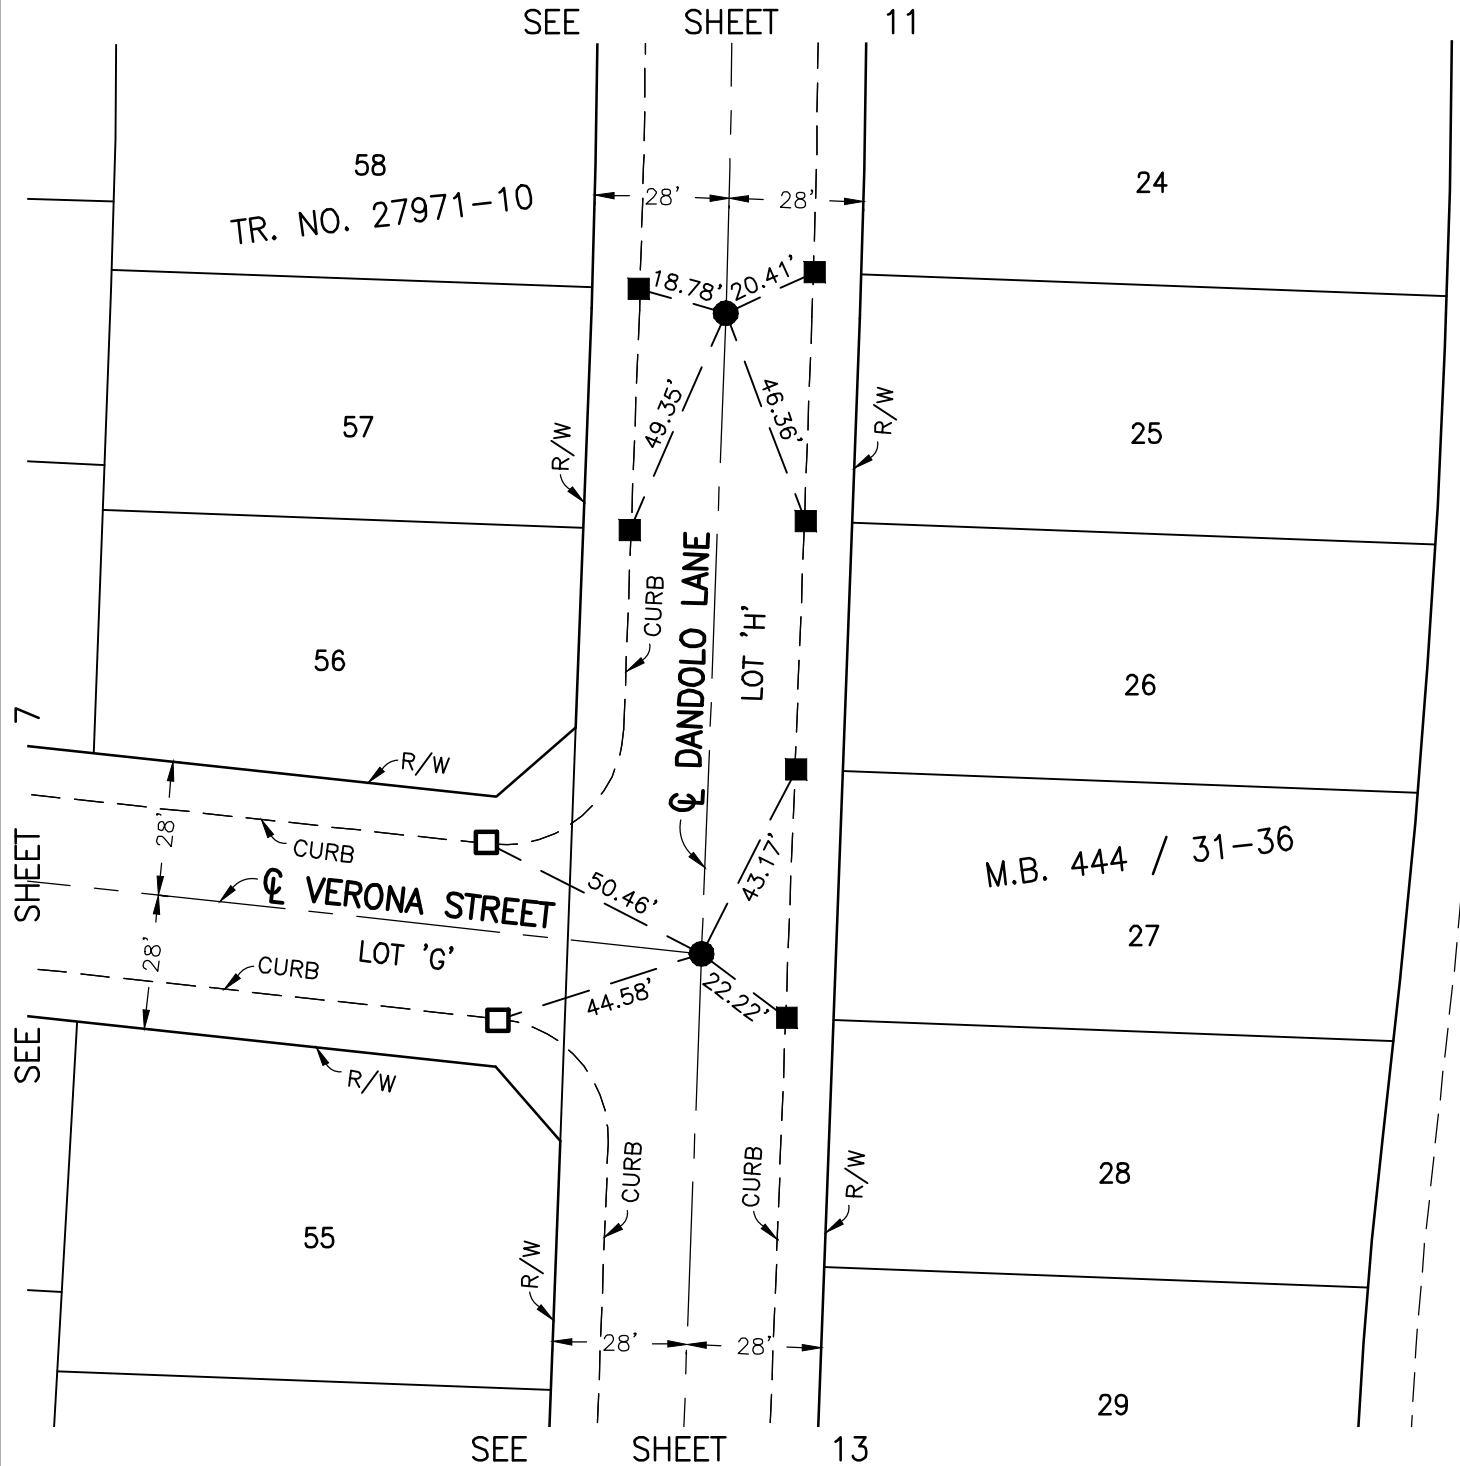

Stantec

735 East Carnegie Drive, Suite 280
 San Bernardino, CA 92408
 909-335-6116 stantec.com

CENTERLINE TIES
TRACT NO. 27971-10
M.B. 444 / 31-36

SCALE: 1" = 40'

JN: 2042 495812


DATE: 7/30/24

PUBLIC WORKS DEPARTMENT CITY OF BEAUMONT

FILE: 495810V-MX7174

LEGEND:

- INDICATES FD. 1" I.P. TAGGED "LS 7185", FLUSH, PER TR. NO. 27971-10, M.B. 444 / 31-36.
- INDICATES FD. LEAD & TAG "LS 7185", IN TOP OF CURB, PER TR. NO. 27971-10, M.B. 444 / 31-36.

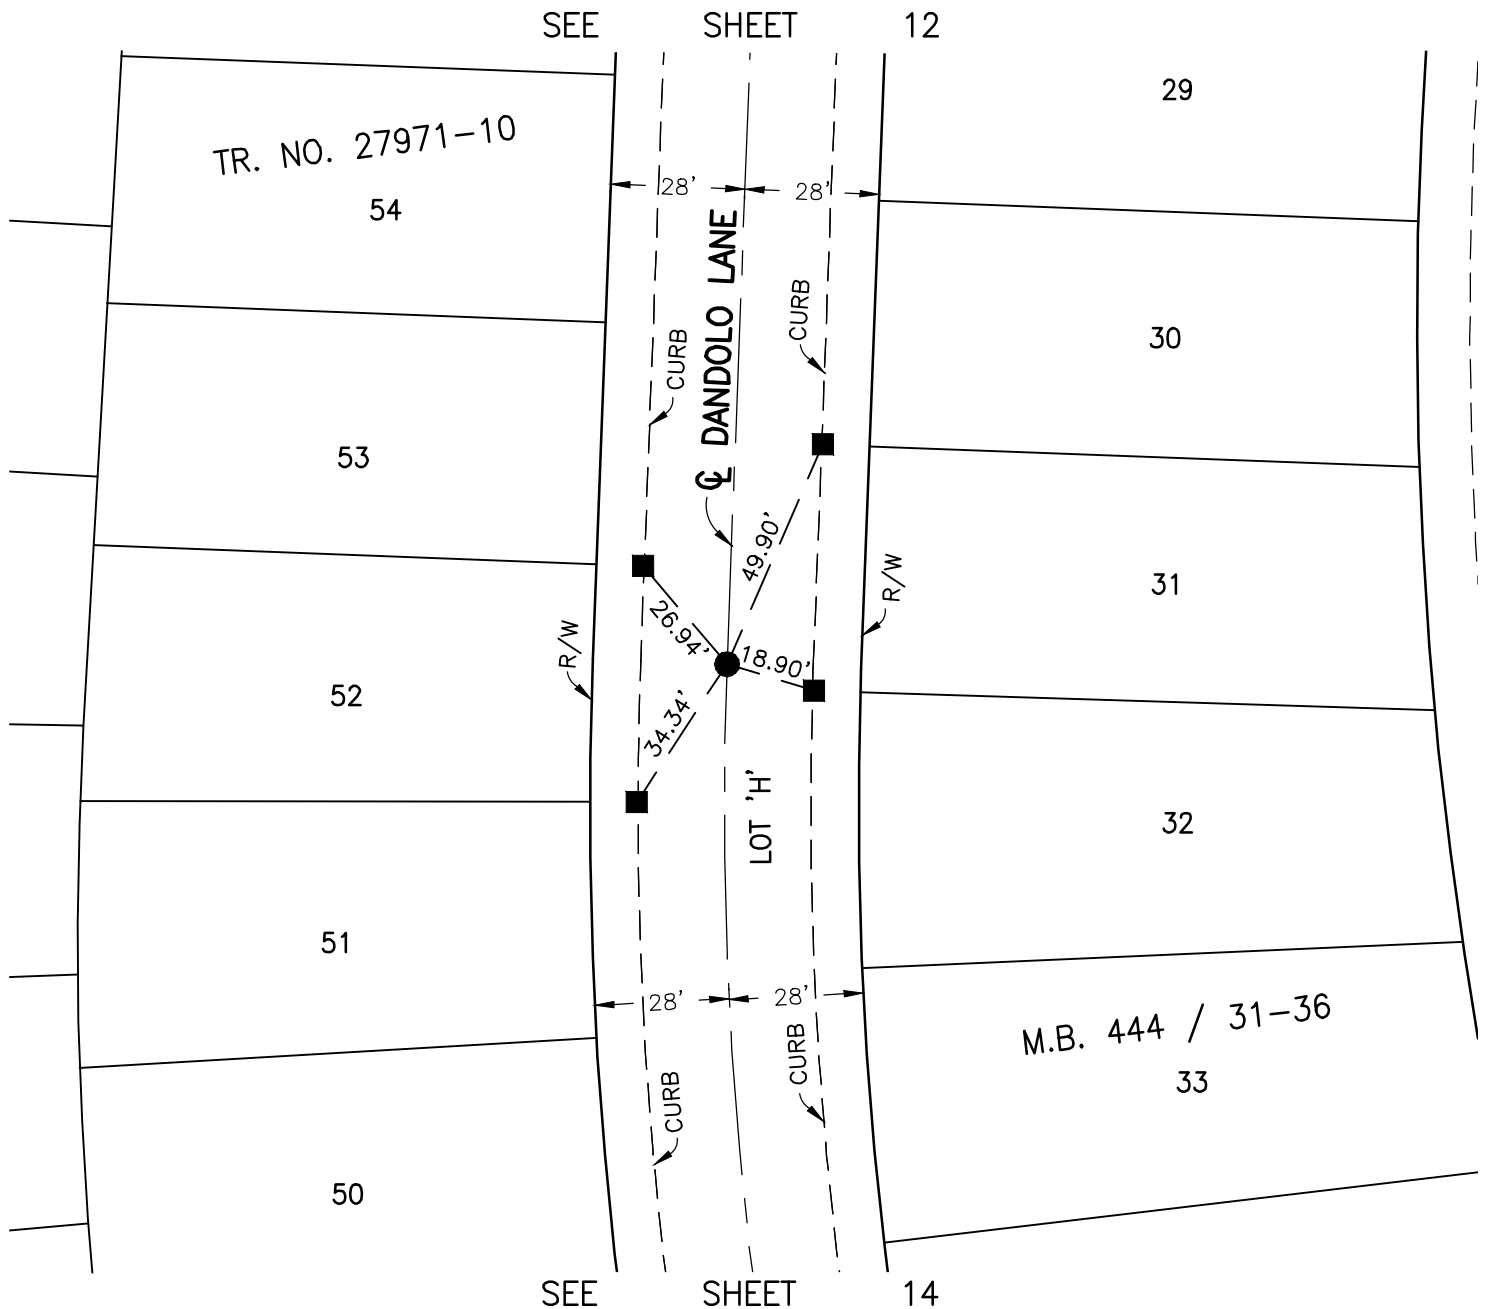

Stantec

735 East Carnegie Drive, Suite 280
 San Bernardino, CA 92408
 909-335-6116 stantec.com

CENTERLINE TIES
TRACT NO. 27971-10
M.B. 444 / 31-36

SCALE: 1" = 40'

JN: 2042 495812


DATE: 7/30/24

PUBLIC WORKS DEPARTMENT CITY OF BEAUMONT

FILE: 495810V-MX7174

LEGEND:

- INDICATES FD. 1" I.P. TAGGED "LS 7185", FLUSH, PER TR. NO. 27971-10, M.B. 444 / 31-36.
- INDICATES FD. LEAD & TAG "LS 7185", IN TOP OF CURB, PER TR. NO. 27971-10, M.B. 444 / 31-36.
- INDICATES SET LEAD & TAG "LS 7185 TIE", IN TOP OF CURB.

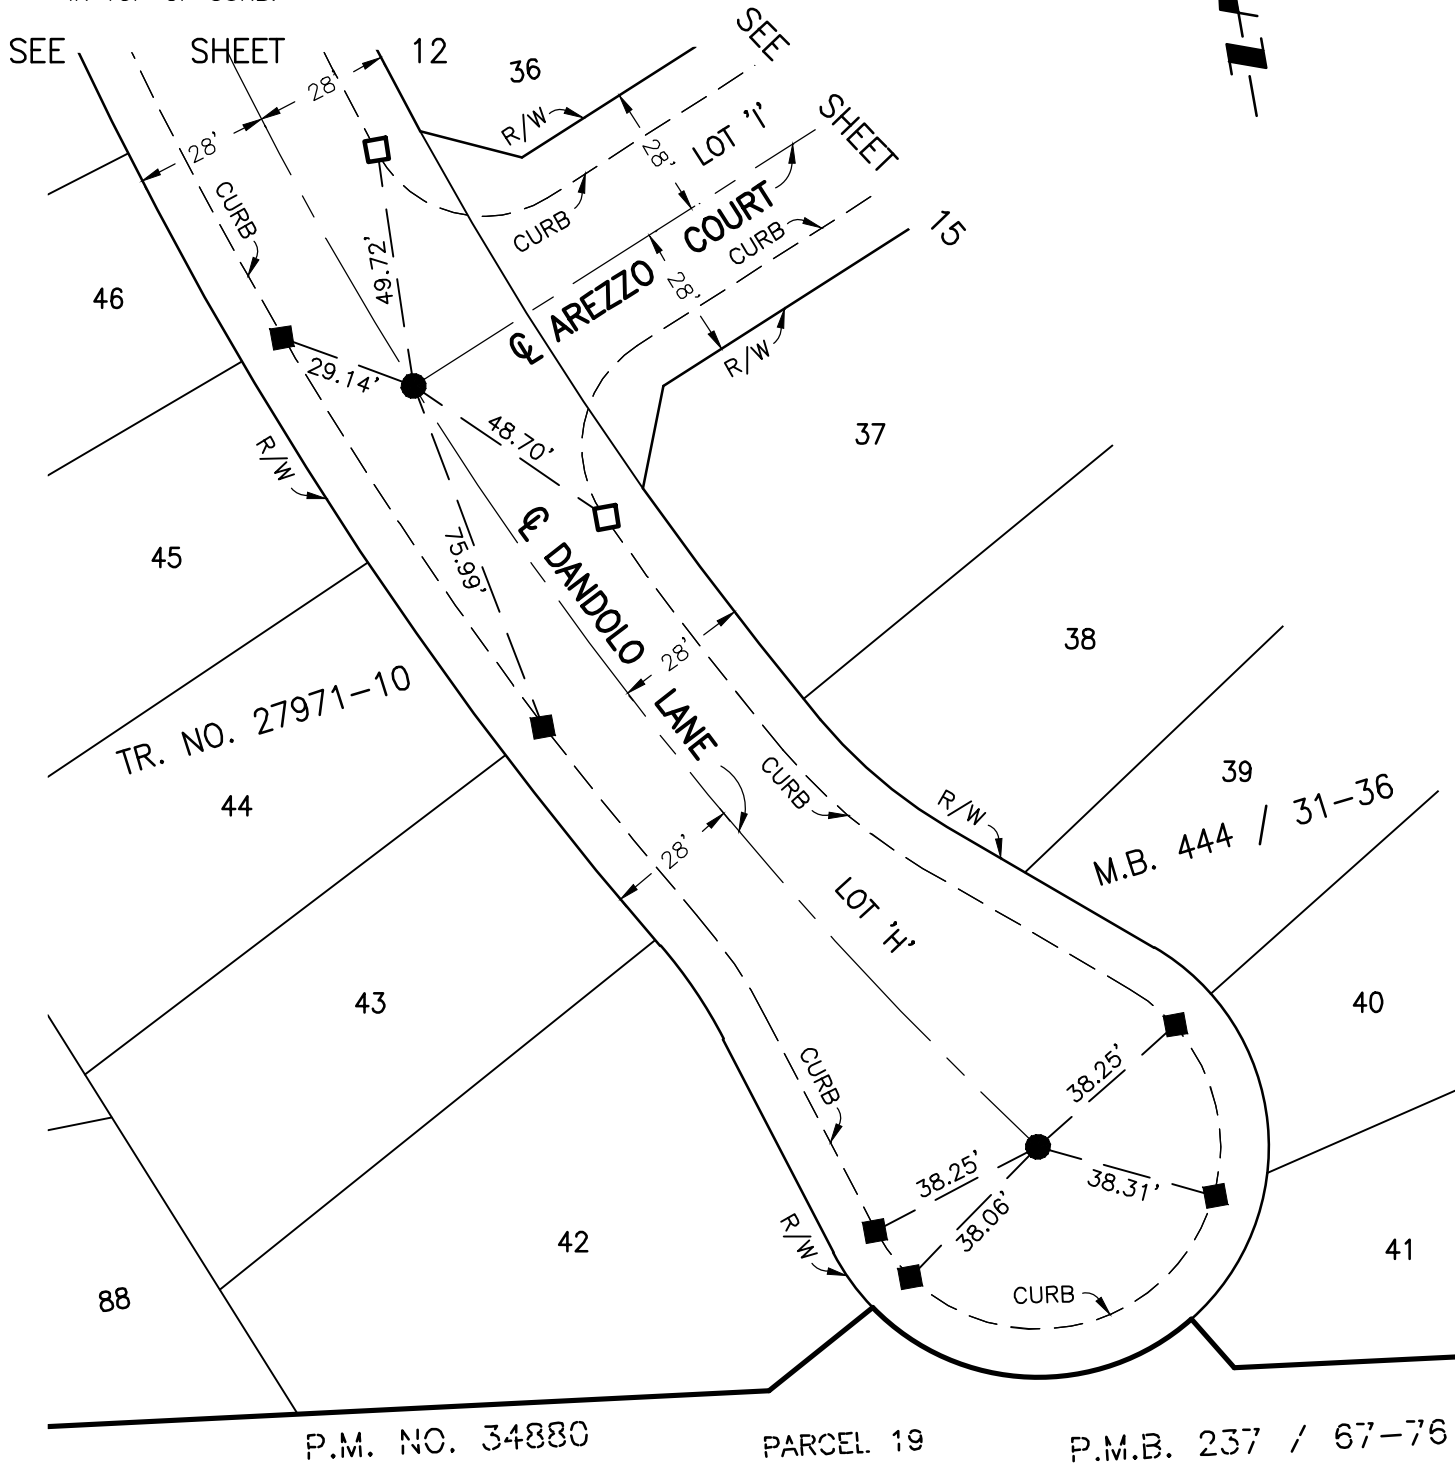

Stantec
 735 East Carnegie Drive, Suite 280
 San Bernardino, CA 92408
 909-335-6116 stantec.com

CENTERLINE TIES
TRACT NO. 27971-10
M.B. 444 / 31-36


DATE: 7/30/24

PUBLIC WORKS DEPARTMENT CITY OF BEAUMONT

SCALE: 1" = 40'
 JN: 2042 495812
 FILE: 495810V-MX7174

LEGEND:

- INDICATES FD. 1" I.P. TAGGED "LS 7185", FLUSH, PER TR. NO. 27971-10, M.B. 444 / 31-36.
- INDICATES SET LEAD & TAG "LS 7185 TIE", IN TOP OF CURB.

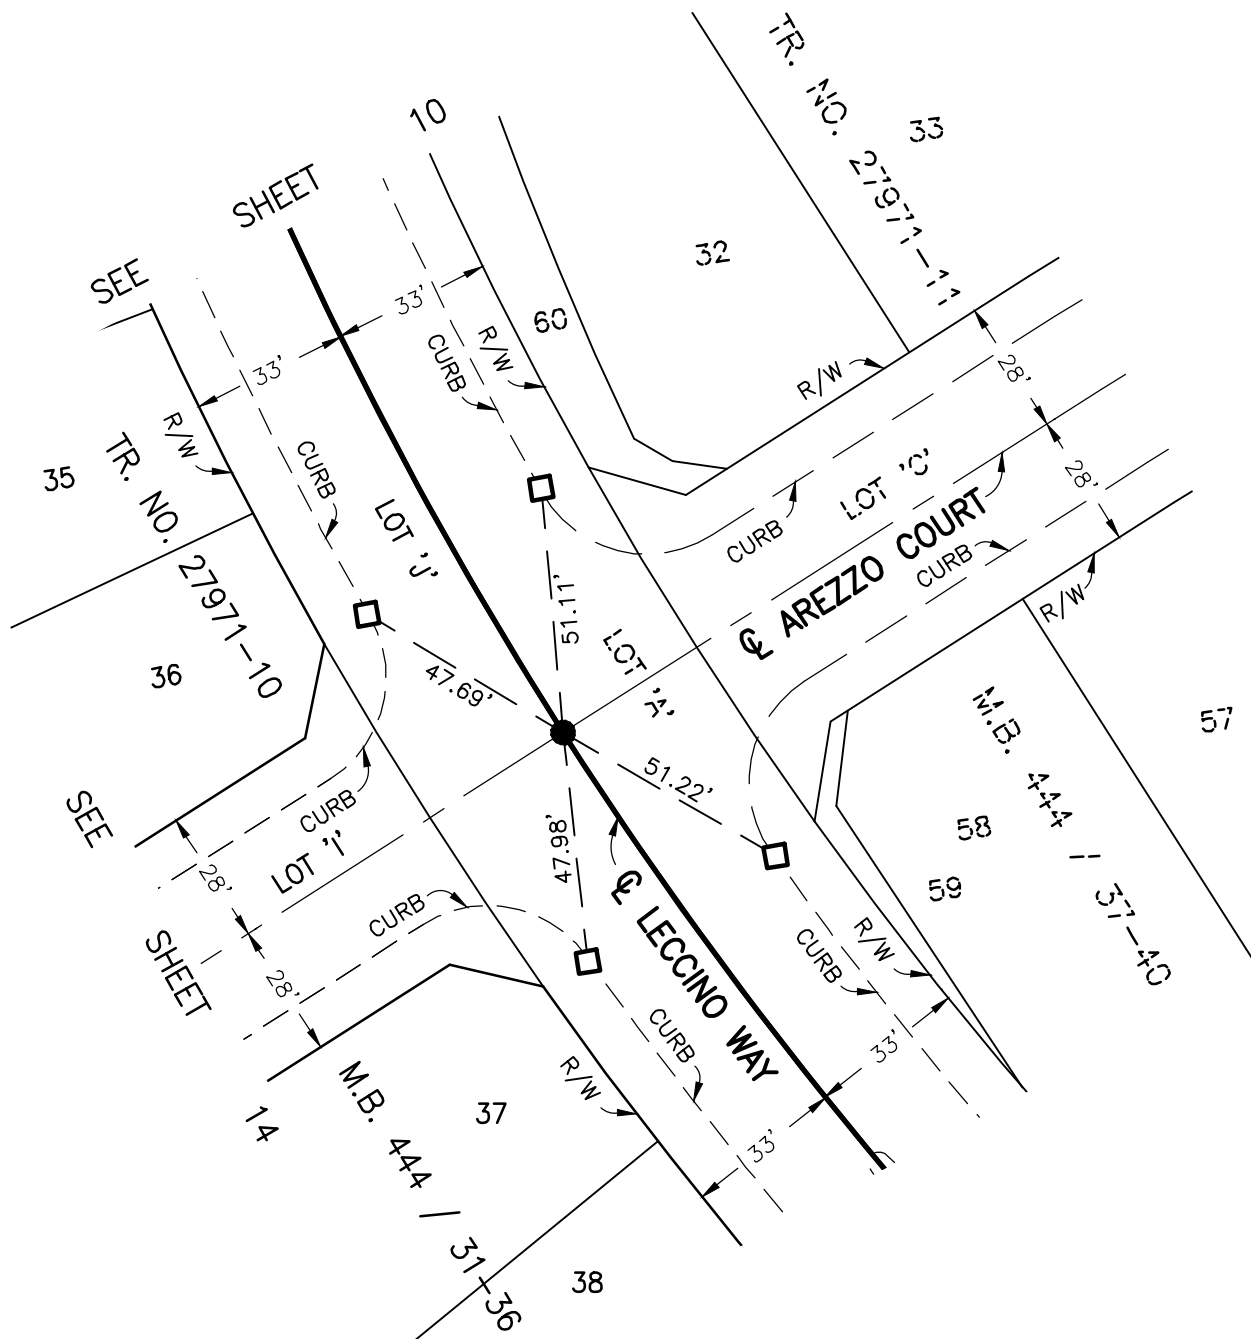

Stantec

735 East Carnegie Drive, Suite 280
 San Bernardino, CA 92408
 909-335-6116 stantec.com

CENTERLINE TIES
TRACT NO. 27971-10
M.B. 444 / 31-36

SCALE: 1" = 40'

JN: 2042 495812

DATE: 7/30/24

PUBLIC WORKS DEPARTMENT CITY OF BEAUMONT

FILE: 495810V-MX7174

IN THE CITY OF BEAUMONT, COUNTY OF RIVERSIDE, STATE OF CALIFORNIA

TRACT NO. 27971-10

BEING A DIVISION OF PARCEL 10, LOTS 'B' AND 'AA' OF PARCEL MAP NO. 34880, RECORDED IN BOOK 237, PAGES 67 THROUGH 76 INCLUSIVE, OF PARCEL MAPS, RECORDS OF RIVERSIDE COUNTY, STATE OF CALIFORNIA, WITHIN SECTION 6, TOWNSHIP 3 SOUTH, RANGE 1 WEST, SAN BERNARDINO MERIDIAN.
FEBRUARY, 2014 STANTEC CONSULTING INC.

NUMBER OF LOTS: 153
NUMBER OF LETTERED LOTS: 10
ACREAGE OF LOTS: 22.01 AC.
ACREAGE OF LETTERED LOTS: 9.55 AC.
TOTAL ACREAGE: 31.56 AC.

RECORDER'S STATEMENT

FILED THIS 23rd DAY OF DECEMBER 2014 AT 10:41 AM IN BOOK 444 OF MAPS, AT PAGES 31-32, AT THE REQUEST OF THE CITY CLERK OF THE CITY OF BEAUMONT.

NO. 2014-0489252
FEE \$ 20.00

LARRY W. WARD
ASSESSOR - COUNTY CLERK - RECORDER
BY: *[Signature]* DEPUTY
SUBDIVISION GUARANTEE: FIDELITY NATIONAL TITLE COMPANY

OWNER'S STATEMENT

WE HEREBY STATE THAT WE ARE THE OWNERS OF THE LAND INCLUDED WITHIN THE SUBDIVISION SHOWN HEREON; THAT WE ARE THE ONLY PERSONS WHOSE CONSENT IS NECESSARY TO PASS A CLEAR TITLE TO SAID LAND; THAT WE CONSENT TO THE MAKING AND RECORDING OF THIS SUBDIVISION MAP AS SHOWN WITHIN THE DISTINCTIVE BORDER LINE.

WE HEREBY DEDICATE TO THE CITY OF BEAUMONT, FOR STREET AND PUBLIC UTILITY PURPOSES, LOT 'A' (HEARTLAND PARKWAY NORTH), LOT 'B' (MONTGOMERY PLACE), LOT 'C' (ALBANY LANE), LOT 'D' (HARRISBURG PLACE), LOT 'E' (LANSING STREET), LOT 'F' (MONTGOMERY PLACE), LOT 'G' (LANSING STREET), LOT 'H' (HAMILTON PLACE), LOT 'I' (DENVER COURT), AND LOT 'J' (HOMESTEAD WAY).

WE HEREBY RETAIN LOTS 152 AND 153, FOR COMMON OPEN SPACE AND LANDSCAPE MAINTENANCE, AS SHOWN HEREON, TO OURSELVES, OUR SUCCESSORS, ASSIGNEES AND LOT OWNERS WITHIN THIS TRACT.

LV HEARTLAND LLC,
A DELAWARE LIMITED LIABILITY COMPANY

BY: *[Signature]*
James Stiklorus
Authorized Signatory

TRUSTEE'S STATEMENT

FIDELITY NATIONAL TITLE INSURANCE COMPANY, AS TRUSTEE UNDER DEED OF TRUST RECORDED JULY 31, 2006 AS INSTRUMENT NO. 2006-557501, OF OFFICIAL RECORDS, AN INSTRUMENT ENTITLED "SECOND AMENDED AND RESTATED CONSTRUCTION DEED OF TRUST AND FIXTURE FILING" RECORDED OCTOBER 04, 2007 AS INSTRUMENT NO. 2007-0619882, OF OFFICIAL RECORDS.

FIDELITY NATIONAL TITLE INSURANCE COMPANY

BY: *[Signature]*
ART CHEYNE
SENIOR VICE PRESIDENT

NOTARY ACKNOWLEDGMENT

STATE OF NEW YORK)
) SS
COUNTY OF NEW YORK)

ON June 17, 2014 BEFORE ME, THE UNDERSIGNED, PERSONALLY APPEARED

James Stiklorus
PERSONALLY KNOWN TO ME (OR PROVED TO ME ON THE BASIS OF SATISFACTORY EVIDENCE) TO BE THE PERSON(S) WHOSE NAME(S) IS/ARE SUBSCRIBED TO THE WITHIN INSTRUMENT AND ACKNOWLEDGED TO ME THAT HE/SHE/THEY EXECUTED THE SAME IN HIS/HER/THEIR AUTHORIZED CAPACITY(IES), AND THAT BY HIS/HER/THEIR SIGNATURE(S) ON THE INSTRUMENT THE PERSON(S), OR THE ENTITY(IES) UPON BEHALF OF WHICH THE PERSON(S) ACTED, EXECUTED THE INSTRUMENT.

MY COMMISSION EXPIRES July 23, 2015

[Signature]
NOTARY PUBLIC
DEANNA BAILLO
DEANNA BAILLO
Notary Public, State of New York
No. 01414931082
Qualified to New York County
Term Expires July 23, 2015

TAX BOND CERTIFICATE

I HEREBY CERTIFY THAT A BOND IN THE SUM OF \$ _____, HAS BEEN EXECUTED AND FILED WITH THE BOARD OF SUPERVISORS OF THE COUNTY OF RIVERSIDE, CALIFORNIA, CONDITIONED UPON THE PAYMENT OF ALL TAXES, STATE, COUNTY, MUNICIPAL, OR LOCAL, AND ALL SPECIAL ASSESSMENTS COLLECTED AS TAXES, WHICH AT THE TIME OF THE FILING OF THIS MAP WITH THE COUNTY RECORDER ARE A LIEN AGAINST SAID PROPERTY BUT NOT YET PAYABLE AND SAID BOND HAS BEEN DULY APPROVED BY SAID BOARD OF SUPERVISORS.

DATED: _____, 20__

CASH OR SURETY TAX BOND
DON KENT
COUNTY TAX COLLECTOR

BY: _____, DEPUTY

SIGNATURE OMISSIONS

PURSUANT TO SECTION 66436 OF THE SUBDIVISION MAP ACT, THE SIGNATURES OF THE FOLLOWING OWNERS OF EASEMENTS AND/OR OTHER INTERESTS HAVE BEEN OMITTED:

1. SOUTHERN PACIFIC PIPELINES, A CORPORATION, HOLDER OF AN EASEMENT FOR PIPELINES AS RECORDED JUNE 16, 1955 AS INSTRUMENT NO. 39399 OF OFFICIAL RECORDS OF RIVERSIDE COUNTY. THE EXACT LOCATION AND EXTENT OF SAID EASEMENT IS NOT DISCLOSED OF RECORD.

GEOTECHNICAL REPORT NOTE:

PRELIMINARY GEOTECHNICAL INVESTIGATION REPORT FOR TENTATIVE TRACT MAP NO. 27971 DATED OCTOBER 6, 2006 AS PROJECT NO. 700136 WAS PREPARED BY PACIFIC SOILS ENGINEERING, INC. AS REQUIRED BY SECTIONS 17853 OF THE CALIFORNIA HEALTH AND SAFETY CODE AND IS REQUIRED BY SECTION 66434.5 OF THE CALIFORNIA GOVERNMENT CODE. A COPY OF SAID REPORT IS ON FILE FOR PUBLIC INSPECTION IN THE CITY ENGINEERS OFFICE.

NOTARY ACKNOWLEDGMENT

STATE OF California
COUNTY OF Orange

ON Aug 21, 2014 BEFORE ME Dena Marie Seovel, Notary Public PERSONALLY APPEARED Art Cheyne WHO PROVED TO ME ON THE BASIS OF SATISFACTORY EVIDENCE TO BE THE PERSON(S) WHOSE NAME(S) IS/ARE SUBSCRIBED TO THE WITHIN INSTRUMENT AND ACKNOWLEDGED TO ME THAT HE/SHE/THEY EXECUTED THE SAME IN HIS/HER/THEIR AUTHORIZED CAPACITY(IES), AND THAT BY HIS/HER/THEIR SIGNATURE(S) ON THE INSTRUMENT THE PERSON(S), OR THE ENTITY UPON BEHALF OF WHICH THE PERSON(S) ACTED, EXECUTED THE INSTRUMENT.

I CERTIFY UNDER PENALTY OF PERJURY, UNDER THE LAWS OF THE STATE OF CALIFORNIA, THAT THE FOREGOING PARAGRAPH IS THE TRUE AND CORRECT.

WITNESS MY HAND:
[Signature]
Dena Marie Seovel
SIGNATURE
Dena Marie Seovel
(PRINT NAME)

MY COMMISSION EXPIRES Aug 24, 2015
MY PRINCIPAL PLACE OF BUSINESS IS Orange COUNTY.

TAX COLLECTOR'S CERTIFICATE

I HEREBY CERTIFY THAT ACCORDING TO THE RECORDS OF THIS OFFICE, AS OF THIS DATE, THERE ARE NO LIENS AGAINST THE PROPERTY SHOWN ON THE WITHIN MAP FOR UNPAID STATE, COUNTY, MUNICIPAL, OR LOCAL TAXES OR SPECIAL ASSESSMENTS COLLECTED AS TAXES, EXCEPT TAXES OR SPECIAL ASSESSMENTS COLLECTED AS TAXES, NOW A LIEN BUT NOT YET PAYABLE, WHICH ARE ESTIMATED TO BE \$ _____

DATED: October 21, 2014


DON KENT, COUNTY TAX COLLECTOR
BY: *[Signature]* DEPUTY

SURVEYOR'S STATEMENT

THIS MAP WAS PREPARED BY ME OR UNDER MY DIRECTION AND IS BASED ON A FIELD SURVEY IN CONFORMANCE WITH THE REQUIREMENTS OF THE SUBDIVISION MAP ACT AND LOCAL ORDINANCE AT THE REQUEST OF LV HEARTLAND, LLC ON FEBRUARY, 2014. I HEREBY STATE THAT ALL MONUMENTS ARE OF THE CHARACTER AND OCCUPY THE POSITIONS INDICATED, OR THAT THEY WILL BE SET IN ACCORDANCE WITH THE TERMS OF THE MONUMENT AGREEMENT FOR THE MAP AND THAT THE MONUMENTS ARE, OR WILL BE, SUFFICIENT TO ENABLE THE SURVEY TO BE RETRACED, AND THAT THIS FINAL MAP SUBSTANTIALLY CONFORMS TO THE CONDITIONALLY APPROVED TENTATIVE MAP. THIS SURVEY IS TRUE AND COMPLETE AS SHOWN.

DATED: JUNE 12, 2014

[Signature]
RAY E. MANSUR, P.L.S. 7185

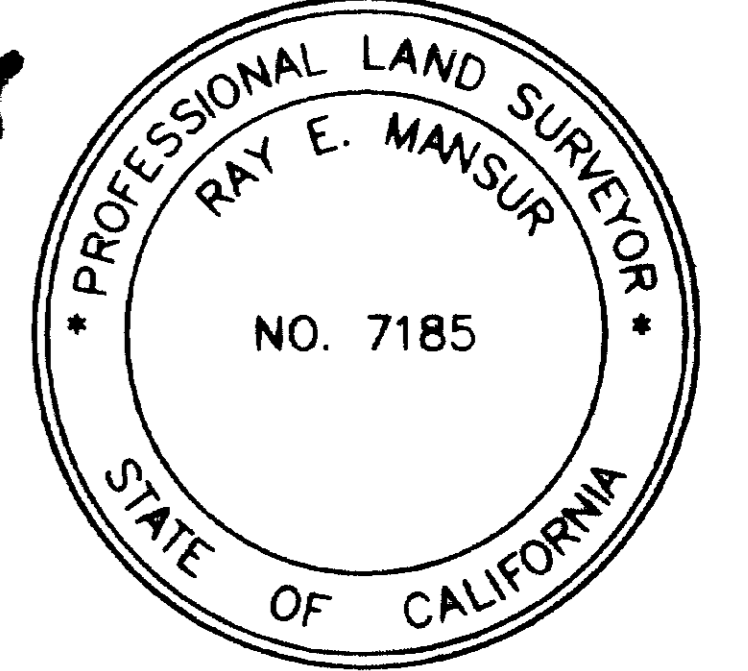


CITY ENGINEER'S STATEMENT

I HEREBY STATE THAT I HAVE EXAMINED THE WITHIN MAP, THAT THE SUBDIVISION AS SHOWN HEREON IS SUBSTANTIALLY THE SAME AS IT APPEARED ON THE AMENDED TENTATIVE MAP OF TRACT NO. 27971, BY THE BEAUMONT CITY COUNCIL ON AUGUST 2, 2005, AND ANY APPROVED ALTERATION THEREOF; THAT ALL PROVISIONS OF THE SUBDIVISION MAP ACT AND OF TITLE 16 OF THE BEAUMONT MUNICIPAL CODE APPLICABLE AT THE TIME OF THE APPROVAL OF THE TENTATIVE MAP HAVE BEEN COMPLIED WITH; THAT I AM SATISFIED THAT THE MAP IS TECHNICALLY CORRECT; THAT THE PLANS FOR THE DRAINS, DRAINAGE WORKS, AND SEWERS SUFFICIENT TO PROTECT ALL LOTS IN THE SUBDIVISION FROM FLOODS HAVE BEEN APPROVED; THAT A COMPLETE SET OF PLANS FOR THE CONSTRUCTION OF ALL REQUIRED IMPROVEMENTS HAS BEEN FILED WITH THE COMMUNITY DEVELOPMENT DEPARTMENT AND THAT THE SAME HAVE BEEN CHECKED AND APPROVED; AND THAT ALL IMPROVEMENTS HAVE BEEN COMPLETED IN ACCORDANCE WITH THE APPROVED PLANS OR THAT THE SUBDIVIDER HAS ENTERED INTO AGREEMENT WITH THE CITY OF BEAUMONT COVERING COMPLETION OF ALL IMPROVEMENTS AND SPECIFYING THE TIME FOR COMPLETING THE SAME AS MAY BE REQUIRED BY CONDITIONS OF APPROVAL DATED AUGUST 2, 2005.

FOR: DEEPAK MOORJANI, R.C.E. 51047,
CITY ENGINEER, CITY OF BEAUMONT

DATED: 20 OCTOBER, 2014

[Signature]
DENNIS W. JANDA, P.L.S. 6359
EXPIRES 12/31/2014

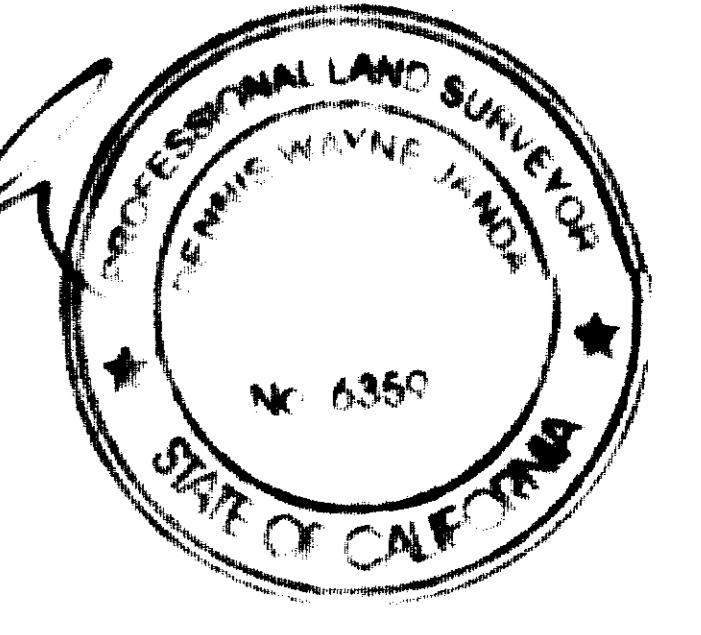

BEAUMONT CITY COUNCIL CERTIFICATE

I HEREBY CERTIFY THAT THIS MAP WAS APPROVED BY THE CITY COUNCIL OF THE CITY OF BEAUMONT ON 11th DAY OF December OF 2014, AND THAT THE OFFERS OF DEDICATIONS DEPICTED HEREON WERE NOT ACCEPTED. THE CITY COUNCIL MAY, HOWEVER, BY RESOLUTION AT ANY LATER DATE, AND WITHOUT FURTHER ACTION BY THE SUBDIVIDER, RESCIND ITS ACTION AND ACCEPT THE FOLLOWING DEDICATIONS AND IMPROVEMENTS FOR PUBLIC USE, WHICH ACCEPTANCE SHALL BE RECORDED IN THE OFFICE OF THE RIVERSIDE COUNTY RECORDER.

FOR STREET AND PUBLIC UTILITY PURPOSES LOT 'A' (HEARTLAND PARKWAY NORTH), LOT 'B' (MONTGOMERY PLACE), LOT 'C' (ALBANY LANE), LOT 'D' (HARRISBURG PLACE), LOT 'E' (LANSING STREET), LOT 'F' (MONTGOMERY PLACE), LOT 'G' (LANSING STREET), LOT 'H' (HAMILTON PLACE), LOT 'I' (DENVER COURT), AND LOT 'J' (HOMESTEAD WAY).

DATED: 12-18, 2014


[Signature]
CITY CLERK, CITY OF BEAUMONT
RIVERSIDE COUNTY, CALIFORNIA

2014-0489252 ORIGINAL

444 32

TRACT NO. 27971-10

BEING A DIVISION OF PARCEL 10, LOTS 'B' AND 'AA' OF PARCEL MAP NO. 34880, RECORDED IN BOOK 237, PAGES 67 THROUGH 76, INCLUSIVE, OF PARCEL MAPS, RECORDS OF RIVERSIDE COUNTY, STATE OF CALIFORNIA, WITHIN SECTION 6, TOWNSHIP 3 SOUTH, RANGE 1 WEST, SAN BERNARDINO MERIDIAN.
 FEBRUARY, 2014 STANTEC CONSULTING INC.

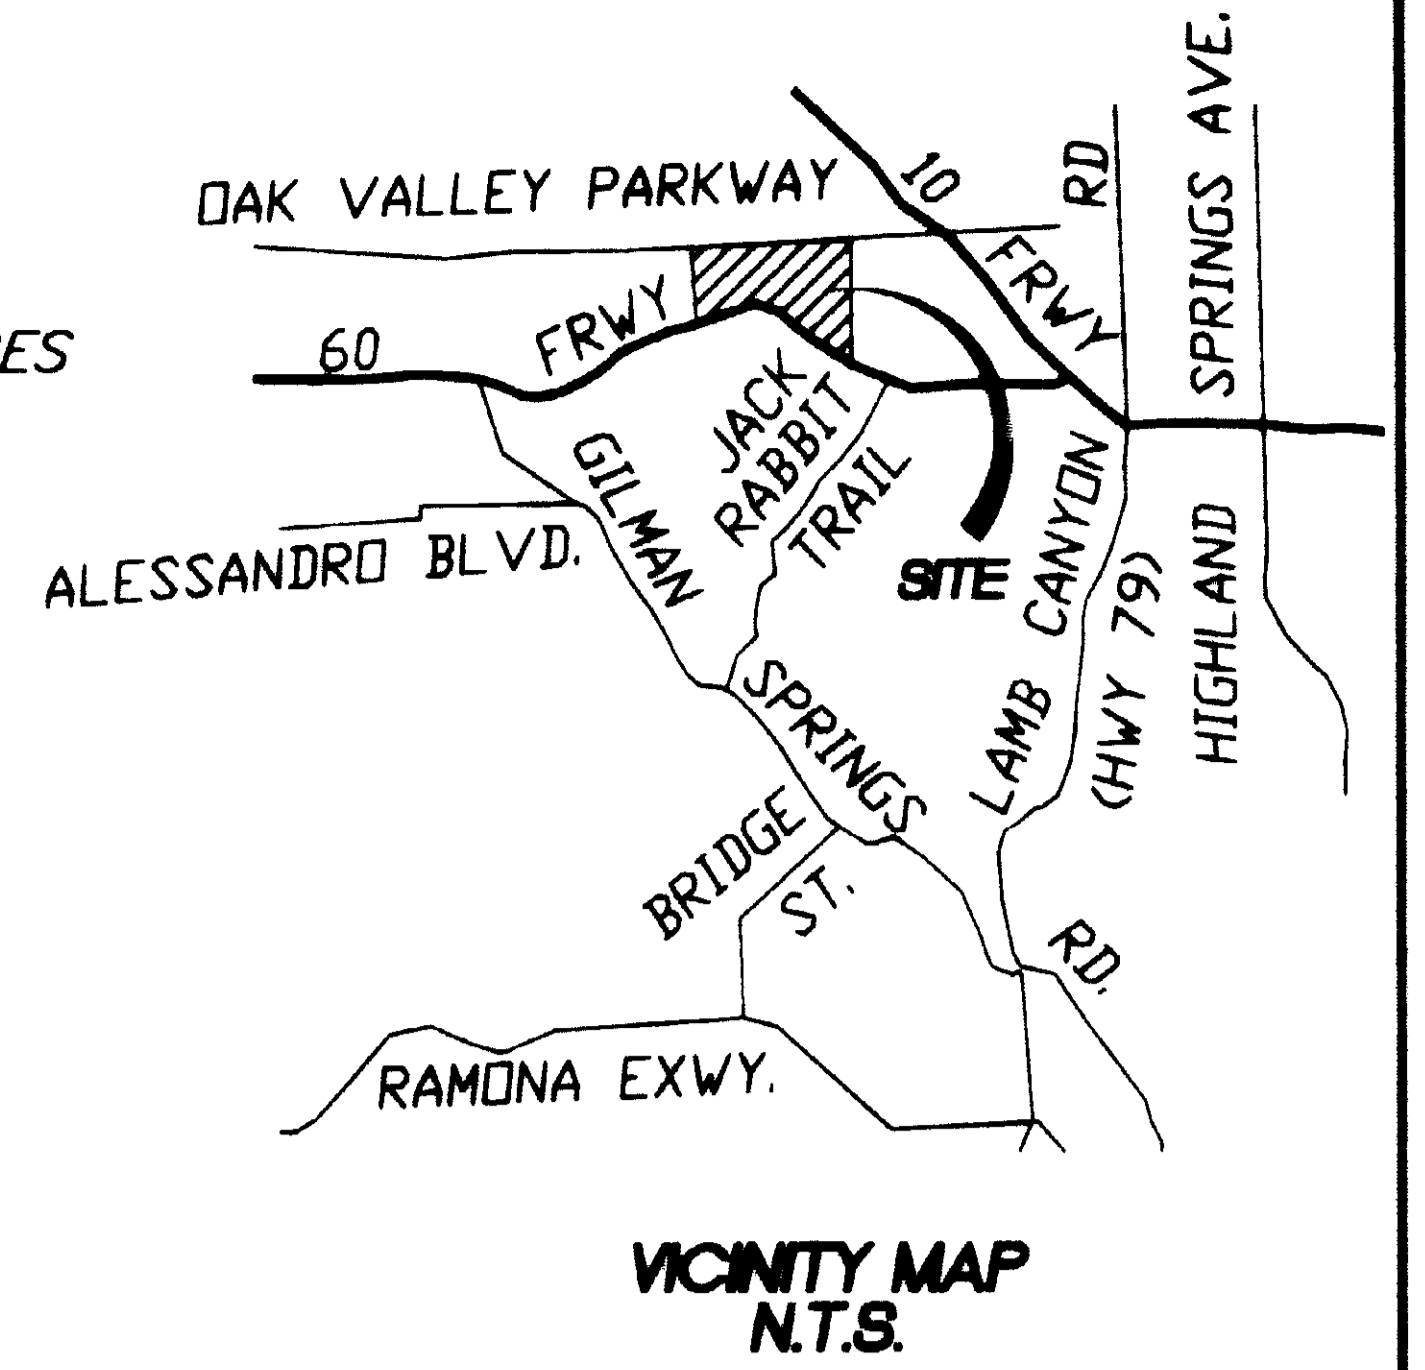

BOUNDARY AND INDEX SHEET

EASEMENT NOTE



THE EXACT LOCATIONS OF FOLLOWING EASEMENTS ARE NOT DISCLOSED FROM RECORDS:
 AN EASEMENT IN FAVOR OF SOUTHERN PACIFIC PIPELINES FOR PIPELINES AS RECORDED JUNE 16, 1955 AS INSTRUMENT NO. 39399 OF OFFICIAL RECORDS OF RIVERSIDE COUNTY.

BASIS OF BEARINGS

THE BASIS OF BEARINGS FOR THIS SURVEY IS THE CALIFORNIA STATE PLANE COORDINATE SYSTEM, CCS83, ZONE 6, BASED LOCALLY ON CONTROL STATIONS "RABBIT" AND "REST", NAD 83(2002) AS SHOWN HEREON, HAVING A GRID BEARING OF N 27°30'52" E. ALL BEARINGS SHOWN ON THIS MAP ARE GRID BEARINGS AND DISTANCES FROM REFERENCE MAPS OR DEEDS ARE AS SHOWN PER THAT RECORD REFERENCE. ALL DISTANCES SHOWN ARE GROUND DISTANCES UNLESS SPECIFIED OTHERWISE. GRID DISTANCES MAY BE OBTAINED BY MULTIPLYING THE GROUND DISTANCE BY A COMBINATION FACTOR OF 0.999904925. CALCULATIONS ARE MADE AT STATION RABBIT WITH COORDINATES N 2284367.50 E 6323791.93, USING AN ELEVATION OF 2366.92 FEET.

- CONTROL STATION "RABBIT"
 NATIONAL GEODETIC SURVEY, CALIFORNIA DIVISION OF HIGHWAYS DISK SET IN TOP OF CONCRETE STAMPED "RABBIT". HORIZONTAL ORDER = SECOND. HORIZONTAL DATUM IS NAD 83.
 N 2284367.50 E 6323791.93
- CONTROL STATION "REST"
 NATIONAL GEODETIC SURVEY, CALIFORNIA DIVISION OF HIGHWAYS DISK SET IN TOP OF CONCRETE MONUMENT STAMPED "REST 1972". HORIZONTAL ORDER = SECOND, VERTICAL ORDER = FIRST, CLASS II. HORIZONTAL DATUM IS NAD 83.
 N 2292862.27 E 6328245.05

LINE	BEARING	LENGTH
L1	(N17°55'29"W)	(R) (5.00')
L2	(N06°30'17"E)	(52.39')
L3	(N03°19'25"E)	(52.76')
L4	(N00°52'43"E)	(51.53')
L5	(N02°17'13"W)	(55.00')
L6	(N03°22'18"W)	(49.26')

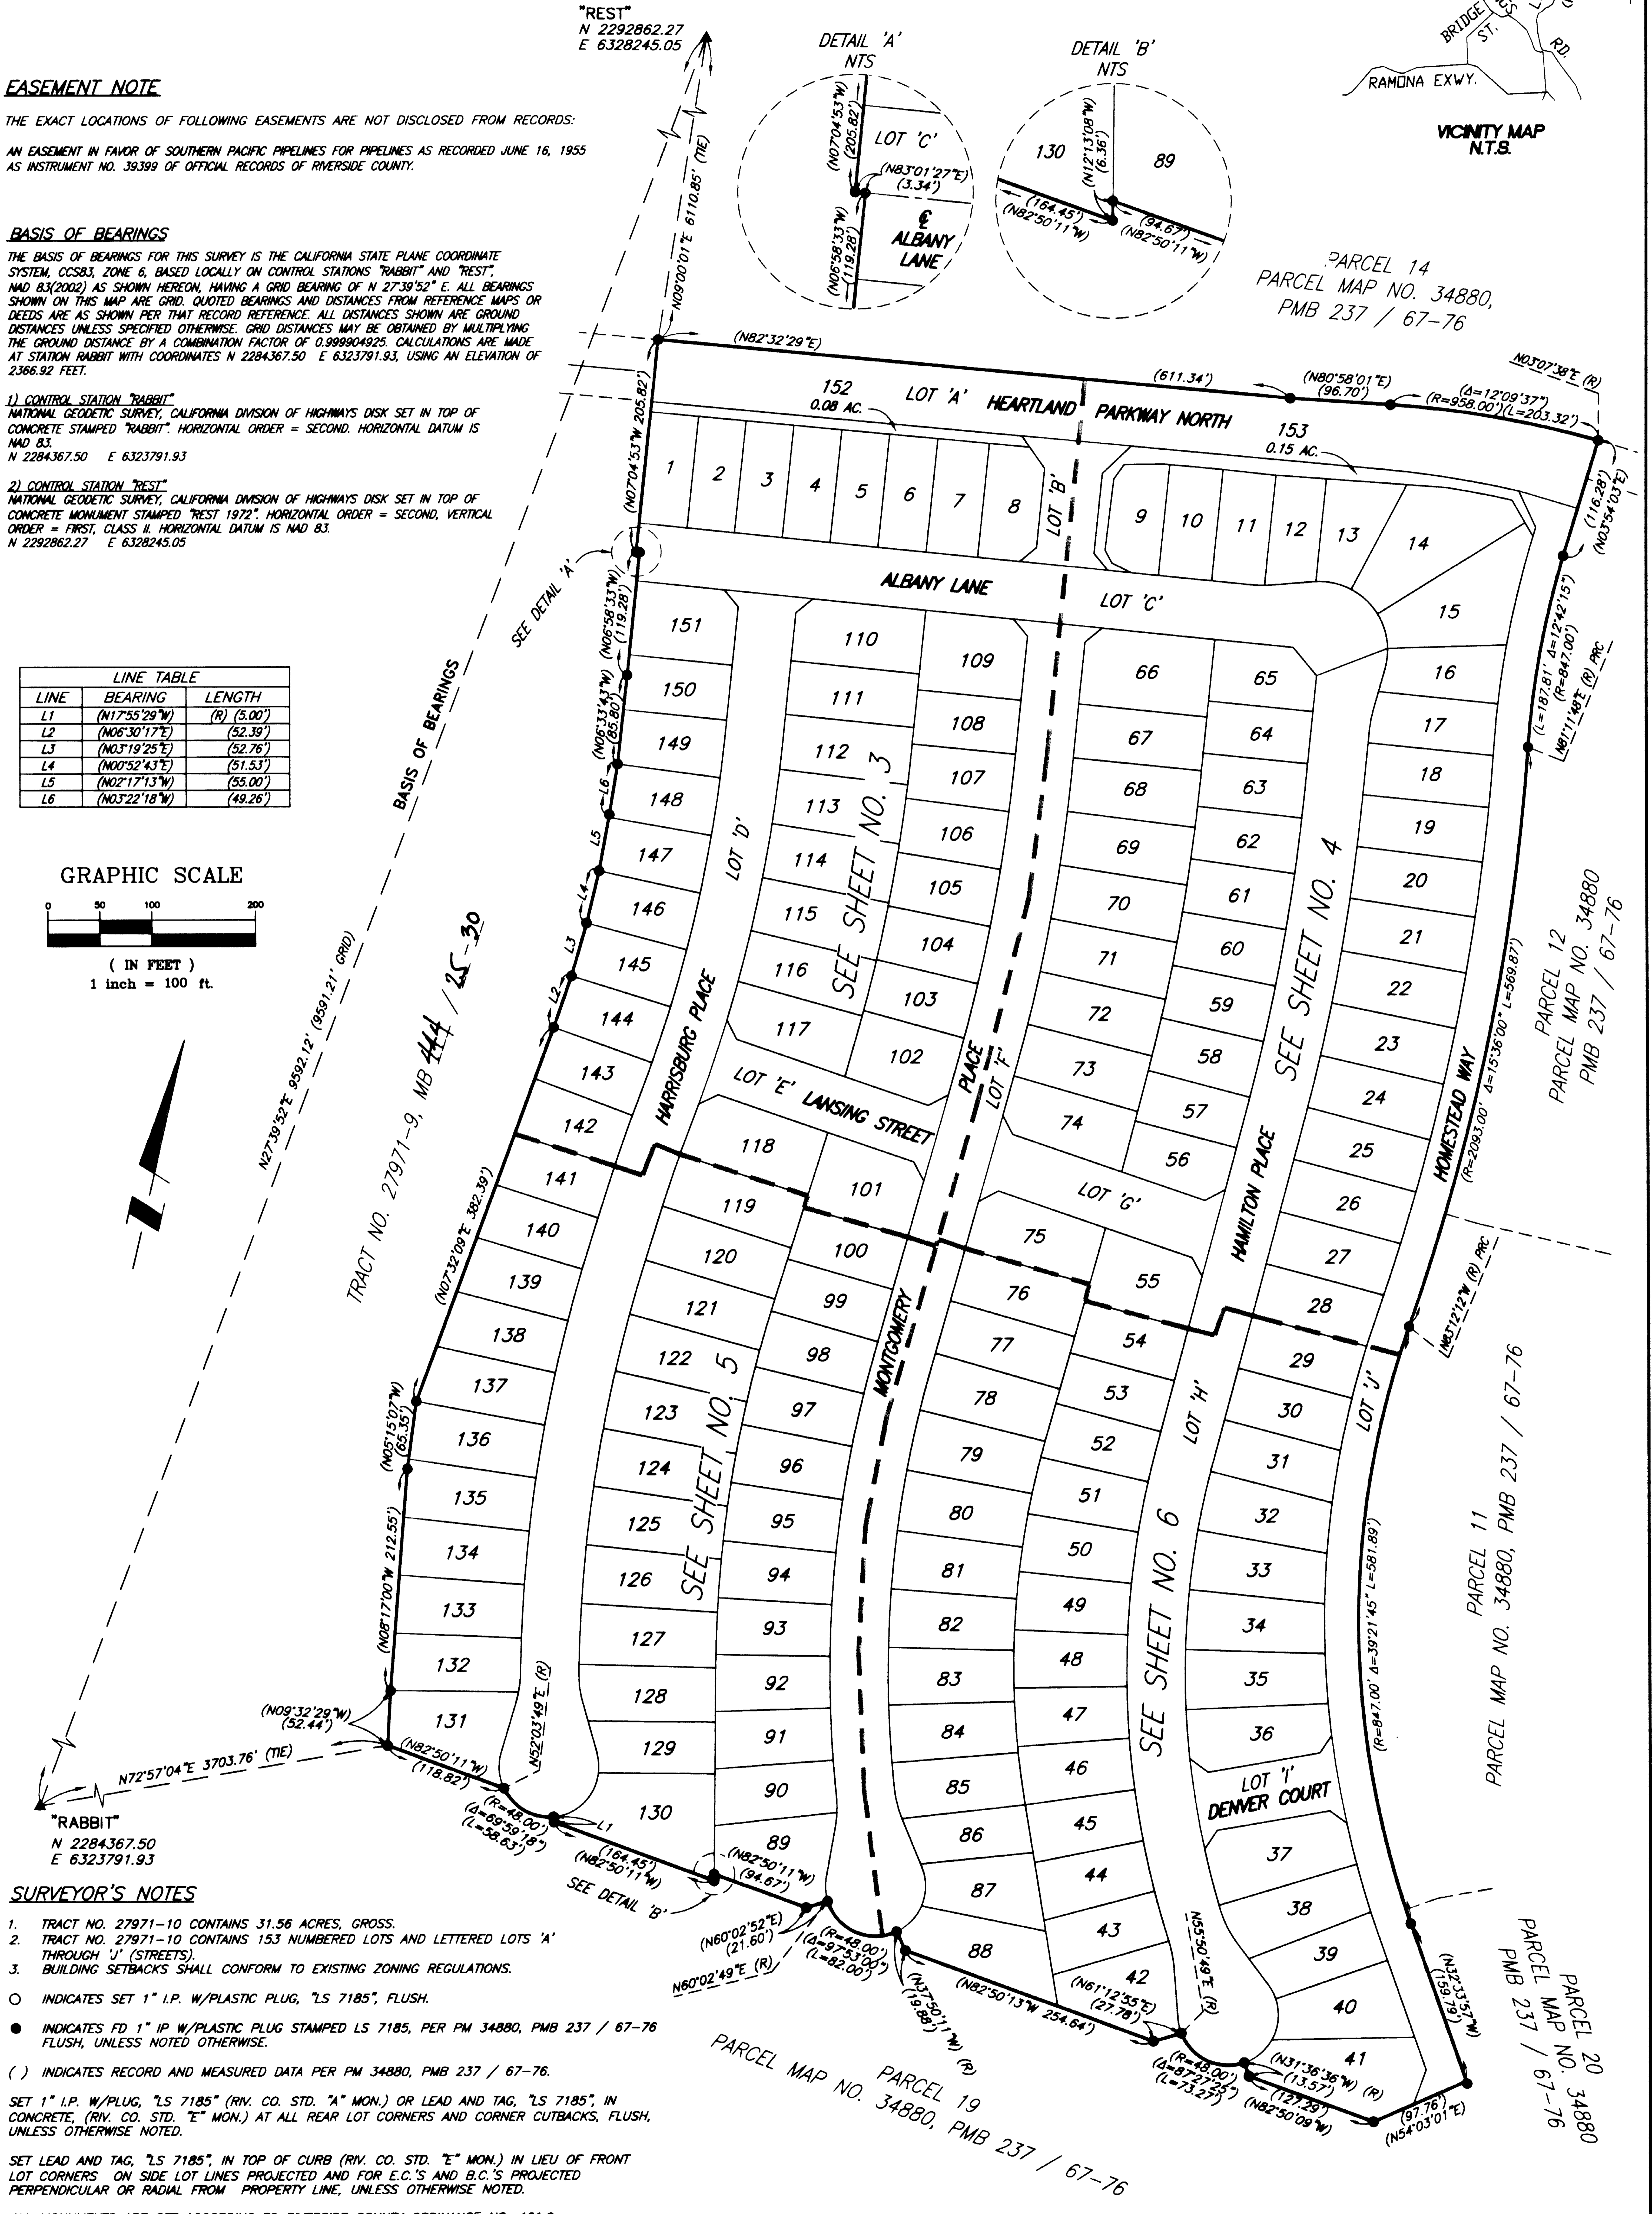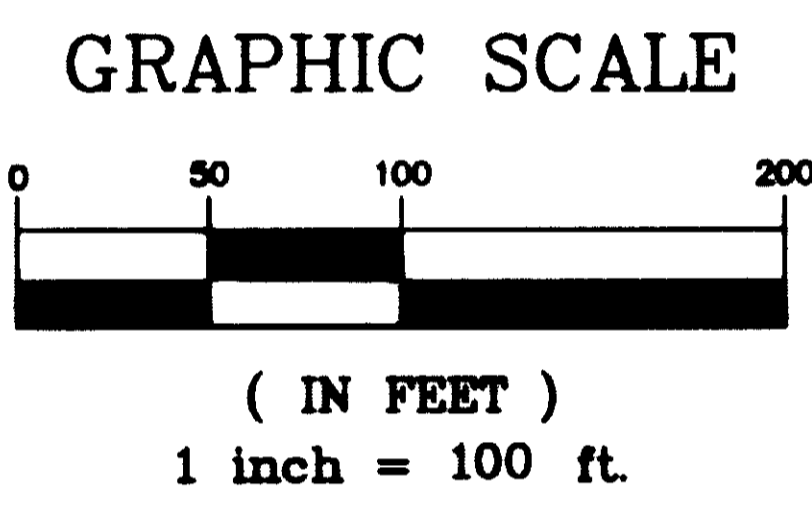

SURVEYOR'S NOTES

- TRACT NO. 27971-10 CONTAINS 31.56 ACRES, GROSS.
 - TRACT NO. 27971-10 CONTAINS 153 NUMBERED LOTS AND LETTERED LOTS 'A' THROUGH 'J' (STREETS).
 - BUILDING SETBACKS SHALL CONFORM TO EXISTING ZONING REGULATIONS.
- INDICATES SET 1" I.P. W/PLASTIC PLUG, "LS 7185", FLUSH.
 - INDICATES FD 1" IP W/PLASTIC PLUG STAMPED LS 7185, PER PM 34880, PMB 237 / 67-76 FLUSH, UNLESS NOTED OTHERWISE.
 - () INDICATES RECORD AND MEASURED DATA PER PM 34880, PMB 237 / 67-76.
- SET 1" I.P. W/PLUG, "LS 7185" (RIV. CO. STD. "A" MON.) OR LEAD AND TAG, "LS 7185", IN CONCRETE, (RIV. CO. STD. "E" MON.) AT ALL REAR LOT CORNERS AND CORNER CUTBACKS, FLUSH, UNLESS OTHERWISE NOTED.
- SET LEAD AND TAG, "LS 7185", IN TOP OF CURB (RIV. CO. STD. "E" MON.) IN LIEU OF FRONT LOT CORNERS ON SIDE LOT LINES PROJECTED AND FOR E.C.'S AND B.C.'S PROJECTED PERPENDICULAR OR RADIAL FROM PROPERTY LINE, UNLESS OTHERWISE NOTED.
- ALL MONUMENTS ARE SET ACCORDING TO RIVERSIDE COUNTY ORDINANCE NO. 461.9

444
33
2014-0489252
ORIGINAL




SEE SHEET 2 FOR SURVEYOR'S AND EASEMENT NOTES

IN THE CITY OF BEAUMONT, COUNTY OF RIVERSIDE, STATE OF CALIFORNIA

SHEET 3 OF 6 SHEETS

TRACT NO. 27971-10

BEING A DIVISION OF PARCEL 10, LOTS 'B' AND 'AA' OF PARCEL MAP NO. 34880, RECORDED IN BOOK 237, PAGES 67 THROUGH 76, INCLUSIVE, OF PARCEL MAPS, RECORDS OF RIVERSIDE COUNTY, STATE OF CALIFORNIA, WITHIN SECTION 6, TOWNSHIP 3 SOUTH, RANGE 1 WEST, SAN BERNARDINO MERIDIAN.
FEBRUARY, 2014 STANTEC CONSULTING INC.

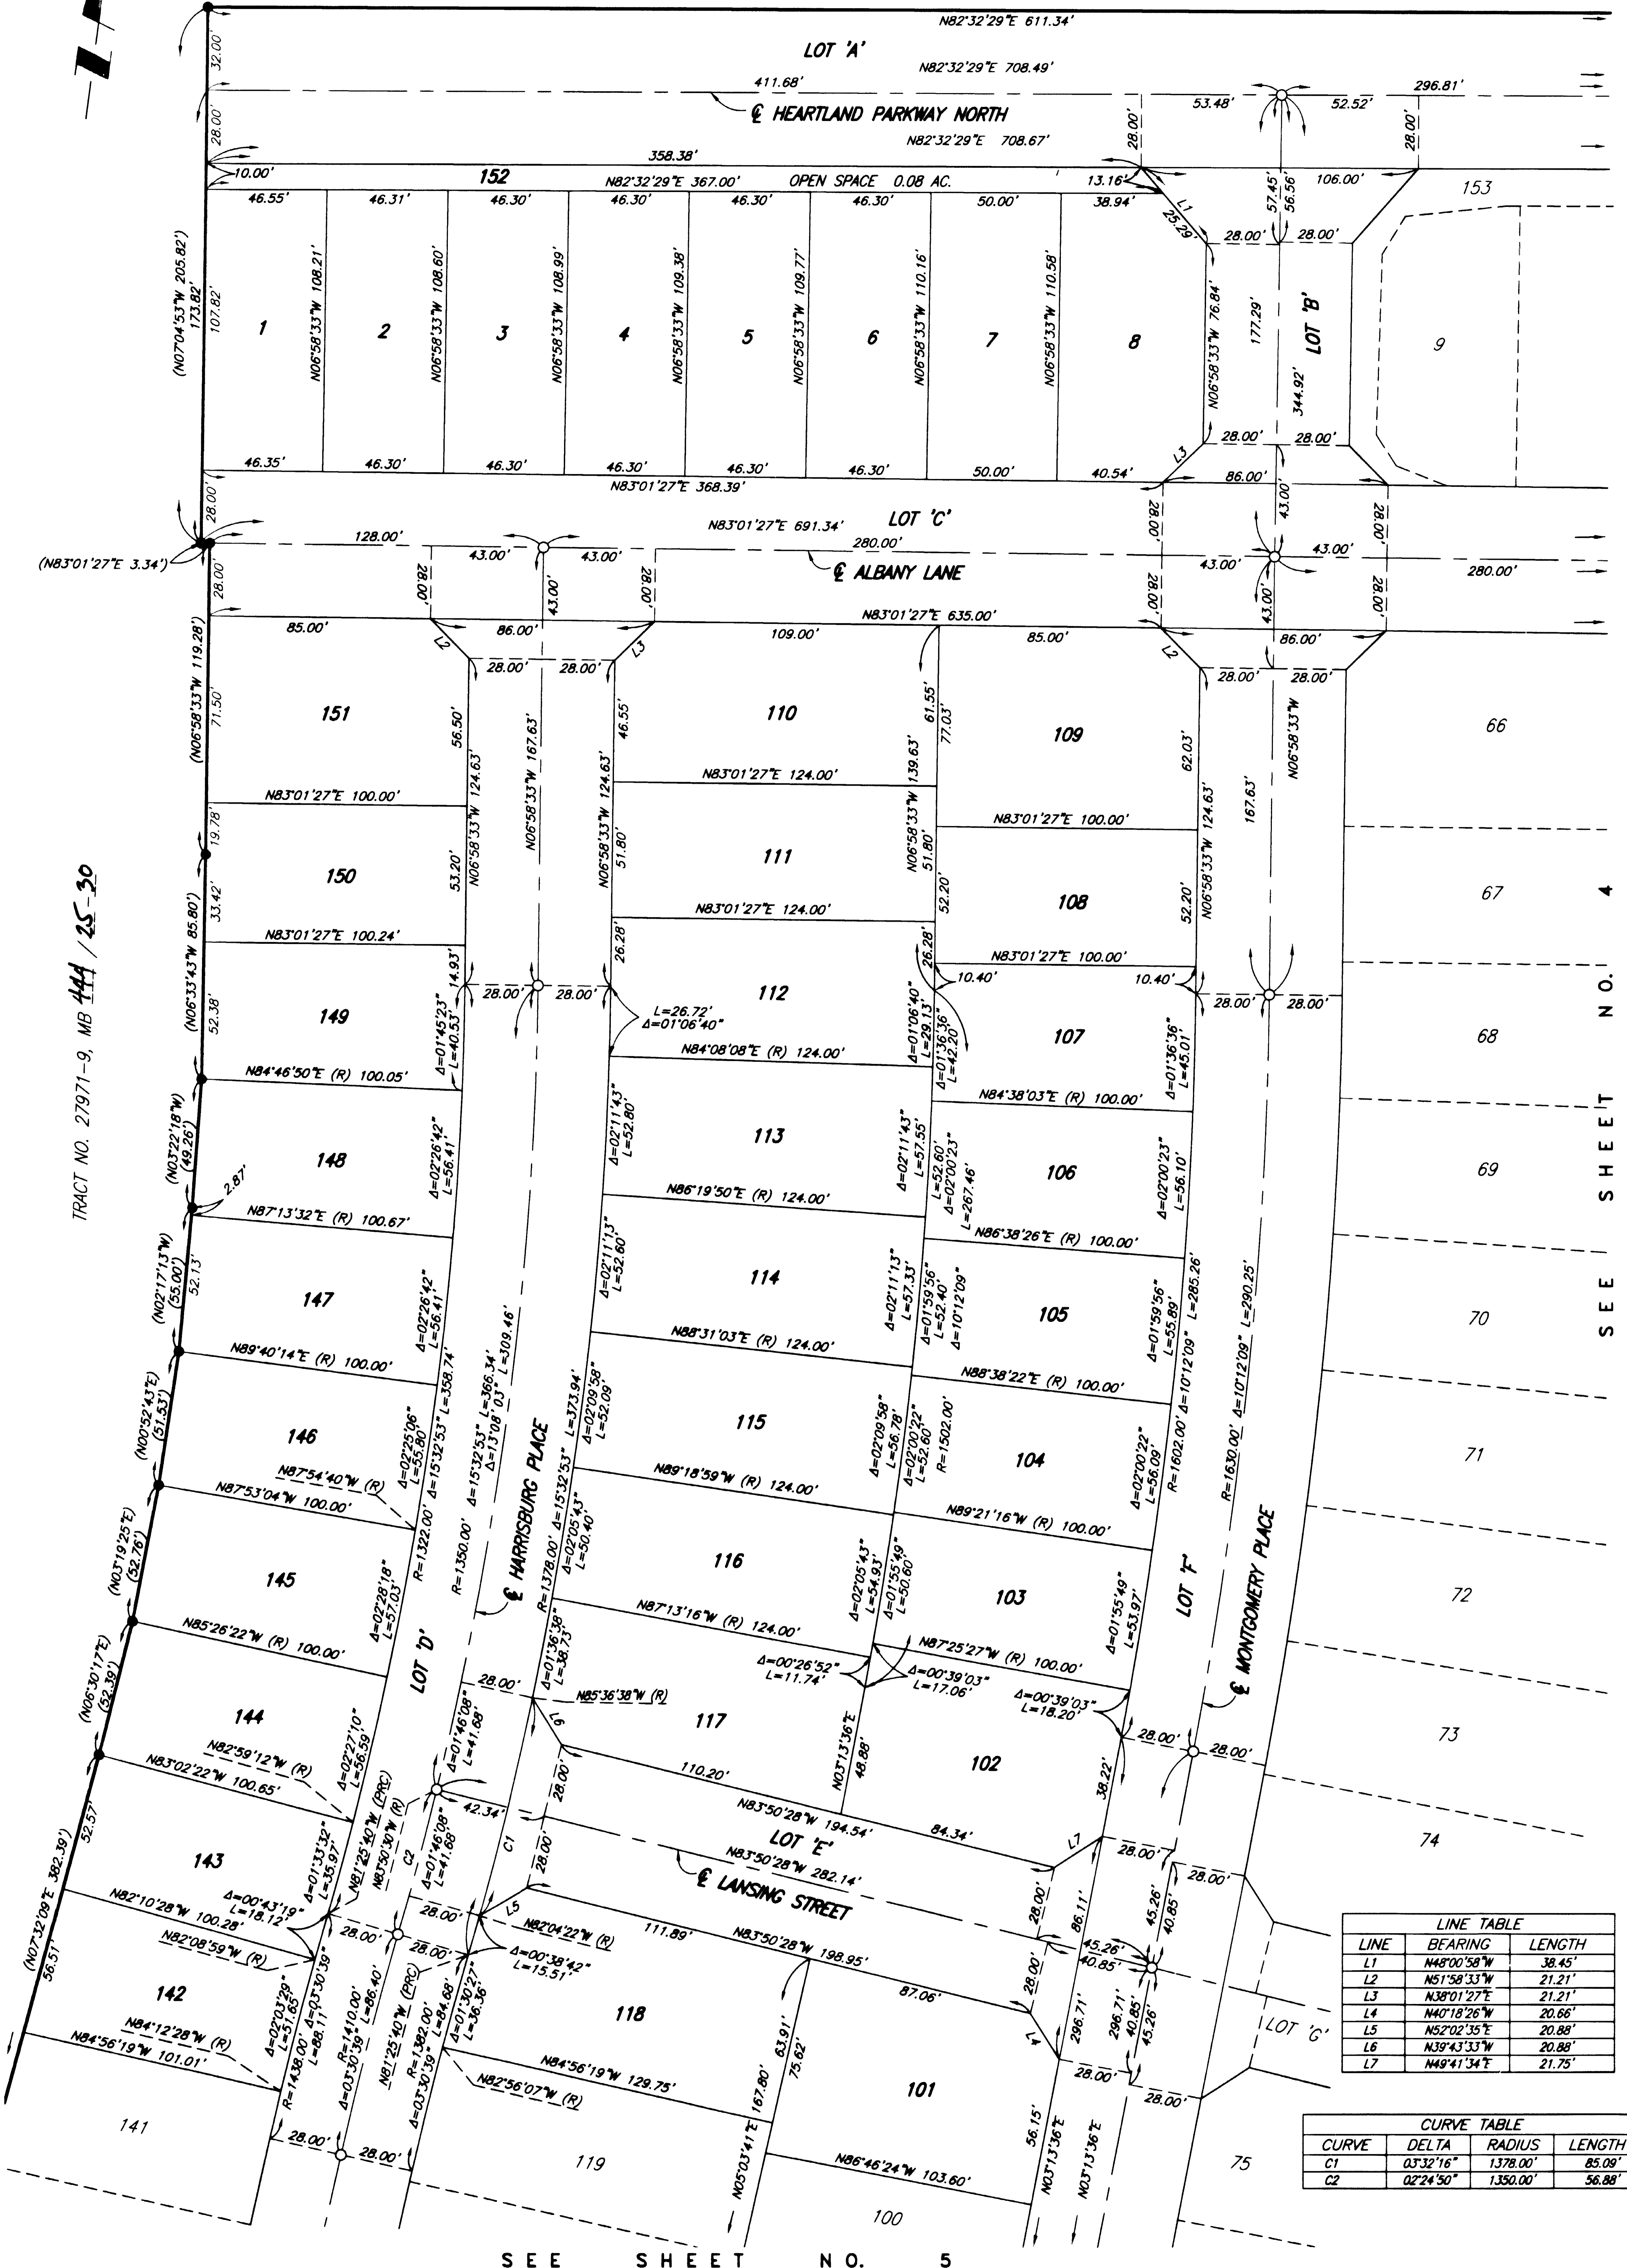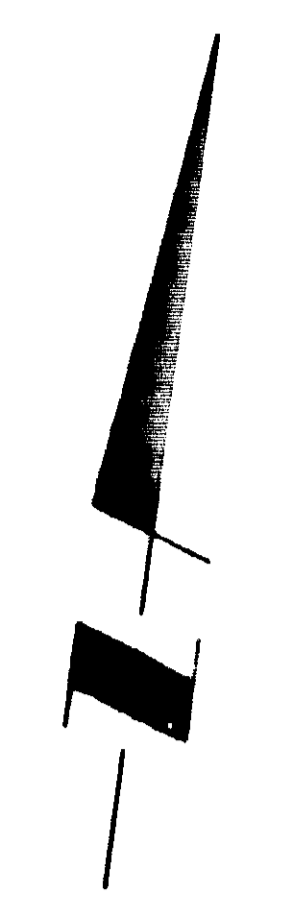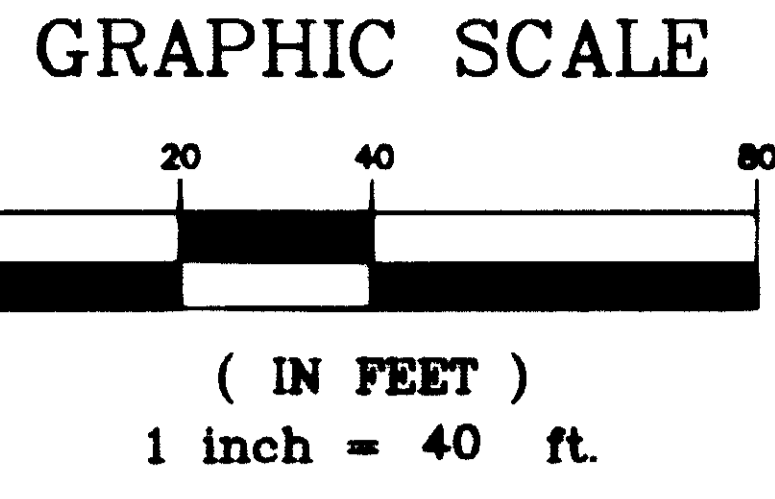

TRACT NO. 27971-9, MB 444 / 25-30

SEE SHEET NO. 4

SEE SHEET NO. 5

LINE TABLE		
LINE	BEARING	LENGTH
L1	N48°00'58"W	38.45'
L2	N51°58'33"W	21.21'
L3	N38°01'27"E	21.21'
L4	N40°18'26"W	20.86'
L5	N52°02'35"E	20.88'
L6	N39°43'33"W	20.88'
L7	N49°41'34"E	21.75'

CURVE TABLE			
CURVE	DELTA	RADIUS	LENGTH
C1	03°32'16"	1378.00'	85.08'
C2	02°24'50"	1350.00'	56.88'


2014-0489252 ORIGINAL

TRACT NO. 27971-10

CURVE TABLE			
CURVE	DELTA	RADIUS	LENGTH
C1	10°17'48"	100.00'	17.97'
C2	03°29'54"	100.00'	6.10'
C3	01°47'21"	66.00'	2.06'

BEING A DIVISION OF PARCEL 10, LOTS 'B' AND 'AA' OF PARCEL MAP NO. 34880, RECORDED IN BOOK 237, PAGES 67 THROUGH 76, INCLUSIVE, OF PARCEL MAPS, RECORDS OF RIVERSIDE COUNTY, STATE OF CALIFORNIA, WITHIN SECTION 6, TOWNSHIP 3 SOUTH, RANGE 1 WEST, SAN BERNARDINO MERIDIAN.
 FEBRUARY, 2014 STANTEC CONSULTING INC.

LINE TABLE		
LINE	BEARING	LENGTH
L1	N86°05'57"W	58.83'
L2	N37°50'55"W	38.79'
L3	N42°54'36"W	40.47'
L4	N03°54'03"E	18.84'
L5	N51°58'33"W	21.21'
L6	N56°08'15"E	73.43'

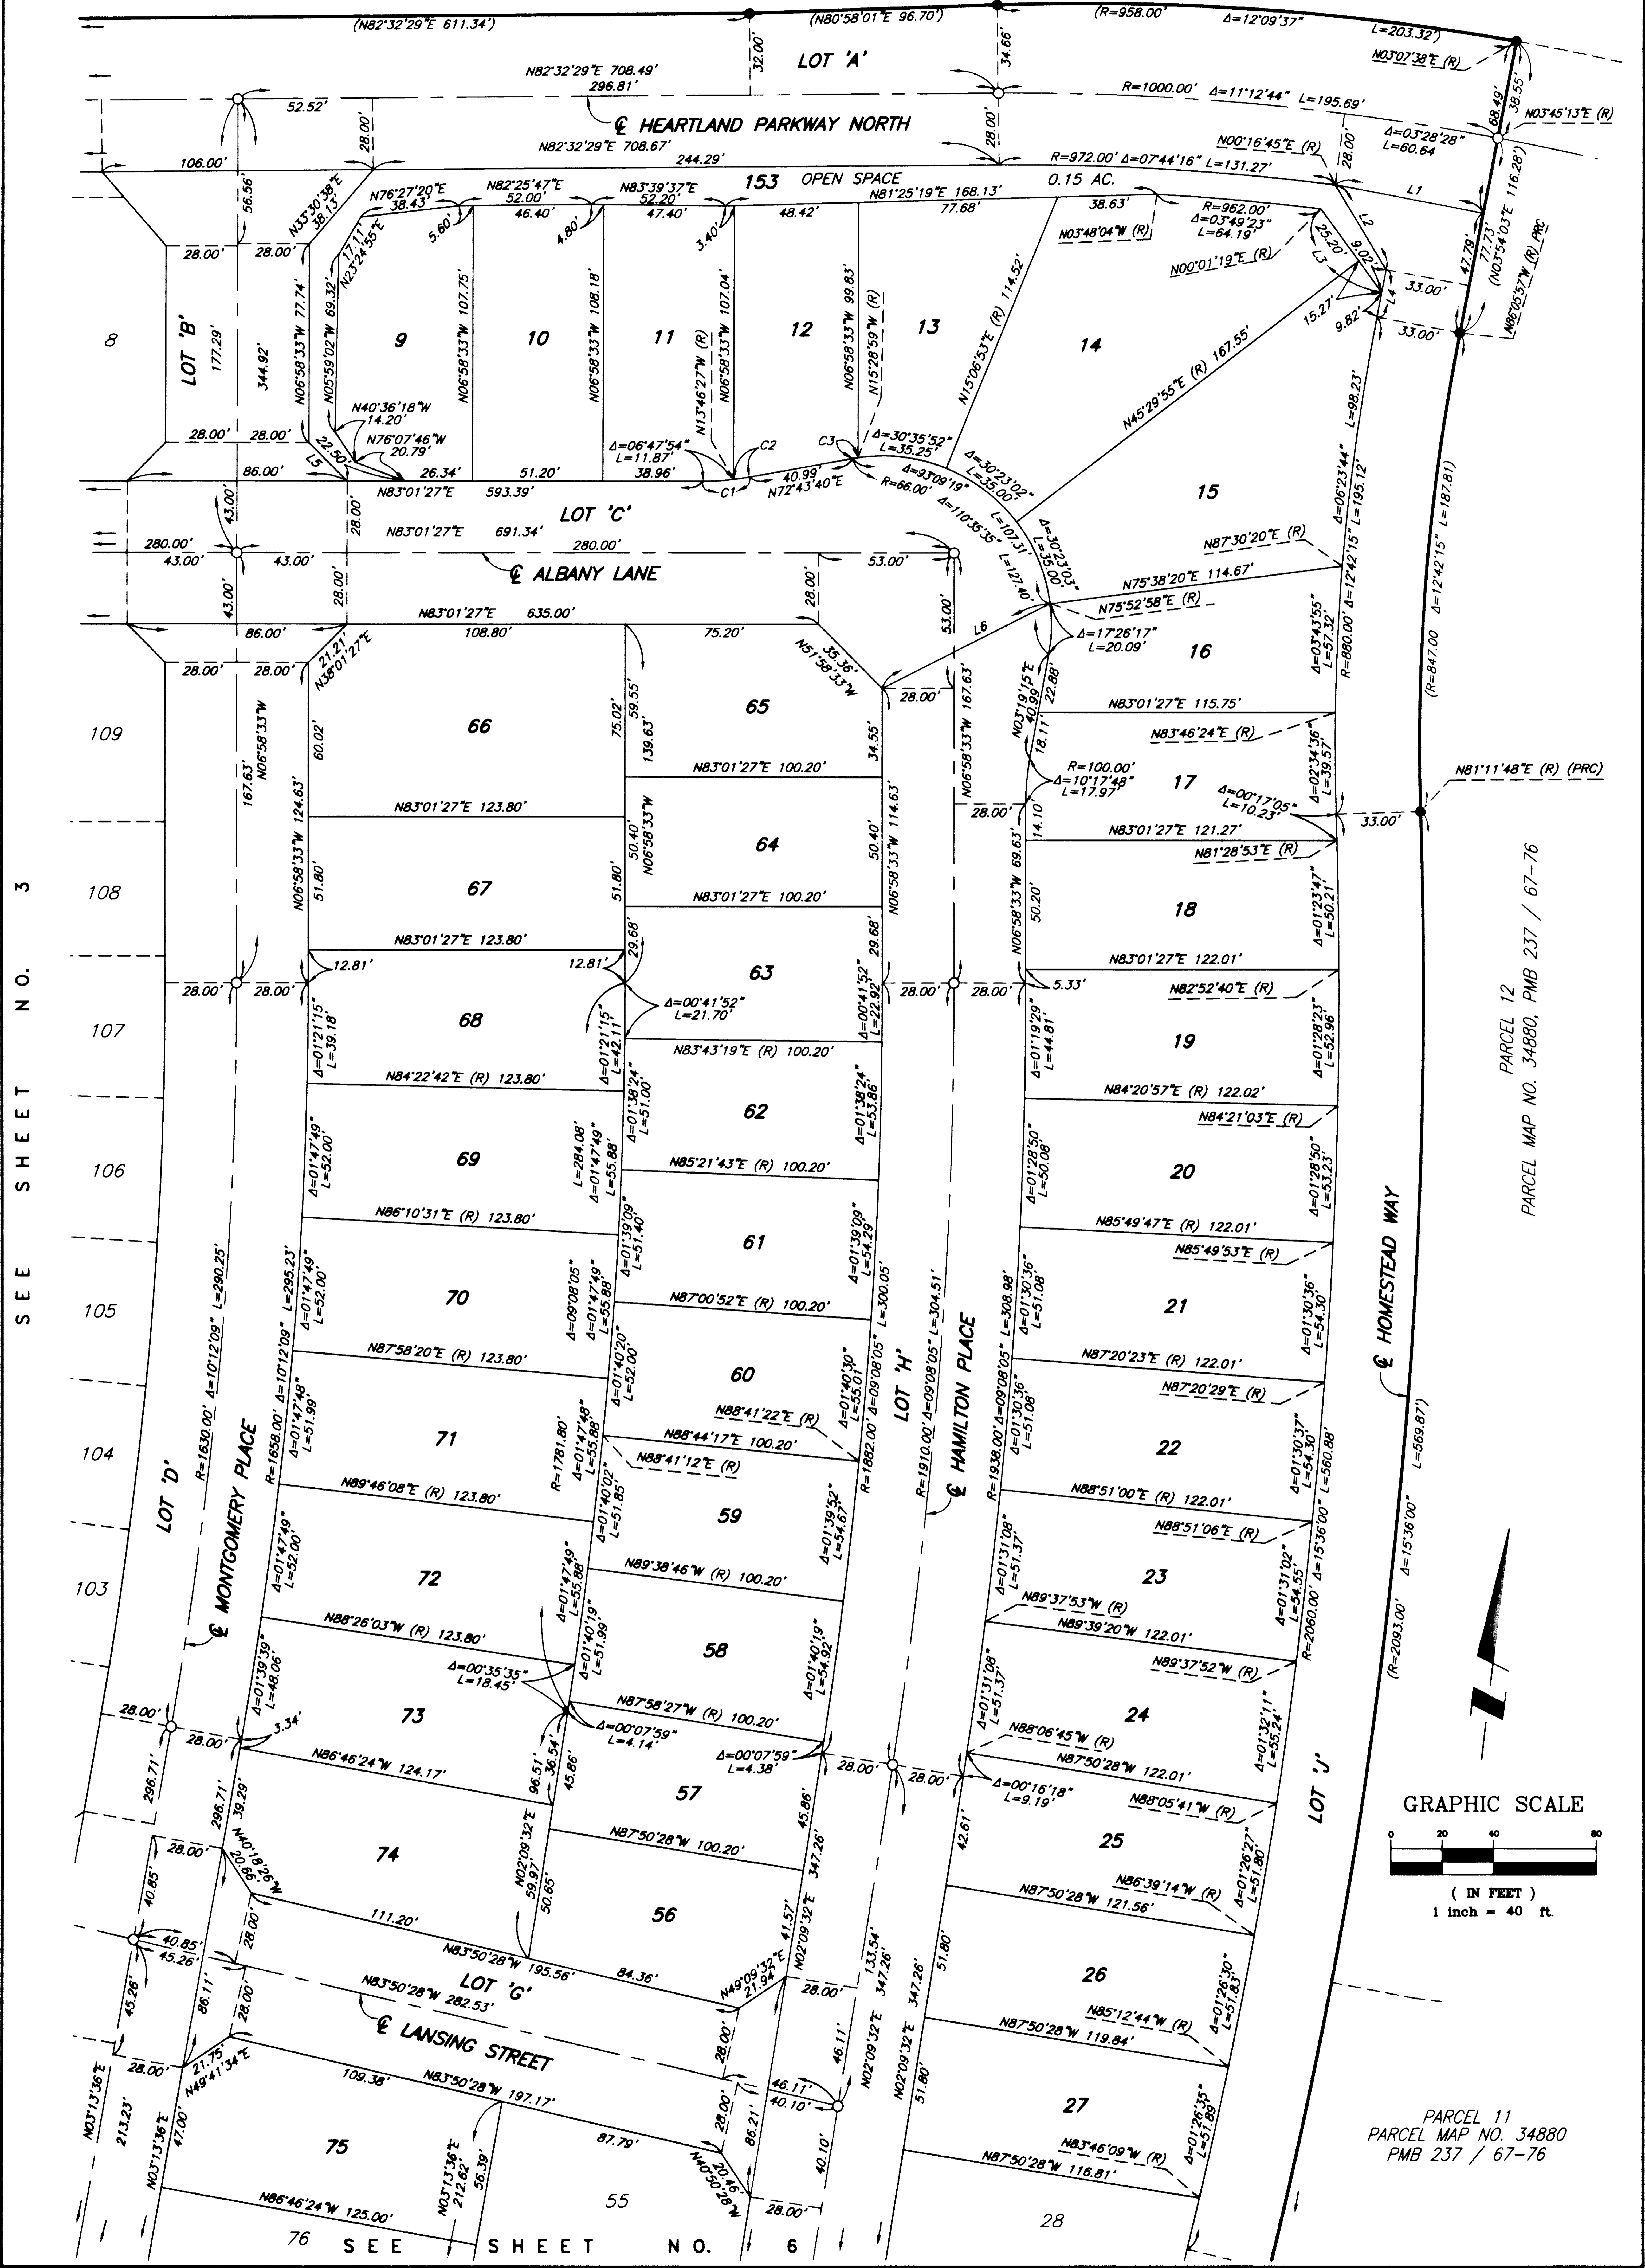

SEE SHEET NO. 3

SEE SHEET NO. 6

PARCEL 12
PARCEL MAP NO. 34880, PMB 237 / 67-76

PARCEL 11
PARCEL MAP NO. 34880
PMB 237 / 67-76

444
35
2014-0489252
ORIGINAL

TRACT NO. 27971-10

BEING A DIVISION OF PARCEL 10, LOTS 'B' AND 'AA' OF PARCEL MAP NO. 34880, RECORDED IN BOOK 237, PAGES 67 THROUGH 76, INCLUSIVE, OF PARCEL MAPS, RECORDS OF RIVERSIDE COUNTY, STATE OF CALIFORNIA, WITHIN SECTION 6, TOWNSHIP 3 SOUTH, RANGE 1 WEST, SAN BERNARDINO MERIDIAN.


FEBRUARY, 2014

STANTEC CONSULTING INC.

SEE SHEET NO. 3



TRACT NO. 27971-9
MB 444 / 25-30

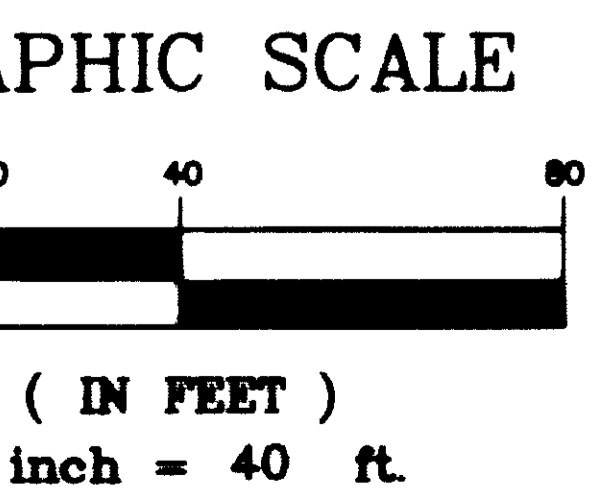

CURVE	DELTA	RADIUS	LENGTH
C1	16°10'31"	100.00'	28.23'
C2	16°45'04"	100.00'	29.24'
C3	15°56'28"	100.00'	27.82'

PARCEL MAP NO. 34880, PMB 237 / 67-76

N. O. S. H. E. E. T.

444
36
2014-0489252
ORIGINAL

SEE SHEET 2 FOR SURVEYOR'S AND EASEMENT NOTES


IN THE CITY OF BEAUMONT, COUNTY OF RIVERSIDE, STATE OF CALIFORNIA

SHEET 6 OF 6 SHEETS


TRACT NO. 27971-10

BEING A DIVISION OF PARCEL 10, LOTS 'B' AND 'AA' OF PARCEL MAP NO. 34880, RECORDED IN BOOK 237, PAGES 67 THROUGH 76, INCLUSIVE, OF PARCEL MAPS, RECORDS OF RIVERSIDE COUNTY, STATE OF CALIFORNIA, WITHIN SECTION 6, TOWNSHIP 3 SOUTH, RANGE 1 WEST, SAN BERNARDINO MERIDIAN.
FEBRUARY, 2014 STANTEC CONSULTING INC.

LINE TABLE		
LINE	BEARING	LENGTH
L1	N21°46'01"E	20.02'
L2	N66°50'44"W	20.02'
L3	N65°37'36"W	21.91'
L4	N21°07'00"E	21.70'
L5	(N61°12'55"E)	(27.78')

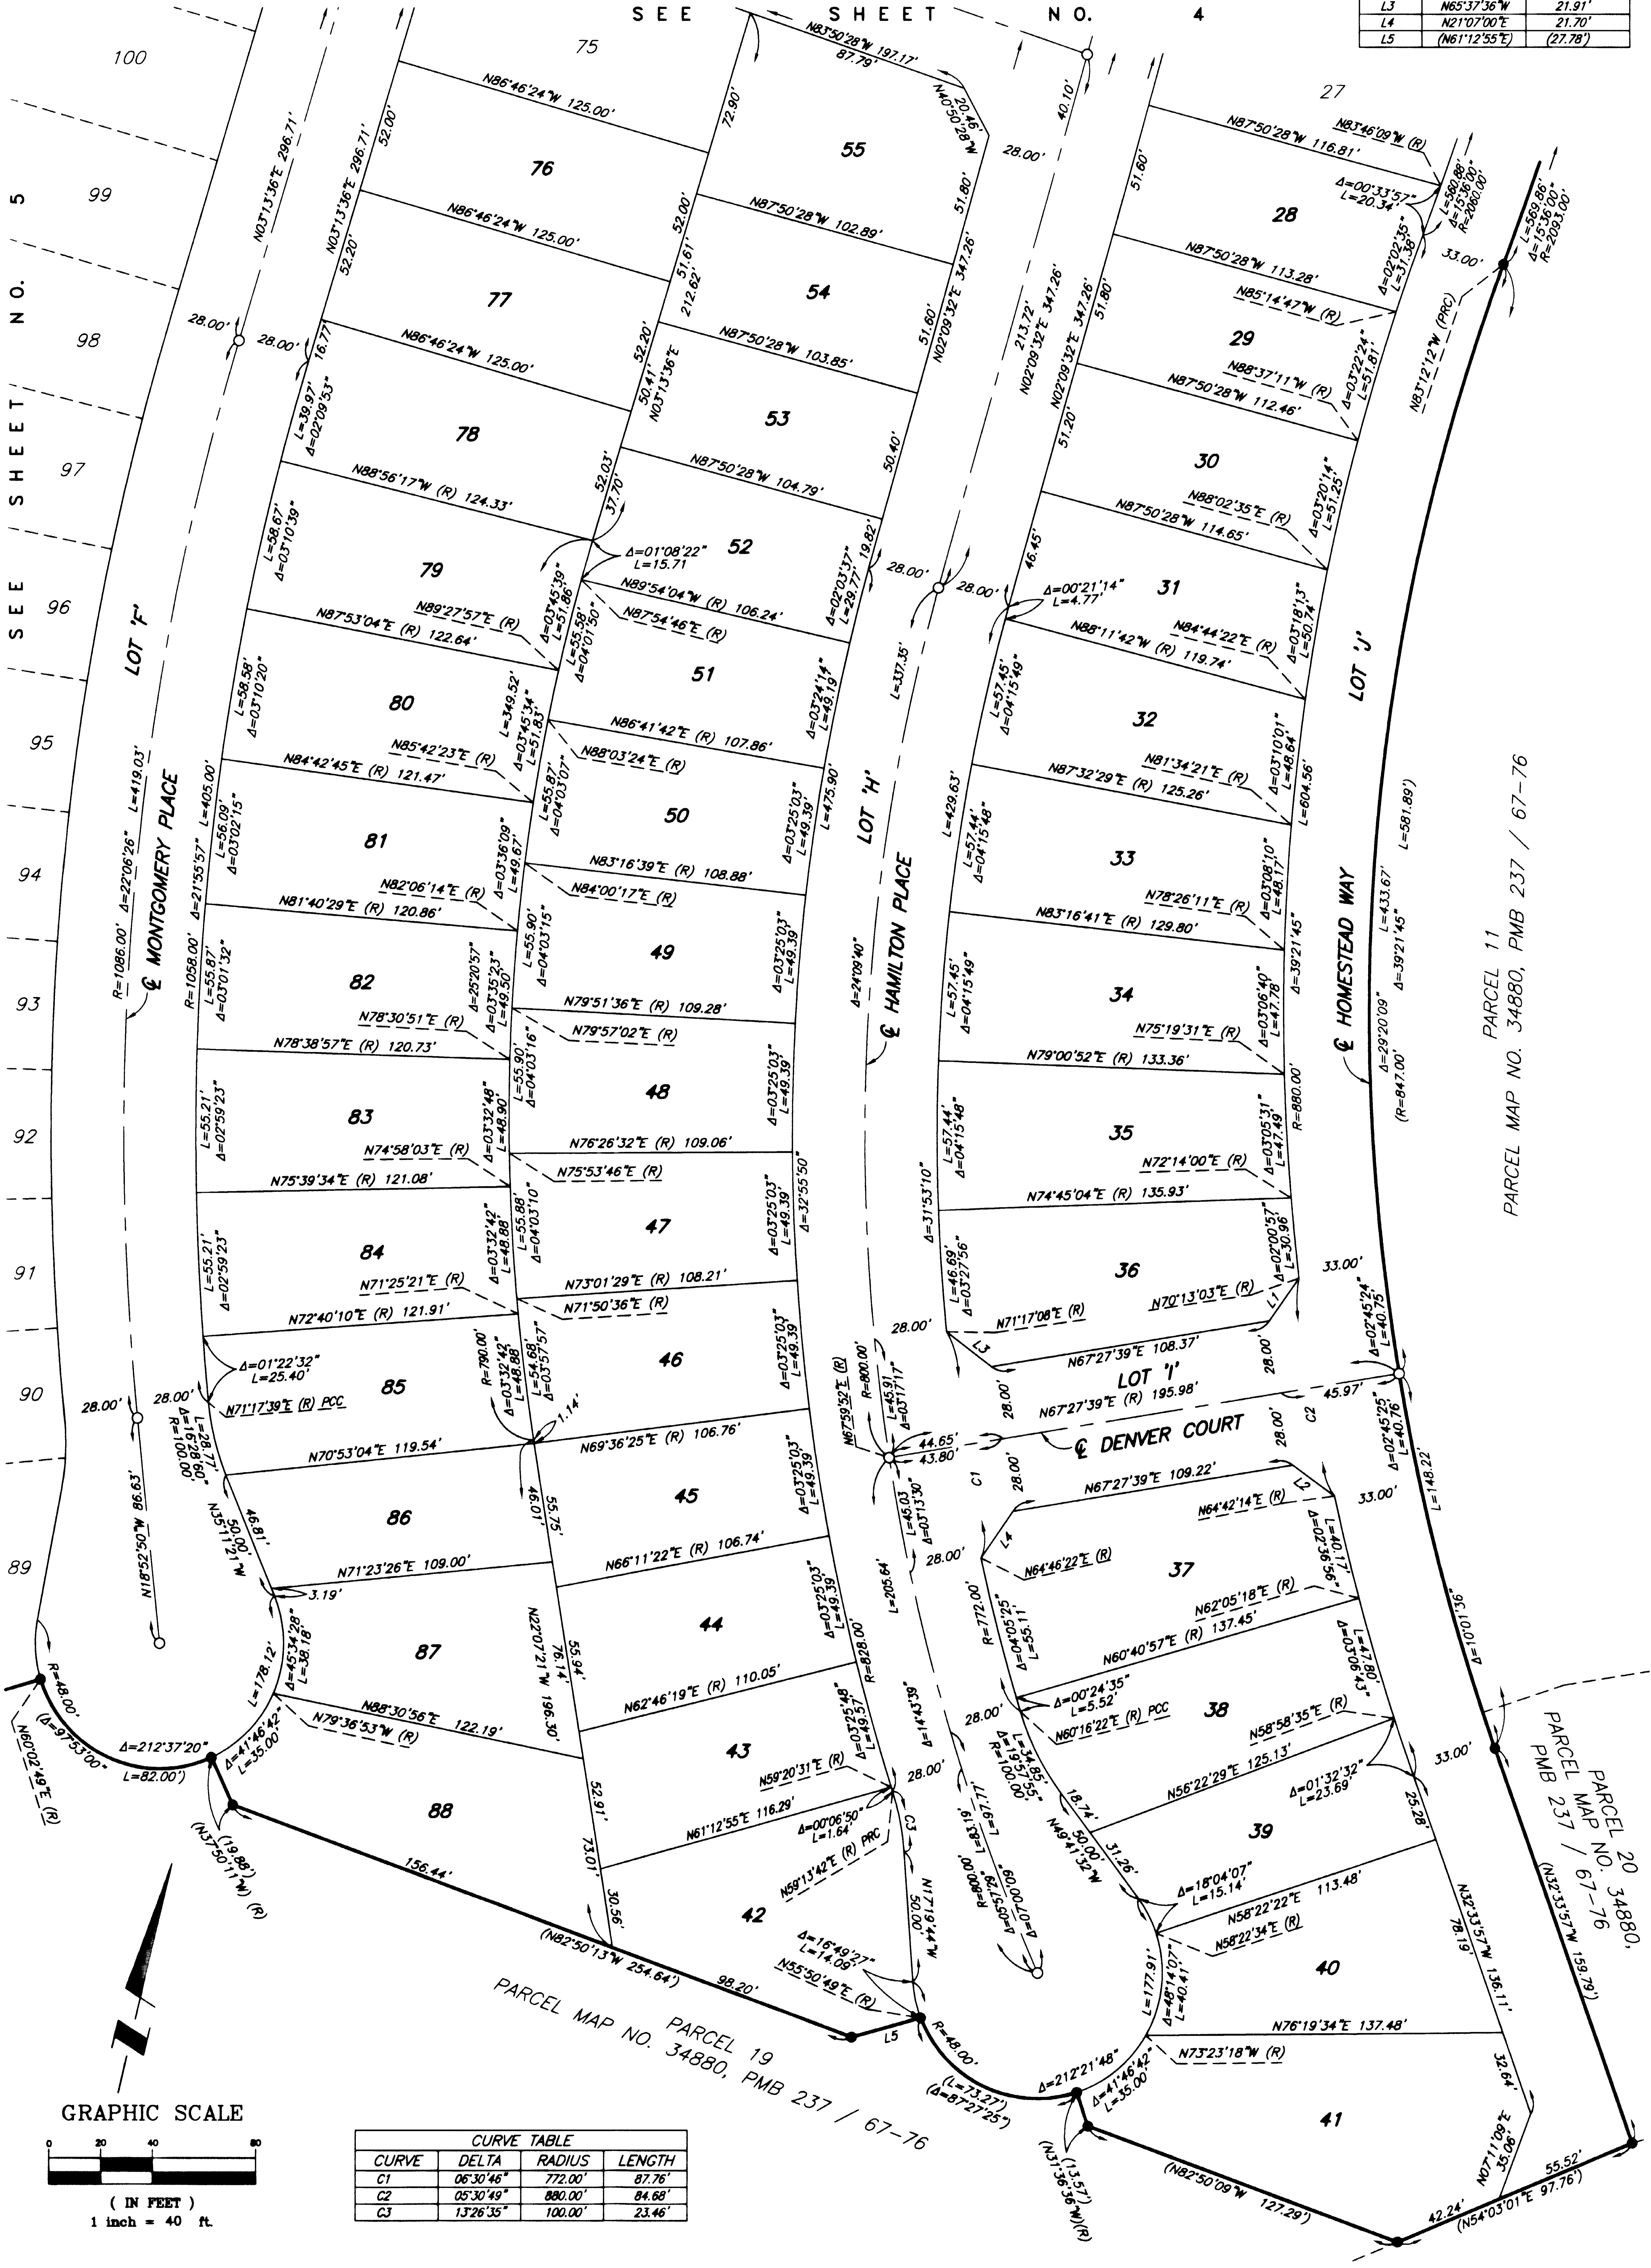

CURVE TABLE			
CURVE	DELTA	RADIUS	LENGTH
C1	06°30'46"	772.00'	87.76'
C2	05°30'49"	880.00'	84.68'
C3	13°26'35"	100.00'	23.46'

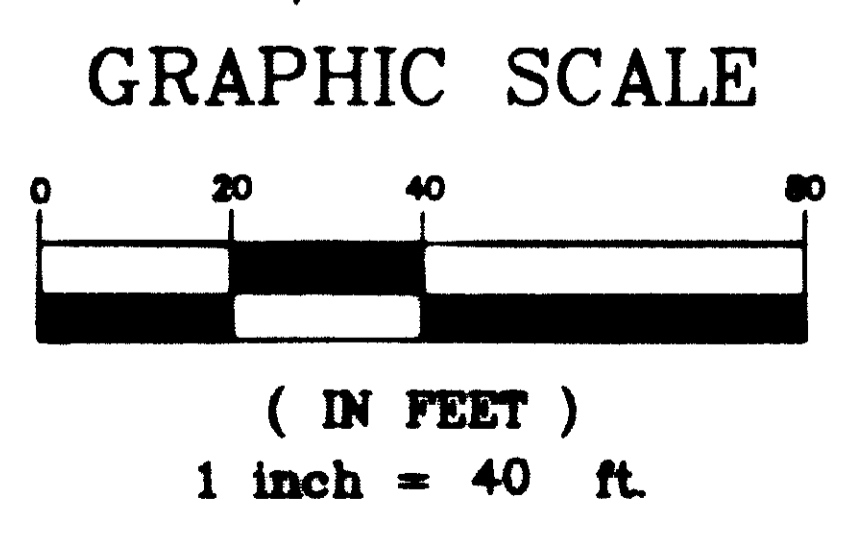

PARCEL MAP NO. 34880, PMB 237 / 67-76

PARCEL MAP NO. 34880, PMB 237 / 67-76

PARCEL MAP NO. 34880, PMB 237 / 67-76