



City of Beaumont

550 E. 6th Street
Beaumont, CA 92223
(951) 769-8520
www.beaumontca.gov

Case No. <u>PW2024-0111</u>
Receipt No. <u>R01594325</u>
Fee \$ <u>3,915.00</u>
Date Paid <u>9/19/2024</u>

BOND EXONERATION APPLICATION

Bond Type: Performance Maintenance Final Monument Inspection Other: _____

1. Contact's Name Bruce McDonald Phone 949-655-8227

2. Contact's Address 1140 N. Coast Highway, Laguna Beach, CA 92651
City/State/Zip


5. Contact's E-mail bruce@mcdonaldpropertygroup.com

3. Developer Name McDonald Property Group Phone 949-655-8227
(If corporation or partnership application must include names of principal officers or partners)


4. Developer Address 1140 N. Coast Highway, Laguna Beach, CA 92651
City/St/Zip

5. Description of Bonds (including Bond Number, Tract Map/Application number, Lot number, and description of improvements covered):
Maintenance Bond #800086182 for Parcel Map No. 36426 for 4th Street Sewer Lift Station

6. **CERTIFICATION OF ACCURACY AND COMPLETENESS:** I hereby certify that to the best of my knowledge the information in this application and all attached answers and exhibits are true, complete, and correct.

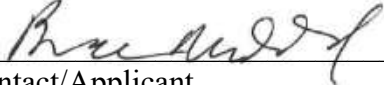Bruce McDonald  9/5/2024
Print Name and Sign – Contact/Applicant Date

7. Contractor shall indemnify, defend, and hold harmless the City and its officers, officials, employees and volunteers from and against any and all liability, loss, damage, expense, costs (including without limitation costs and fees of litigation) of every nature arising out of or in connection with contractor's performance of work hereunder or its failure to comply with any of its obligations for which this Bond exoneration is requested, except for such loss or damage which was caused by the active negligence of the City.

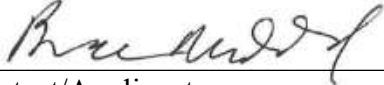Bruce McDonald  9/5/2024
Print Name and Sign – Contact/Applicant Date

8. Developer/Contractor has completed all the following items prior to requesting release or has included them in the application.

- Remove and replace concrete and AC as needed where lifting.
- Provide AC crack fill as needed. Crack fill/seal shall be hot asphaltic emulsion.
- Provide Type II slurry coat for all road surfaces.
- Restore/Verify pavement striping/markings.
- Restore/Verify blue dots and signage as needed.
- Clean and camera sewer. Provide report and video copy of camera survey.
- Provide all final geotechnical reports.
- Provide Engineers' certification for line and grade within Right-of-Way.
- Provide Landscape Architects Certification as required.

Bruce McDonald



9/5/2024

Print Name and Sign – Contact/Applicant

Date



Punch List

Project Name: 4th Street Sewer Lift Station

Tract No. Parcel Map
#36426

Maintenance	PW2024-0111	Bond No. 800086182	Sewer Lift Station
Inspected By: Public Works & Wastewater		Page: 1	Date: 9-27-24/11-21-24/ 1-21-25
Item No.	Description	Completed by Construction (Sign/Date)	Accepted by (Sign/Date)
1	Land dedication for SLS and driveway.	Alex Stanko 9/27/24	Omitted by Kenyon Potter (separate item) 11/21/24
2	Provide AQMD paperwork	Alex Stanko 9/27/24	Alex Stanko 1-21-25
3	Provide generator maintenance	Alex Stanko 9/27/24	Alex Stanko 1-21-25
4	Verify plug cross-connect	Alex Stanko 9/27/24	Alex Stanko 11/21/24
5	Provide new VFD information	Alex Stanko 9/27/24	Alex Stanko 11/21/24
6	Provide specifications for lift station security system	Alex Stanko 9/27/24	Alex Stanko 11/21/24
7	Address delamination of wet well	Alex Stanko 9/27/24	Alex Stanko 11/21/24
8			
9			
10			
11			

MAINTENANCE BOND

WHEREAS, the City of Beaumont ("City"), a municipal corporation, and MPLD II Inland Empire, LLC (hereinafter "Principal"), have entered into an agreement by which Principal agrees to install and complete certain designated public improvements and to guarantee and warrant the work for the period of one year following its completion and acceptance, which said agreement, dated _____, and identified as Tract Map PP2018-0134 is hereby referred to and made a part hereof; and:

Beaumont Crossroads II Sewer Lift Station

WHEREAS, Principal is required under the terms of the agreement to furnish a bond to guarantee and warrant the work for a period of one year following its completion and acceptance against any defective work or labor done, or defective materials furnished, to comply with the terms of the agreement.

Atlantic Specialty

NOW, THEREFORE, we, the Principal and Insurance Company ("Surety") admitted and duly authorized to transact business under the laws of the State of California as surety, are held and firmly bound unto the City of Beaumont as obligee, in the penal sum of Two Hundred Ninety Eight Thousand Four Hundred Ninety Two and 30/100 dollars (\$298,492.30) lawful money of the United States, for the payment of which sum well and truly to be made, we bind ourselves, our heirs, successors, executors, and administrators, jointly and severally, firmly by these presents.

The condition of this obligation is such that if the above bounded Principal, his or its heirs, executors, administrators, successors or assigns, shall in all things stand to and abide by, provisions in the agreement and any alteration thereof made as therein provided, on his or its part to be kept and performed at the time and in the manner therein specified, and in all respects according to their true intent and meaning, and shall indemnify and save harmless the City of Beaumont, its officers, agents and employees, as therein stipulated, then this obligation shall become null and void; otherwise it shall be and remain in full force and effect.

As a condition precedent to the satisfactory completion of the agreement, the obligation of the Principal and surety under this bond shall remain in effect for a period of one (1) year after the completion and acceptance of the work. During that time, if the Principal or his or its heirs, executors, administrators, successors or assigns, fails to make full, complete and satisfactory repair and replacement or totally protect the City from any loss or damage made evident during that year which results from or is caused by either defective materials or faulty workmanship in the prosecution of the work, then the obligation shall remain in full force and effect. However, anything in this paragraph to the contrary notwithstanding, the obligation of the Surety shall continue so long as any obligation of the Principal remains.

As a part of the obligation secured hereby and in addition to the face amount specified therefor, there shall be included costs and reasonable expenses and fees, including reasonable attorney's fees, incurred by the City of Beaumont in successfully enforcing such obligation, all to be taxed as costs and included in any judgment rendered.

The Surety hereby stipulates and agrees that no change, extension of time, alteration or addition to the terms of the agreement or to the work to be performed thereunder or the specifications accompanying the same shall in anywise affect its obligations under this bond, and it does hereby waive notice of any such change, extension of time, alteration or addition to the terms of the agreement or to the work or to the specifications. The Surety waives all rights of subrogation against the City or any person employed by the City.

[signatures on following page]

SIGNED AND SEALED THIS 24th DAY OF July ~~2020~~X, 2023.



(Seal)

Atlantic Specialty Insurance Company
SURETY

By: 

Jeremy Polk, Attorney-in-Fact

(Seal)

MPLD II Inland Empire, LLC, a Delaware limited liability company
By: MPLD II REIT A, a Texas real estate investment trust, its sole member

PRINCIPAL

By: 

(Name)

(Address)

605 Highway 169 North, Suite 800

Plymouth, MN 55441

(Name)

LANGE ALLEN
Executive Managing Director

(Title)

(Address)

9830 Colonnade Blvd, Suite 600

San Antonio, TX 78230-2239

By:

(Name)

(Title)
(Address)

ALL SIGNATURES MUST BE ACKNOWLEDGED BY A NOTARY PUBLIC

Acknowledgement Form

State of Texas)

)ss.:

County of Bexar)

On the 25 day of July in the year 2023, before me, the undersigned notary public, personally appeared Lange Allen, personally known to me or proved to me on the basis of satisfactory evidence to be the individual(s) whose name(s) is (are) subscribed to the within instrument and acknowledged to me that he/she/they executed the same in his/her/their capacity(ies), and that by his/her/their signature(s) on the instrument, the individual(s), or the person upon behalf of which the individual(s) acted, executed the instrument.

Maya A. D. Notary Public



ACKNOWLEDGEMENT

State of Arizona

County of Maricopa

On 7/24/2023 before me personally appeared **Jeremy Polk** whose identity was proven to me on the basis of satisfactory evidence to be the person who he or she claims to be, and acknowledged that he or she signed the attached document.

(Seal)

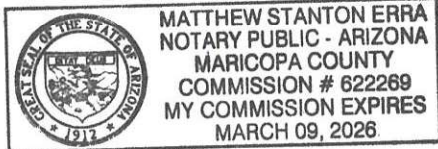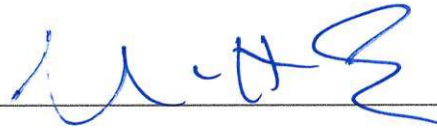

Notary Signature

Matthew Stanton Erra
Commission Expires March 9th, 2026



Power of Attorney

KNOW ALL MEN BY THESE PRESENTS, that ATLANTIC SPECIALTY INSURANCE COMPANY, a New York corporation with its principal office in Plymouth, Minnesota, does hereby constitute and appoint: **Jeremy Polk, Jorge Mendez, Matthew Erra**, each individually if there be more than one named, its true and lawful Attorney-in-Fact, to make, execute, seal and deliver, for and on its behalf as surety, any and all bonds, recognizances, contracts of indemnity, and all other writings obligatory in the nature thereof; provided that no bond or undertaking executed under this authority shall exceed in amount the sum of: **unlimited** and the execution of such bonds, recognizances, contracts of indemnity, and all other writings obligatory in the nature thereof in pursuance of these presents, shall be as binding upon said Company as if they had been fully signed by an authorized officer of the Company and sealed with the Company seal. This Power of Attorney is made and executed by authority of the following resolutions adopted by the Board of Directors of ATLANTIC SPECIALTY INSURANCE COMPANY on the twenty-fifth day of September, 2012:

Resolved: That the President, any Senior Vice President or Vice-President (each an "Authorized Officer") may execute for and in behalf of the Company any and all bonds, recognizances, contracts of indemnity, and all other writings obligatory in the nature thereof, and affix the seal of the Company thereto; and that the Authorized Officer may appoint and authorize an Attorney-in-Fact to execute on behalf of the Company any and all such instruments and to affix the Company seal thereto; and that the Authorized Officer may at any time remove any such Attorney-in-Fact and revoke all power and authority given to any such Attorney-in-Fact.

Resolved: That the Attorney-in-Fact may be given full power and authority to execute for and in the name and on behalf of the Company any and all bonds, recognizances, contracts of indemnity, and all other writings obligatory in the nature thereof, and any such instrument executed by any such Attorney-in-Fact shall be as binding upon the Company as if signed and sealed by an Authorized Officer and, further, the Attorney-in-Fact is hereby authorized to verify any affidavit required to be attached to bonds, recognizances, contracts of indemnity, and all other writings obligatory in the nature thereof.


This power of attorney is signed and sealed by facsimile under the authority of the following Resolution adopted by the Board of Directors of ATLANTIC SPECIALTY INSURANCE COMPANY on the twenty-fifth day of September, 2012:

Resolved: That the signature of an Authorized Officer, the signature of the Secretary or the Assistant Secretary, and the Company seal may be affixed by facsimile to any power of attorney or to any certificate relating thereto appointing an Attorney-in-Fact for purposes only of executing and sealing any bond, undertaking, recognizance or other written obligation in the nature thereof, and any such signature and seal where so used, being hereby adopted by the Company as the original signature of such officer and the original seal of the Company, to be valid and binding upon the Company with the same force and effect as though manually affixed.


IN WITNESS WHEREOF, ATLANTIC SPECIALTY INSURANCE COMPANY has caused these presents to be signed by an Authorized Officer and the seal of the Company to be affixed this first day of January, 2023.

STATE OF MINNESOTA
HENNEPIN COUNTY



By 
Sarah A. Kolar, Vice President and General Counsel

On this first day of January, 2023, before me personally came Sarah A. Kolar, Vice President and General Counsel of ATLANTIC SPECIALTY INSURANCE COMPANY, to me personally known to be the individual and officer described in and who executed the preceding instrument, and she acknowledged the execution of the same, and being by me duly sworn, that she is the said officer of the Company aforesaid, and that the seal affixed to the preceding instrument is the seal of said Company and that the said seal and the signature as such officer was duly affixed and subscribed to the said instrument by the authority and at the direction of the Company.

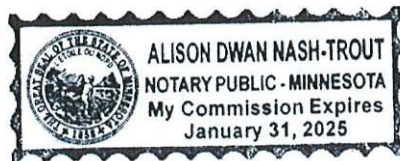


Notary Public

I, the undersigned, Secretary of ATLANTIC SPECIALTY INSURANCE COMPANY, a New York Corporation, do hereby certify that the foregoing power of attorney is in full force and has not been revoked, and the resolutions set forth above are now in force.


Signed and sealed. Dated 24th day of July, 2023.

This Power of Attorney expires
January 31, 2025




Kara L.B. Barrow, Secretary

Plotted By: \\v\mwhorner_sam\sheet\ba1\beaumont_lift_station\design\plan_sheets - 2020_delta_set1195284001 - kvcdwg

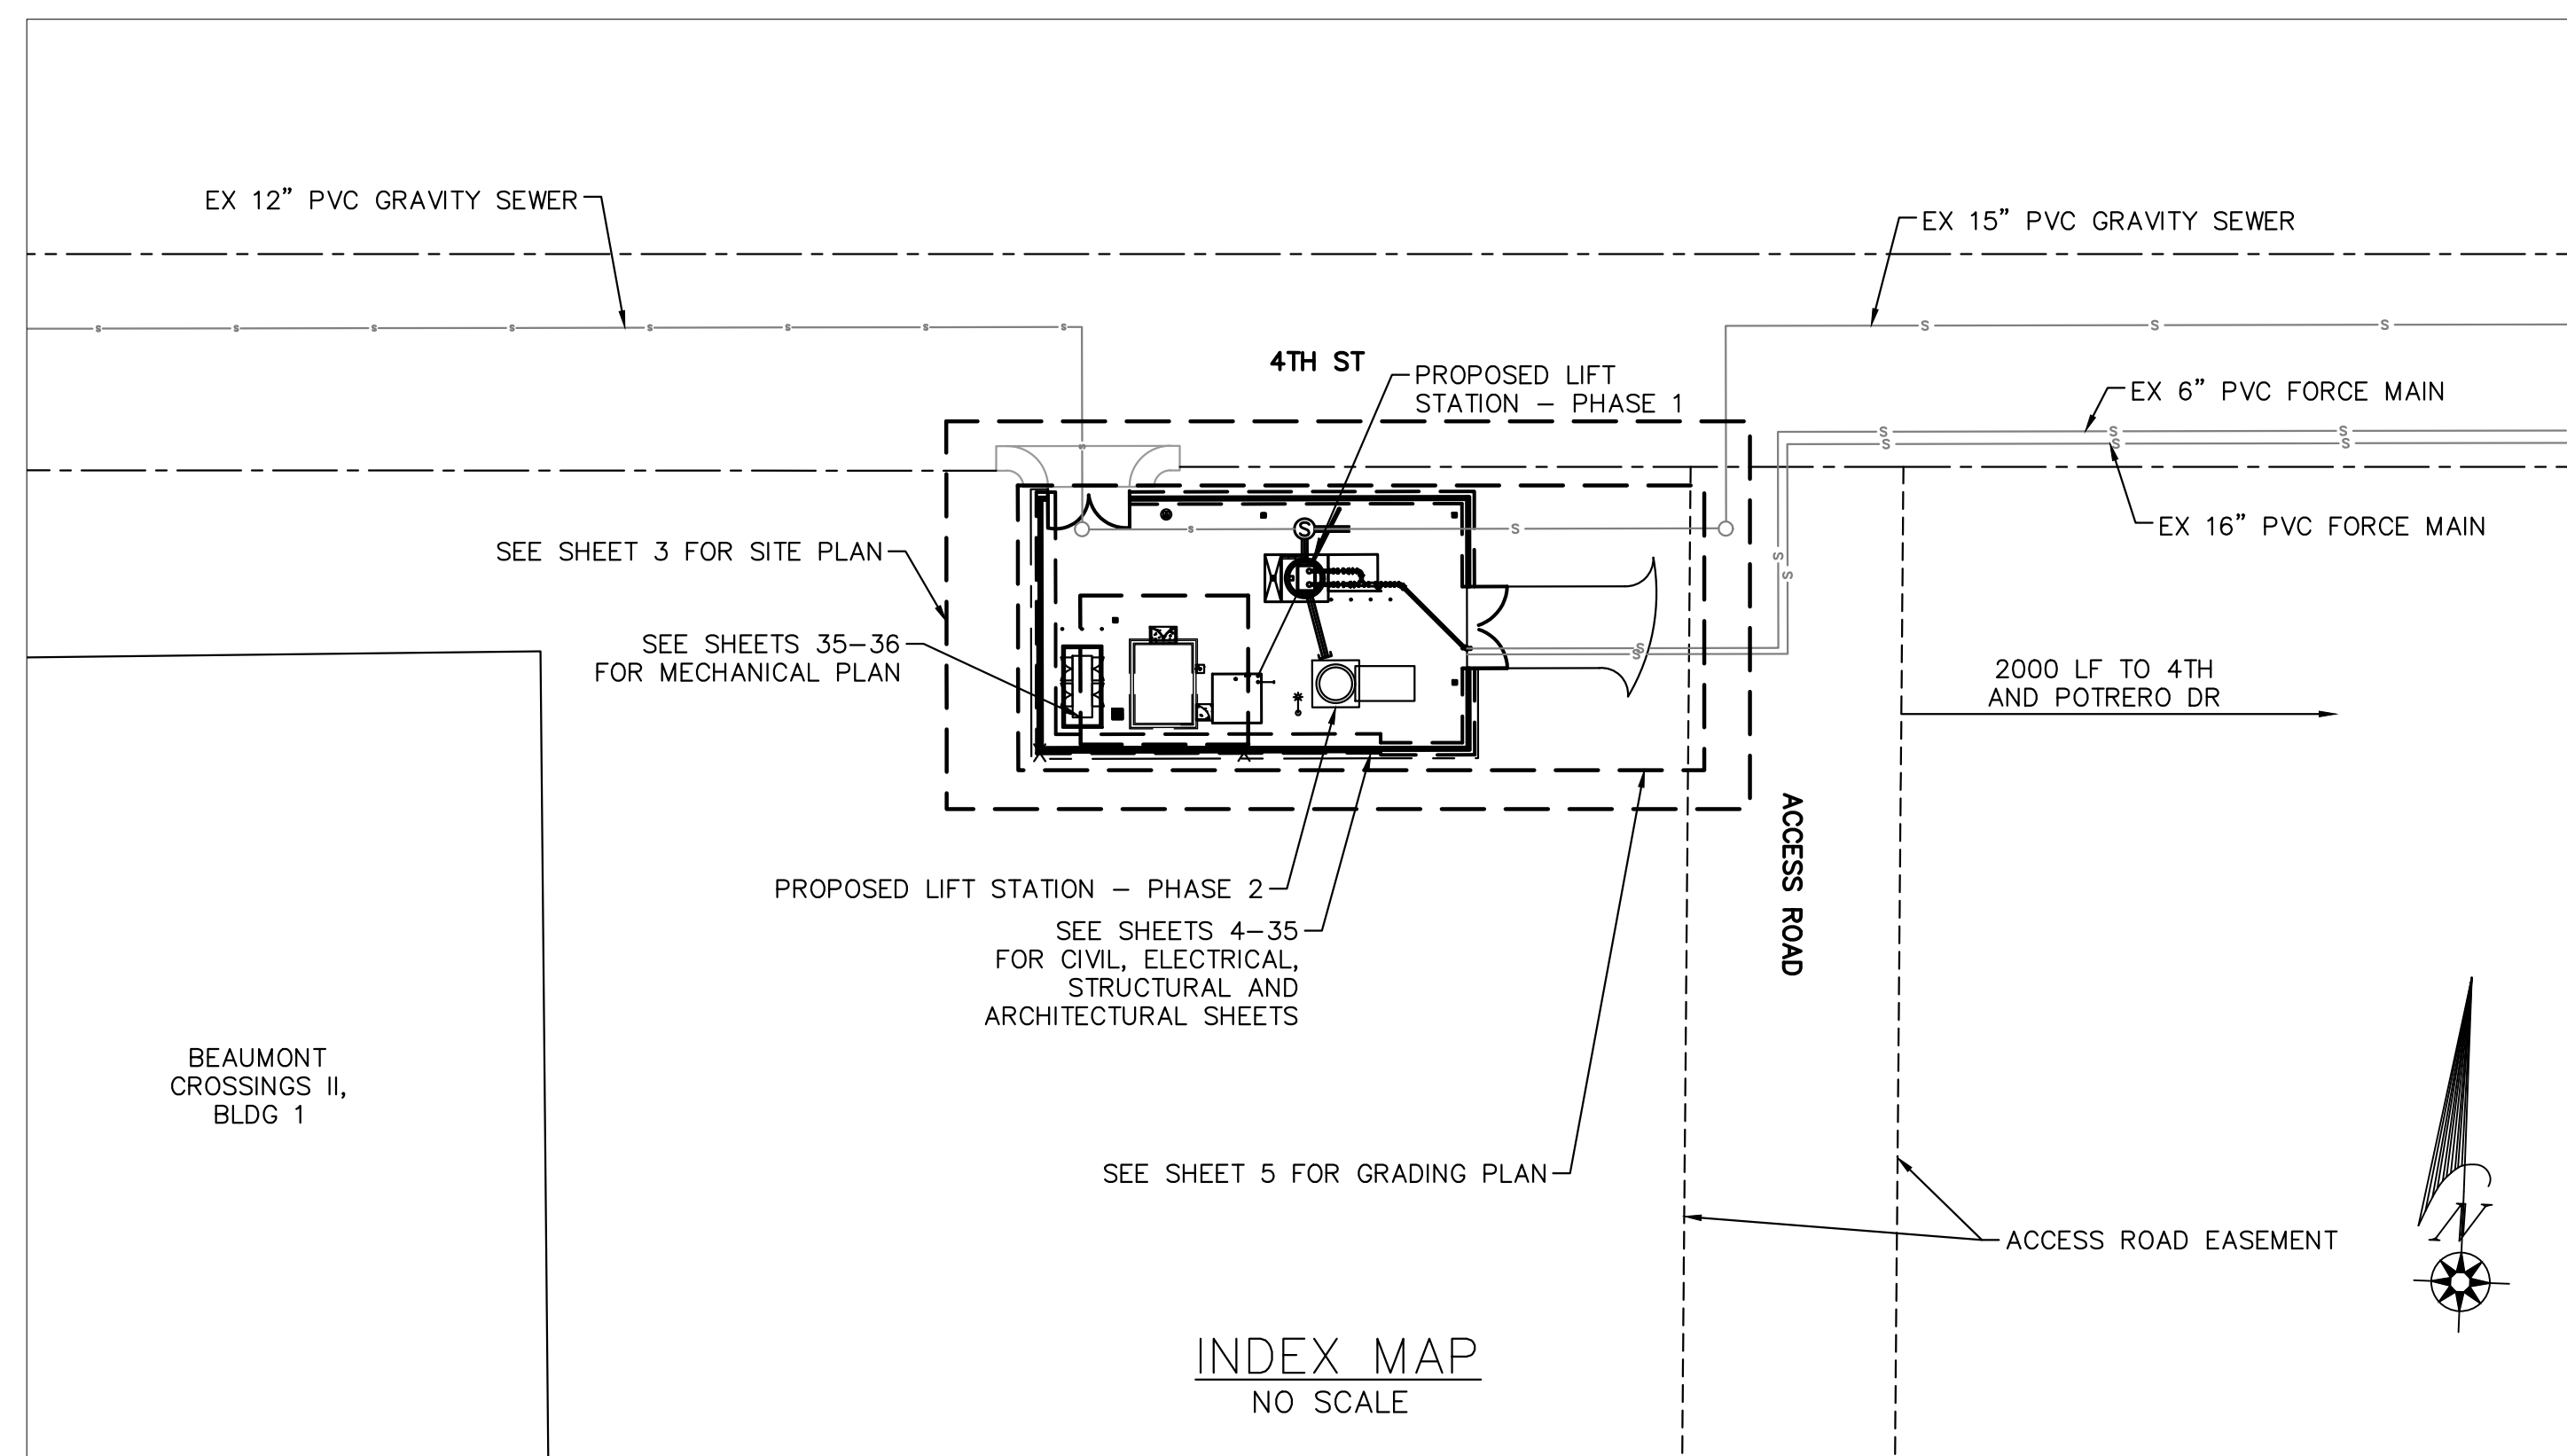


LEGEND

DESCRIPTION	DWG. NO.	SYMBOL	QUANTITY
RIGHT-OF-WAY, R/W		---	
EASEMENT		- - - - -	
DAYLIGHT LINE		—//—	
PROP SEWER		—s—	
EXISTING SEWER		—s—	
PROP STORM DRAIN		— —	
EXISTING STORM DRAIN		— —	
PROP WATER		—w—	
EXISTING WATER		—w—	
GAS		—GAS—GAS—GAS—	
SEWER MANHOLE		⊙	53.0
PROP CONTOUR		———	53.0
EXISTING CONTOUR		———	53.0
PROPOSED WALL		— — —	
EXISTING WALL		— — —	
CURB & GUTTER		———	
CENTERLINE, CL		—+—	
CONCRETE		[Pattern]	
AC PAVING		[Pattern]	
ACCESS ROAD		[Pattern]	
SITE LIGHT		⊙	
WATER METER		⊞	
BACKFLOW PREVENTION DEVICE		⊞	
ELECTRICAL ANTENNA		⊞	
REMOVE EXISTING		· · · · ·	

ABBREVIATIONS

AB	AGGREGATE BASE
ASTM	AMERICAN SOCIETY FOR TESTING AND MATERIALS
AC	ASPHALTIC CONCRETE
BLDG	BUILDING
CF	CUBIC FEET
CMU	CONCRETE MASONRY UNIT
COMM	COMMUNICATIONS
CONC	CONCRETE
DI	DUCTILE IRON
DIP	DUCTILE IRON PIPE
DIA, D	DIAMETER
DR	DRIVE
DWG	DRAWING
DWY	DRIVEWAY
EG	EXISTING GRADE
ELEC	ELECTRIC/ELECTRICAL
ELEV	ELEVATION
EMWD	EASTERN MUNICIPAL WATER DISTRICT
EX	EXISTING
FG	FINISHED GRADE
FLG	FLANGE
FM	FORCE MAIN
GAL	GALLONS
GPM	GALLONS PER MINUTE
HORIZ	HORIZONTAL
HP	HORSEPOWER
HRS	HOURS
HWL	HIGH WATER LEVEL
ID	INNER DIAMETER
IE	INVERT ELEVATION
IPS	IRON PIPE SIZE
LF	LINEAR FEET
LOL	LAYOUT LINE
LT	LEFT
LWL	LOW WATER LEVEL
MAX	MAXIMUM
MCC	MOTOR CONTROL CENTER
ME	MATCH EXISTING
MH	MANHOLE
MIN	MINIMUM
NO.	NUMBER
N.T.S.	NOT TO SCALE
O.C.	ON CENTER
PC	POINT OF CURVATURE
PE	PLAIN END
PI	POINT OF INTERSECTION
P/L	PROPERTY LINE
PROP	PROPOSED
PSI	POUNDS PER SQUARE INCH
PVC	POLYVINYL CHLORIDE
R/W	RIGHT-OF-WAY
RCFC&WCD	RIVERSIDE COUNTY FLOOD CONTROL AND WATER CONSERVATION DISTRICT
RCP	REINFORCED CONCRETE PIPE
RPM	REVOLutions PER MINUTE
RTU	REMOTE TELEMetry UNIT
SCH	SCHEDULE
SDR	STANDARD DIMENSION RATIO
SS	STAINLESS STEEL
ST	STREET
STL	STEEL
STD	STANDARD
SWR	SEWER
TDH	TOTAL DYNAMIC HEAD
TF	TOP OF FOOTING
TP	TOP OF PIPE
TW	TOP OF WALL
TYP	TYPICAL
V	VOLT
VOL	VOLUME
VERT	VERTICAL

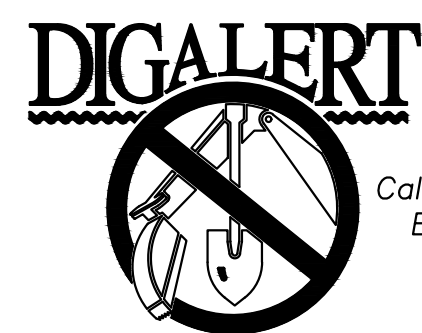

BENCHMARK:
 NATIONAL GEODETIC SURVEY BENCHMARK NO. Q 1311
 1.4 MILES WEST OF BEAUMONT ON INTERSTATE 10 TO SAN TIMOTEO CANYON NEAR FRONTAGE ROAD ON SOUTH(WEST) SIDE OF INTERSTATE 10, 0.1 MILES SOUTHWEST ALONG FRONTAGE ROAD, SOUTH ACROSS THE ROAD FROM A GUY POLE 25.9 FEET SOUTH OF THE CENTERLINE OF FRONTAGE ROAD, 1.8 FEET WEST OF POWERPOLE AND 1.5 FEET EAST OF A WITNESS POST, INSIDE A 4 INCH PVC PIPE WITH SCREW PLUG 1 INCH ABOVE GROUND (ELEVATION = 2468.07). ALSO SHOWN ON HIGHWAY 69 // POTRERO BLVD. INTERCHANGE STATIC GPS PROJECT CONTROL DIAGRAM AND IDENTIFIED THEREON AS 3538 BM D3474 WHEREIN THE PUBLISHED ELEVATION = 2468.07 IS CORRECTED WITH A MEASURED ELEVATION = 2468.01, USED HEREON.
 ELEV. 2468.01, (NVD '88), (STAMPED Q 1311 1978)

BY	MARK	DESCRIPTION	APPR.	DATE
ENGINEER		REVISIONS		CITY

Kimley»Horn
 401 B Street, Suite 600, San Diego, CA 92101
 Phone: (619) 234-9411
 WWW.KIMLEY-HORN.COM

Sam McWhorter
 SAM L. MCWHORTER
 R.C.E. 61788 8/23/2021



DESIGN BY:
 SLM
 DRAWN BY:
 RC/SW
 CHECKED BY:
 TW/SS
 SCALE:
 DATE:
 JOB NUMBER:
 195284001



Reviewed By: _____ Date: _____
 Staff Engineer

Recommended for Approval By: *[Signature]* Date: 11/19/2021
 Administrative Engineer




Approved By: *[Signature]* Date: 11/23/2021
 City Engineer/Director of Public Works

CITY OF BEAUMONT, PUBLIC WORKS DEPARTMENT
 ENGINEERING DIVISION
 550E 6th St
 Beaumont, CA 92223
 TEL: (951) 769-8520 FAX: (951) 769-8526

CITY OF BEAUMONT, CALIFORNIA
 IMPROVEMENT PLANS FOR:
**BEAUMONT CROSSROADS
 LIFT STATION**

INDEX MAP

S H E E T
2
 OF 38 SHEETS
 FILE NO:
 3387

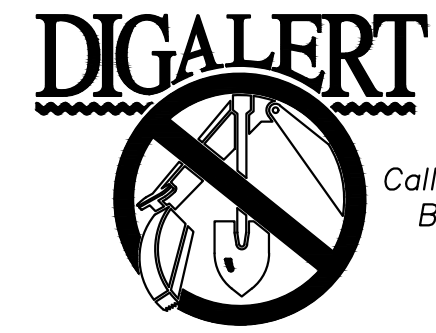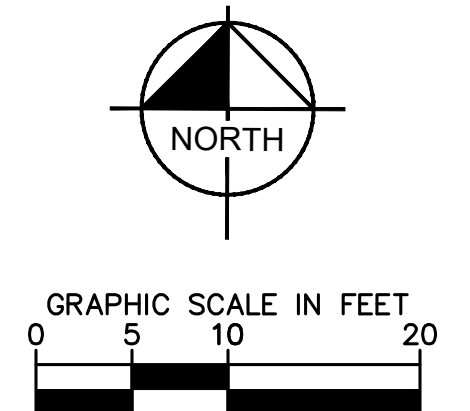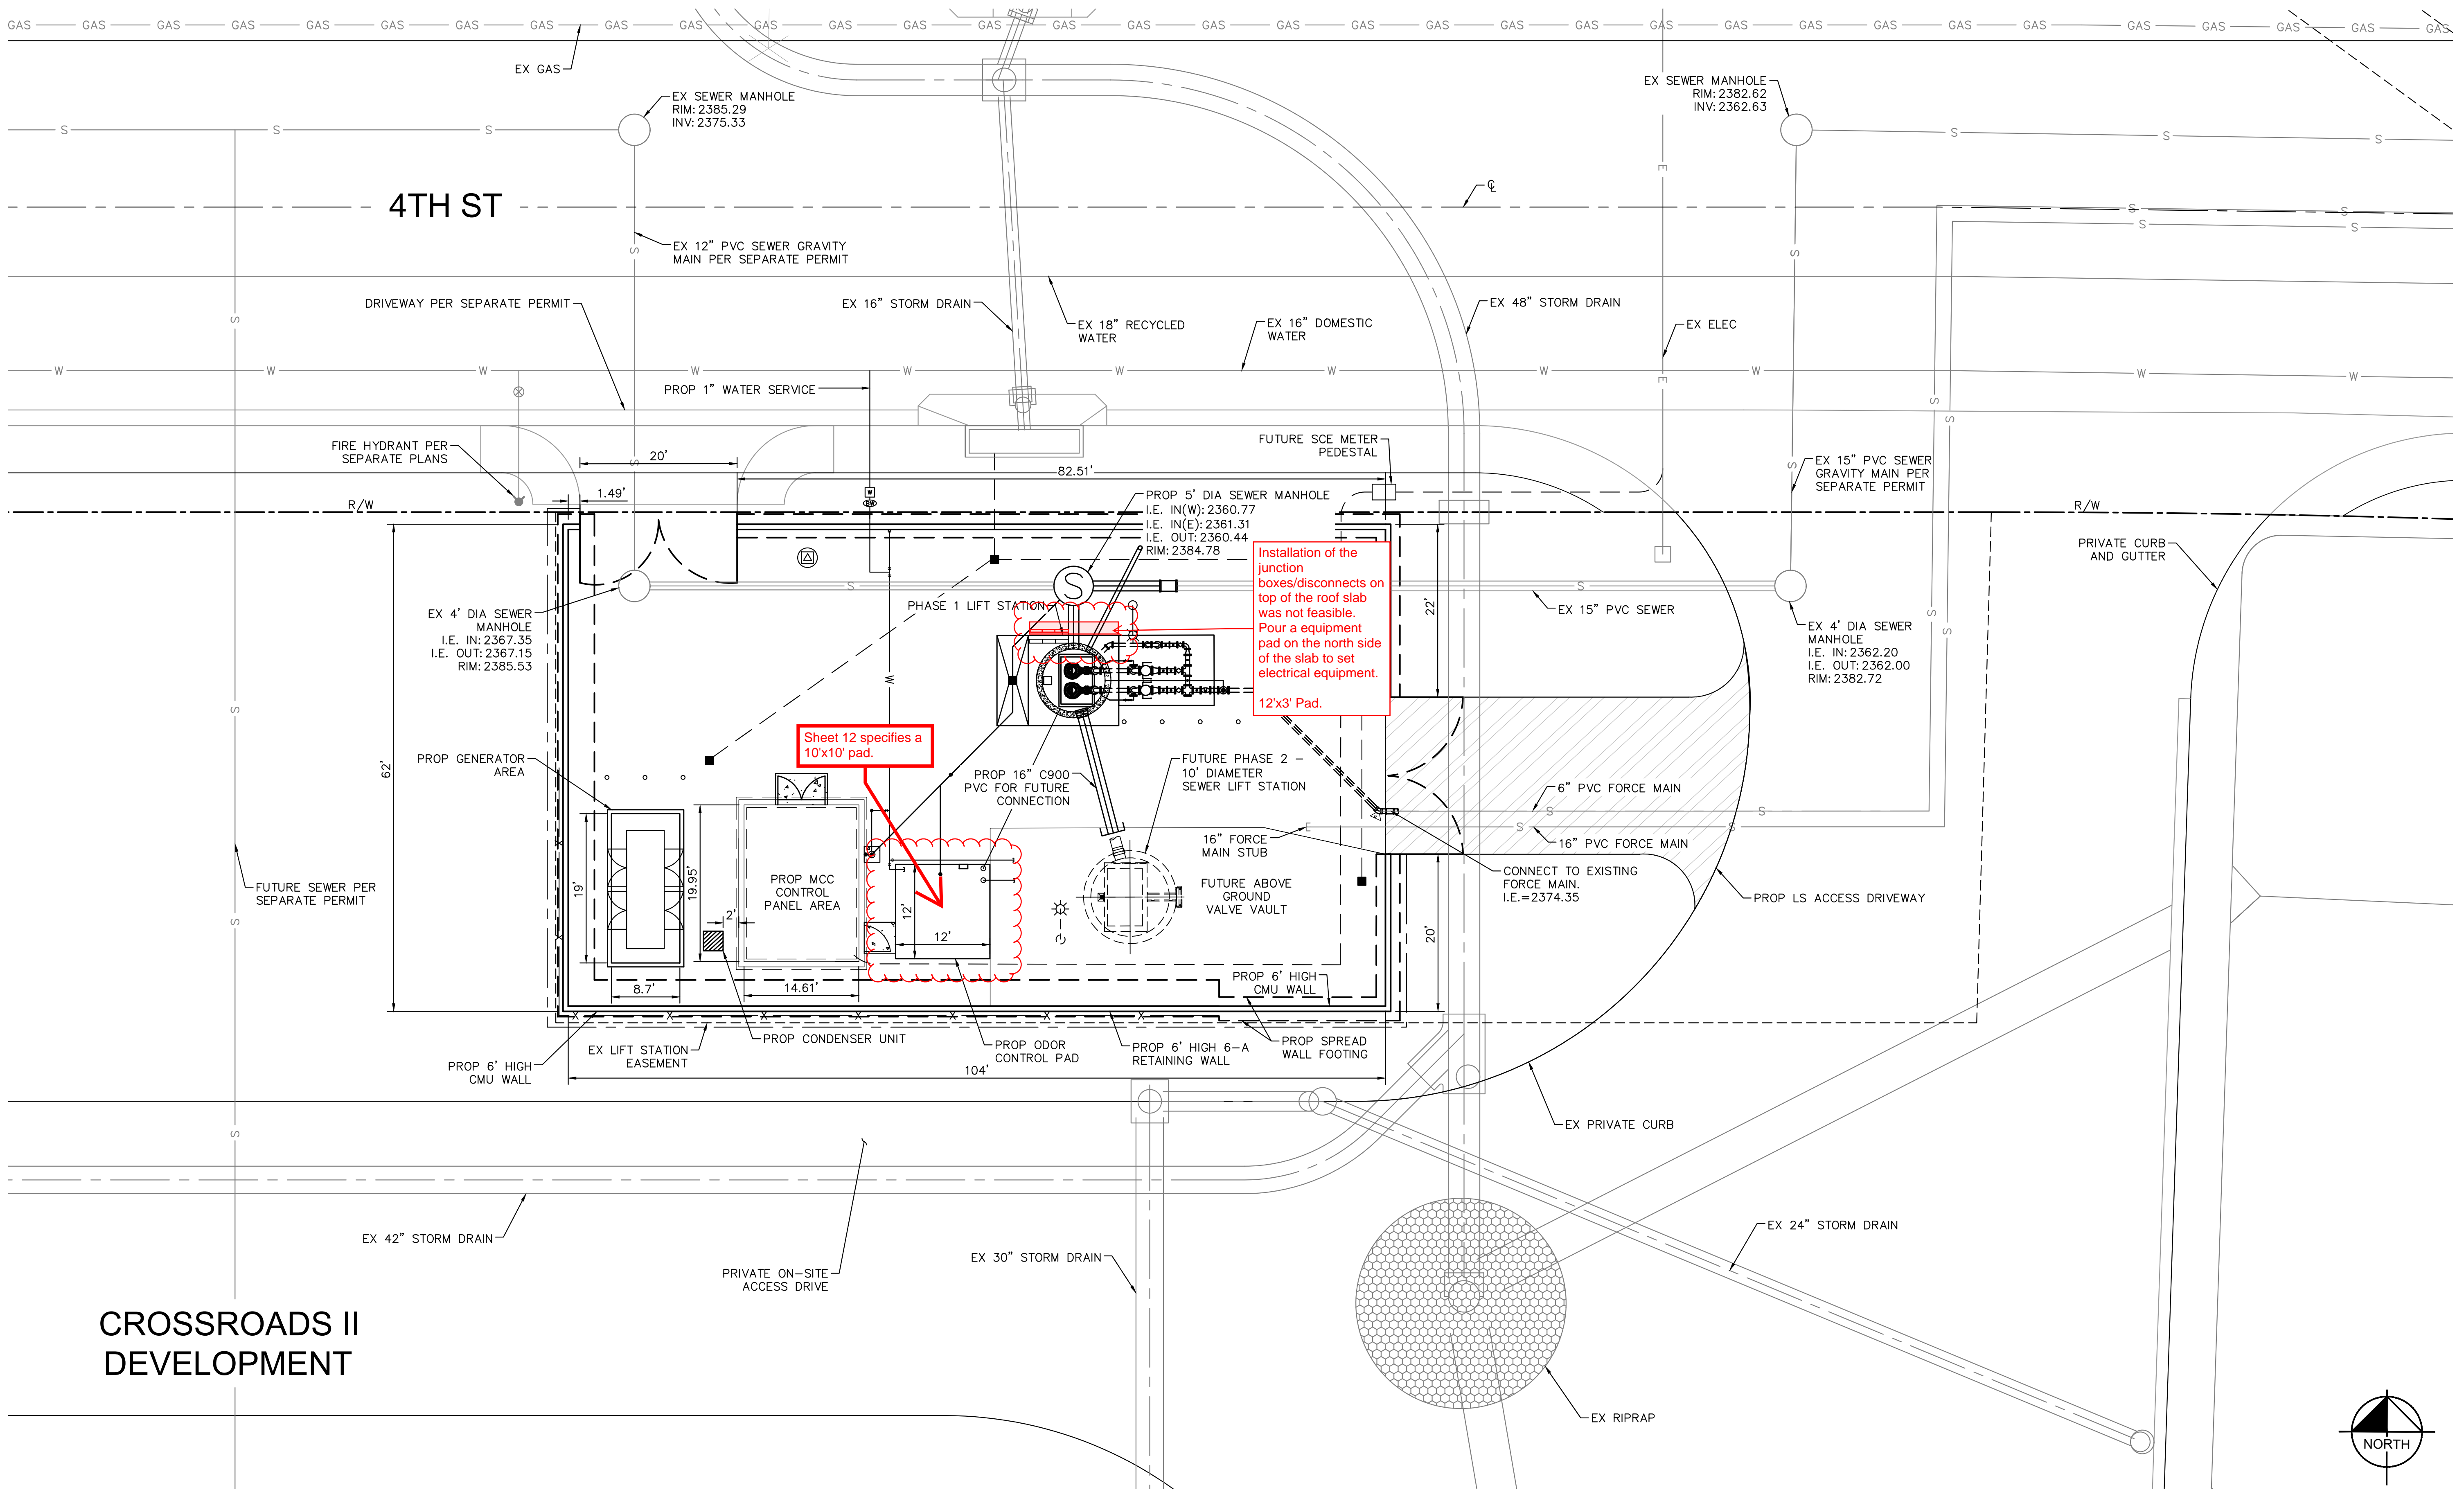

BENCHMARK:
 NATIONAL GEODETIC SURVEY BENCHMARK NO. 1311
 1.4 MILES WEST OF BEAUMONT ON INTERSTATE 10 TO SAN TIMOTEO CANYON NEAR FRONTAGE ROAD ON SOUTH(WEST) SIDE OF INTERSTATE 10, 0.1 MILES SOUTHWEST ALONG FRONTAGE ROAD, SOUTH ACROSS THE ROAD FROM A GUY POLE 25.9 FEET SOUTH OF THE CENTERLINE OF FRONTAGE ROAD, 1.8 FEET WEST OF POWERPOLE AND 1.5 FEET EAST OF A WITNESS POST, INSIDE A 4 INCH PVC PIPE WITH SCREW PLUG 1 INCH ABOVE GROUND (ELEVATION = 2468.07). ALSO SHOWN ON HIGHWAY 60 / POTRERO BLVD. INTERCHANGE STATIC GPS PROJECT CONTROL DIAGRAM AND IDENTIFIED THEREON AS 3558 BM D3474 WHEN THE PUBLISHED ELEVATION = 2468.07 IS CORRECTED WITH A MEASURED ELEVATION = 2468.01, USED HEREON.
 ELEV. 2468.01, (NVD '88), (STAMPED Q 1311 1978)

BY	MARK	DESCRIPTION	APPR.	DATE
		REVISIONS		

Kimley»Horn
 401 B Street, Suite 600, San Diego, CA 92101
 Phone: (619) 234-9411
 WWW.KIMLEY-HORN.COM

Sam McWhorter
 SAM L. MCWHORTER
 R.C.E. 61788




DESIGN BY:
 SLM
 DRAWN BY:
 RC/SW
 CHECKED BY:
 TW/SS
 SCALE:



Reviewed By: _____ Date: _____
 Staff Engineer
 Recommended for Approval By: *P. Harris* Date: 11/19/2021
 Administrative Engineer
 Approved By: *John D. Harts* Date: 11/23/2021
 City Engineer/Director of Public Works


CITY OF BEAUMONT, CALIFORNIA
 IMPROVEMENT PLANS FOR:
**BEAUMONT CROSSROADS
 LIFT STATION**
 OVERALL SITE PLAN

SHEET
3
 OF 38 SHEETS
 FILE NO:
 3387

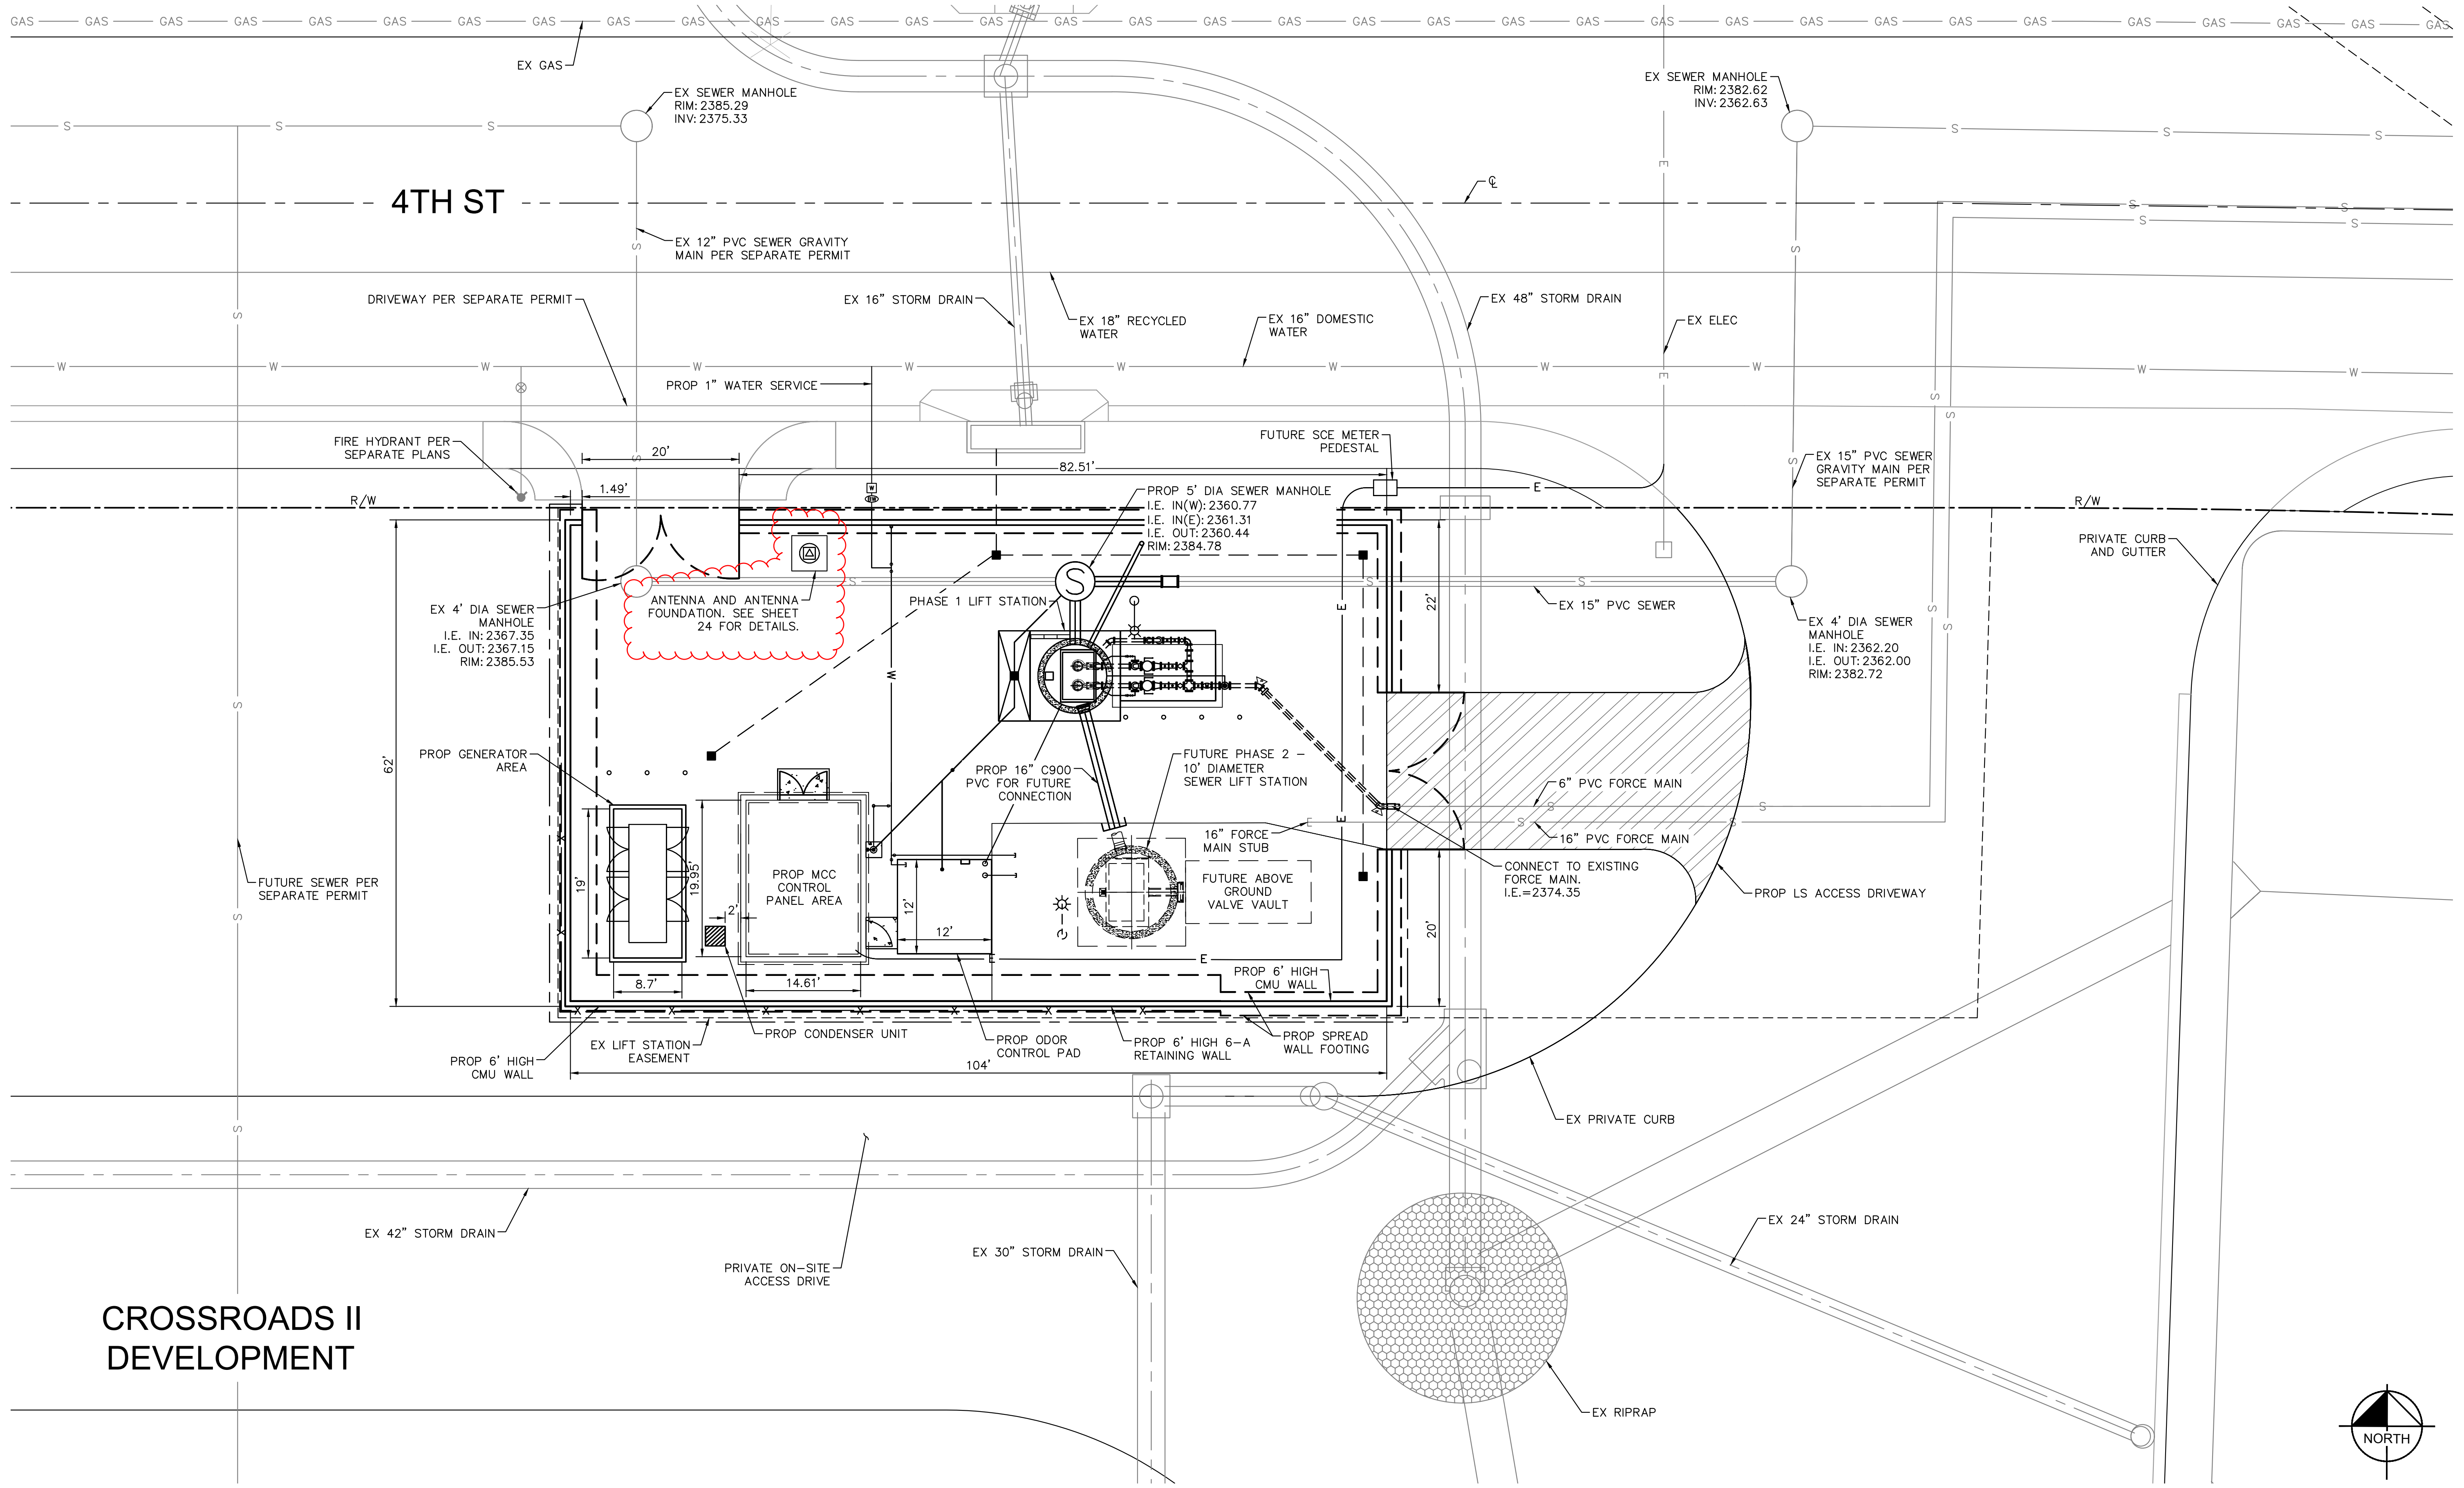

CROSSROADS II DEVELOPMENT

NOTES:
 1. CONTRACTOR SHALL FOLLOW GOVERNMENT CODE 4216 PRIOR TO ANY EXCAVATION.

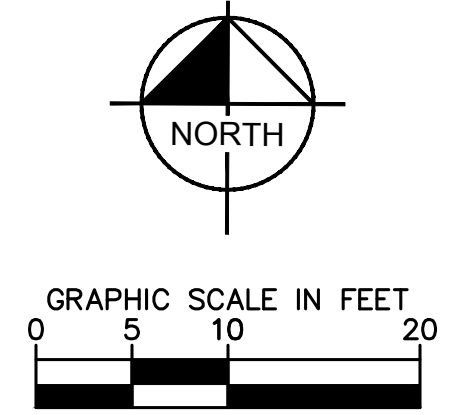

Plotted By: jfisher, Jessica Sheet Set: BEAUMONT LIFT STATION Design Plan Sheets - 2020192284001 - XSP-OVERALL.dwg
 K:\SND_WATER\192284001 Beaumont Lift Station Design Plan Sheets - 2020192284001 - XSP-OVERALL.dwg
 August 10, 2022 10:09:48am




BENCHMARK:
 NATIONAL GEODETIC SURVEY BENCHMARK NO. 1311
 1.4 MILES WEST OF BEAUMONT ON INTERSTATE 10 TO SAN TIMOTEO CANYON NEAR FRONTAGE ROAD ON SOUTH (WEST) SIDE OF INTERSTATE 10, 0.1 MILES SOUTHWEST ALONG FRONTAGE ROAD, SOUTH ACROSS THE ROAD FROM A GUY POLE 25.9 FEET SOUTH OF THE CENTERLINE OF FRONTAGE ROAD, 1.8 FEET WEST OF POWERPOLE AND 1.8 FEET EAST OF A WITNESS POST, INSIDE A 4 INCH PVC PIPE WITH SCREW PLUG 1 INCH ABOVE GROUND (ELEVATION = 2468.07). ALSO SHOWN ON HIGHWAY 60 // POTRERO BLVD. INTERCHANGE STATIC GPS PROJECT CONTROL DIAGRAM AND IDENTIFIED THEREON AS 3558 BM D34374 WHEN THE PUBLISHED ELEVATION = 2468.07 IS CORRECTED WITH A MEASURED ELEVATION = 2468.01, USED HEREON.
 ELEV. 2468.01, (NVD '88), (STAMPED Q 1311 1978)

BY	MARK	DESCRIPTION	APPR.	DATE
ENGINEER		REVISIONS		CITY

Kimley»Horn
 401 B Street, Suite 600, San Diego, CA 92101
 Phone: (619) 234-9411
 WWW.KIMLEY-HORN.COM

Sam McWhorter
 REGISTERED PROFESSIONAL ENGINEER
 R.G.E. 67788 8/23/2021

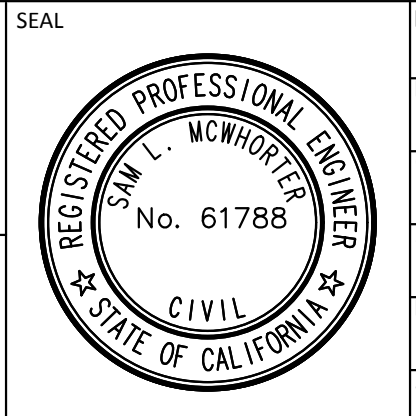

DESIGN BY: SLM
 DRAWN BY: RC/SW
 CHECKED BY: TW/SS
 SCALE: _____
 DATE: _____
 JOB NUMBER: 195284001



Reviewed By: _____ Date: _____
 Staff Engineer
 Recommended for Approval By: _____ Date: _____
 Administrative Engineer
 Approved By: _____ Date: _____
 City Engineer/Director of Public Works

CITY OF BEAUMONT, PUBLIC WORKS DEPARTMENT
 ENGINEERING DIVISION
 550E 6th St
 Beaumont, CA 92223
 TEL: (951) 769-8520 FAX: (951) 769-8526


CITY OF BEAUMONT, CALIFORNIA
 IMPROVEMENT PLANS FOR:
BEAUMONT CROSSROADS LIFT STATION
 OVERALL SITE PLAN

SHEET
3
 OF 38 SHEETS
 FILE NO: 3387

Plotted By: Carson, Brimdon. Sheet Set: BEAUMONT LIFT STATION. Structural Site Plan. Layout: STRUCTURAL SITE PLAN. August 09, 2022. 01:53:50pm. \\sdr\p01\cas_smt\15ND_WATER\15224001_Beamont Lift Station\Design\Plan Sheets - 2020\15224001 -_S1.dwg

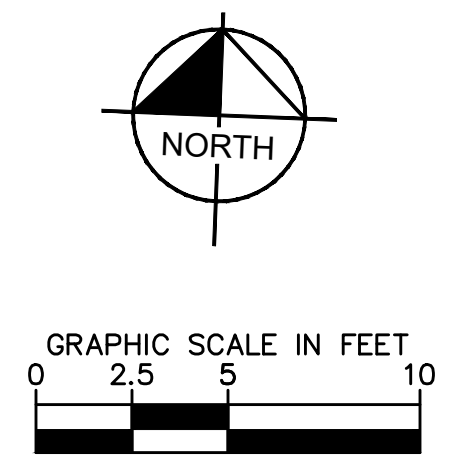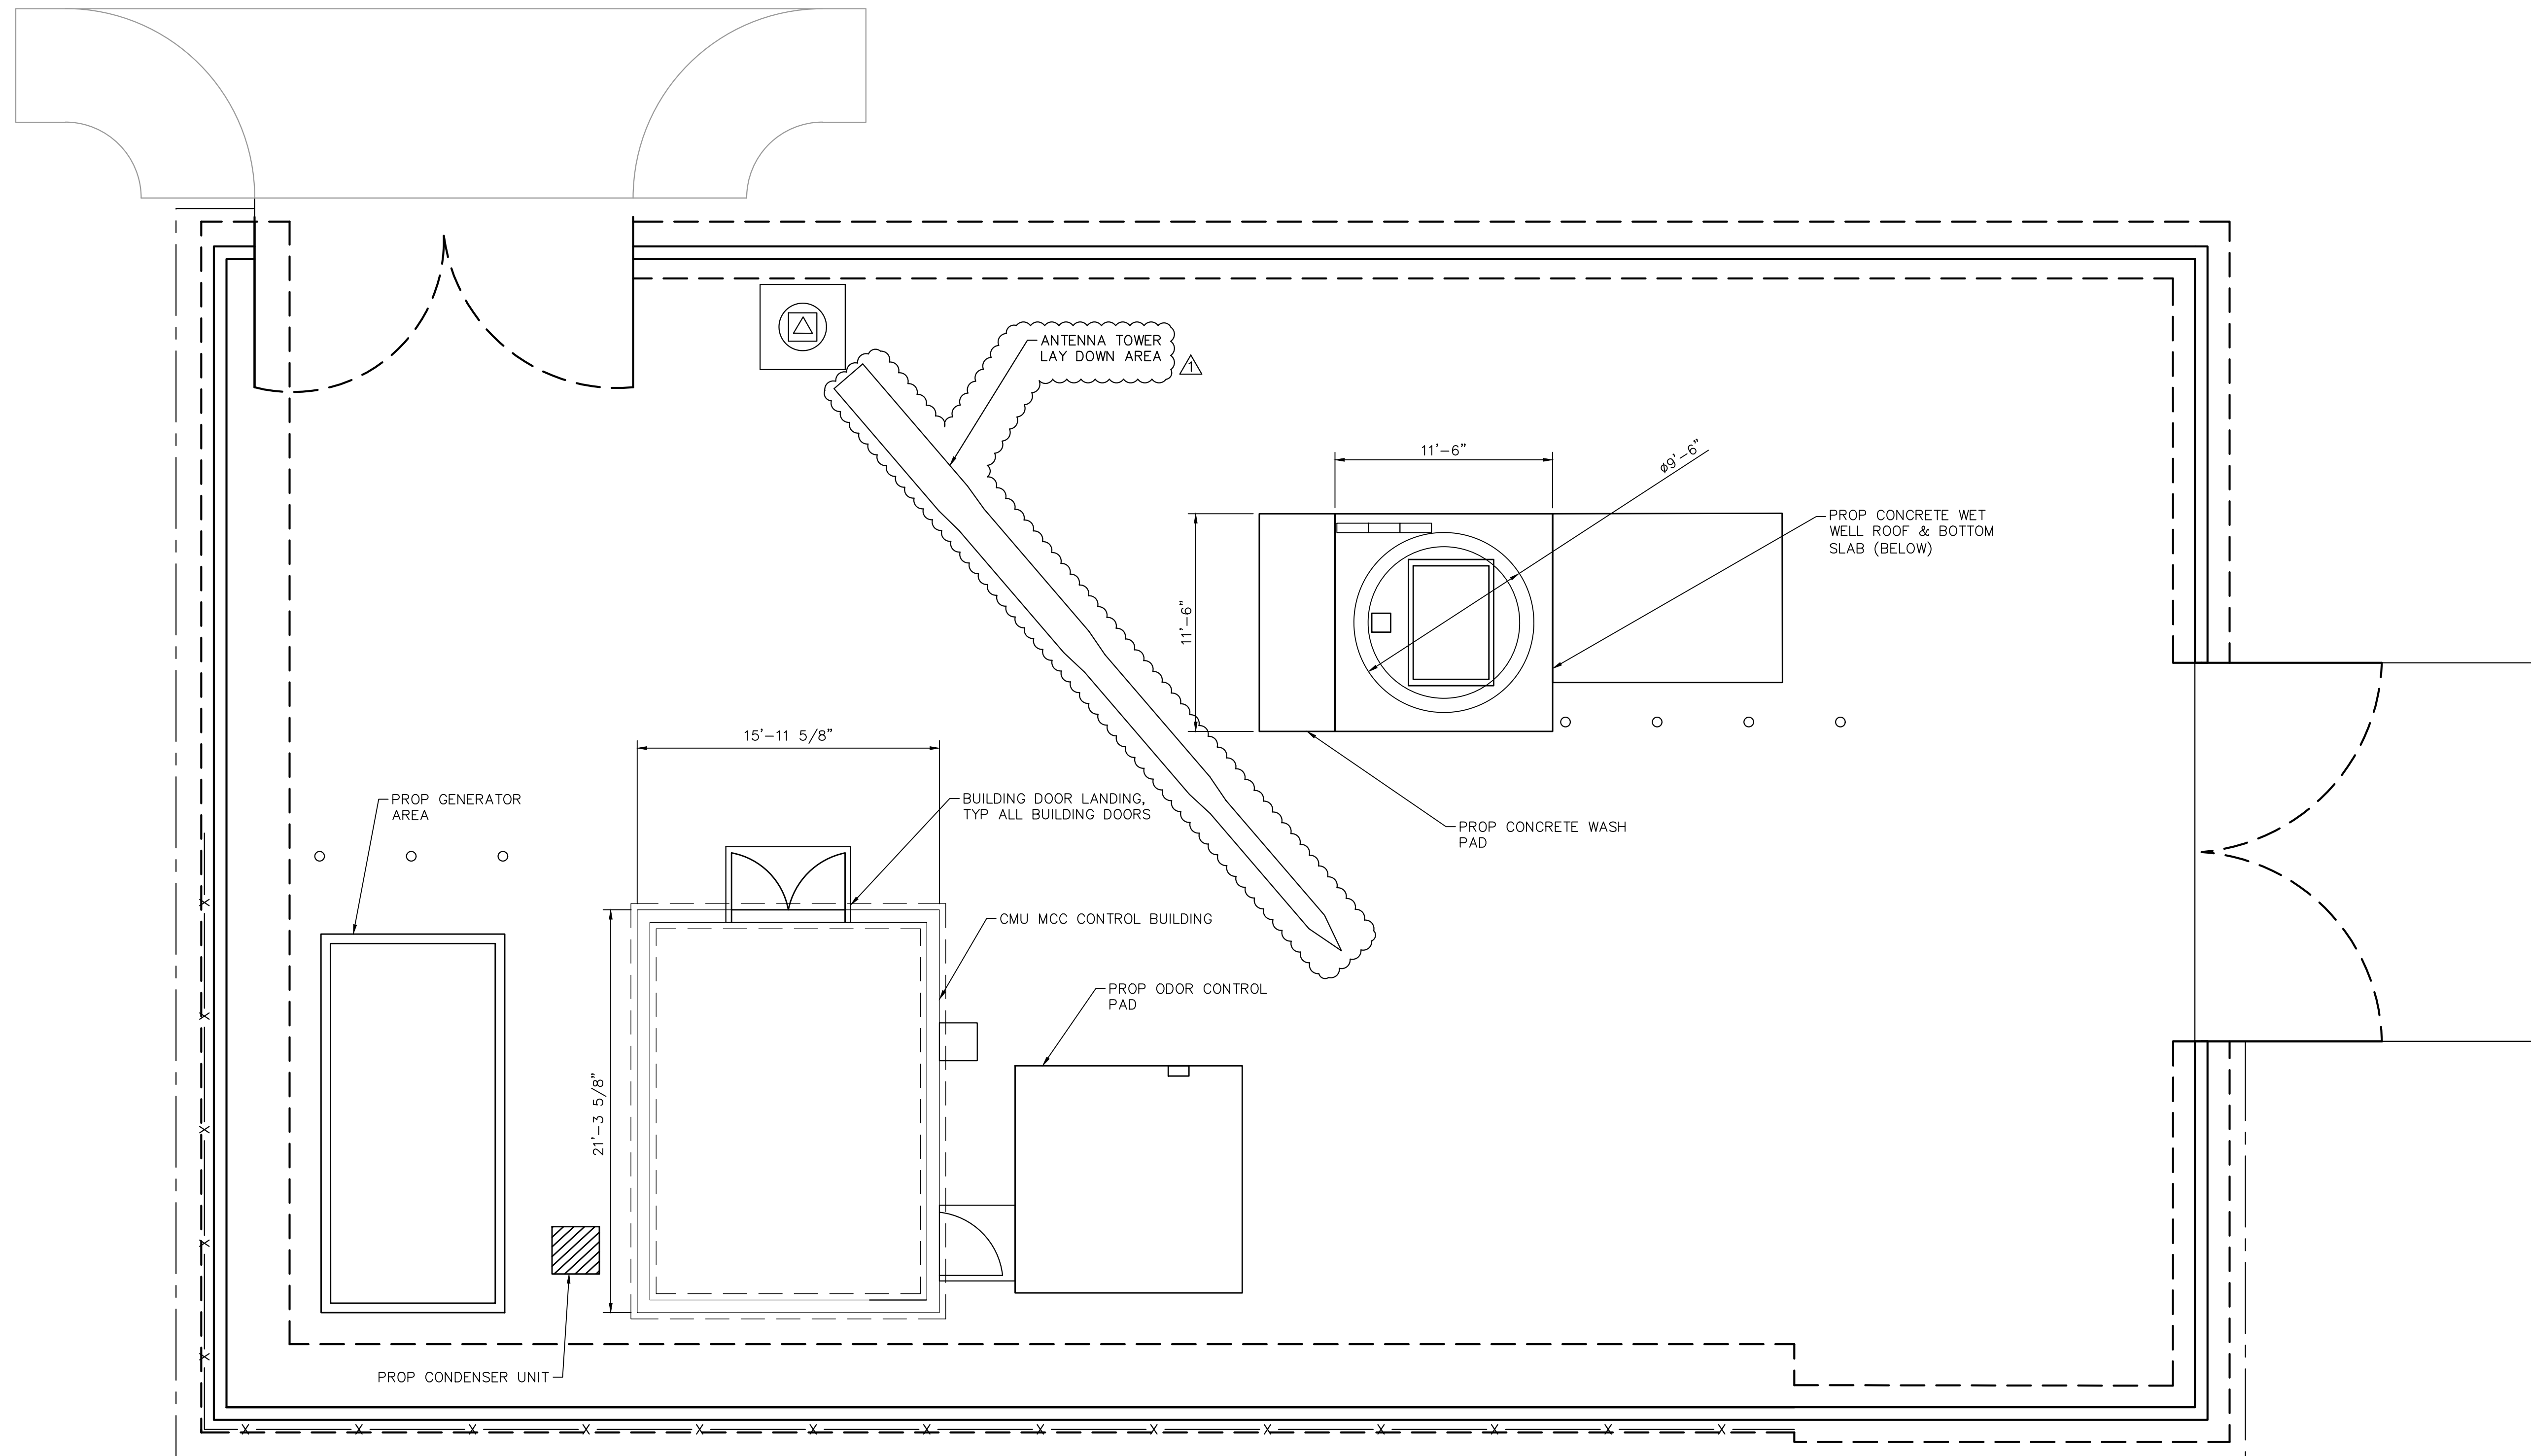

1
24 STRUCTURAL SITE PLAN
SCALE: 1" = 5'-0"

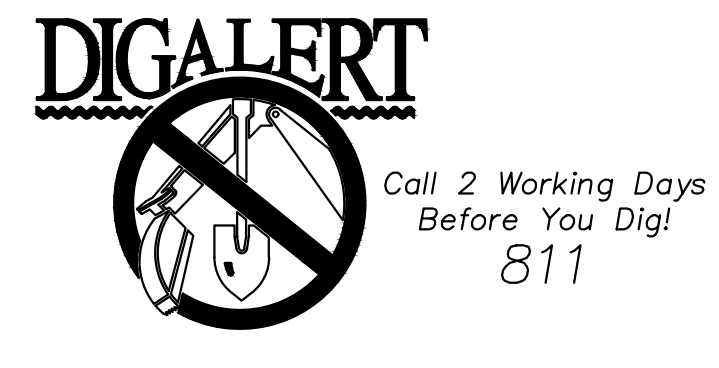

BENCHMARK:
NATIONAL GEODETIC SURVEY BENCHMARK NO. Q 1311
1.4 MILES WEST OF BEAUMONT ON INTERSTATE 10 TO SAN TIMOTEY CANYON NEAR FRONTAGE ROAD ON SOUTH (WEST) SIDE OF INTERSTATE 10, 0.1 MILES SOUTHEAST ALONG FRONTAGE ROAD, SOUTH ACROSS THE ROAD FROM A GUY POLE 25.9 FEET SOUTH OF THE CENTERLINE OF FRONTAGE ROAD, 1.8 FEET WEST OF POWERPOLE AND 1.8 FEET EAST OF A WITNESS POST, INSIDE A 4 INCH PVC PIPE WITH SCREW PLUG 1 INCH ABOVE GROUND (ELEVATION = 2468.07). ALSO SHOWN ON HIGHWAY 69 // POTRERO BLVD. INTERCHANGE STATIC GPS PROJECT CONTROL DIAGRAM AND IDENTIFIED THEREON AS 3538 BM D3474 WHEN THE PUBLISHED ELEVATION = 2468.07 IS CORRECTED WITH A MEASURED ELEVATION = 2468.01, USED HEREON.
ELEV. 2468.01, (NVD '88), (STAMPED Q 1311 1978)

BY	MARK	DESCRIPTION	APPR.	DATE
ENGINEER		REVISIONS		CITY

Kimley»Horn
401 B Street, Suite 600, San Diego, CA 92101
Phone: (619) 234-9411
WWW.KIMLEY-HORN.COM

Joseph Nunneley
JOSEPH NUNNELEY
R.S.E. 6777

08/09/2022

SEAL
JOSEPH NUNNELEY
REGISTERED PROFESSIONAL ENGINEER
S 6777
CITY OF BEAUMONT, CALIFORNIA

DESIGN BY: SLM
DRAWN BY:
RC/SW CHECKED BY:
TW/SS SCALE:
DATE:
JOB NUMBER: 195284001



Reviewed By: _____ Date: _____
Staff Engineer

Recommended for Approval By: _____ Date: _____
Administrative Engineer

Approved By: _____ Date: _____
City Engineer/Director of Public Works

CITY OF BEAUMONT, PUBLIC WORKS DEPARTMENT
ENGINEERING DIVISION

550E 6th St
Beaumont, CA 92223
TEL: (951) 769-8520 FAX: (951) 769-8526

CITY OF BEAUMONT, CALIFORNIA
IMPROVEMENT PLANS FOR:
**BEAUMONT CROSSROADS
LIFT STATION**
STRUCTURAL SITE PLAN

SHEET
24
OF 38 SHEETS
FILE NO:
3387

1.00 DOCUMENTS AND LIMITATIONS

- 1.01 THESE STRUCTURAL DOCUMENTS, TOGETHER WITH THE CONCEPTS AND DESIGNS PRESENTED HEREIN, AS AN INSTRUMENT OF SERVICE, ARE INTENDED ONLY FOR THE SPECIFIC PURPOSE AND CLIENT FOR WHICH IT WAS PREPARED...

2.00 CONSTRUCTION SAFETY

- 2.01 IT IS UNDERSTOOD THAT THE CONTRACTOR IS SOLELY RESPONSIBLE FOR INITIATING, MAINTAINING, AND SUPERVISING ALL SAFETY PRECAUTIONS AND PROGRAMS IN CONNECTION WITH THE WORK ON THE PROJECT...

3.00 REINFORCED CONCRETE (CAST-IN-PLACE)

- 3.01 DETAILING OF REBAR SHALL BE IN ACCORDANCE WITH THE LATEST REVISION OF THE ACI DETAILING MANUAL, AND CONCRETE REINFORCING INSTITUTE'S LATEST EDITION OF "MANUAL OF STANDARD PRACTICE"...

4.00 ALUMINUM

- 4.01 ALUMINUM CONSTRUCTION SHALL CONFORM TO THE LATEST EDITION OF THE ALUMINUM CONSTRUCTION MANUAL OF THE ALUMINUM ASSOCIATION...

5.00 STRUCTURAL STEEL

- 5.01 DESIGN, FABRICATION AND ERECTION SHALL BE IN ACCORDANCE WITH AISC 360-16 "SPECIFICATIONS FOR STRUCTURAL STEEL BUILDINGS"...

6.00 DESIGN LOADS

- 6.01 2019 CALIFORNIA BUILDING CODE
6.02 BUILDING CATEGORY = II
6.03 ANTENNA TOWER LOADING:
A. DEAD: SELF WEIGHT OF MEMBERS
B. LIVE: N/A
C. SNOW: N/A
D. WIND: DESIGN LOAD BASED ON ASCE 7-16 CHAPTER 29 PART 4
E. SEISMIC: DESIGN LOAD BASED ON ASCE 7-16 CHAPTER 15
F. SOIL: ALLOWABLE SOIL BEARING PRESSURE = 1500 PSF

SCHEDULE OF SPECIAL INSPECTION SERVICES table with columns: ITEM, QUALIFICATIONS, SCOPE. Rows include WELDING, MIX DESIGN / MATERIAL CERTIFICATION, REINFORCEMENT INSTALLATION, CONCRETE PLACEMENT, EVALUATION OF CONCRETE STRENGTH.

90 DEG STD HOOKS table with columns: BAR SIZE, #3, #4, #5, #6, #7, #8, #9, #10, #11 and rows for fc = 4 KSI, 5 KSI, 7 KSI, 9 KSI.

NOTES:
1. VALUES ASSUME NO EPOXY-COATING IS USED AND NORMAL WEIGHT AGGREGATE CONCRETE
2. NO REDUCTION FACTORS IN ACI 318, SECTION 12.5.3 ARE APPLIED TO THESE VALUES.

Large table of abbreviations and definitions. Columns include various codes (A/E, AB, ABC, etc.) and their corresponding full names (ARCHITECT/ENGINEER, ANCHOR BOLT, etc.).

Kimley Horn
2022©
4637 CHABOT DR SUITE 300 PLEASANTON, CA 94588 PHONE: 925.398.4840

This document is an instrument of service prepared solely for Kimley-Horn's client and for a particular purpose. Any other use or reliance is without liability to Kimley-Horn.



BEAUMONT LIFT STATION

OWNER/APPLICANT: MCDONALD PROPERTY GROUP 1140 N. COAST HIGHWAY LAGUNA BEACH, CA 92651

Revision table with columns: NO., DATE, DRAWING ISSUE DESCRIPTION. Row 1: 01 08/09/22 PLAN CHECK COMMENTS. Row 2: 02 07/07/22 ISSUED FOR PERMIT.

DESIGNED BY: BC
DRAWN BY: BC
CHECKED BY: BC
SCALE: None
DATE: 07/07/2022
PROJECT NO: 123456
FILENAME:

STRUCTURAL GENERAL NOTES

9/8/2022 2:18:07 PM \\s001\... \Beaumont Lift Station Design\Drawings\2022\01 Plan Check Comments\Beaumont Lift Station - General.dwg

This document is an instrument of service prepared solely for Kimley-Horn's client and for a particular purpose. Any other use or reliance is without liability to Kimley-Horn.

SEALS



BEAUMONT
LIFT STATION

OWNER/APPLICANT:
MCDONALD PROPERTY GROUP
1140 N. COAST HIGHWAY
LAGUNA BEACH, CA 92651


NO.	DATE	DRAWING ISSUE DESCRIPTION
1	08/09/22	PLAN CHECK COMMENTS
0	07/07/22	ISSUED FOR PERMIT

DESIGNED BY: BC
DRAWN BY: BC
CHECKED BY: BC
SCALE: NTS
DATE: 07/07/2022
PROJECT NO: 123456
FILENAME:


STRUCTURAL
SECTIONS, PLANS,
AND DETAILS

Project Status


S101

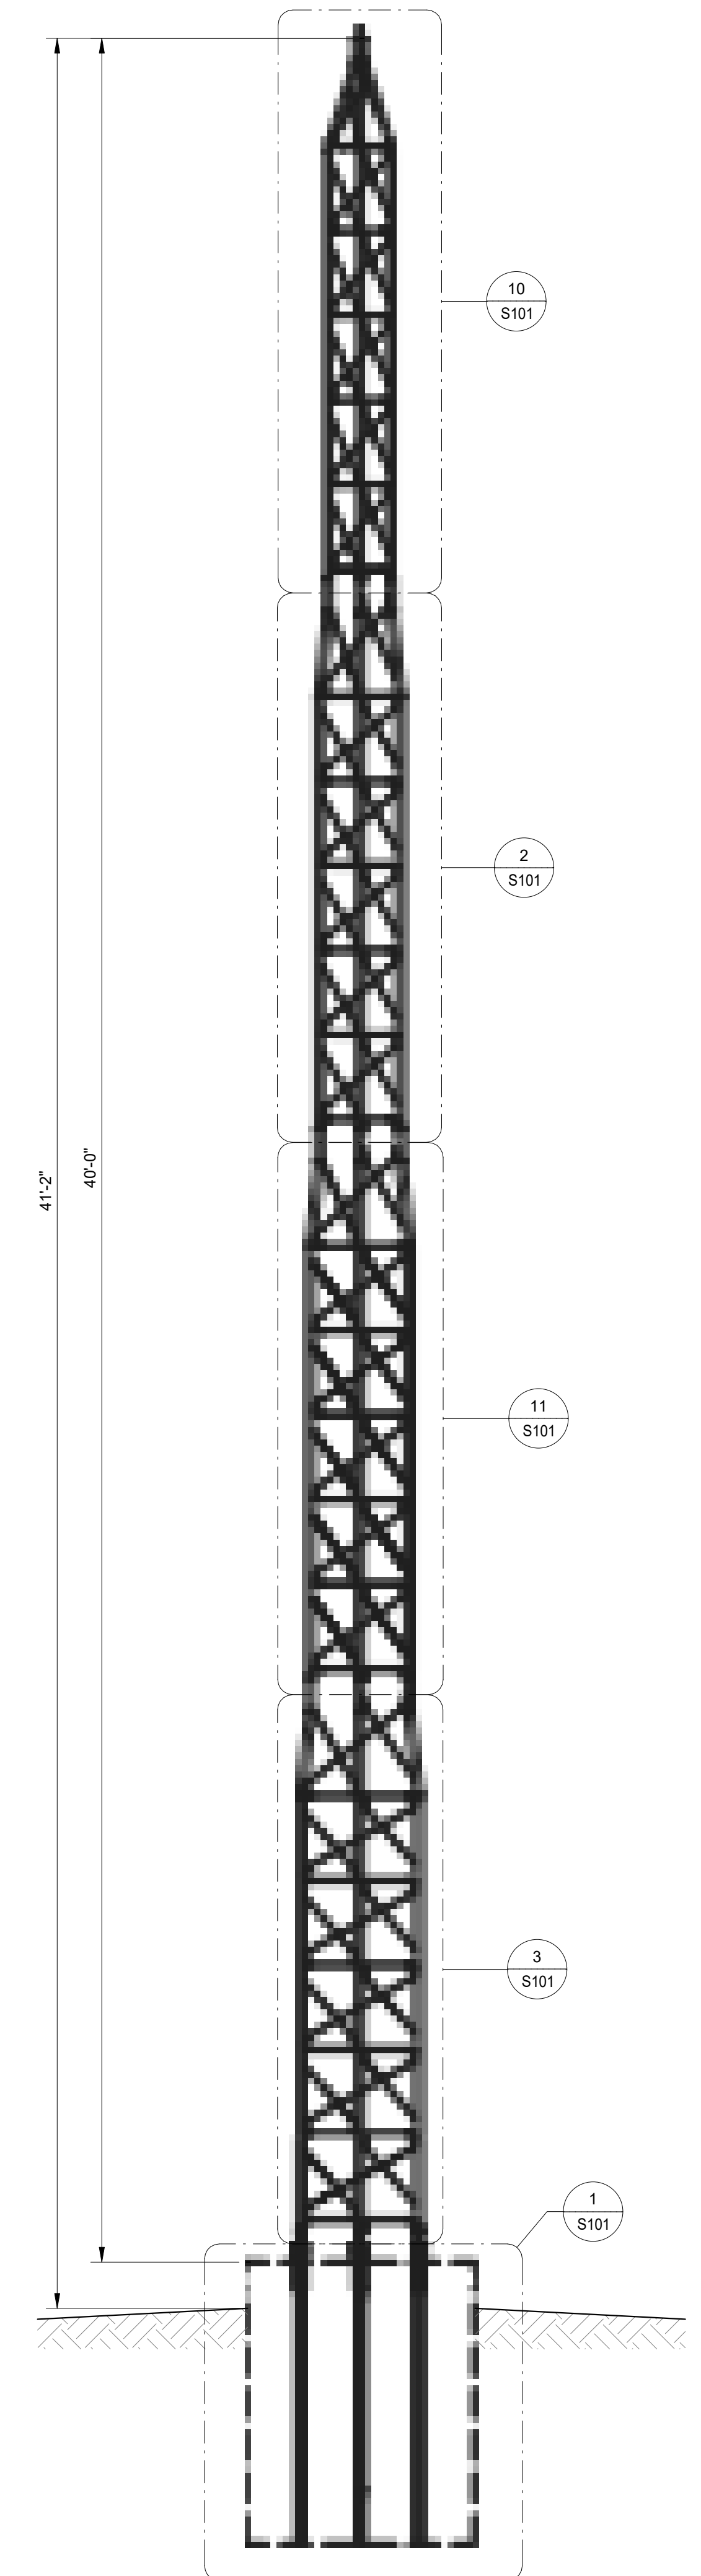


4 TOWER SECTION
SCALE: NTS

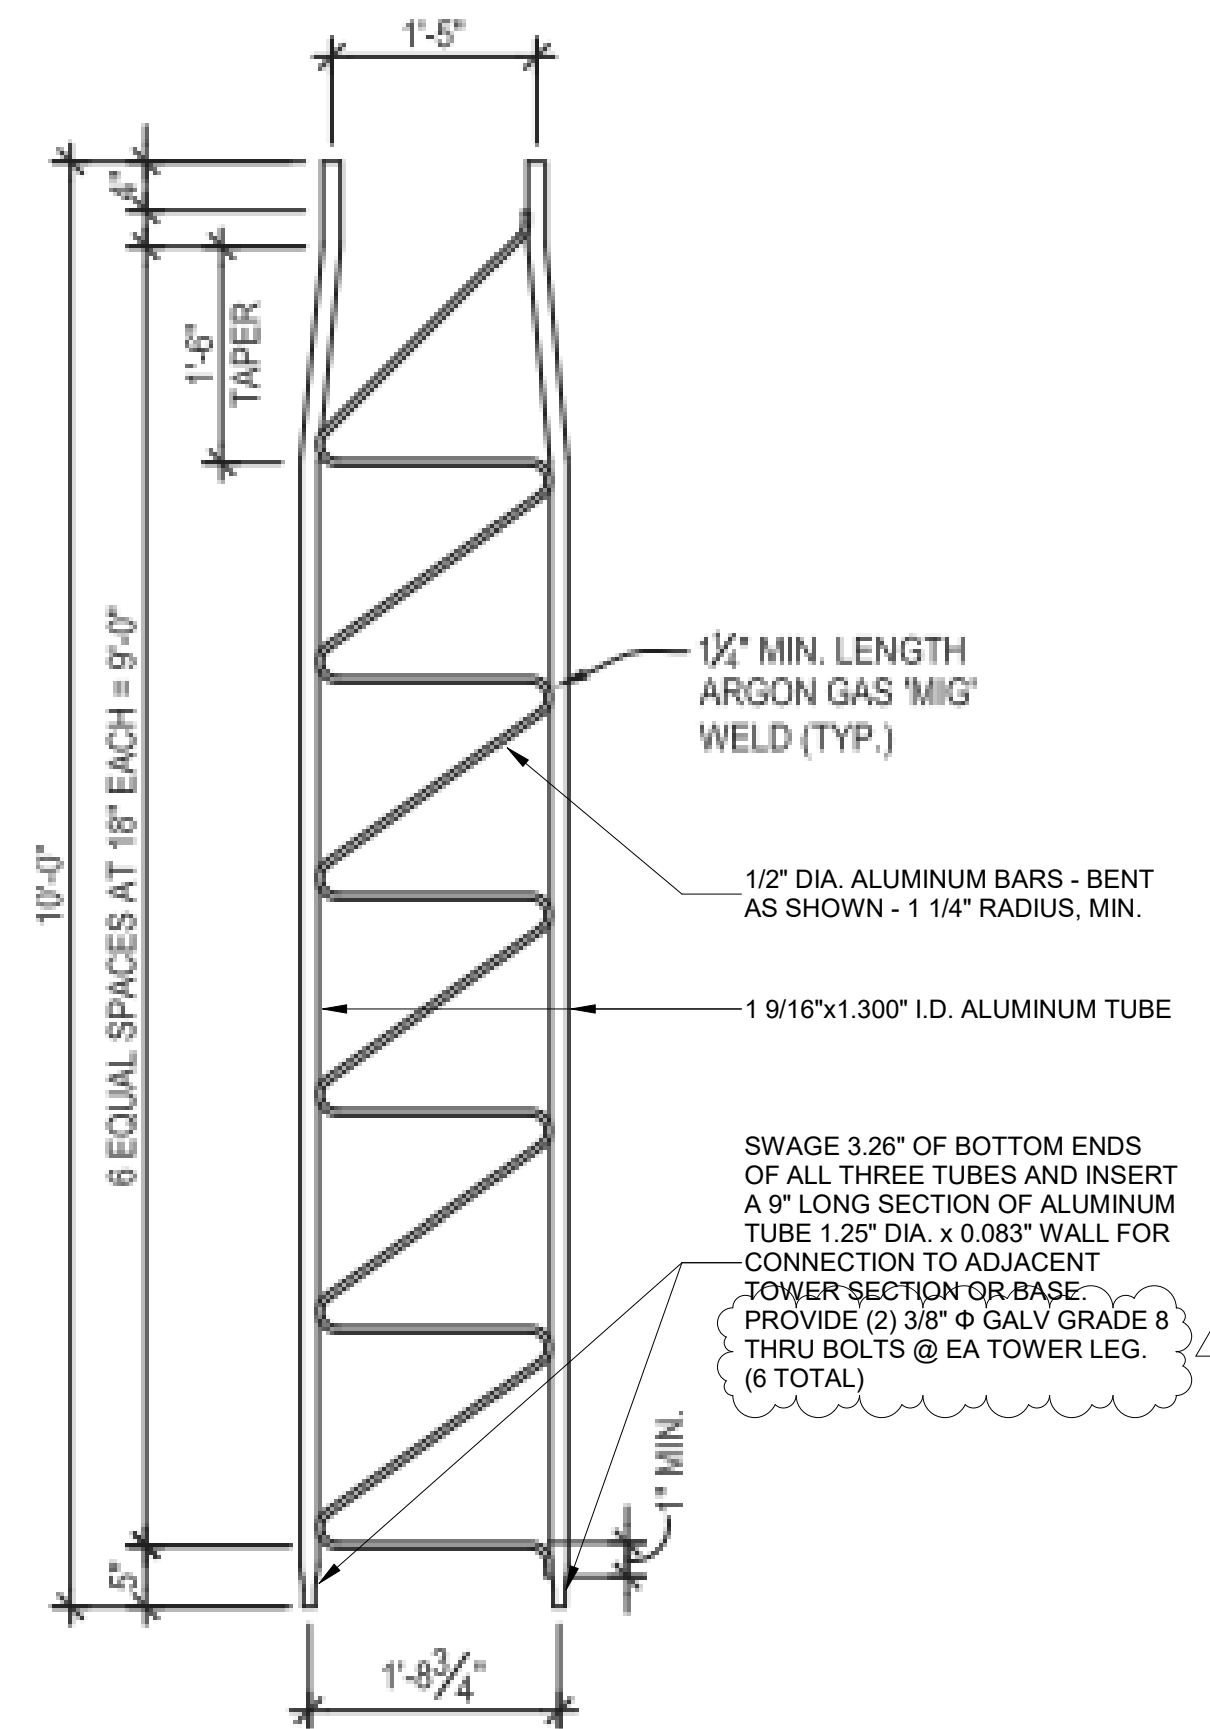


11 ENLARGED TOWER SECTION - LEVEL 2
SCALE: NTS

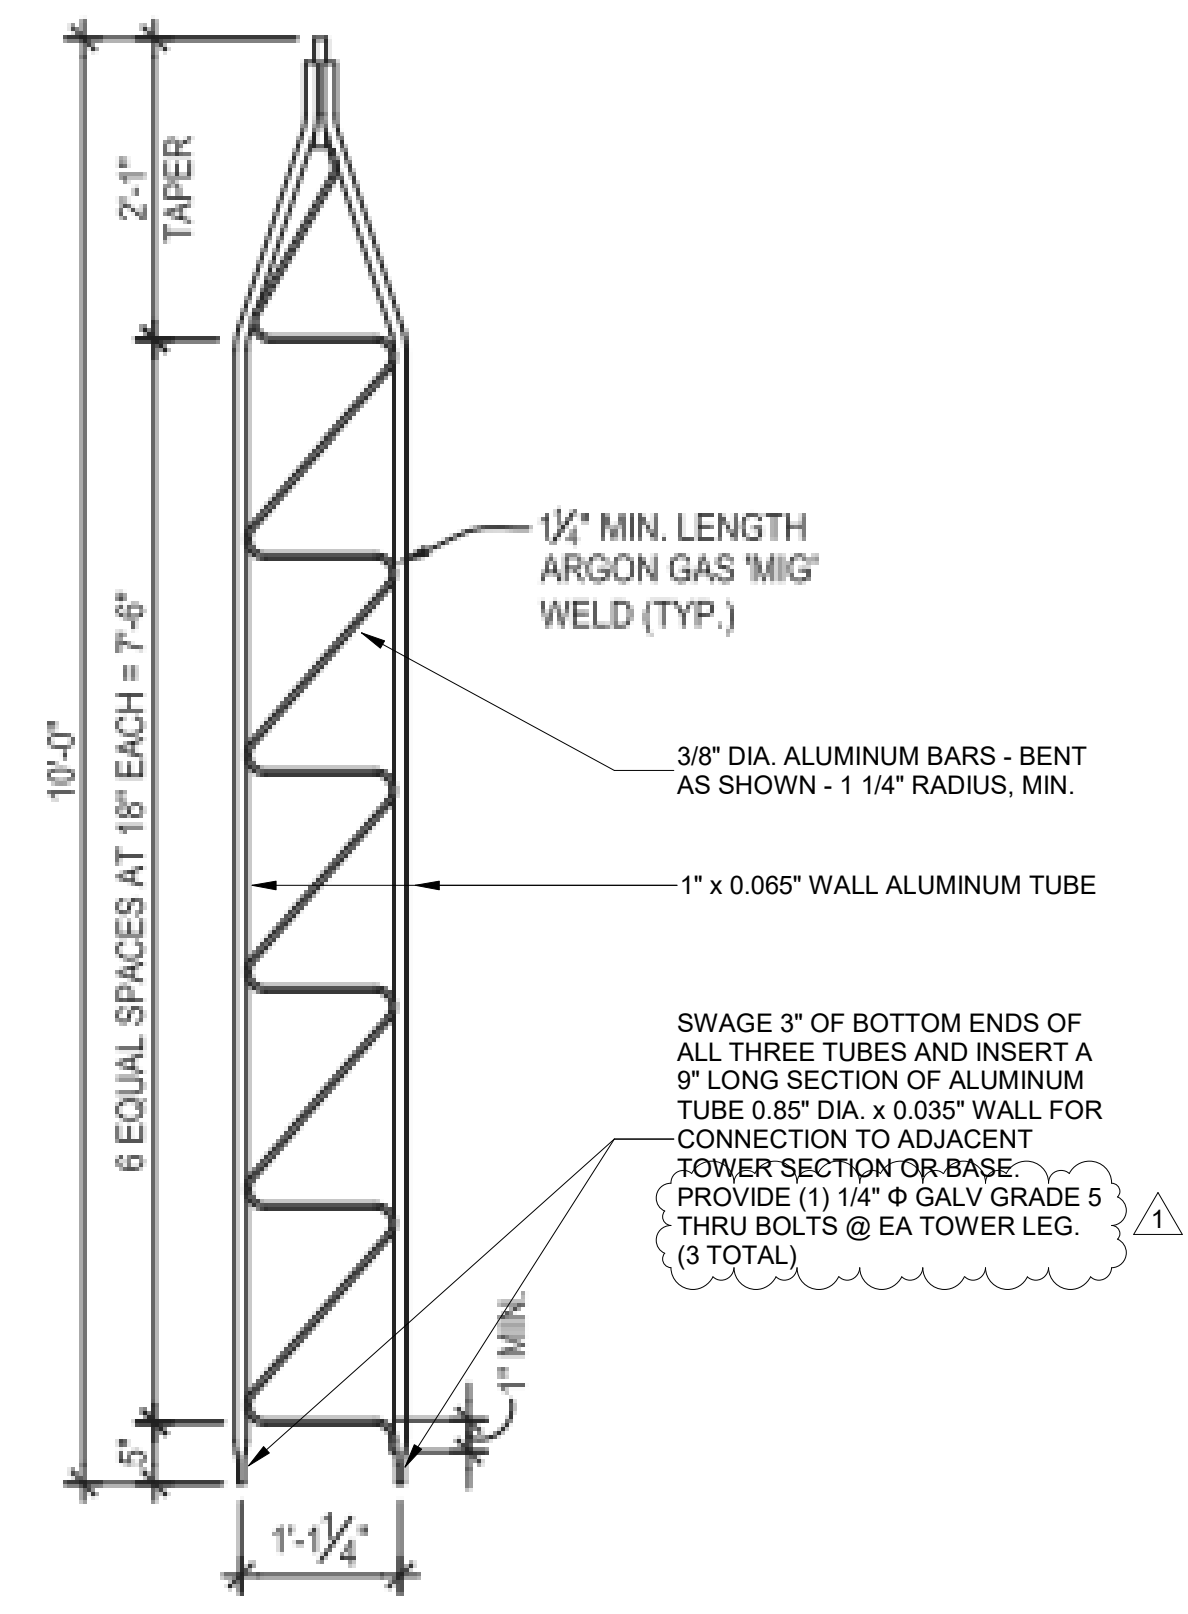


10 ENLARGED TOWER SECTION - LEVEL 4
SCALE: NTS

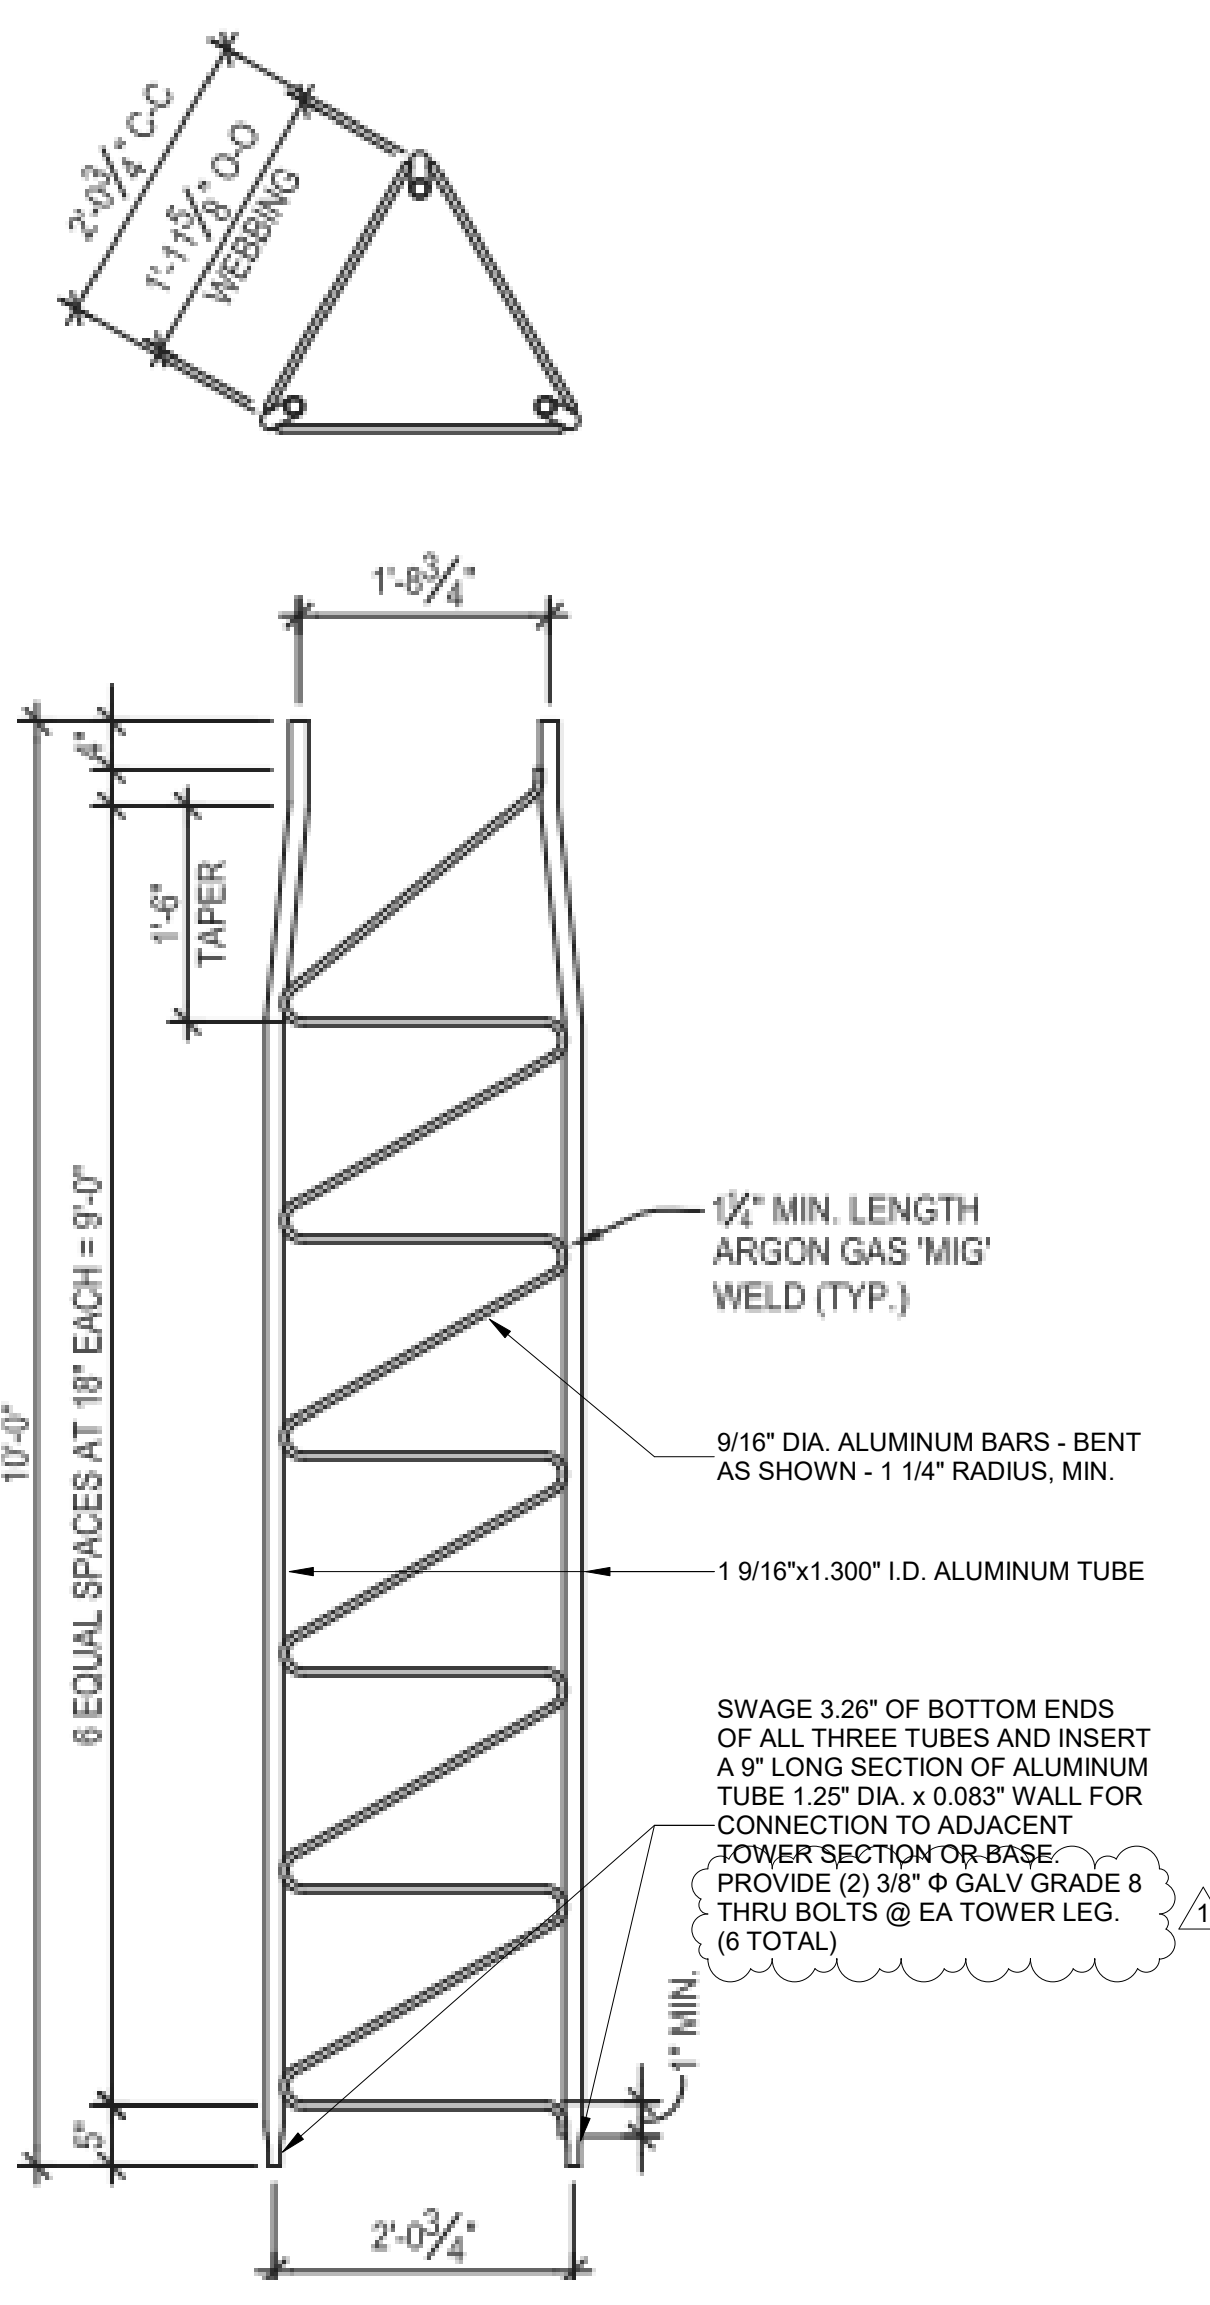


3 ENLARGED TOWER SECTION - LEVEL 1
SCALE: NTS

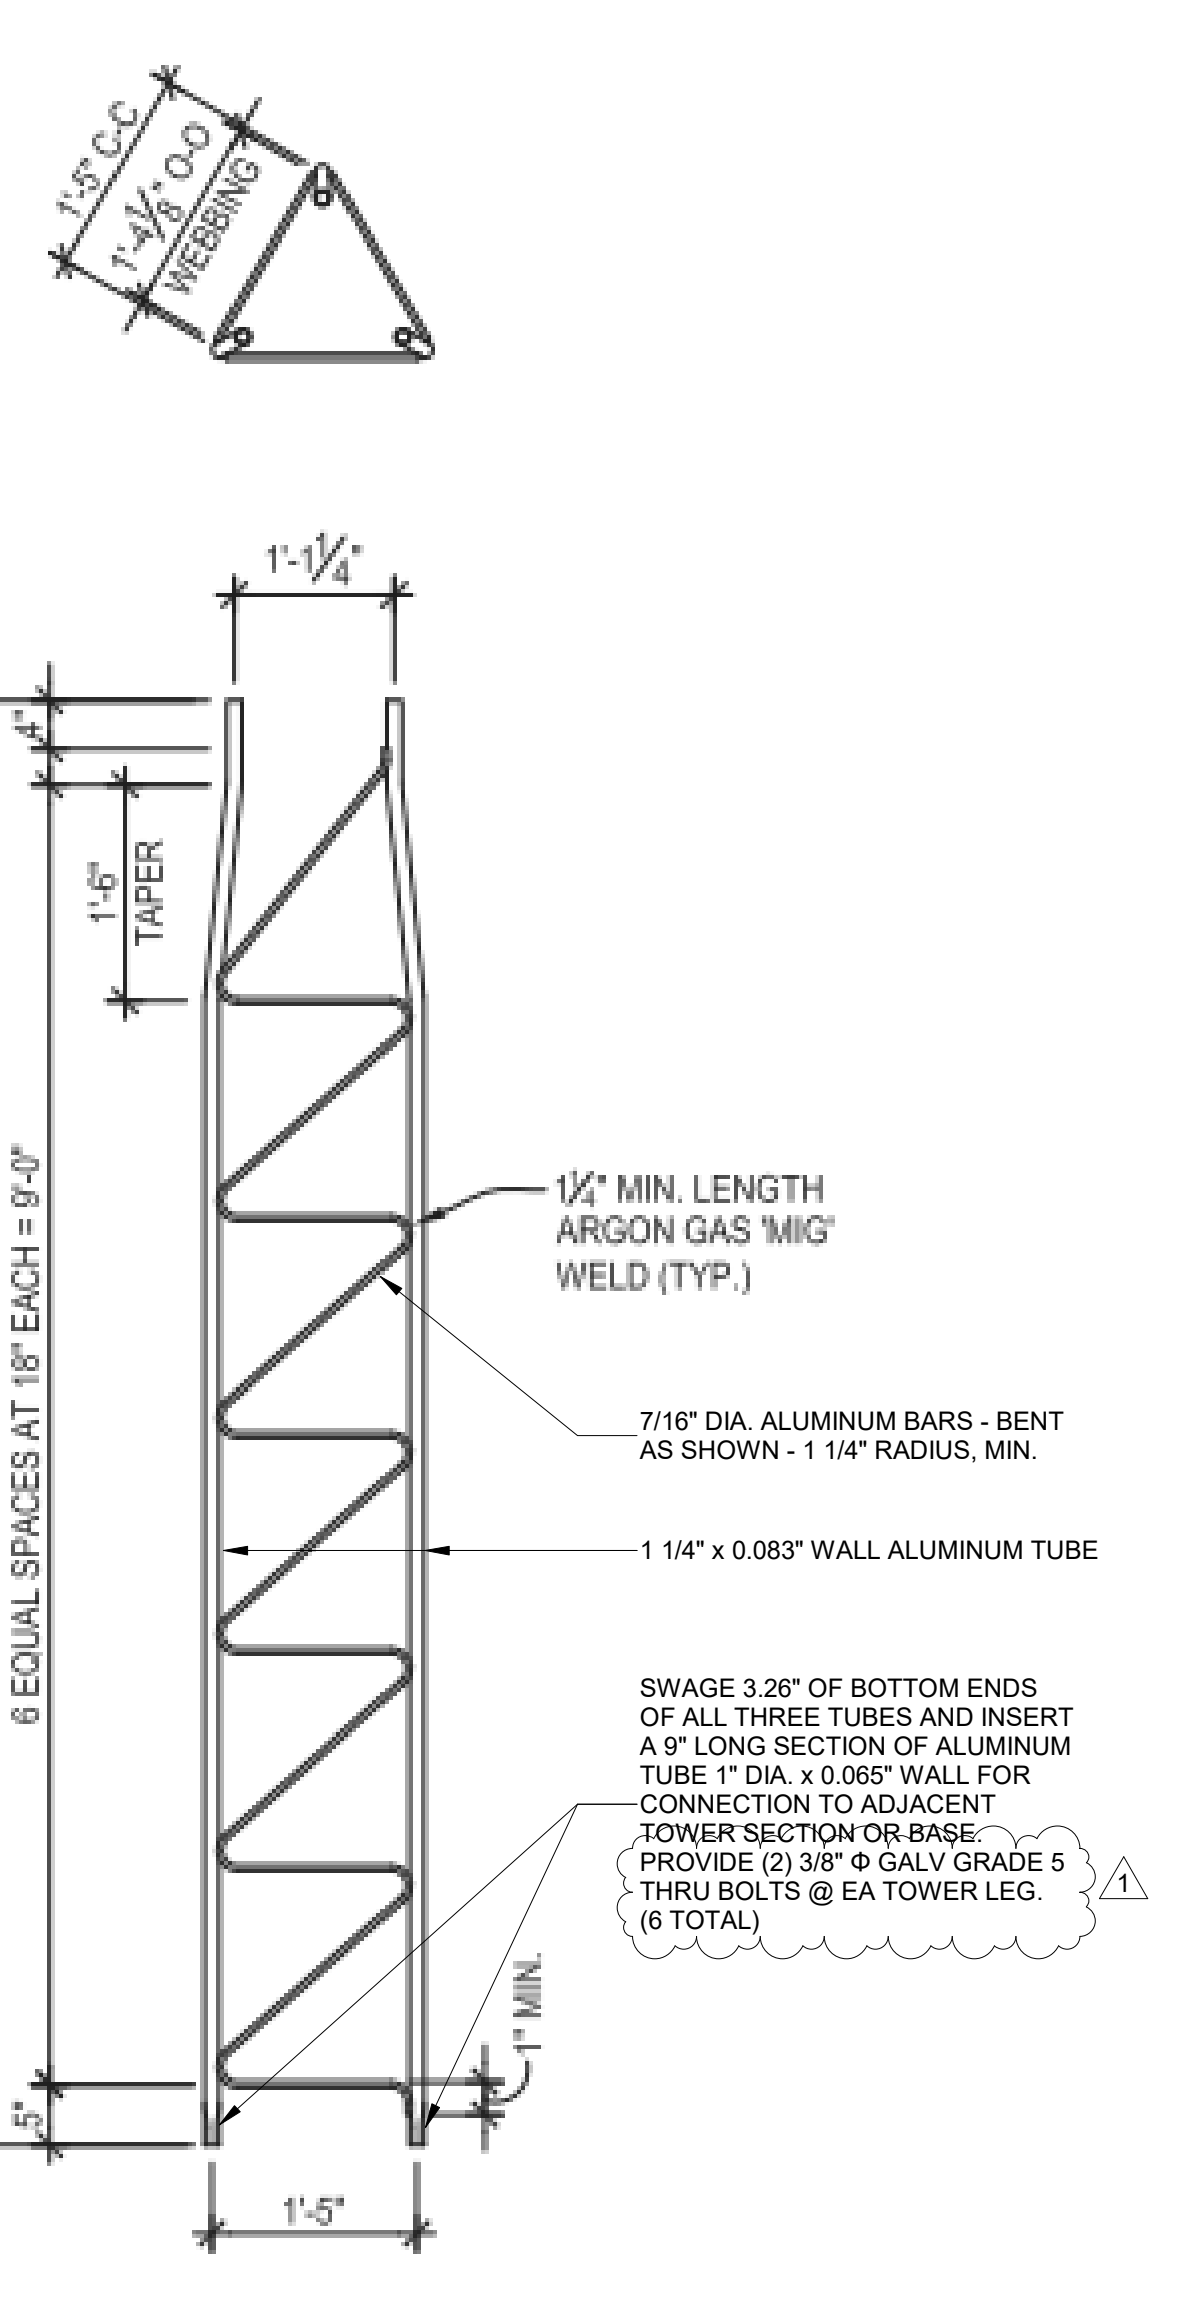


2 ENLARGED TOWER SECTION - LEVEL 3
SCALE: NTS

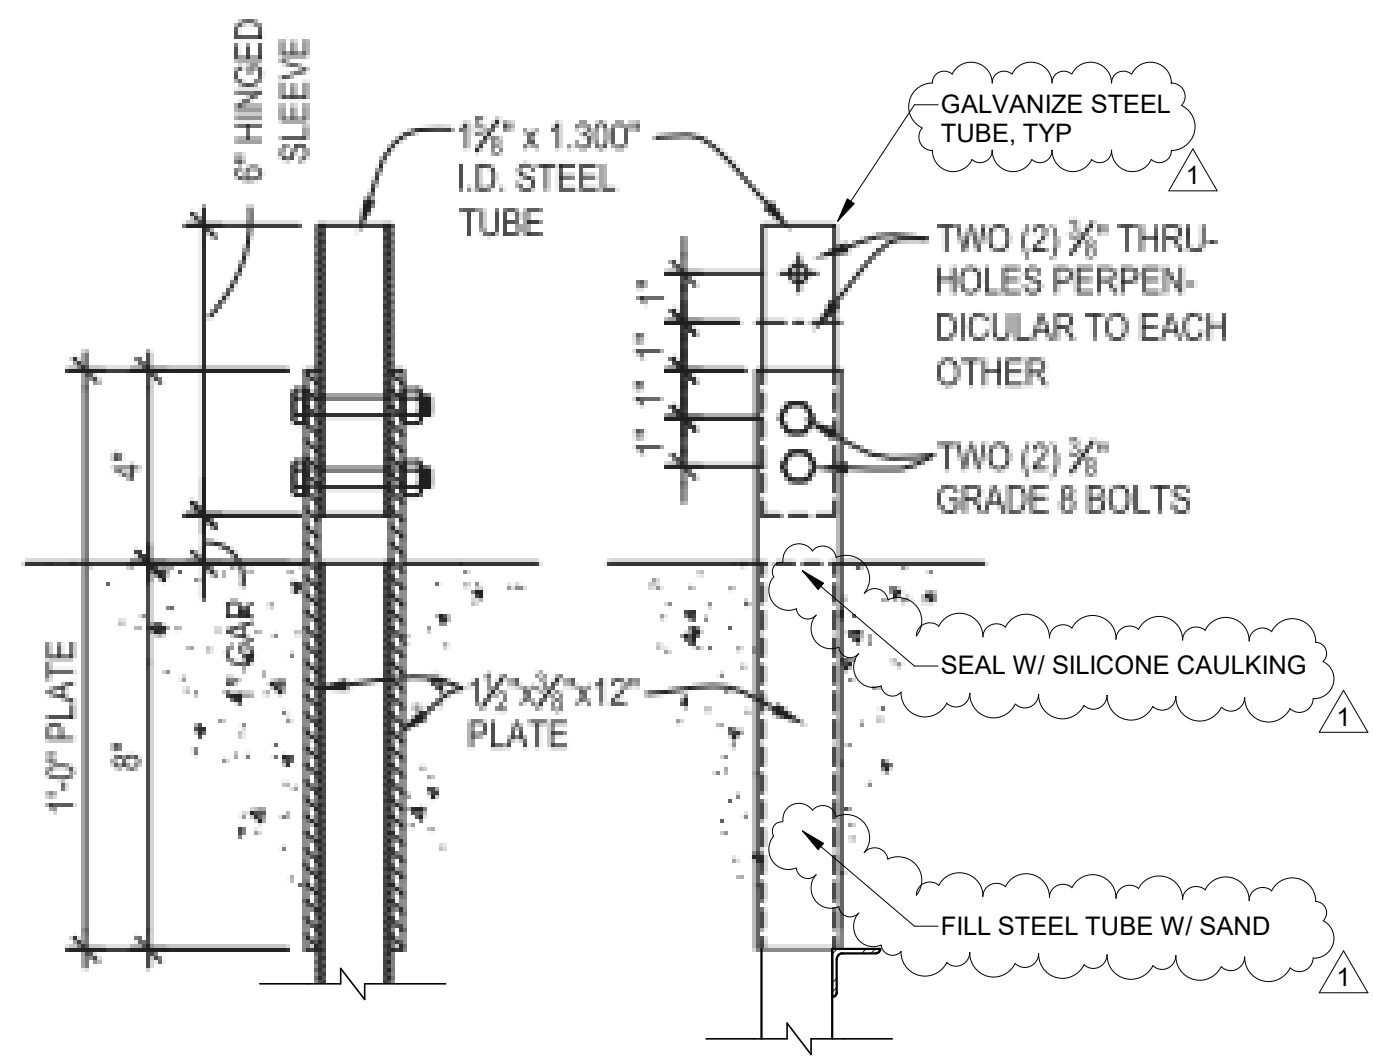


13 BASE CONNECTION DETAIL
SCALE: NTS

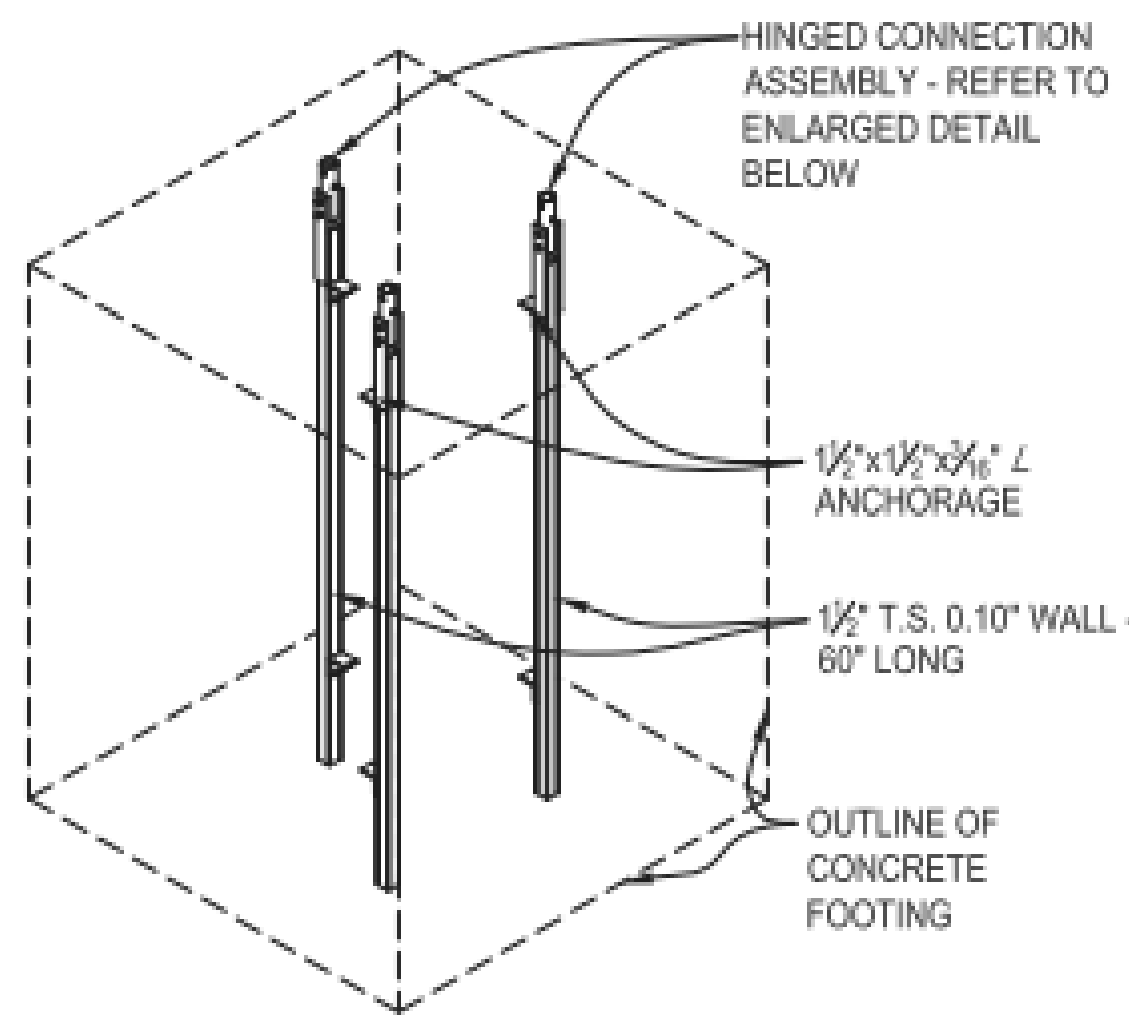

B ISOMETRIC

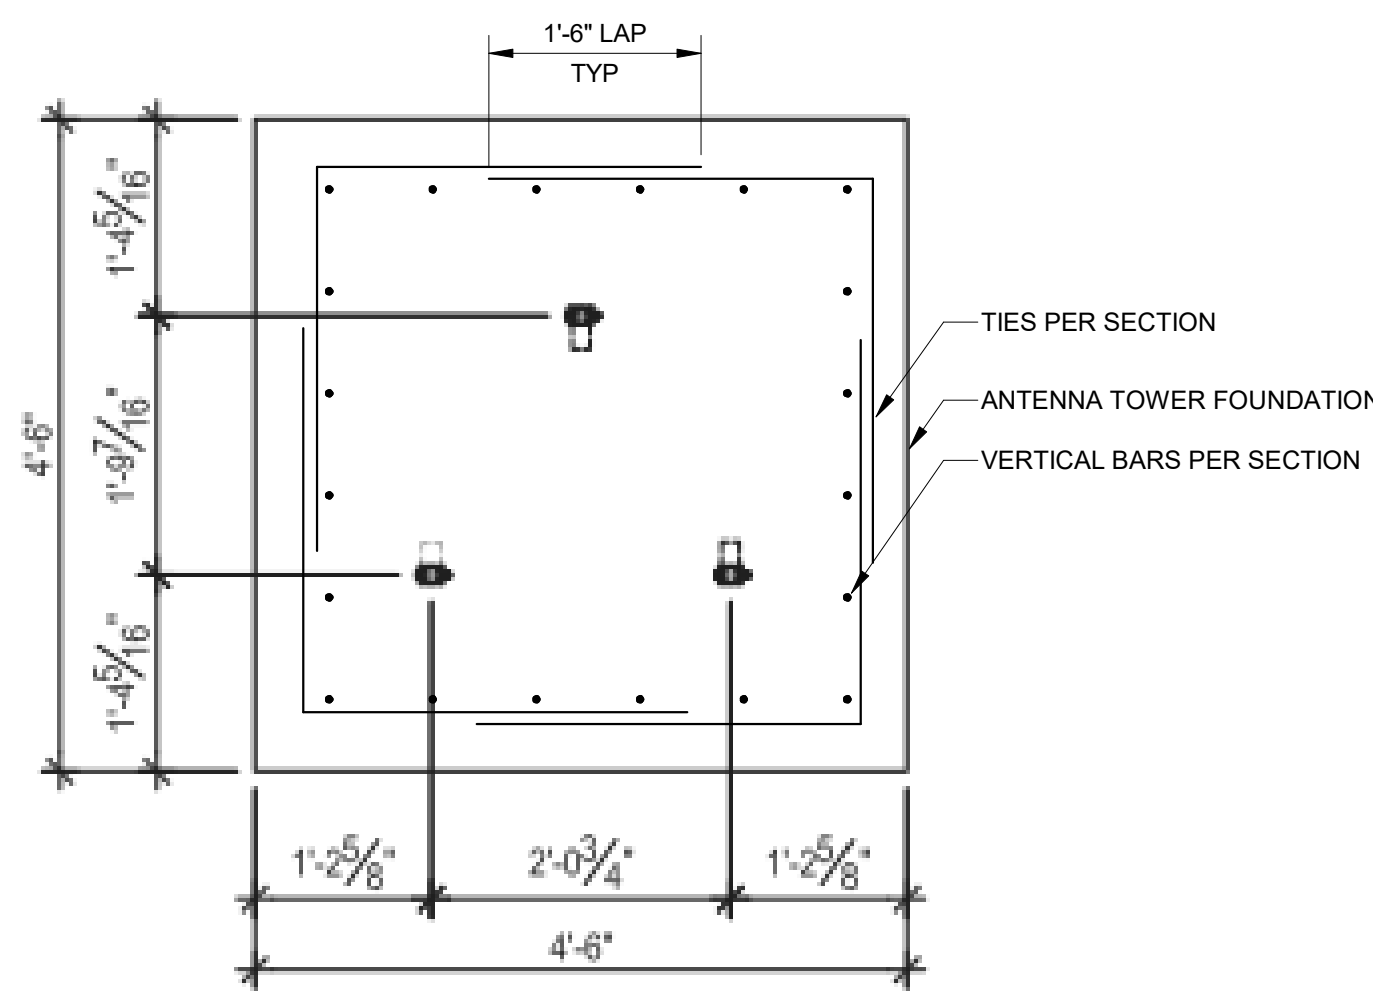

A PLAN

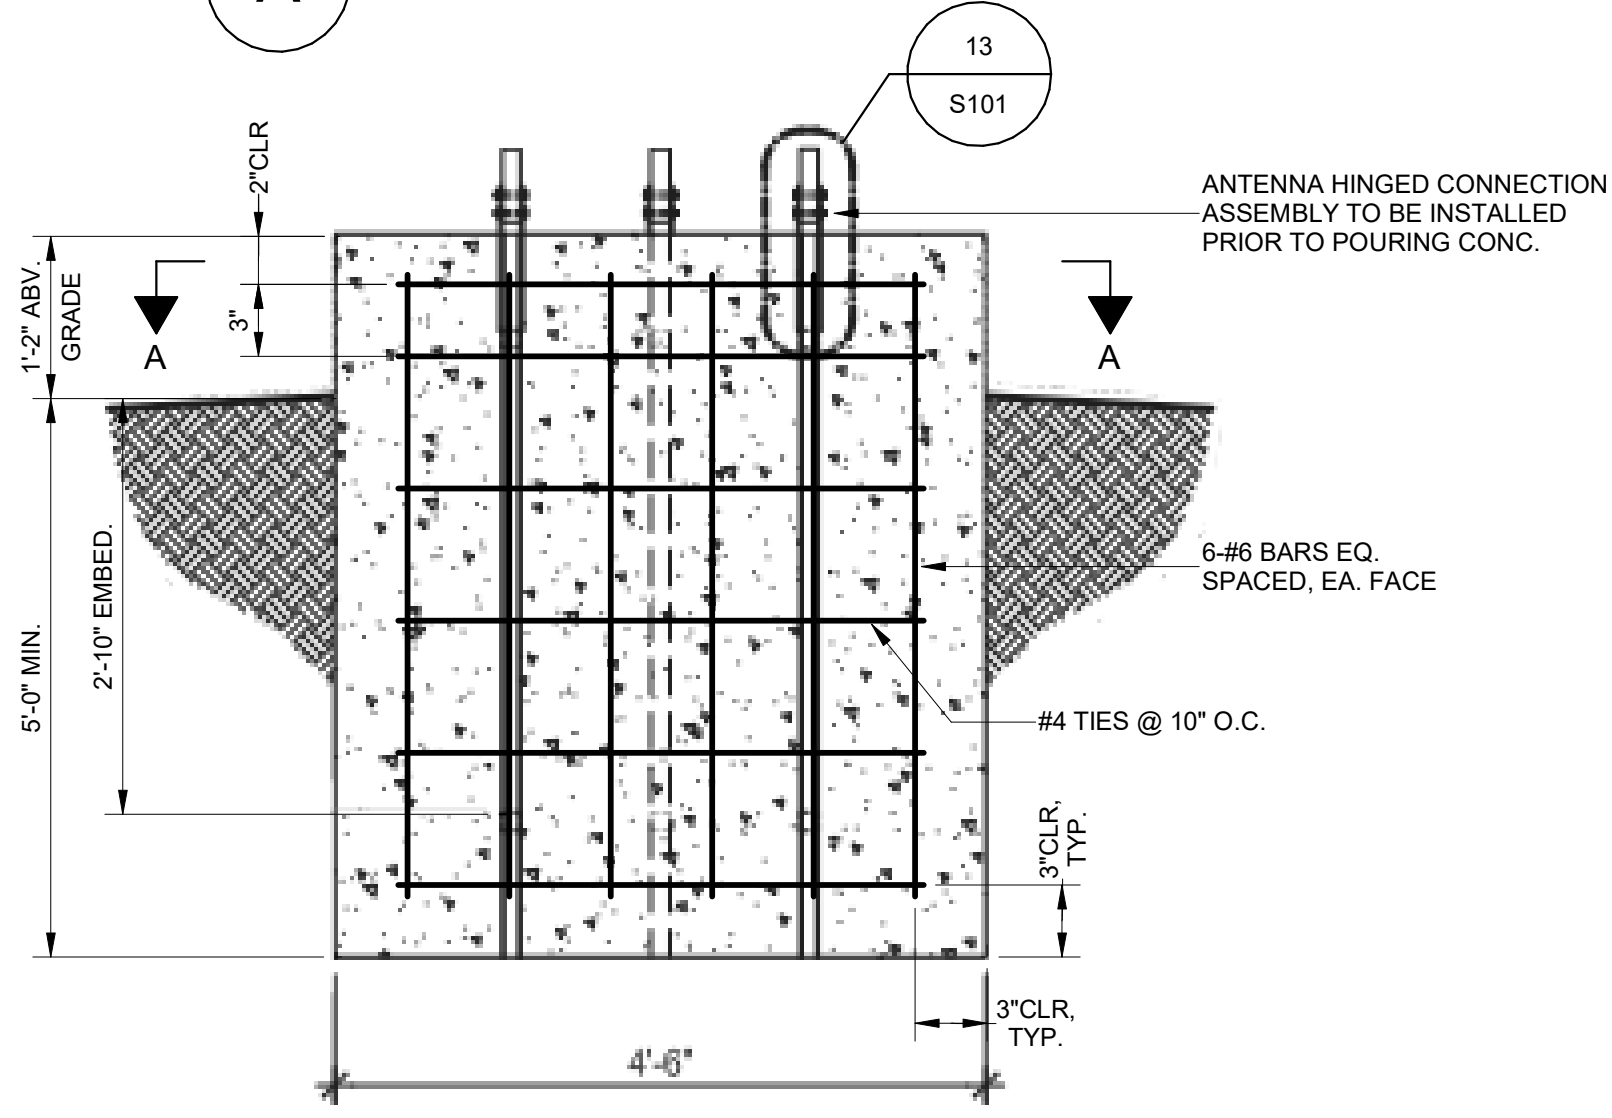


1 FOUNDATION DETAIL
SCALE: NTS

9/6/2022 3:30:57 PM I:\projects\2022\123456\Drawings\Structural\0220220101.dwg Check Comments\Beaumont.LS.Bates - 4/26/2022 1:28:41

CONSTRUCTION NOTES

- 1 CONSTRUCT 6' HIGH TYPE-6A RETAINING WALL PER CALTRANS STD B3-7A.
- 2 INSTALL 1" HOSE BIB WITH ANTISIPHON DEVICE ATTACHED. SEE DETAIL E, SHEET 12.
- 3 INSTALL 4" PVC STORM DRAIN WITH TRENCHING AND BACKFILL PER EMWD SB-157 AND SB-158.
- 5 INSTALL 12" X 12" GRATE PRE-CAST CONCRETE AREA DRAIN-TRAFFIC RATED BROOKS BOX. DEPTH PER PLAN.
- 7 INSTALL SITE LIGHT. SEE DETAIL 5 SHEET 18.
- 10 CONSTRUCT 9' X 4' CONCRETE WASH PAD. SEE DETAIL D, SHEET 13.
- 11 INSTALL 8' DIAMETER SEWER LIFT STATION. SEE SHEETS 33 AND 34 FOR STRUCTURAL DETAILS.
- 13 INSTALL 1" PVC WATER SERVICE WITH TRENCHING AND BACKFILL PER EMWD SB-157 AND SB-158. CONNECTION PER EMWD B-590A.
- 14 INSTALL ELEC PULL BOX. FOR ELECTRICAL PLANS, SEE SHEETS 14-21.
- 15 INSTALL COMBINATION EMERGENCY EYEWASH AND SHOWER STATION. SEE DETAIL A, SHEET 11.
- 16 INSTALL 16" DR-14 C900 PVC PIPE WITH TRENCHING AND BEDDING PER EMWD SB-157 AND SB-158.
- 17 INSTALL 4" AC OVER 6" CRUSHED AB.
- 18 CONSTRUCT 6' HIGH SPREAD FOOTINGS CMU WALL PER CALTRANS STD B15-1
- 19 INSTALL 4" SCH-80 PVC CLEANOUT PER EMWD STD SB-52
- 20 INSTALL 4" SCH-80 PVC WYE
- 22 INSTALL 20' WIDE, 6' TALL STEEL SWING GATE PER APWA STD DWG 600-4.
- 23 INSTALL 4" DIA ROUND GRATE DRAIN
- 24 INSTALL JUNCTION BOX
- 25 INSTALL WATER METER PER EMWD STD B-342
- 26 INSTALL BACKFLOW PREVENTION DEVICE PER EMWD STD B-597A
- 27 INSTALL CONDENSER UNIT
- 28 INSTALL 6' WIDE BY 7.33' HIGH STEEL DOUBLE SWING DOOR. SEE ARCHITECTURAL PLANS PER SHEETS 37 AND 38 FOR DOOR SCHEDULE.
- 29 INSTALL BOLLARD. SEE DETAIL C, SHEET 11.
- 30 INSTALL 5" DIA SEWER MANHOLE RING AND COVER PER EMWD SA-87 AND SB-53. SEE DETAIL D, SHEET 11.
- 31 INSTALL ELECTRICAL CONDUIT. SEE ELECTRICAL PLANS FOR LAYOUT AND SIZES
- 32 DEMOLISH AND REPLACE EXISTING FORCE MAIN. SEE SHEET 6.
- 33 INSTALL 4" ABS DRAIN PIPING FROM PUMP WASH DOWN PAD TO WET WELL WITH P-TRAP
- 34 INSTALL 11.5' X 11.5' CONCRETE WET WELL ROOF. SEE SHEET 33 FOR DETAILS.
- 35 72" X 48" DOUBLE HATCH OPENING WITH TWO PIECE ALUMINUM SAFETY GRATING BENEATH HATCH DOOR LEAF. RATED FOR 200 LB/SF LIVE LOAD.
- 38 INSTALL 1" PVC BALL VALVE
- 39 INSTALL 3/4" ROCK OVER FABRIC LINER-2" DEEP
- 40 INSTALL 4" SCH 40 PVC SLEEVE FOR FUTURE CHEMICAL FEED LINE PER DETAIL C, SHEET 13.
- 41 120V RECEPTACLE FOR FUTURE FURNISHED CHEMICAL FEED PUMP PROVIDED BY THE CITY OF BEAUMONT PER DETAIL C, SHEET 13.
- 42 INSTALL 4" ABS 45° BEND
- 43 INSTALL 40" X 80" SWING DOOR
- 44 BREAK OUT 8" DIAMETER HOLE FOR 6" PVC STORM DRAIN. GROUT ANNULAR SPACE TO SEAL.
- 45 CONSTRUCT 4.5" AC OVER 10" AB
- 46 INSTALL FENCE PER APWA STANDARD 600-3
- 47 CONSTRUCT DRAINAGE DITCH PER SEPARATE PERMIT. SEE ON-SITE GRADING PLANS.
- 48 12" SQUARE OPENING IN CONCRETE TOP WITH CAST IRON RING AND BROOKS CB1212 FRAME AND SOLID COVER FOR FLOAT SWITCH AND LEVEL TRANSDUCER
- 49 ANTENNA PER ELECTRICAL PLANS
- 50 INSTALL 6" DI VENT. SEE DETAIL D, SHEET 12.
- 51 INSTALL 6" PVC STORM DRAIN WITH TRENCHING AND BACKFILL PER EMWD SB-157 AND SB-158.
- 52 6" DI VENT PIPING. TRENCHING AND BACKFILL PER EMWD SB-157 AND SB-158.
- 53 TEMPORARY EXPANDABLE POLYURETHANE FOAM TO BE REMOVED AFTER FUTURE II LIFT STATION CONSTRUCTION
- 54 INSTALL 15" CALDER COUPLING. SEE DETAIL A, SHEET 13.
- 55 INSTALL CHEMICAL FEED PORT. SEE DETAIL C, SHEET 13.
- 56 PROPOSED 400KW/500 KVA, 480/277 V, 3PHASE, 4W, NEMA 3R DIESEL GENERATOR WITH 693 GALLON BELLY TANK AND LEVEL 2 ACOUSTIC ENCLOSURE.

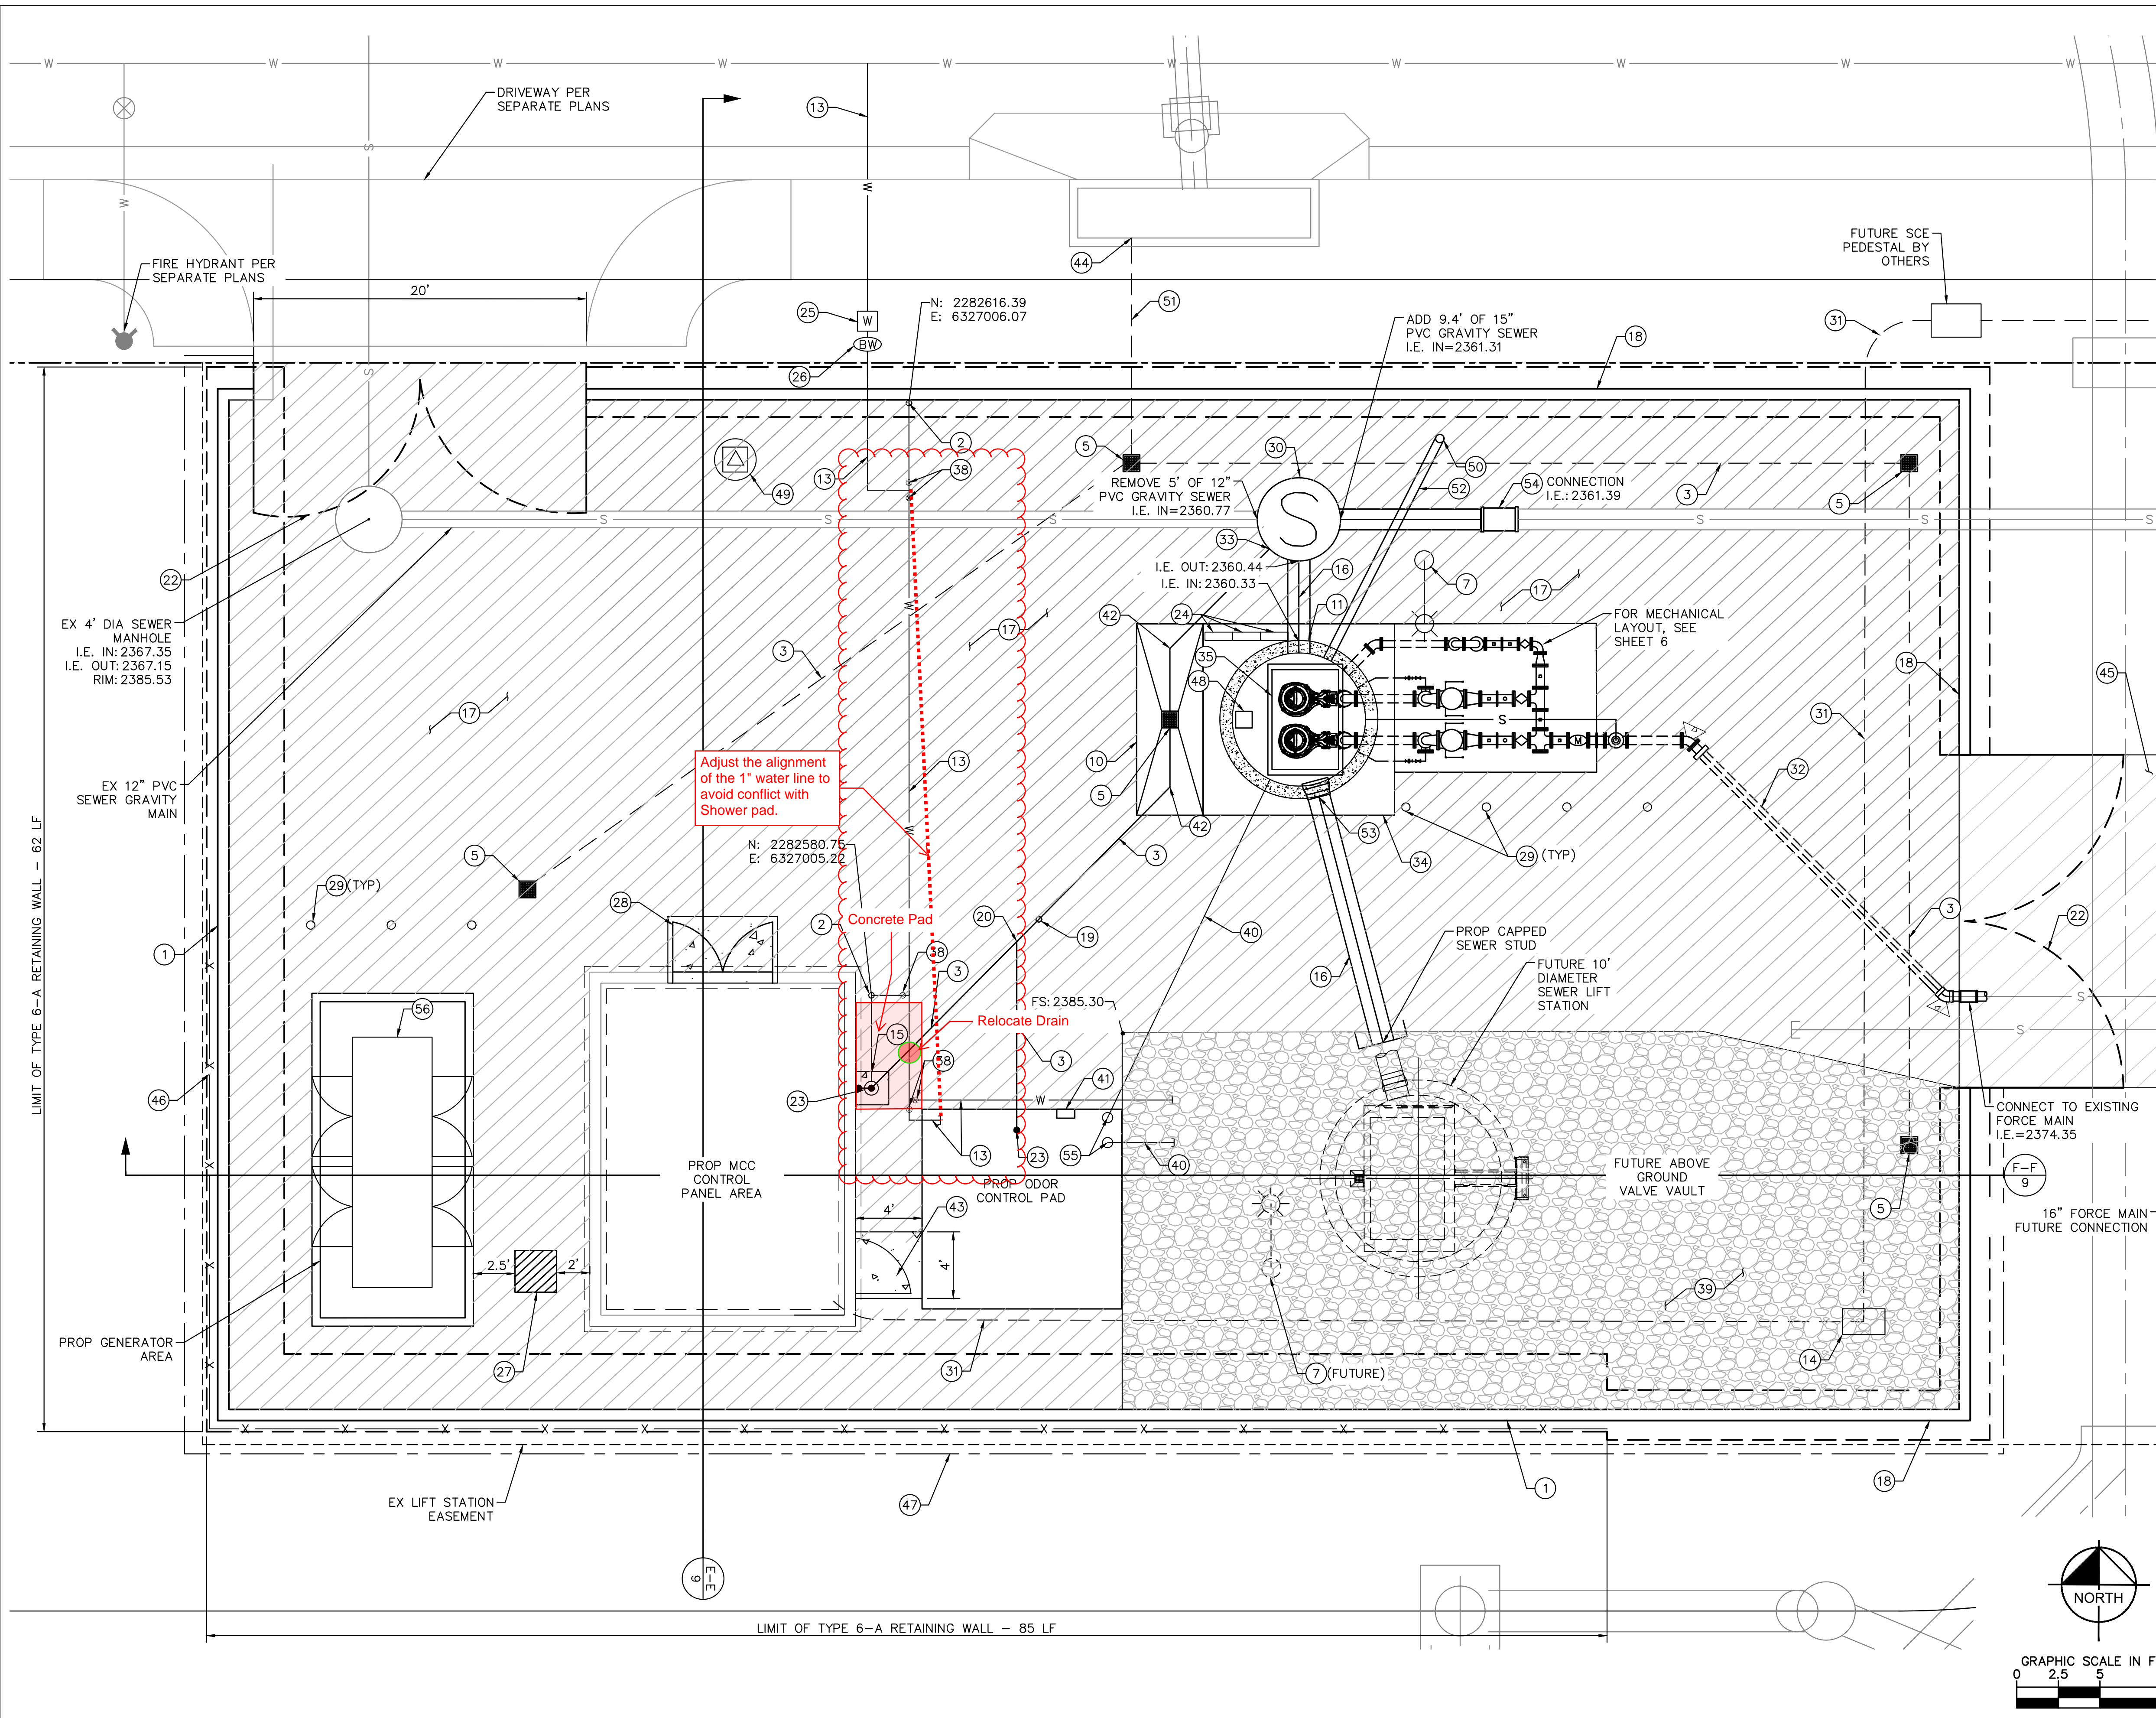

DIGALERT
Call 2 Working Days Before You Dig!
811

BENCHMARK:
NATIONAL GEODETIC SURVEY BENCHMARK NO. 1311
1.4 MILES WEST OF BEAUMONT ON INTERSTATE 10 TO SAN TIMOTEO CANYON NEAR FRONTAGE ROAD ON SOUTH(WEST) SIDE OF INTERSTATE 10, 0.1 MILES SOUTHWEST ALONG FRONTAGE ROAD, SOUTH ACROSS THE ROAD FROM A GUY POLE 25.9 FEET SOUTH OF THE CENTERLINE OF FRONTAGE ROAD, 1.8 FEET WEST OF POWERPOLE AND 1.5 FEET EAST OF A WITNESS POST, INSIDE A 4 INCH PVC PIPE WITH SCREW PLUG 1 INCH ABOVE GROUND (ELEVATION = 2468.07). ALSO SHOWN ON HIGHWAY 69 // POTRERO BLVD. INTERCHANGE STATIC GPS PROJECT CONTROL DIAGRAM AND IDENTIFIED THEREON AS 3508 BM D33474 WHEN THE PUBLISHED ELEVATION = 2468.07 IS CORRECTED WITH A MEASURED ELEVATION = 2468.01, USED HEREON.
ELEV. 2468.01, (NVD '88), (STAMPED Q 1311 1978)

BY	MARK	DESCRIPTION	APPR.	DATE
ENGINEER		REVISIONS	CITY	

Kimley»Horn
401 B Street, Suite 600, San Diego, CA 92101
Phone: (619) 234-9411
WWW.KIMLEY-HORN.COM

Sam L. McWhorter
S.A.M. L. MCWHORTER
R.C.E. 61788
8/23/2021

SEAL
REGISTERED PROFESSIONAL ENGINEER
S.A.M. L. MCWHORTER
No. 61788
CIVIL
STATE OF CALIFORNIA

DESIGN BY: SLM
DRAWN BY: RC/SW
CHECKED BY: TW/SS
SCALE:
DATE:
JOB NUMBER: 195284001

CITY OF BEAUMONT
CALIFORNIA
NOV. 18, 1972

Reviewed By: _____ Date: _____
Staff Engineer

Recommended for Approval By: _____ Date: 11/19/2021
Administrative Engineer

Approved By: _____ Date: 11/23/2021
City Engineer/Director of Public Works



CITY OF BEAUMONT, PUBLIC WORKS DEPARTMENT
ENGINEERING DIVISION
5500 6th St
Beaumont, CA 92223
TEL: (951) 789-8520 FAX: (951) 789-8528

CITY OF BEAUMONT, CALIFORNIA
IMPROVEMENT PLANS FOR:
**BEAUMONT CROSSROADS
LIFT STATION**
LIFT STATION SITE PLAN

SHEET
4
OF 38 SHEETS
FILE NO:
3387

Plotted By: V. W. H. / Sam Sheet Set: BEAUMONT LIFT STATION Layout_Layout_2021_10:54:30am K:\SND_WATER\195284001\Beaumont Lift Station\Design\Plan Sheets - 2020\DELTA SET\1195284001 - xSP.dwg

Plotted By: \mwhorn, Sam, Sheet Set: BEAUMONT LIFT STATION, Grading Plan, October 20, 2021, 10:53:31 am, K:\ISND_WATER\195284001 Beaumont Lift Station\Design\Plan Sheets - 2020, DELTA SET\195284001 - xGR.dwg

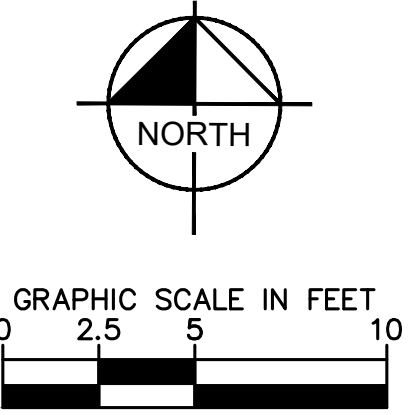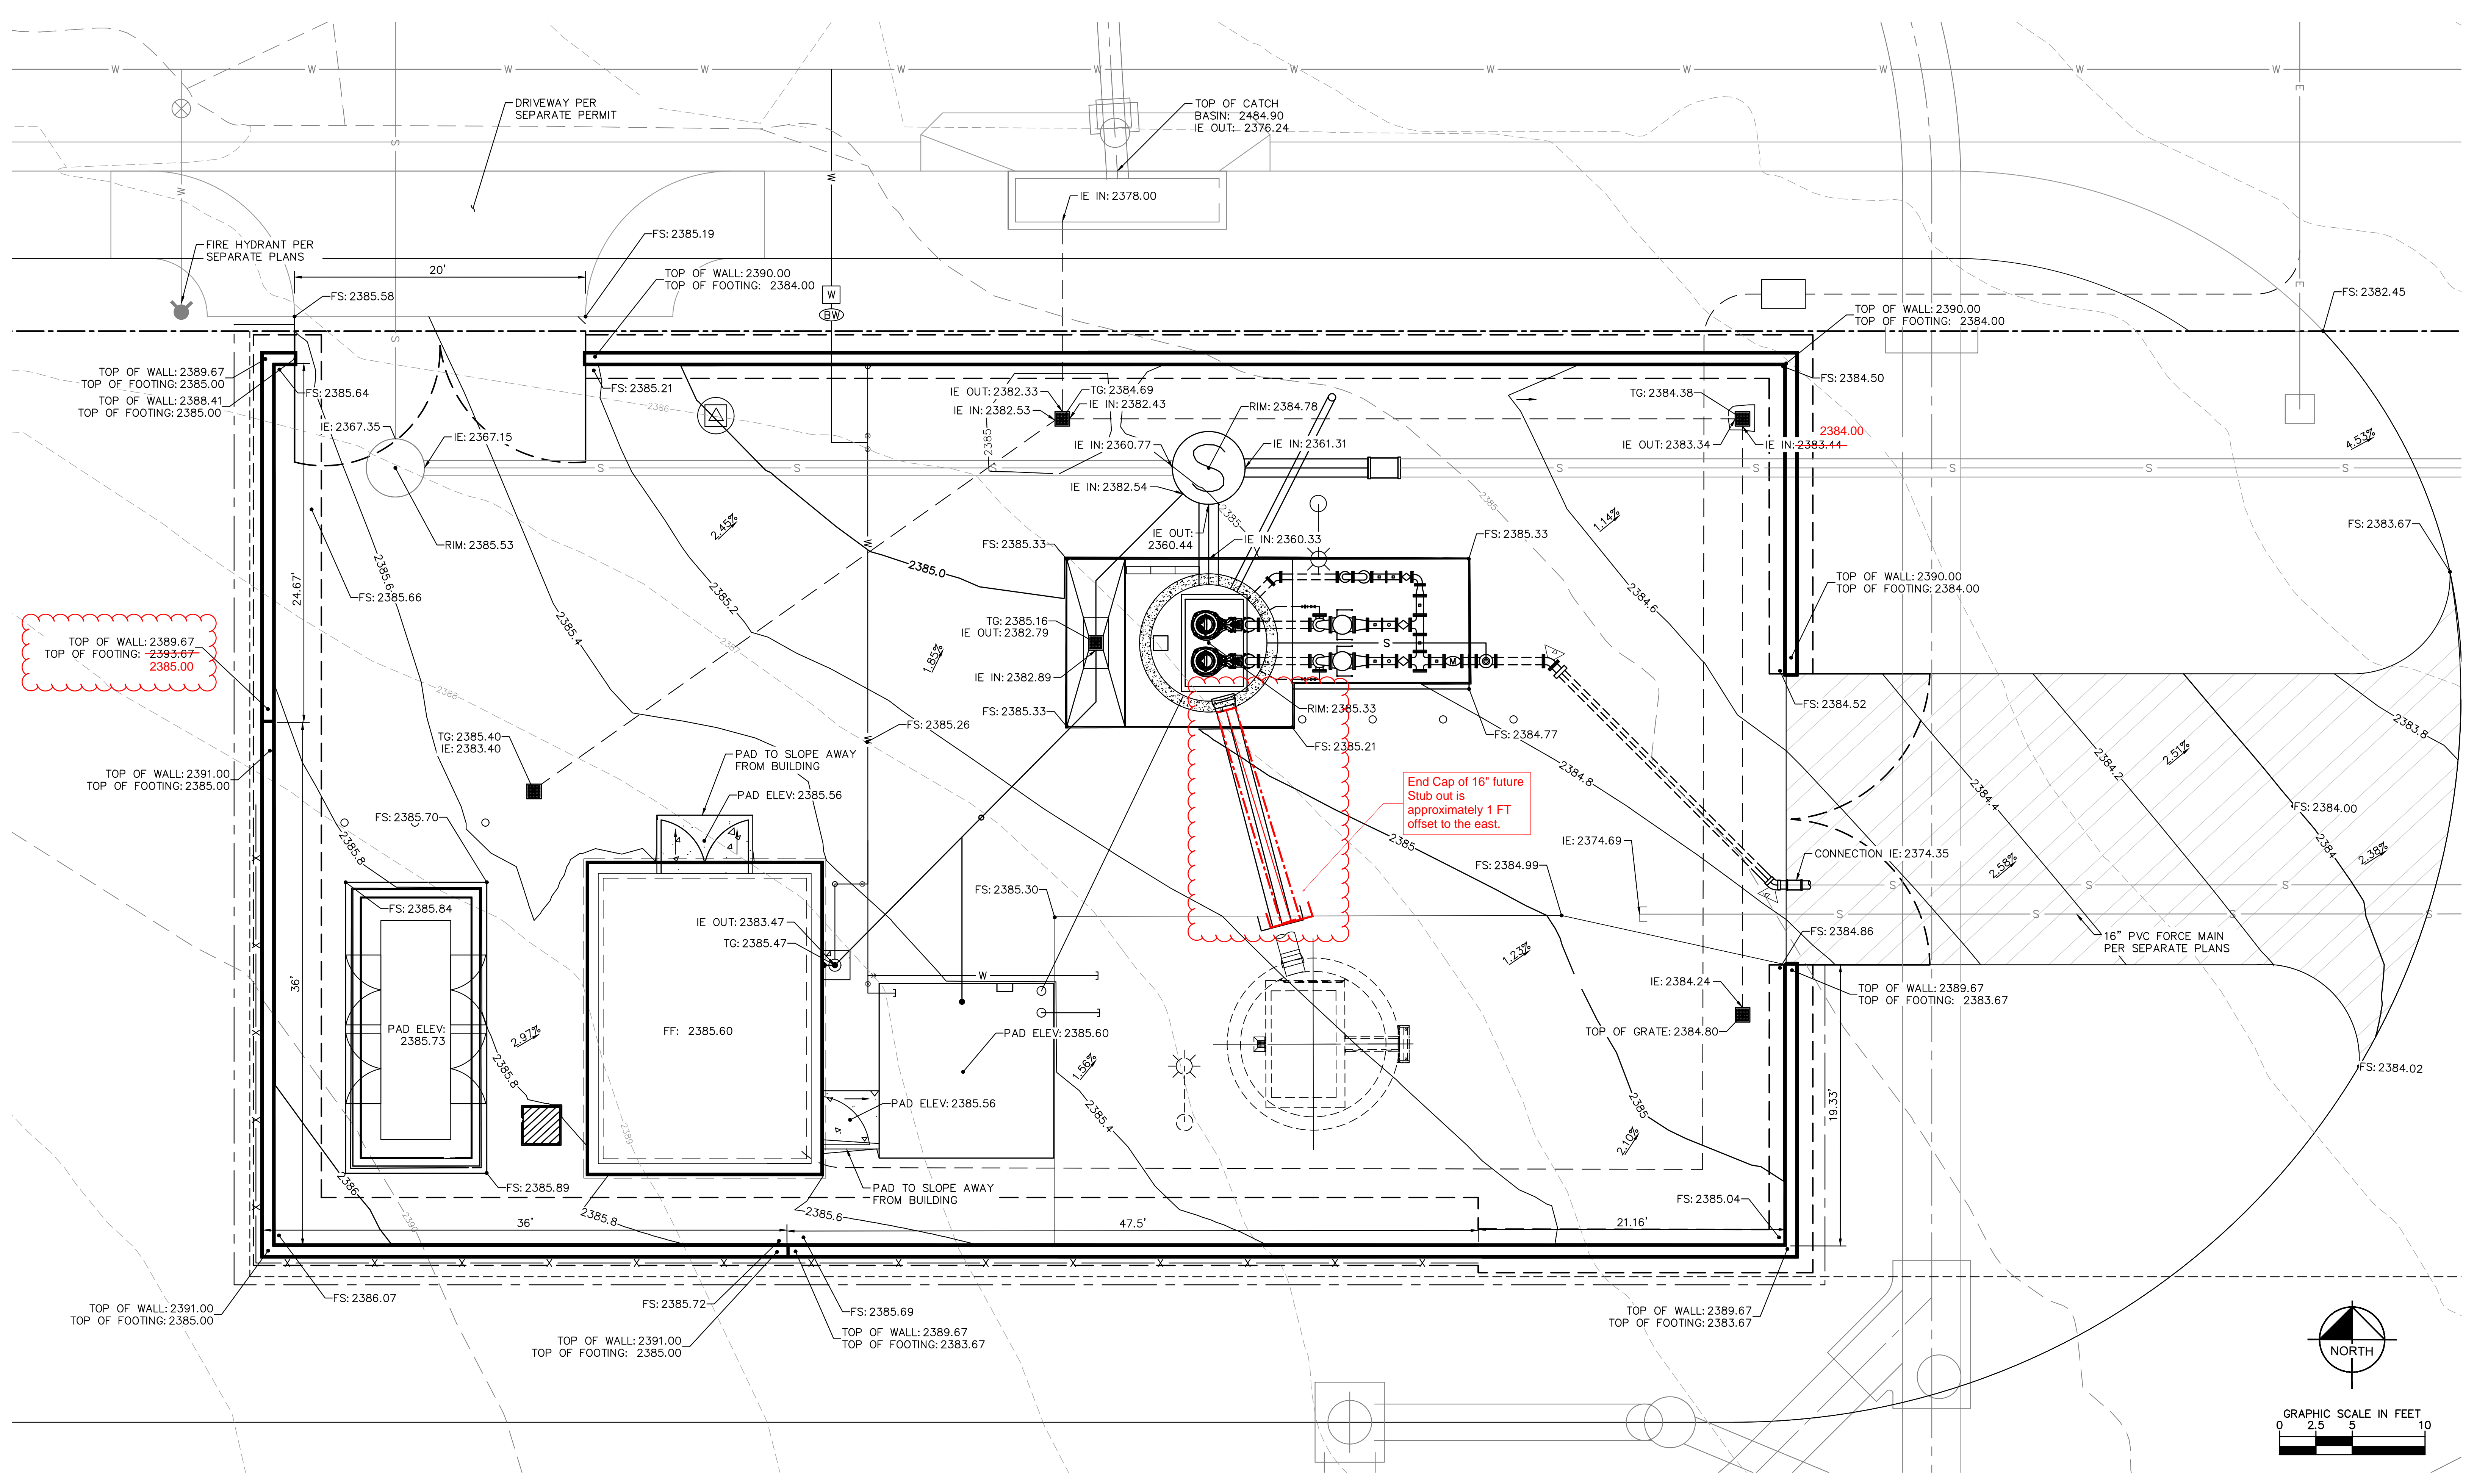

DIGALERT
 Call 2 Working Days Before You Dig!
 811


BENCHMARK:
 NATIONAL GEODETIC SURVEY BENCHMARK NO. 1311
 1.4 MILES WEST OF BEAUMONT ON INTERSTATE 10 TO SAN TIMOTEO CANYON NEAR FRONTAGE ROAD ON SOUTH(WEST) SIDE OF INTERSTATE 10, 0.1 MILES SOUTHWEST ALONG FRONTAGE ROAD, SOUTH ACROSS THE ROAD FROM A GUY POLE 25.9 FEET SOUTH OF THE CENTERLINE OF FRONTAGE ROAD, 1.8 FEET WEST OF POWERPOLE AND 1.8 FEET EAST OF A WITNESS POST, INSIDE A 4 INCH PVC PIPE WITH SCREW PLUG 1 INCH ABOVE GROUND (ELEVATION = 2468.07). ALSO SHOWN ON HIGHWAY 69 / POTRERO BLVD. INTERCHANGE STATIC GPS PROJECT CONTROL DIAGRAM AND IDENTIFIED THEREON AS 3558 BM D33474 WHEREIN THE PUBLISHED ELEVATION = 2468.07 IS CORRECTED WITH A MEASURED ELEVATION = 2468.01, USED HEREON.
 ELEV. 2468.01, (NVD '88), (STAMPED Q 1311 1978)

BY	MARK	DESCRIPTION	APPR.	DATE
ENGINEER		REVISIONS		CITY

Kimley»Horn
 401 B Street, Suite 600, San Diego, CA 92101
 Phone: (619) 234-9411
 WWW.KIMLEY-HORN.COM

Sam McWhorter
 SAM L. MCWHORTER
 R.C.E. 61788

8/23/2021

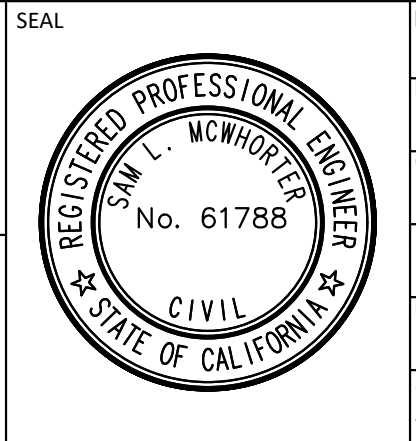

DESIGN BY: SLM
 DRAWN BY: RC/SW
 CHECKED BY: TW/SS
 SCALE:

DATE:

JOB NUMBER: 195284001

Reviewed By: _____ Date: _____
 Staff Engineer

Recommended for Approval By: *[Signature]* Date: 11/19/2021
 Administrative Engineer

Approved By: *[Signature]* Date: 11/23/2021
 City Engineer/Director of Public Works

CITY OF BEAUMONT, PUBLIC WORKS DEPARTMENT
 ENGINEERING DIVISION


550E 6th St
 Beaumont, CA 92223
 TEL: (951) 769-8520 FAX: (951) 769-8526

CITY OF BEAUMONT, CALIFORNIA
 IMPROVEMENT PLANS FOR:
**BEAUMONT CROSSROADS
 LIFT STATION**

GRADING PLAN

SHEET
5
 OF 38 SHEETS
 FILE NO:
 3387


Plotted By: \mwhorn, Sam, Sheet Set: BEAUMONT LIFT STATION MECHANICAL PLAN, October 20, 2021, 10:53:57am, K:\SND_WATER\195284001\Beaumont Lift Station\Design\Plan Sheets - 2020\DELTA SET\195284001 - xMC.dwg

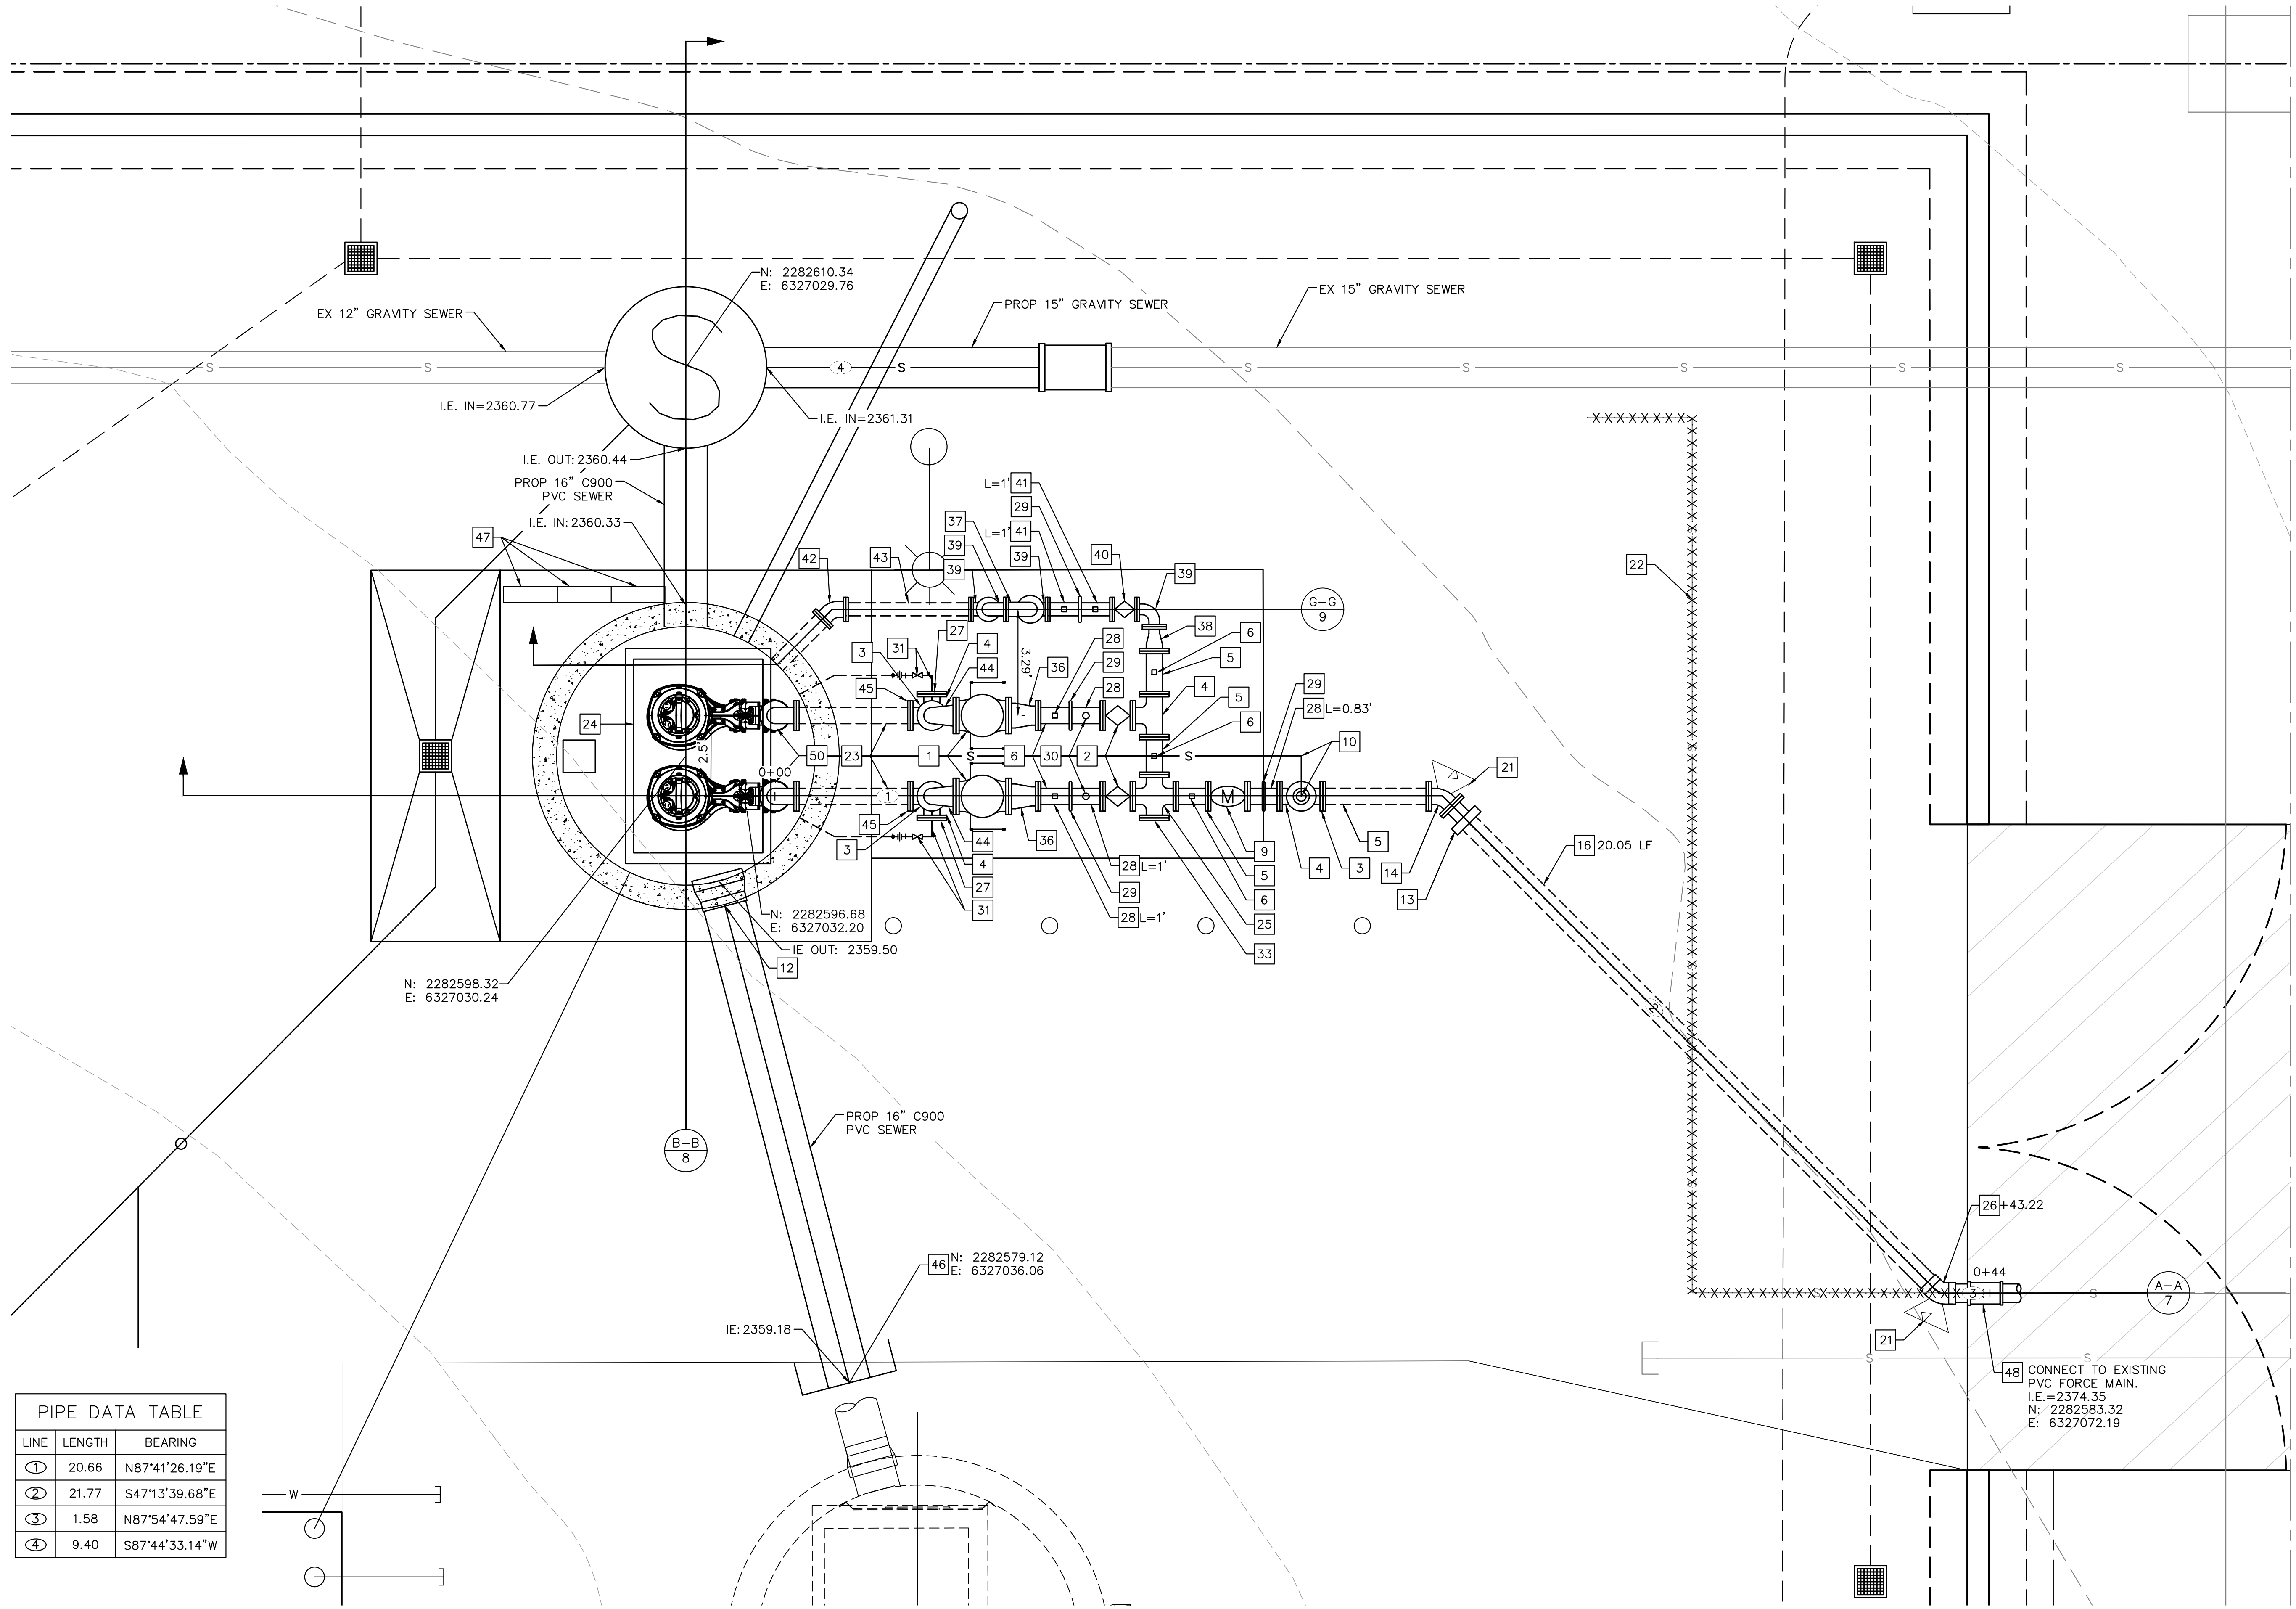

MECHANICAL NOTES

- 1 8" APCO SWING CHECK VALVE & OIL CONTROLLED BOTTOM MOUNTED BUFFER OR EQUAL
- 2 6" PLUG VALVE FLANGED WITH HAND WHEEL ACTUATOR. PRATT OR APPROVED EQUAL.
- 3 6" DI 90° BEND
- 4 6" DI TEE, FLANGED
- 5 6" DI SPOOL, FLANGED
- 6 PIPE SUPPORT WITH STRAP PER DETAIL A, SHEET 10.
- 9 6" ELECTROMAGNETIC FLOW METER, FLANGED. FURNISH SPARE 6" FLANGED SPOOL (LENGTH TO MATCH LENGTH OF FLOW METER) TO BE INSTALLED WHEN METER IS REMOVED FOR SERVICE. CONTRACTOR TO SET PIPE SPOOL IN PLACE TO VERIFY FIT, THEN REPLACE WITH FLOW METER.
- 10 INSTALL 2" COMBINATION SEWAGE AIR AND VACUUM VALVE WITH 2" ISOLATION GATE VALVE AND 2" AIR DISCHARGE PIPING TO WET WELL.
- 12 TEMPORARY EXPANDABLE POLYURETHANE FOAM TO BE REMOVED AFTER FUTURE II LIFT STATION CONSTRUCTION
- 13 6" DI TO PVC TRANSITION COUPLING. SEE DETAIL C, SHEET 10.
- 14 6" DI 45° BEND
- 16 6" C900, CLASS 235, DR 18 PVC
- 21 THRUST BLOCK PER EMWD STANDARD DWG B-407
- 22 REMOVE EXISTING 6" PVC FORCE MAIN
- 23 6" SCH 40, 316 STAINLESS STEEL SPOOL, FLANGED
- 24 72" X 48" STAINLESS STEEL DOUBLE LEAF HATCH WITH FALL PROTECTION GRATE
- 25 6" DI CROSS, FLANGED
- 26 6" PVC 45° BEND
- 27 6" BLIND FLANGE. TAPPED FOR 1" FLUSHING LINE.
- 28 6" DI SPOOL, FLANGE X GROOVED END
- 29 VICTAULIC COUPLING
- 30 PRESSURE GAUGE
- 31 1" STAINLESS STEEL BALL VALVE, UNION, AND FITTINGS FOR RAW SEWAGE BACKFLUSH (RSB) TO WET WELL FOR MANUAL BREAK DOWN OF SCUM BLANKET. PIPING SHALL BE 1" SCH 40, 316 STAINLESS STEEL.
- 33 LIFT STATION TEMPORARY BYPASS CONNECTION. DI CROSS WITH BLIND FLANGE.
- 36 8" x 6" DI REDUCER
- 37 INSTALL 4" APCO SURGE RELIEF ANGLE VALVE PRESSURE RANGE 100-200 PSI. SET TO 120 PSI.
- 38 6" x 4" DI REDUCER
- 39 4" DI 90° BEND
- 40 4" PLUG VALVE FLANGED WITH HAND WHEEL ACTUATOR. PRATT OR APPROVED EQUAL.
- 41 4" DI SPOOL, FLANGE X GROOVED END
- 42 4" DI 45° BEND
- 43 4" DI SPOOL, FLANGED
- 44 8" x 6" DI REDUCING 90° BEND
- 45 DI TO SS INSULATING FLANGE KIT PER DETAIL E, SHEET 11.
- 46 GROOVE END PLUG
- 47 JUNCTION BOXES. SEE ELECTRICAL PLANS.
- 48 6" PVC COUPLING. SEE DETAIL B, SHEET 13.
- 50 6" SCHEDULE 40, 316 STAINLESS STEEL 90° BEND

PIPE DATA TABLE		
LINE	LENGTH	BEARING
①	20.66	N87°41'26.19"E
②	21.77	S47°13'39.68"E
③	1.58	N87°54'47.59"E
④	9.40	S87°44'33.14"W

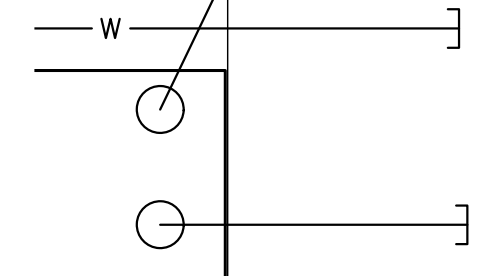


BENCHMARK:
 NATIONAL GEODETIC SURVEY BENCHMARK NO. 1311
 1.4 MILES WEST OF BEAUMONT ON INTERSTATE 10 TO SAN TIMOTEO CANYON NEAR FRONTAGE ROAD ON SOUTH(WEST) SIDE OF INTERSTATE 10, 0.1 MILES SOUTHWEST ALONG FRONTAGE ROAD, SOUTH ACROSS THE ROAD FROM A GUY POLE 25.9 FEET SOUTH OF THE CENTERLINE OF FRONTAGE ROAD, 1.8 FEET WEST OF POWERPOLE AND 1.5 FEET EAST OF A WITNESS POST, INSIDE A 4 INCH PVC PIPE WITH SCREW PLUG 1 INCH ABOVE GROUND (ELEVATION = 2468.07). ALSO SHOWN ON HIGHWAY 60 / POTRERO BLVD. INTERCHANGE STATIC GPS PROJECT CONTROL DIAGRAM AND IDENTIFIED THEREON AS 3558 BM D3374 WHEREIN THE PUBLISHED ELEVATION = 2468.07 IS CORRECTED WITH A MEASURED ELEVATION = 2468.01, USED HEREON.
 ELEV. 2468.01, (NVD '88), (STAMPED Q 1311 1978)

BY	MARK	DESCRIPTION	APPR.	DATE
ENGINEER		REVISIONS		CITY

Kimley»Horn
 401 B Street, Suite 600, San Diego, CA 92101
 Phone: (619) 234-9411
 WWW.KIMLEY-HORN.COM


 Sam L. McWhorter
 R.C.E. 61788
 8/23/2021

DESIGN BY: SLM
 DRAWN BY: RC/SW
 CHECKED BY: TW/SS
 SCALE: _____
 DATE: _____
 JOB NUMBER: 195284001

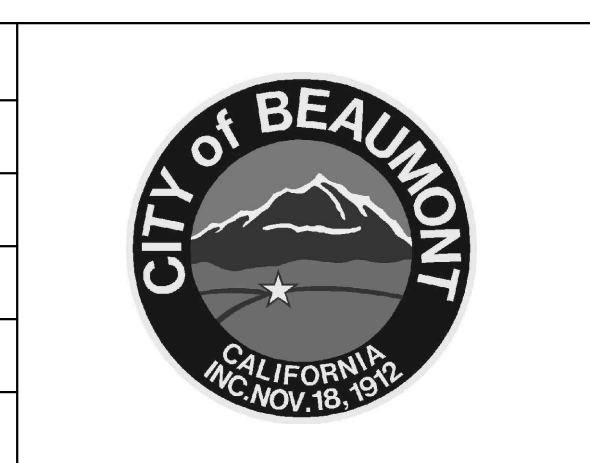

Reviewed By: _____ Date: _____
 Staff Engineer
 Recommended for Approval By: _____ Date: 11/19/2021
 Administrative Engineer
 Approved By: _____ Date: 11/23/2021
 City Engineer/Director of Public Works
 CITY OF BEAUMONT, PUBLIC WORKS DEPARTMENT
 ENGINEERING DIVISION
 550E 6th St
 Beaumont, CA 92223
 TEL: (951) 769-8520 FAX: (951) 769-8526

CITY OF BEAUMONT, CALIFORNIA
 IMPROVEMENT PLANS FOR:
BEAUMONT CROSSROADS LIFT STATION
 MECHANICAL PLAN
 SHEET
6
 OF 38 SHEETS
 FILE NO: 3387

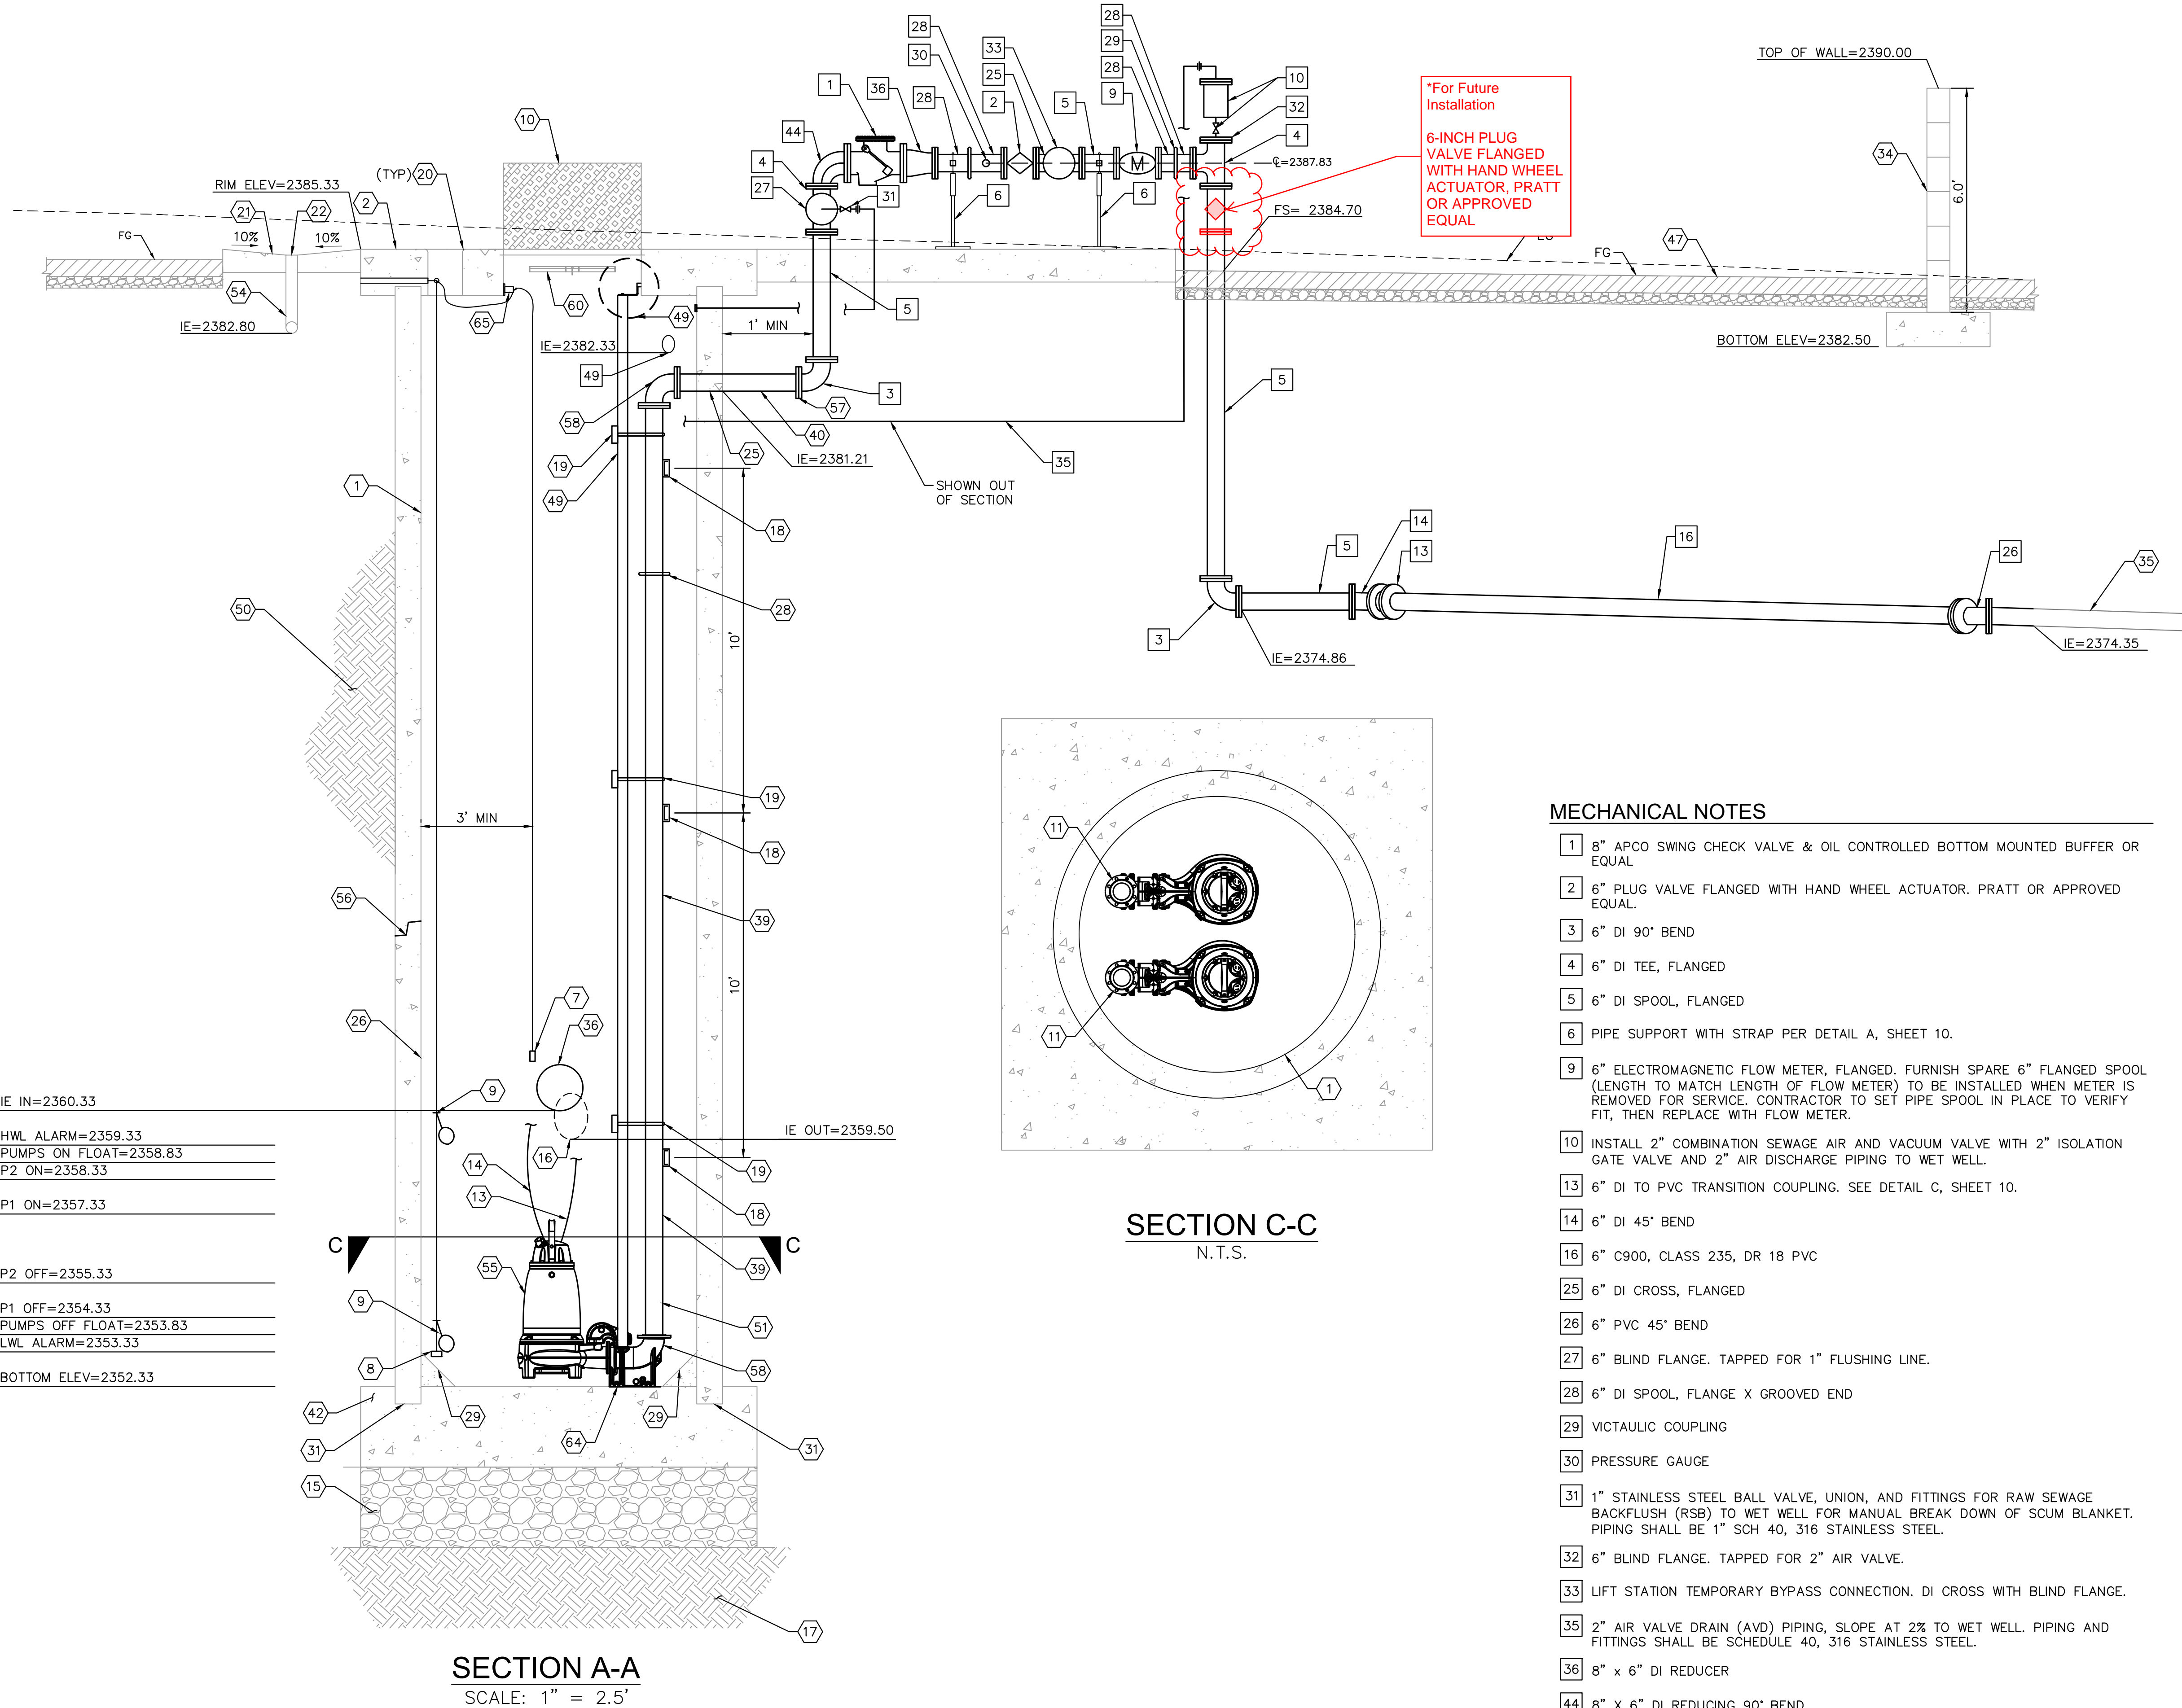

IE IN=2360.33
HWL ALARM=2359.33
PUMPS ON FLOAT=2358.83
P2 ON=2358.33
P1 ON=2357.33
P2 OFF=2355.33
P1 OFF=2354.33
PUMPS OFF FLOAT=2353.83
LWL ALARM=2353.33
BOTTOM ELEV=2352.33

3' OPERATING RANGE

SECTION A-A
SCALE: 1" = 2.5'

SECTION C-C
N.T.S.

MECHANICAL NOTES



- 1 8" APCO SWING CHECK VALVE & OIL CONTROLLED BOTTOM MOUNTED BUFFER OR EQUAL
- 2 6" PLUG VALVE FLANGED WITH HAND WHEEL ACTUATOR. PRATT OR APPROVED EQUAL.
- 3 6" DI 90° BEND
- 4 6" DI TEE, FLANGED
- 5 6" DI SPOOL, FLANGED
- 6 PIPE SUPPORT WITH STRAP PER DETAIL A, SHEET 10.
- 9 6" ELECTROMAGNETIC FLOW METER, FLANGED. FURNISH SPARE 6" FLANGED SPOOL (LENGTH TO MATCH LENGTH OF FLOW METER) TO BE INSTALLED WHEN METER IS REMOVED FOR SERVICE. CONTRACTOR TO SET PIPE SPOOL IN PLACE TO VERIFY FIT, THEN REPLACE WITH FLOW METER.
- 10 INSTALL 2" COMBINATION SEWAGE AIR AND VACUUM VALVE WITH 2" ISOLATION GATE VALVE AND 2" AIR DISCHARGE PIPING TO WET WELL.
- 13 6" DI TO PVC TRANSITION COUPLING. SEE DETAIL C, SHEET 10.
- 14 6" DI 45° BEND
- 16 6" C900, CLASS 235, DR 18 PVC
- 25 6" DI CROSS, FLANGED
- 26 6" PVC 45° BEND
- 27 6" BLIND FLANGE. TAPPED FOR 1" FLUSHING LINE.
- 28 6" DI SPOOL, FLANGE X GROOVED END
- 29 VICTAULIC COUPLING
- 30 PRESSURE GAUGE
- 31 1" STAINLESS STEEL BALL VALVE, UNION, AND FITTINGS FOR RAW SEWAGE BACKFLUSH (RSB) TO WET WELL FOR MANUAL BREAK DOWN OF SCUM BLANKET. PIPING SHALL BE 1" SCH 40, 316 STAINLESS STEEL.
- 32 6" BLIND FLANGE. TAPPED FOR 2" AIR VALVE.
- 33 LIFT STATION TEMPORARY BYPASS CONNECTION. DI CROSS WITH BLIND FLANGE.
- 35 2" AIR VALVE DRAIN (AVD) PIPING, SLOPE AT 2% TO WET WELL. PIPING AND FITTINGS SHALL BE SCHEDULE 40, 316 STAINLESS STEEL.
- 36 8" x 6" DI REDUCER
- 44 8" x 6" DI REDUCING 90° BEND
- 49 6" DI VENT PIPING

SEWER LIFT STATION NOTES

- 1 8' DIAMETER CLASS IV RCP PER ASTM C78 W/ TWO CIRCULAR REINFORCEMENT CAGES AND FLUSH BELL AND SPIGOT JOINTS. BELL AND SPIGOT JOINTS SHALL BE PROVIDED W/ RUBBER GASKETS AND SHALL BE SUITABLE FOR A HYDROSTATIC HEAD OF 50' PER ASTM C361. INTERIOR CONCRETE SURFACES INCLUDING WALL AND ROOF SHALL BE COATED PER SPECIFICATIONS.
- 2 11.5' X 11.5' CONCRETE WET WELL TOP SLAB
- 7 MILLITRONICS ECHOMAX XRS-5 ULTRASONIC LEVEL TRANSDUCER. SET ELEVATION TWO FEET ABOVE GRAVITY SEWER INVERT. INSTALL W/ RIGID CONDUIT AND SUBMERGENCE SHIELD.
- 8 SS WEIGHT ATTACHED TO SS CABLE ATTACHED TO 12" EMBEDDED HOOK. ATTACH FLOATS AND WEIGHT TO SS CABLE WITH NYLON TIES PER MANUFACTURERS RECOMMENDATIONS.
- 9 MERCURY FLOAT SWITCH
- 10 72" X 48" STAINLESS STEEL DOUBLE LEAF HATCH WITH FALL PROTECTION GRATE
- 11 DISCHARGE CONNECTION, 6" SCH 40, 316 STAINLESS STEEL
- 13 SYNTHETIC RUBBER POWER AND CONTROL CABLE TO PUMP. HANG ON SUPPORT WITH STAINLESS STEEL KELLUM GRIPS AND LOOP CABLE OVER SUPPORT
- 14 LIFTING CABLE - TO FOLLOW THE SPECIFICATIONS FROM FLYGT LIFTING CABLE PART NUMBER 14-58 75 15. MIN LENGTH 50'.
- 15 MIN 2' CRUSHED AGGREGATE BASE
- 16 16" C900 DR-25 PVC-EFFLUENT FOR FUTURE PHASE 2 WET WELL
- 17 COMPACTED SUBGRADE @ 95% R.C. PER GEOTECHNICAL RECOMMENDATIONS
- 18 STAINLESS STEEL SUPPORT FOR FORCE MAIN. SEE DETAIL B, SHEET 11. 10' SPACING BETWEEN SUPPORTS.
- 19 6" INTERMEDIATE GUIDE RAIL SUPPORT BRACKET PER FLYGT. 10' SPACING BETWEEN BRACKETS.
- 20 12" SQUARE OPENING IN CONCRETE TOP WITH CAST IRON RING AND BROOKS CB1212 FRAME AND SOLID COVER FOR FLOAT SWITCH AND LEVEL TRANSDUCER. SEE DETAIL E, SHEET 10.
- 21 PUMP WASH DOWN PAD. SEE DETAIL D, SHEET 13.
- 22 4" DROP INLET WITH GRATE
- 25 PIPE PENETRATION. SEE DETAIL B, SHEET 10.
- 26 FIELD APPLY 125 ML OF SANCON 100 ON CONCRETE INTERIOR SURFACE
- 28 6" VICTAULIC COUPLING
- 29 GROUT FILLET - SLOPE VARIES. 1.5" MAX HEIGHT. 1" MIN HEIGHT.
- 31 SLAB TO RCP. SEE DETAIL D, SHEET 10.
- 34 SPLIT FACE WALL PER CALTRANS STANDARD DRAWING B15-1, CASE 1
- 35 EXISTING 6" C900 PVC SEWER FM
- 36 16" C900 DR-25 PVC-INFLUENT
- 39 6" SCHEDULE 40, 316 STAINLESS STEEL FLANGED END SPOOL, LENGTH AS REQUIRED
- 40 6" SCHEDULE 40, 316 STAINLESS STEEL FLANGED END SPOOL, LENGTH AS REQUIRED. SHIP ONE FLANGE LOOSE FOR FIELD WELDING AFTER INSTALLATION IN WET WELL.
- 42 FOR SLAB DIMENSIONS, SEE SHEETS 33 AND 34
- 47 4" AC OVER 6" CRUSHED AB
- 49 MODIFIED GUIDE RAILS. SEE DETAIL A, SHEET 12.
- 50 COMPACT BACKFILL TO 90% RELATIVE COMPACTION (MIN.).
- 51 6" X 4" SCHEDULE 40, 316 STAINLESS STEEL REDUCER
- 54 4" PVC WYE
- 55 2 FLYGT NON-CLOG SUBMERSIBLE PUMPS Q=300 GPM AT 280' EACH PUMP, NP 3301 HT 3-460
- 56 BELL-AND-SPIGOT JOINT (TYP.) PROVIDE MIN. 1' CLEARANCE BETWEEN WET WELL JOINTS AND PIPE PENETRATIONS.
- 57 INSTALL DI TO SS INSULATING FLANGE KIT PER DETAIL E, SHEET 11.
- 58 6" SCHEDULE 40, 316 STAINLESS STEEL 90° BEND
- 60 TWO PIECE ALUMINUM SAFETY GRATING BENEATH HATCH DOOR LEAFS. RATED FOR 200 LB/SF LIVE LOAD.
- 64 PUMP STAND PER PUMP VENDOR
- 65 4" X 4" X 1/2" SS PLATE WITH 2" X 3" SS CHANNEL, WELDED. PROVIDE SS HOOK FOR TRANSDUCER CABLE.

NOTES


1. DASHED PIPING AND FITTINGS INDICATE IT IS OUT OF SECTION BUT SHOWN FOR CLARITY.

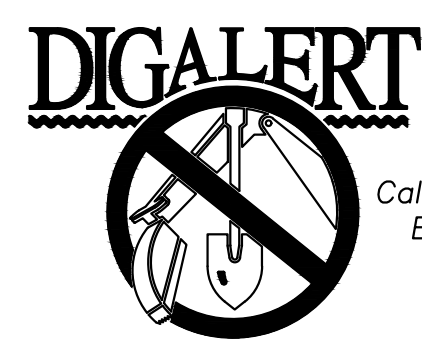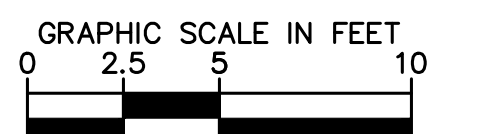

BENCHMARK:
 NATIONAL GEODETIC SURVEY BENCHMARK NO. Q 1311
 1.4 MILES WEST OF BEAUMONT ON INTERSTATE 10 TO SAN TIMOTEO CANYON NEAR FRONTAGE ROAD ON SOUTH(WEST) SIDE OF INTERSTATE 10, 0.1 MILES SOUTHWEST ALONG FRONTAGE ROAD, SOUTH ACROSS THE ROAD FROM A GUY POLE 25.9 FEET SOUTH OF THE CENTERLINE OF FRONTAGE ROAD, 1.6 FEET WEST OF POWERPOLE AND 1.5 FEET EAST OF A WITNESS POST, INSIDE A 4 INCH PVC PIPE WITH SCREW PLUG 1 INCH ABOVE GROUND (ELEVATION = 2468.07). ALSO SHOWN ON HIGHWAY 69 / POTRERO BLVD. INTERCHANGE STATIC GPS PROJECT CONTROL DIAGRAM AND IDENTIFIED THEREON AS 3538 BM D3474 WHEN THE PUBLISHED ELEVATION = 2468.07 IS CORRECTED WITH A MEASURED ELEVATION = 2468.01, USED HEREON.
 ELEV. 2468.01, (NVD '88), (STAMPED Q 1311 1978)

BY	MARK	DESCRIPTION	APPR.	DATE
ENGINEER		REVISIONS	CITY	

Kimley»Horn
 401 B Street, Suite 600, San Diego, CA 92101
 Phone: (619) 234-9411
 WWW.KIMLEY-HORN.COM
Sam McWhorter
 SAM L. MCWHORTER
 R.C.E. 61788 8/23/2021

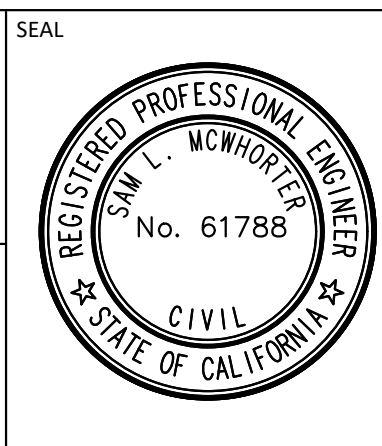

DESIGN BY:
SLM
 DRAWN BY:
RC/SW
 CHECKED BY:
TW/SS
 SCALE:
DATE:
 JOB NUMBER:
195284001





Reviewed By: _____ Date: _____
 Staff Engineer
 Recommended for Approval By: _____ Date: _____
 Administrative Engineer
 Approved By: _____ Date: _____
 City Engineer/Director of Public Works
 CITY OF BEAUMONT, PUBLIC WORKS DEPARTMENT
 ENGINEERING DIVISION
 5506 6th St
 Beaumont, CA 92223
 TEL: (951) 789-8520 FAX: (951) 789-8528

CITY OF BEAUMONT, CALIFORNIA
 IMPROVEMENT PLANS FOR:
**BEAUMONT CROSSROADS
 LIFT STATION**
 LIFT STATION SECTION A

SHEET
 7
 OF 38 SHEETS
 FILE NO.
 3387

Plotted By: V:\mwhorn, Sam, Sheet Set: BEAUMONT LIFT STATION, Section B-B, October 20, 2021, 10:51:53am, K:\ISND_WATER\195284001_Beaumont Lift Station\Design\Plan Sheets - 2020\DELTA SET\195284001 - SECTIONS.dwg

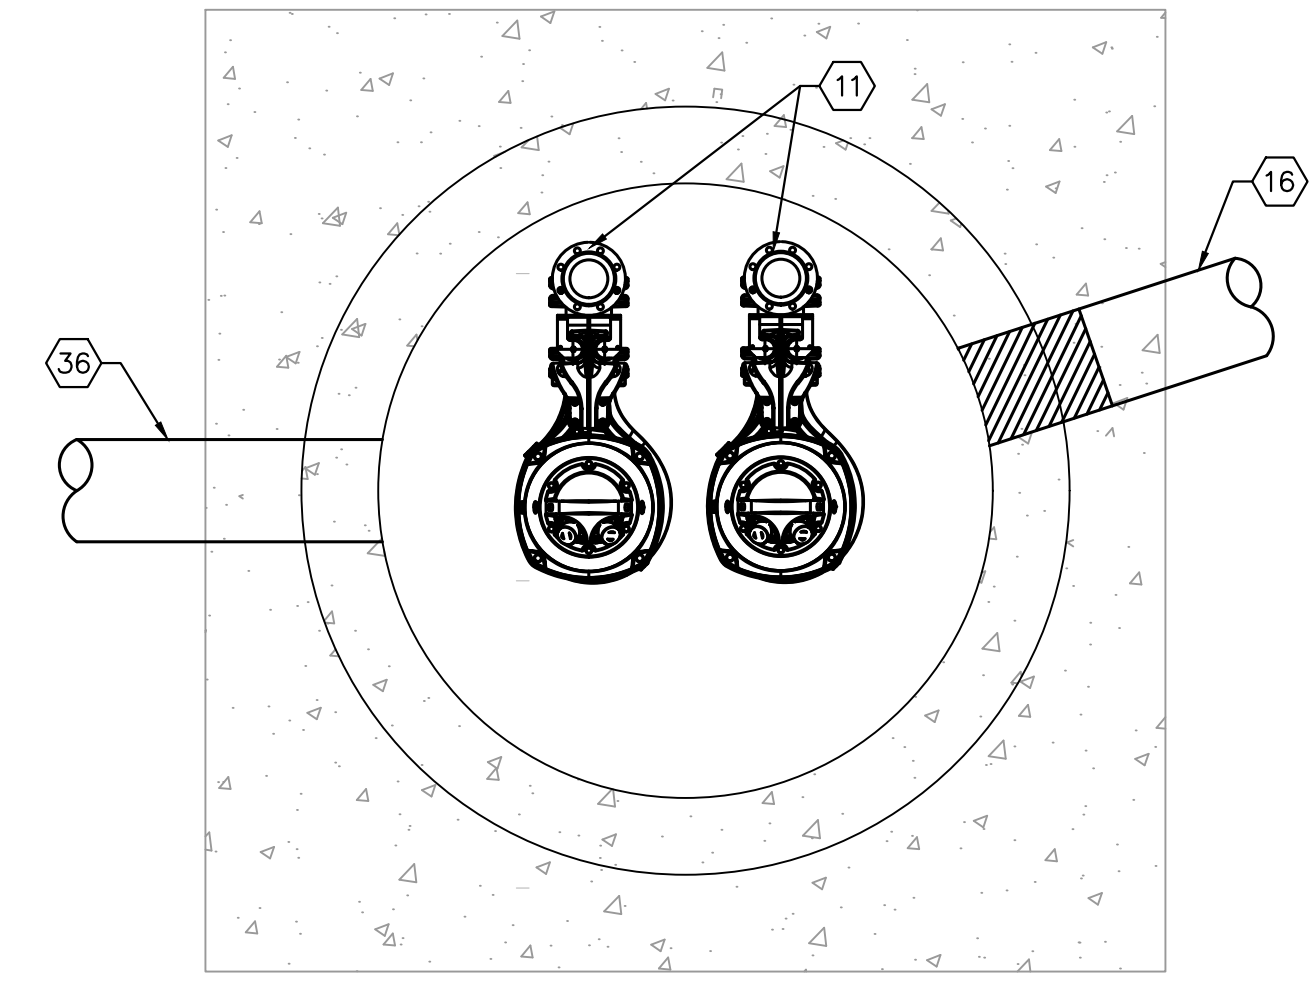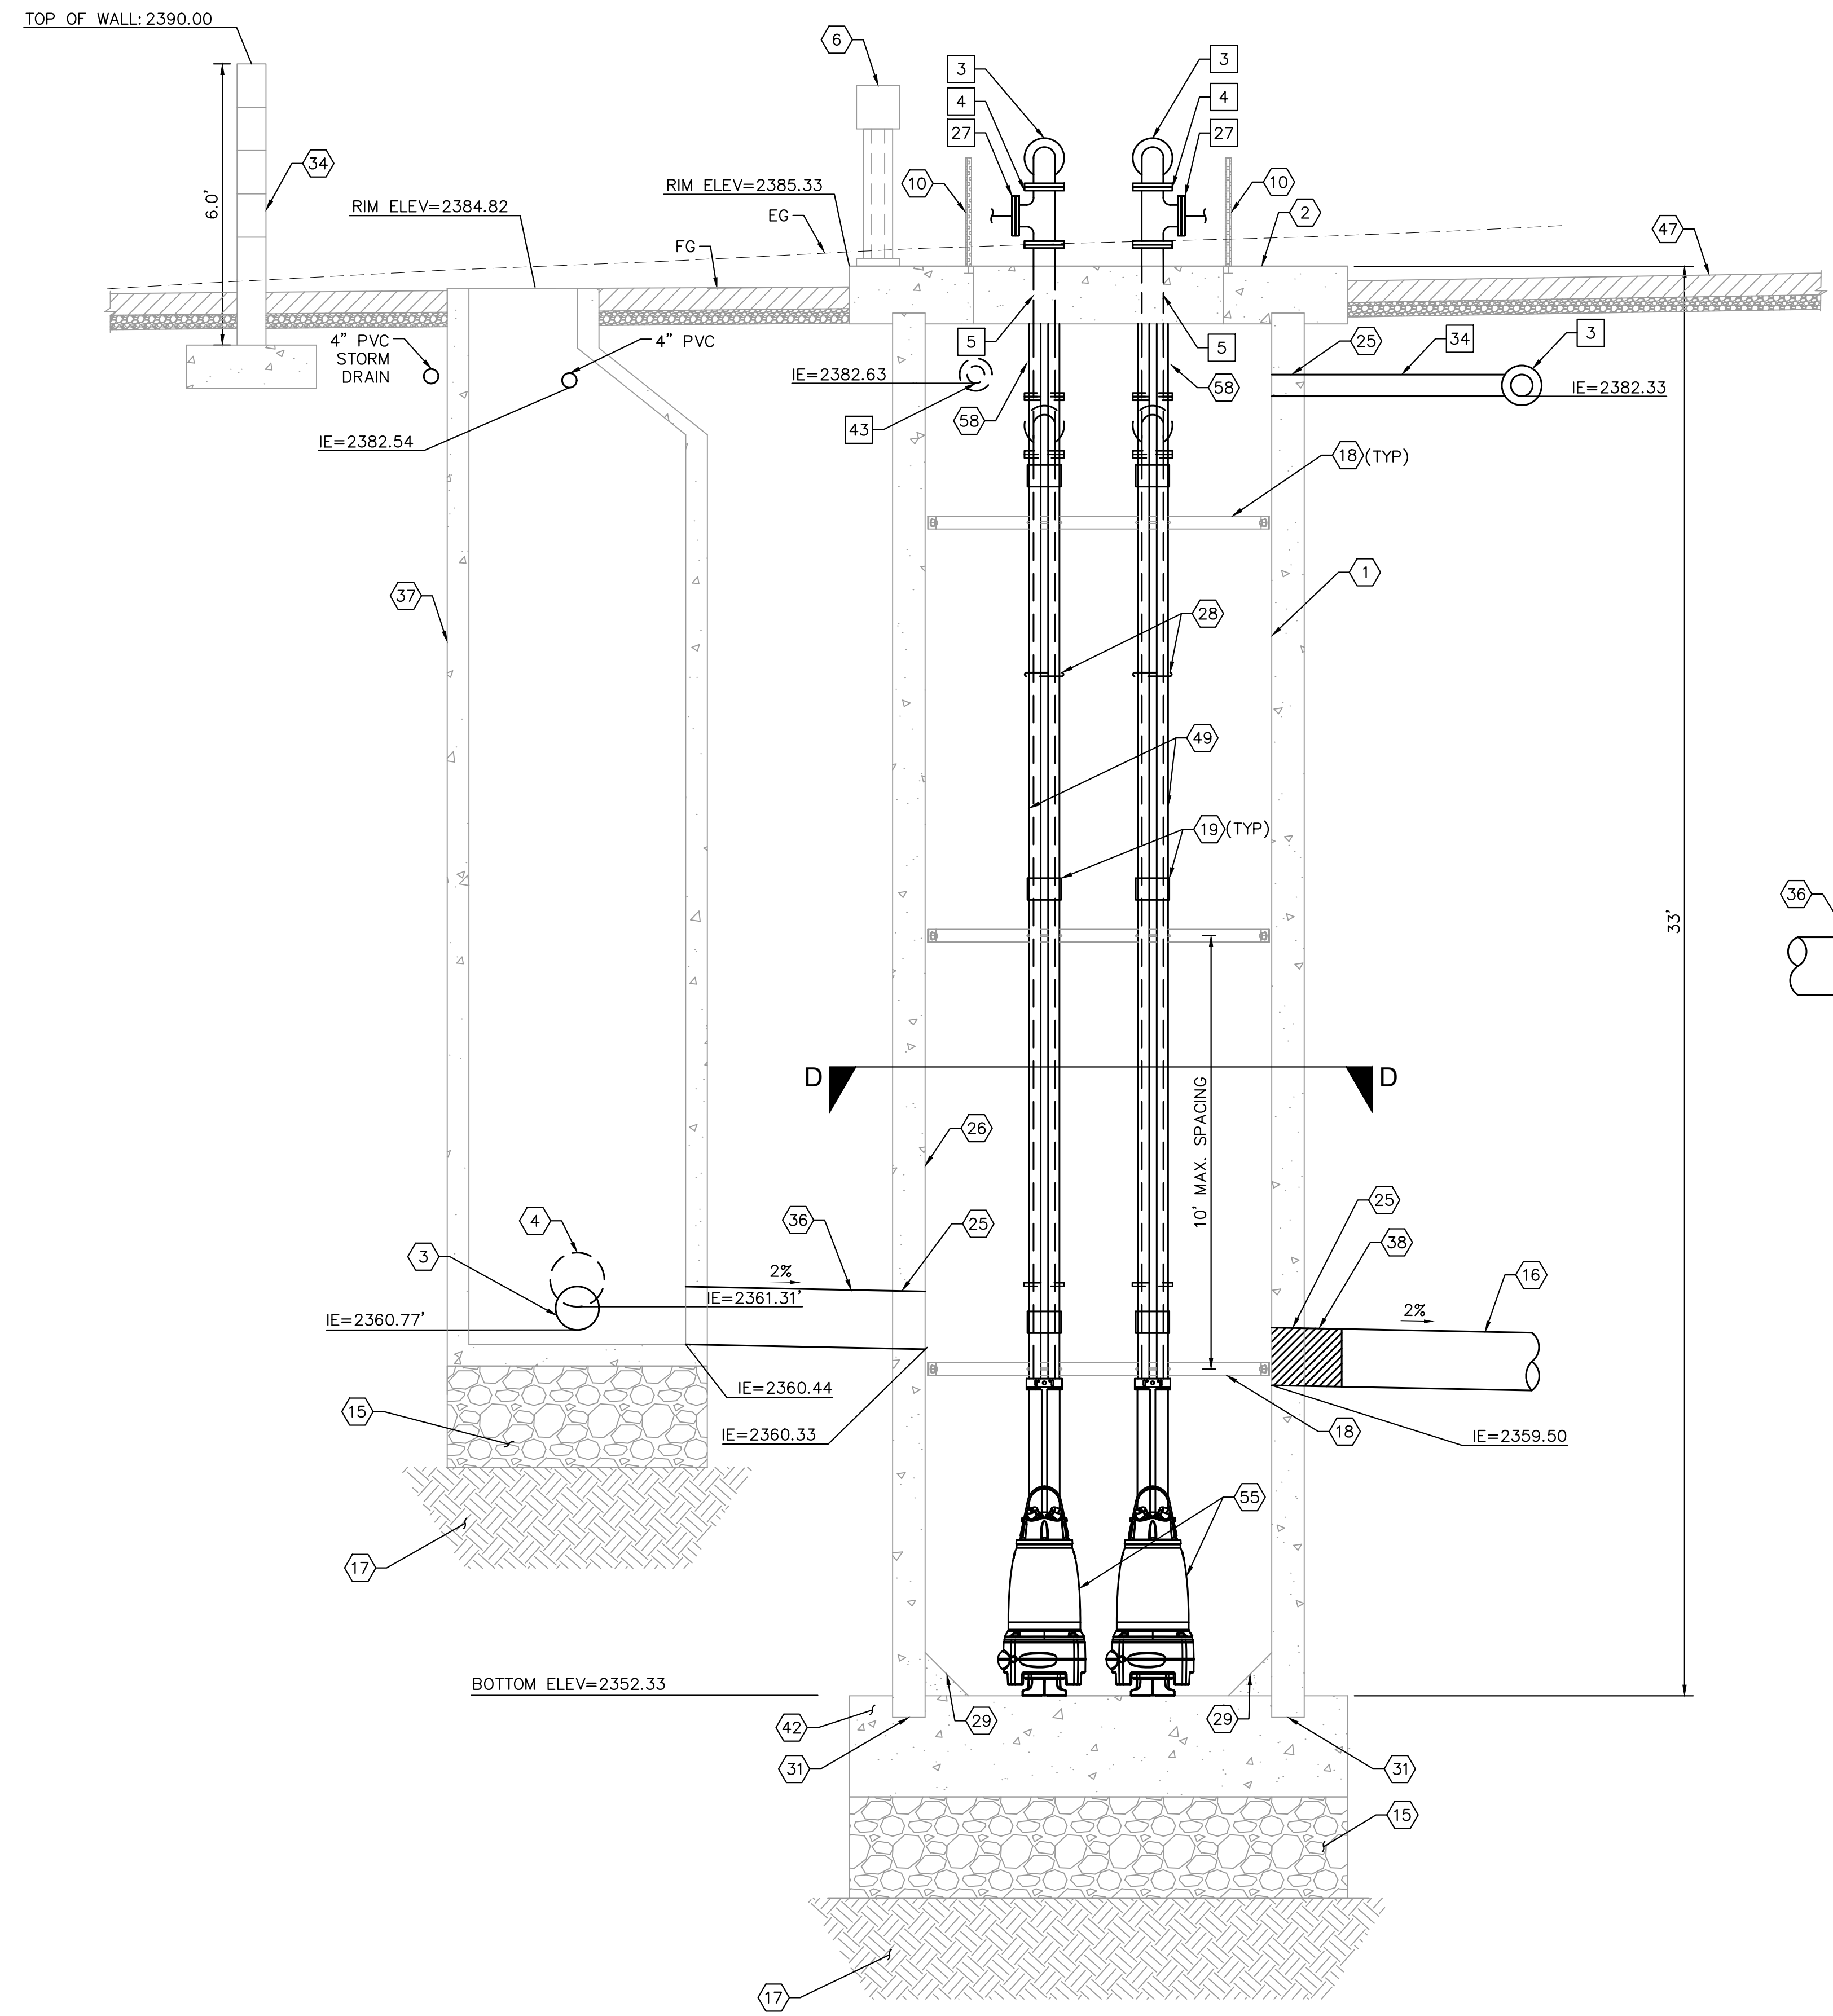


SECTION D-D
N.T.S.

SECTION B-B
SCALE: 1" = 2.5'

- SEWER LIFT STATION NOTES**
- 1 8" DIAMETER CLASS IV RCP PER ASTM C78 W/ TWO CIRCULAR REINFORCEMENT CAGES AND FLUSH BELL AND SPIGOT JOINTS. BELL AND SPIGOT JOINTS SHALL BE PROVIDED W/ RUBBER GASKETS AND SHALL BE SUITABLE FOR A HYDROSTATIC HEAD OF 50' PER ASTM C361. INTERIOR CONCRETE SURFACES INCLUDING WALL AND ROOF SHALL BE COATED PER SPECIFICATIONS.
 - 2 11.5' X 11.5' CONCRETE WET WELL TOP SLAB
 - 3 12" SDR-26 PVC INFLUENT
 - 4 15" SDR-26 PVC INFLUENT
 - 6 ELECTRIC JUNCTION BOX AND STANCHION FOR PUMP POWER/CONTROL CABLES, FLOATS, AND TRANSDUCERS.
 - 10 72" X 48" STAINLESS STEEL DOUBLE LEAF HATCH WITH FALL PROTECTION GRATE
 - 11 DISCHARGE CONNECTION, 6" SCH 40, 316 STAINLESS STEEL
 - 15 MIN 2' CRUSHED AGGREGATE BASE
 - 16 16" C900 DR-25 PVC-EFFLUENT FOR FUTURE PHASE 2 WET WELL
 - 17 COMPACTED SUBGRADE @ 95% R.C. PER GEOTECHNICAL RECOMMENDATIONS
 - 18 STAINLESS STEEL SUPPORT FOR FORCE MAIN. SEE DETAIL B, SHEET 11. 10' SPACING BETWEEN SUPPORTS.
 - 19 6" INTERMEDIATE GUIDE RAIL SUPPORT BRACKET PER FLYGT. 10' SPACING BETWEEN BRACKETS.
 - 25 PIPE PENETRATION. SEE DETAIL B, SHEET 10.
 - 26 FIELD APPLY 125 ML OF SANCON 100 ON CONCRETE INTERIOR SURFACE
 - 28 6" VICTAULIC COUPLING
 - 29 GROUT FILLET - SLOPE VARIES. 1.5' MAX HEIGHT. 1' MIN HEIGHT.
 - 31 SLAB TO RCP. SEE DETAIL D, SHEET 10.
 - 34 SPLIT FACE WALL PER CALTRANS STANDARD DRAWING B15-1, CASE 1
 - 36 16" C900 DR-25 PVC-INFLUENT
 - 37 5' DIA SEWER MANHOLE, RING AND COVER PER EMWD SA-87 AND SB-53.
 - 38 TEMPORARY INFLATED NYLON PLUG TO BE REMOVED AFTER FUTURE PHASE II LIFT STATION CONSTRUCTION.
 - 42 FOR SLAB DIMENSIONS, SEE SHEETS 33 AND 34
 - 47 4" AC OVER 6" CRUSHED AB
 - 49 MODIFIED GUIDE RAILS. SEE DETAIL A, SHEET 12.
 - 55 2 FLYGT NON-CLOG SUBMERSIBLE PUMPS Q=300 GPM AT 280' EACH PUMP, NP 3301 HT 3-460
 - 58 6" SCHEDULE 40, 316 STAINLESS STEEL 90° BEND

- MECHANICAL NOTES**
- 3 6" DI 90° BEND
 - 4 6" DI TEE, FLANGED
 - 5 6" DI SPOOL, FLANGED
 - 27 6" BLIND FLANGE. TAPPED FOR 1" FLUSHING LINE.
 - 34 6" DI VENT PER DETAIL D, SHEET 12.
 - 43 4" DI SPOOL, FLANGED

- NOTES**
1. DASHED PIPING AND FITTINGS INDICATE IT IS OUT OF SECTION BUT SHOWN FOR CLARITY.

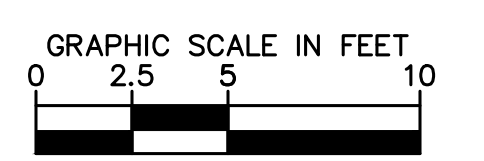


BENCHMARK:
 NATIONAL GEODETIC SURVEY BENCHMARK NO. 1311
 1.4 MILES WEST OF BEAUMONT ON INTERSTATE 10 TO SAN TIMOTEY CANYON NEAR FRONTAGE ROAD ON SOUTH(WEST) SIDE OF INTERSTATE 10, 0.1 MILES SOUTHWEST ALONG FRONTAGE ROAD, SOUTH ACROSS THE ROAD FROM A GUY POLE 25.9 FEET SOUTH OF THE CENTERLINE OF FRONTAGE ROAD, 1.8 FEET WEST OF POWERPOLE AND 1.8 FEET EAST OF A WITNESS POST, INSIDE A 4 INCH PVC PIPE WITH SCREW PLUG 1 INCH ABOVE GROUND (ELEVATION = 2468.07). ALSO SHOWN ON HIGHWAY 69 // POTRERO BLVD. INTERCHANGE STATIC GPS PROJECT CONTROL DIAGRAM AND IDENTIFIED THEREON AS 3558 BM D3474 WHEN THE PUBLISHED ELEVATION = 2468.07 IS CORRECTED WITH A MEASURED ELEVATION = 2468.01, USED HEREON.
 ELEV. 2468.01, (NVD '88), (STAMPED Q 1311 1978)


BY	MARK	DESCRIPTION	APPR.	DATE
ENGINEER		REVISIONS	CITY	

Kimley»Horn
 401 B Street, Suite 600, San Diego, CA 92101
 Phone: (619) 234-9411
 WWW.KIMLEY-HORN.COM

Sam McWhorter
 SAM L. MCWHORTER
 R.C.E. 61788
 8/23/2021

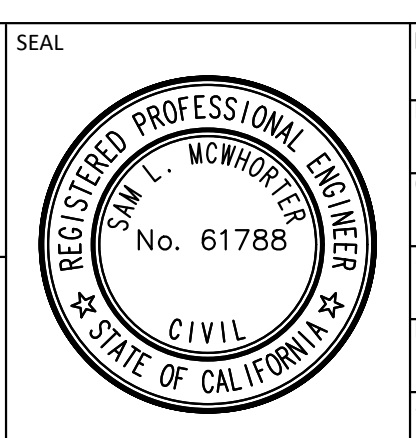

DESIGN BY: SLM
 DRAWN BY: RC/SW
 CHECKED BY: TW/SS
 SCALE:
 DATE:
 JOB NUMBER: 195284001

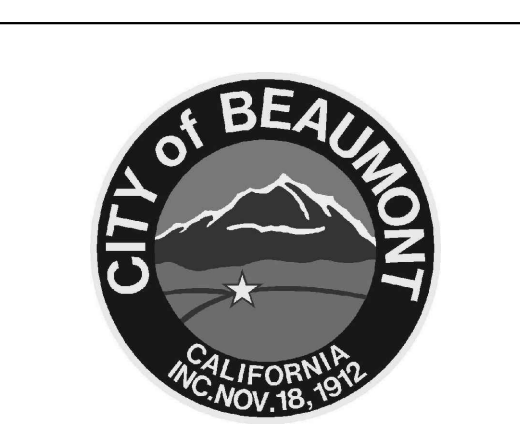

Reviewed By: _____ Date: _____
 Staff Engineer

Recommended for Approval By: *[Signature]* Date: 11/19/2021
 Administrative Engineer

Approved By: *[Signature]* Date: 11/23/2021
 City Engineer/Director of Public Works

CITY OF BEAUMONT, PUBLIC WORKS DEPARTMENT
 ENGINEERING DIVISION
 550E 6th St
 Beaumont, CA 92223
 TEL: (951) 769-8520 FAX: (951) 769-8526

CITY OF BEAUMONT, CALIFORNIA
 IMPROVEMENT PLANS FOR:
**BEAUMONT CROSSROADS
 LIFT STATION**

LIFT STATION SECTION B

SHEET
 8
 OF 38 SHEETS
 FILE NO:
 3387


Plotted By: \winline, Sam Sheet Set: BEAUMONT LIFT STATION Layout: Section E-E F-F October 20, 2021 10:52:32am K:\SND_WATER\195284001 Beaumont Lift Station\Design\Plan Sheets - 2020 DELTA SET\195284001 - SECTIONS_2.dwg

SEWER LIFT STATION NOTES


- ② 11.5' X 11.5' CONCRETE WET WELL TOP SLAB
- ⑩ INSTALL 72" X 48" STAINLESS STEEL DOUBLE LEAF HATCH WITH FALL PROTECTION GRATE
- ⑫ 12" SQUARE OPENING IN CONCRETE TOP WITH CAST IRON RING AND BROOKS CB1212 FRAME AND SOLID COVER FOR FLOAT SWITCH AND LEVEL TRANSDUCER. SEE DETAIL E, SHEET 10.
- ⑫⑤ PIPE PENETRATION. SEE DETAIL B, SHEET 10.
- ⑫④ SPLIT FACE WALL PER CALTRANS STANDARD DRAWING B15-1, CASE 1
- ⑫③ CONSTRUCT 6' HIGH TYPE-6A RETAINING WALL PER CALTRANS STD B3-7A.
- ⑫④ MCC BUILDING.
- ⑫⑤ ODOR CONTROL PAD. SEE DETAIL B SHEET 12.
- ⑫⑥ ELECTRIC GENERATOR PAD. SEE DETAIL C SHEET 12.
- ⑫⑦ 4" AC OVER 6" CRUSHED AB
- ⑫⑧ EXPANSION JOINT
- ⑫⑨ INSTALL 4" PVC STORM DRAIN WITH TRENCHING AND BACKFILL PER EMWD SB-157 AND SB-158. INVERT PER GRADING PLAN
- ⑫⑩ INSTALL 6' WIDE BY 7.33' HIGH STEEL DOUBLE SWING DOOR
- ⑫⑪ INSTALL 3/4" ROCK OVER MIRAFI LINER
- ⑫⑫ TWO PIECE ALUMINUM SAFETY GRATING BENEATH HATCH DOOR LEAFS. RATED FOR 200 LB/SF LIVE LOAD.
- ⑫⑬ INSTALL FENCE PER APWA STANDARD 600-3
- ⑫⑭ DRAINAGE DITCH PER SEPARATE PLANS. SEE ON-SITE GRADING PLANS (PERMIT NUMBER PW2019-0339).

MECHANICAL NOTES


- ⑤ 6" DI SPOOL, FLANGED
- ⑫⑨ VICTAULIC COUPLING
- ⑫⑩ INSTALL 4" APCO SURGE RELIEF ANGLE VALVE PRESSURE RANGE 100-200 PSI. SET TO 120 PSI.
- ⑫⑪ 6" x 4" DI REDUCER
- ⑫⑫ 4" DI 90° BEND
- ⑫⑬ 4" PLUG VALVE FLANGED WITH HAND WHEEL ACTUATOR. PRATT OR APPROVED EQUAL.
- ⑫⑭ 4" DI SPOOL, FLANGE X GROOVED END
- ⑫⑮ 4" DI 45° BEND
- ⑫⑯ 4" DI SPOOL, FLANGED
- ⑫⑰ 6" DI VENT PIPING

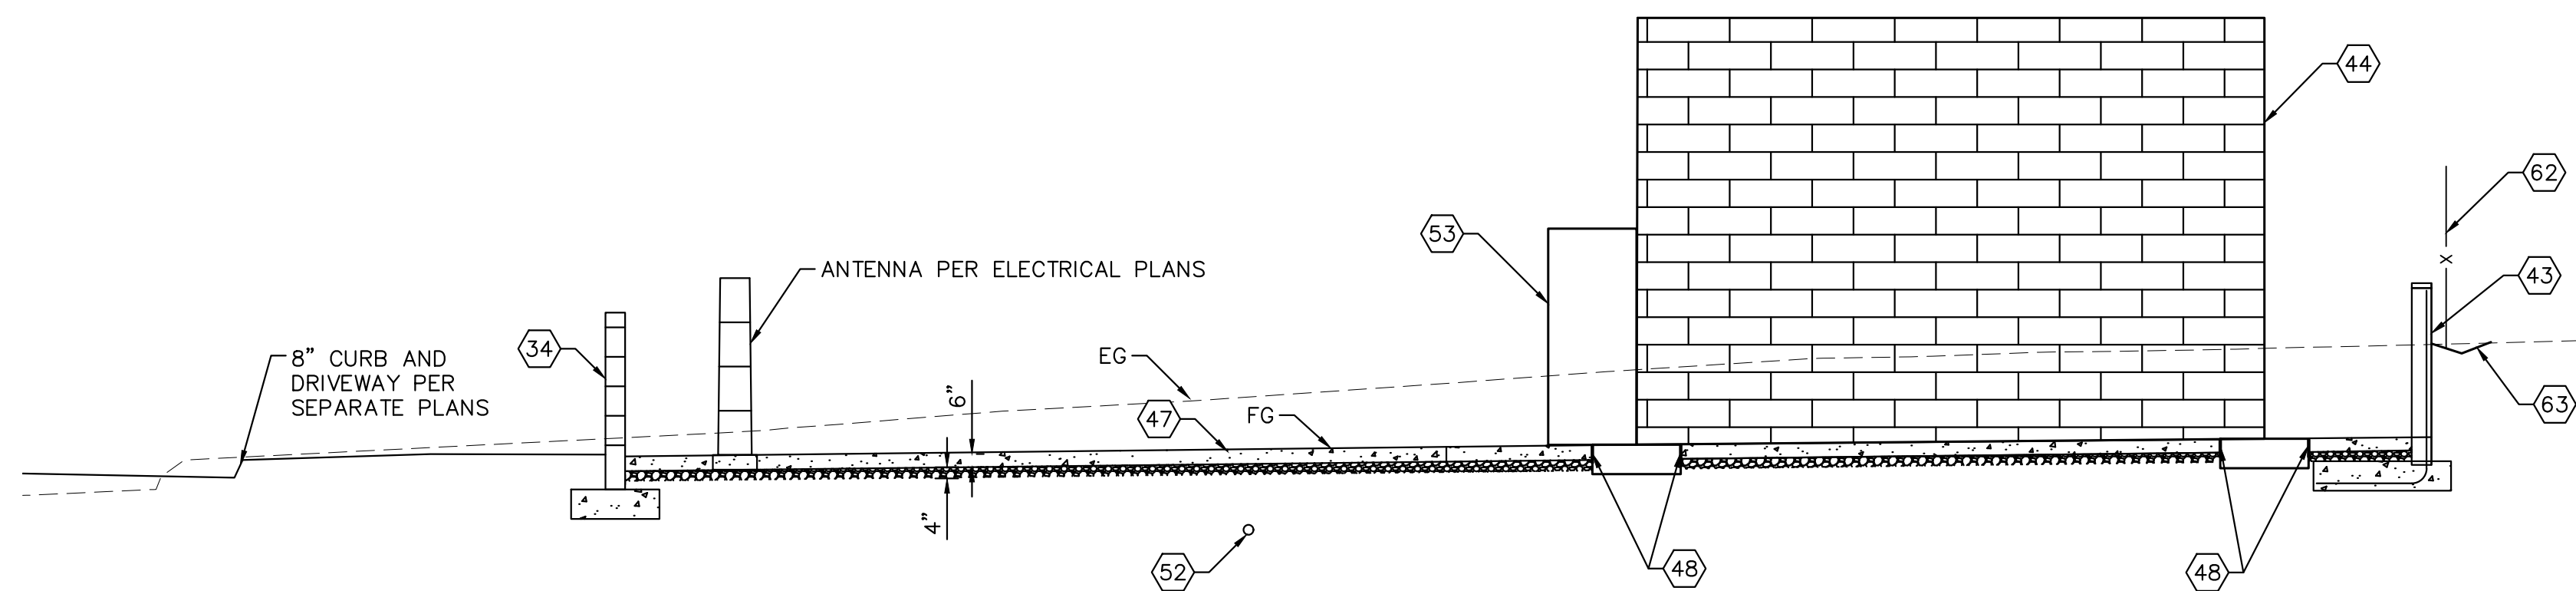


SECTION E-E
SCALE: 1" = 5'

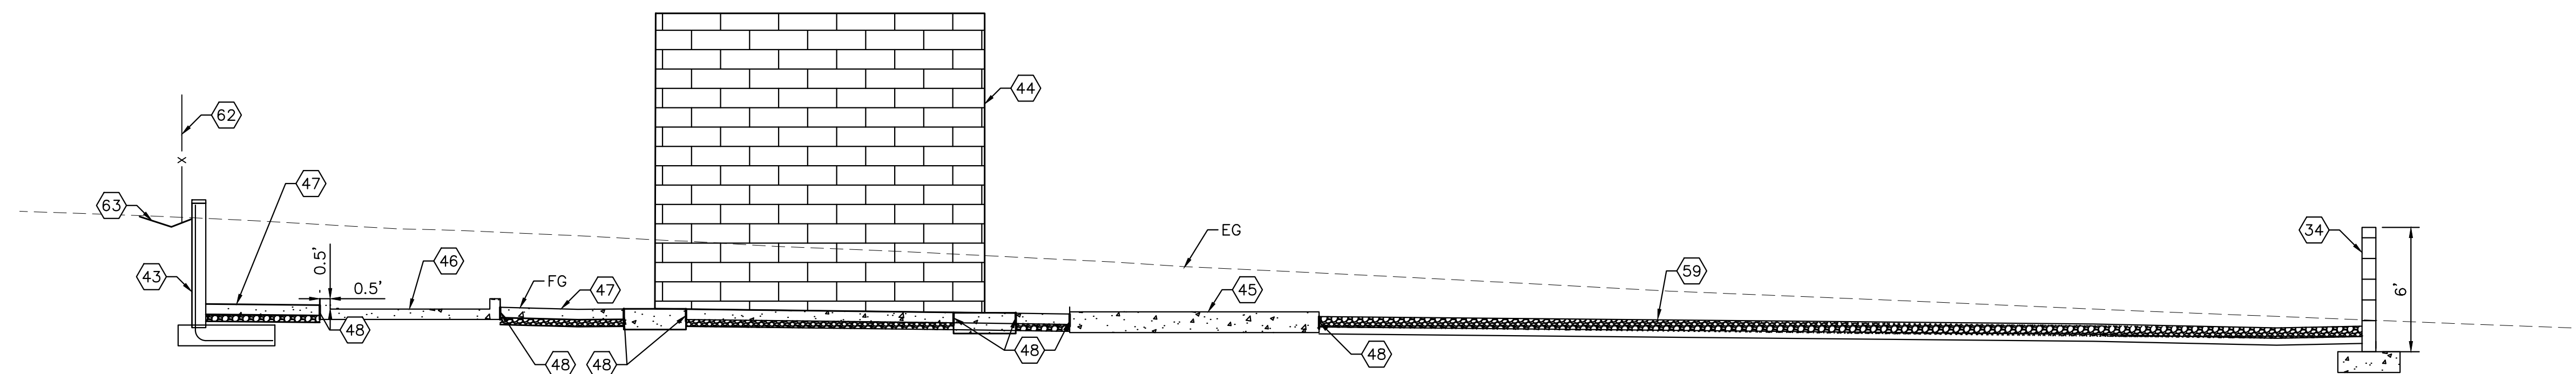

SECTION F-F
SCALE: 1" = 5'

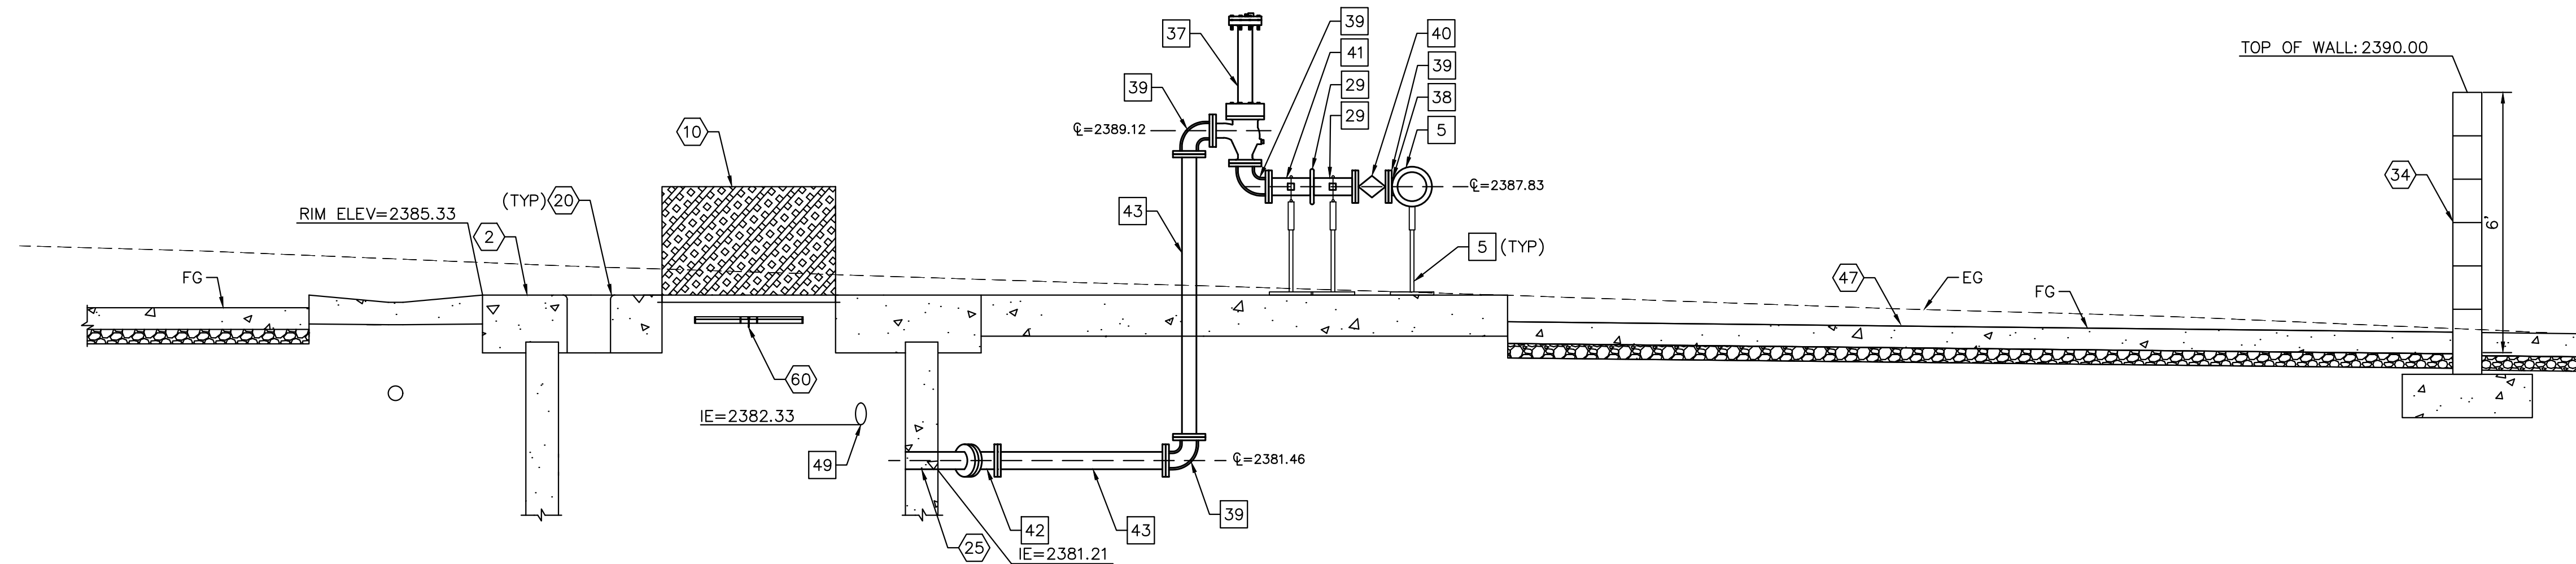

SECTION G-G
SCALE: 1" = 2.5'

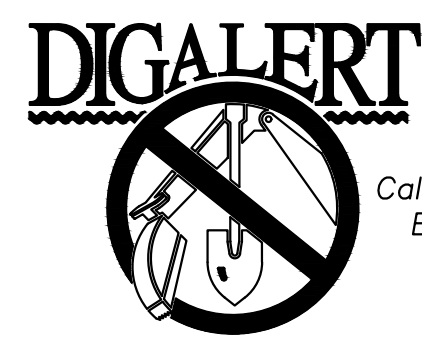


BENCHMARK:
 NATIONAL GEODETIC SURVEY BENCHMARK NO. 1311
 1.4 MILES WEST OF BEAUMONT ON INTERSTATE 10 TO SAN TIMOTEO CANYON NEAR FRONTAGE ROAD ON SOUTH(WEST) SIDE OF INTERSTATE 10, 0.1 MILES SOUTHWEST ALONG FRONTAGE ROAD, SOUTH ACROSS THE ROAD FROM A GUY POLE 25.9 FEET SOUTH OF THE CENTERLINE OF FRONTAGE ROAD, 1.6 FEET WEST OF POWERPOLE AND 1.6 FEET EAST OF A WITNESS POST, INSIDE A 4 INCH PVC PIPE WITH SCREW PLUG 1 INCH ABOVE GROUND (ELEVATION = 2468.07). ALSO SHOWN ON HIGHWAY 69 // POTRERO BLVD. INTERCHANGE STATIC GPS PROJECT CONTROL DIAGRAM AND IDENTIFIED THEREON AS 3558 BM D3474 WHEN THE PUBLISHED ELEVATION = 2468.07 IS CORRECTED WITH A MEASURED OFFSET = 2468.01, USED HEREON.
 ELEV. 2468.01, (NVD '88), (STAMPED Q 1311 1978)

BY	MARK	DESCRIPTION	APPR.	DATE
ENGINEER		REVISIONS		CITY

Kimley»Horn
 401 B Street, Suite 600, San Diego, CA 92101
 Phone: (619) 234-9411
 WWW.KIMLEY-HORN.COM

Sam McWhorter
 R.C.E. 61788
 8/23/2021

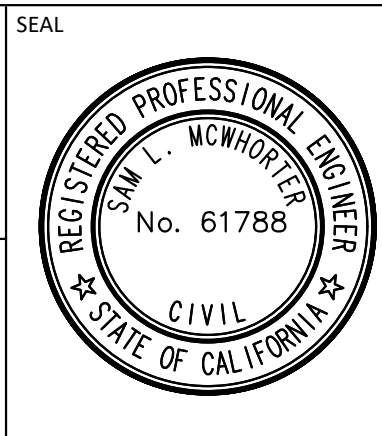


DESIGN BY: SLM
 DRAWN BY: RC/SW
 CHECKED BY: TW/SS
 SCALE: DATE: JOB NUMBER: 195284001

Reviewed By: _____ Date: _____
 Recommended for Approval By: *[Signature]* Date: 11/19/2021
 Approved By: *[Signature]* Date: 11/23/2021
 City Engineer/Director of Public Works


CITY OF BEAUMONT, PUBLIC WORKS DEPARTMENT
 ENGINEERING DIVISION
 550E 6th St
 Beaumont, CA 92223
 TEL: (951) 789-8520 FAX: (951) 789-8528

CITY OF BEAUMONT, CALIFORNIA
 IMPROVEMENT PLANS FOR:
BEAUMONT CROSSROADS LIFT STATION
 LIFT STATION SECTION C


SHEET
9
 OF 38 SHEETS
 FILE NO.: 3387

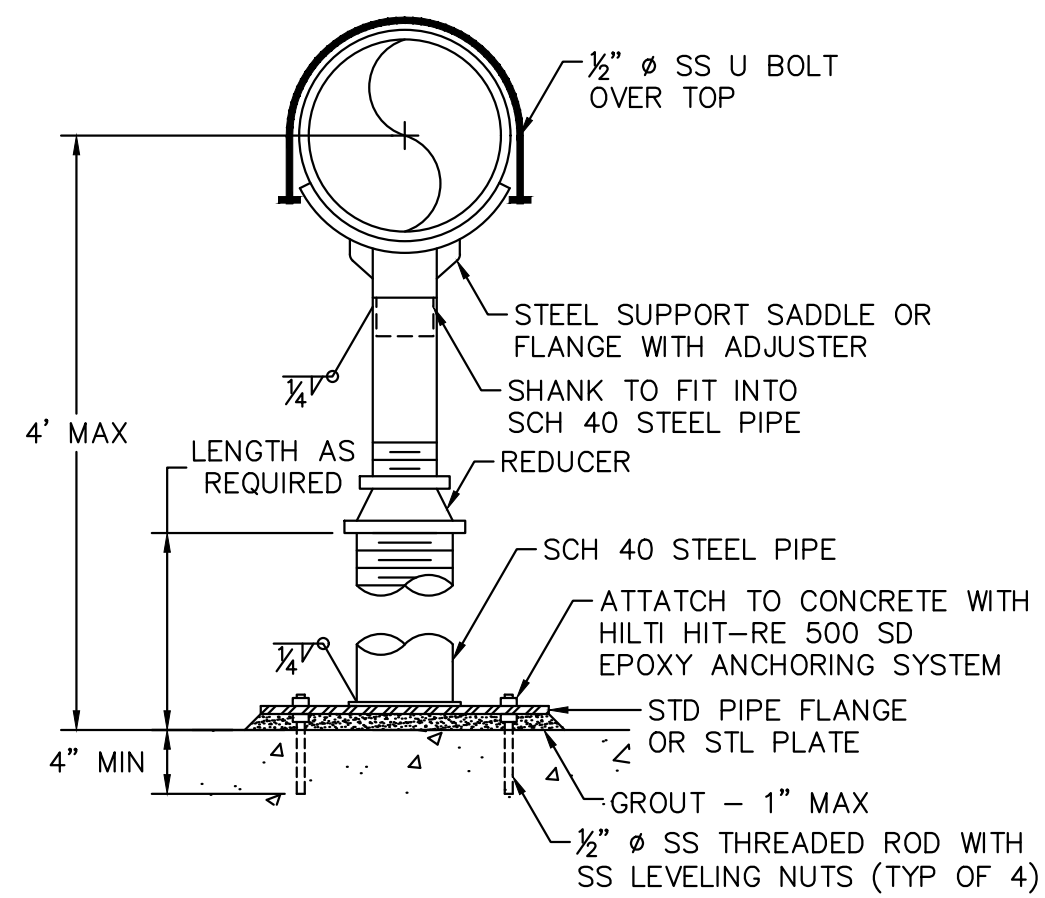


A PIPE SUPPORT
NOT TO SCALE

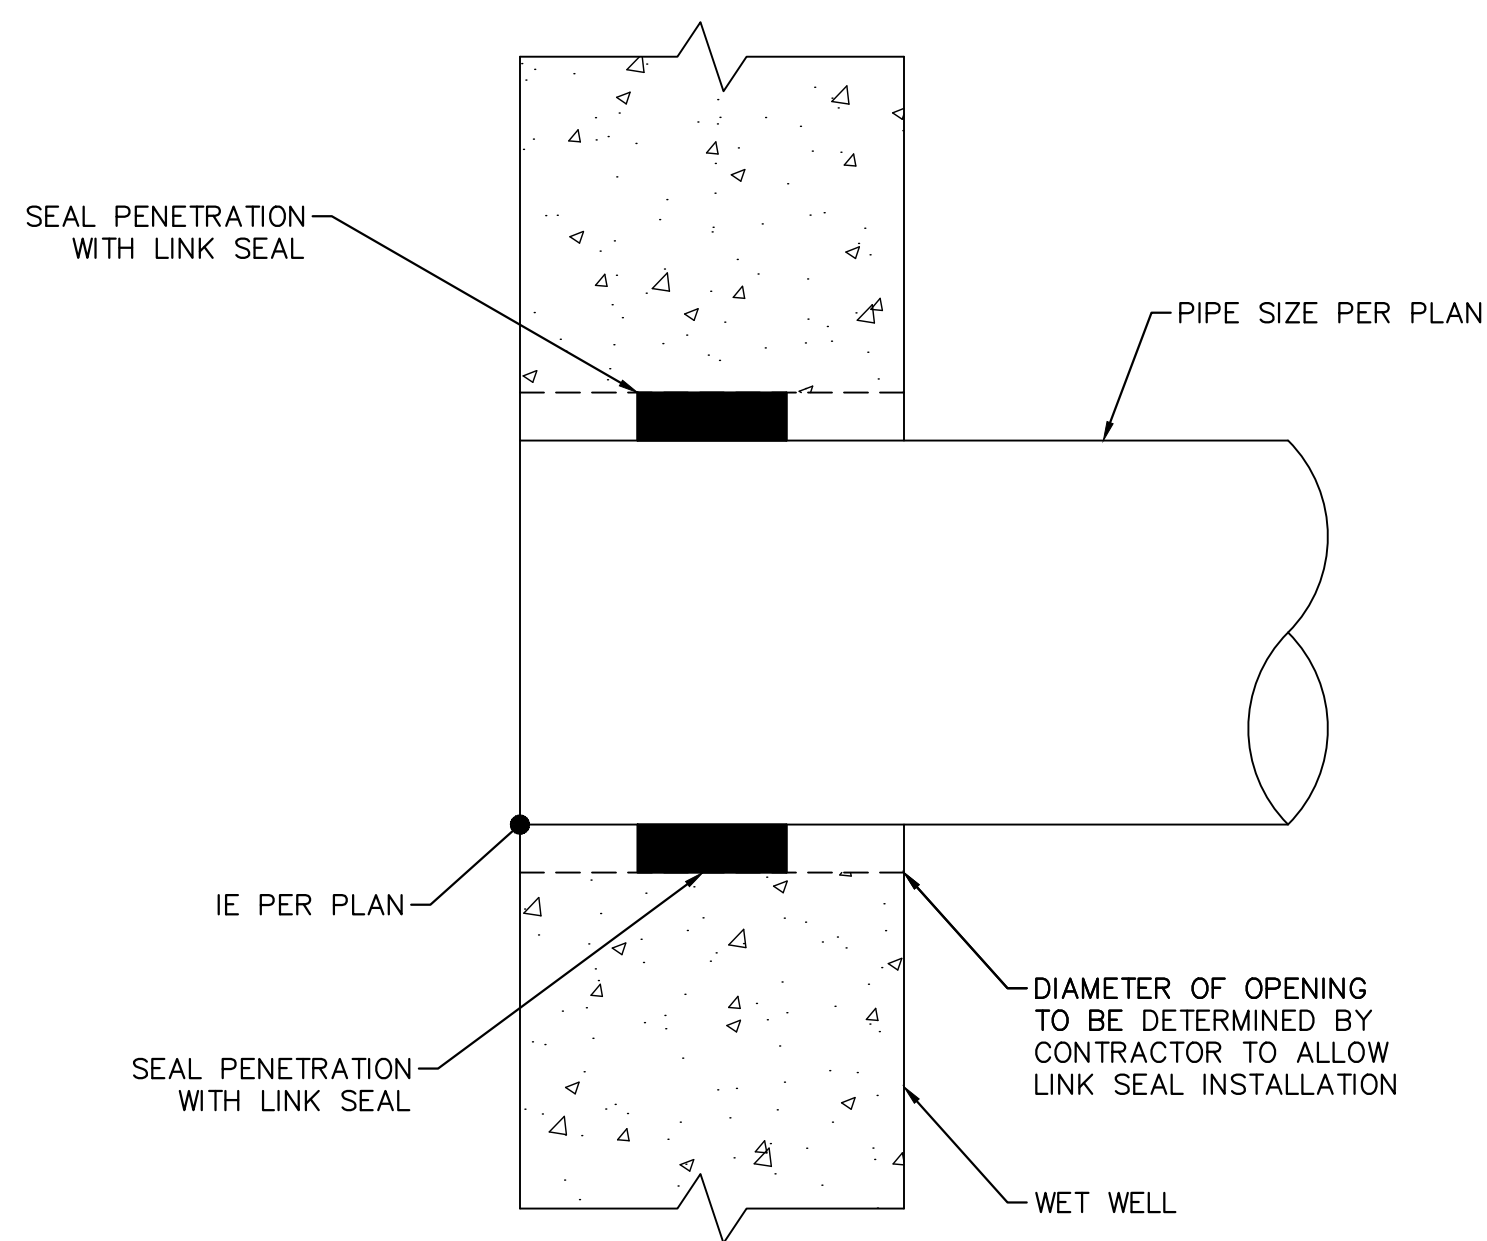


B PIPE PENETRATION
NOT TO SCALE

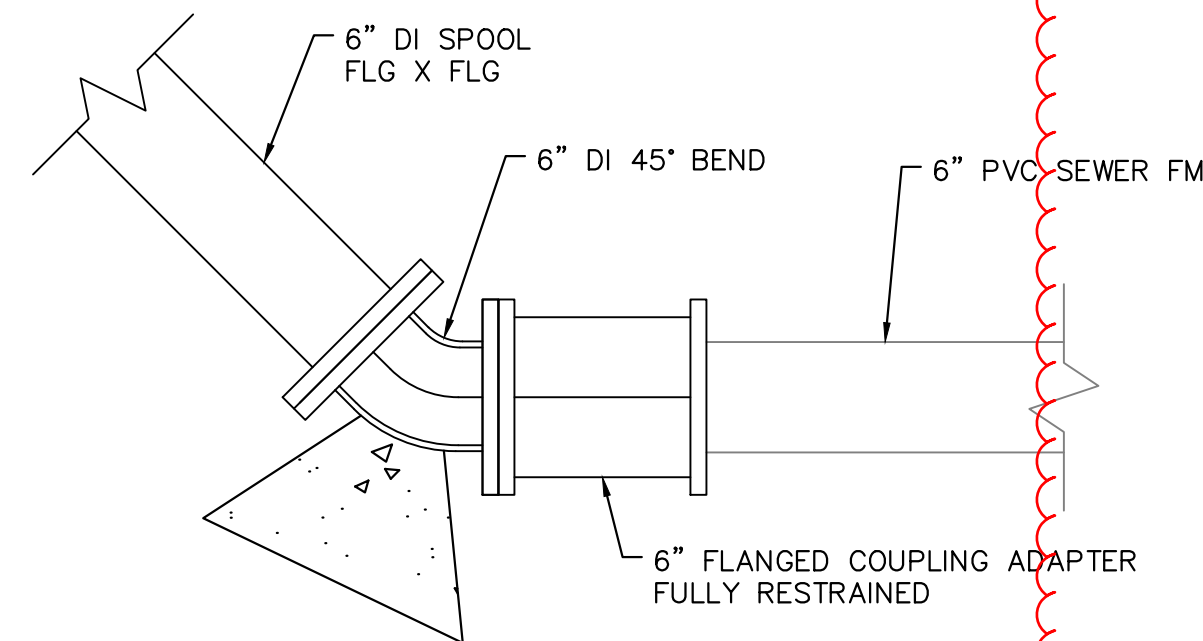




C DI TO PVC FORCE MAIN COUPLING DETAIL
NOT TO SCALE

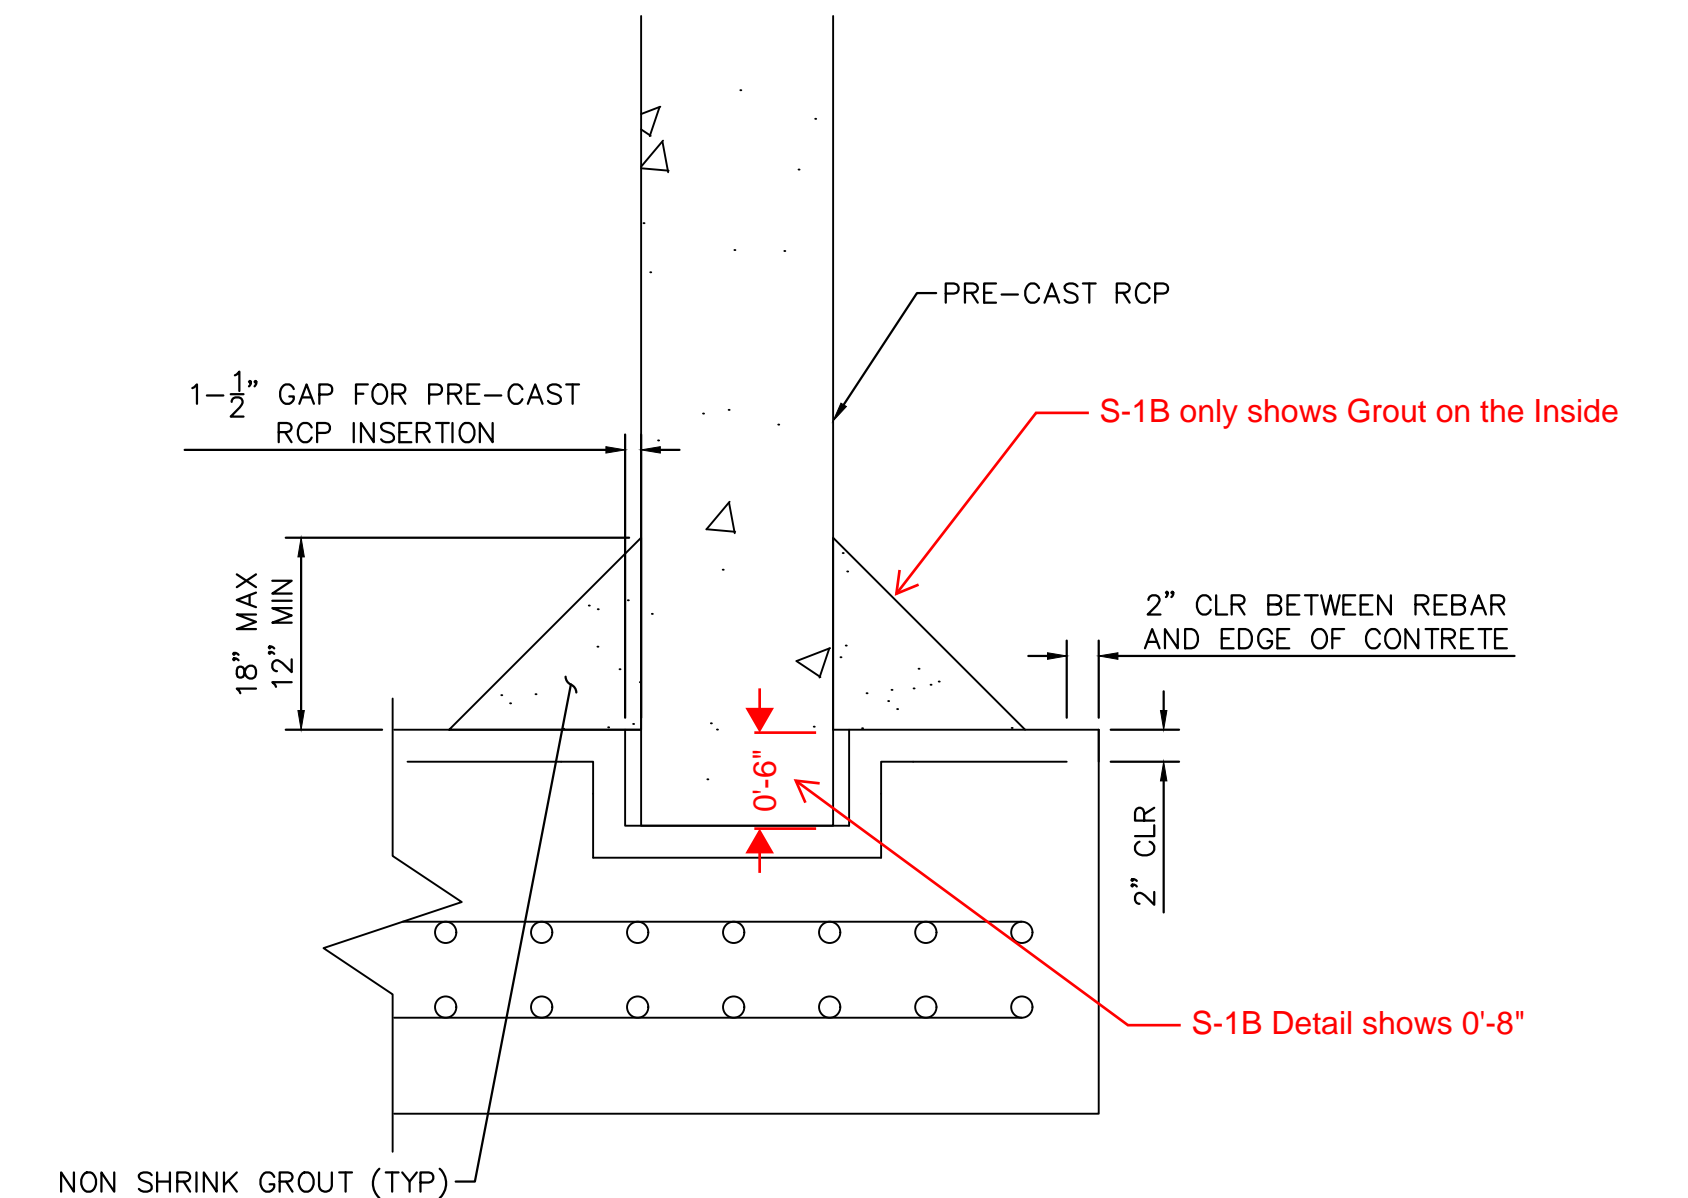

D SLAB TO RCP CONNECTION DETAIL
NOT TO SCALE

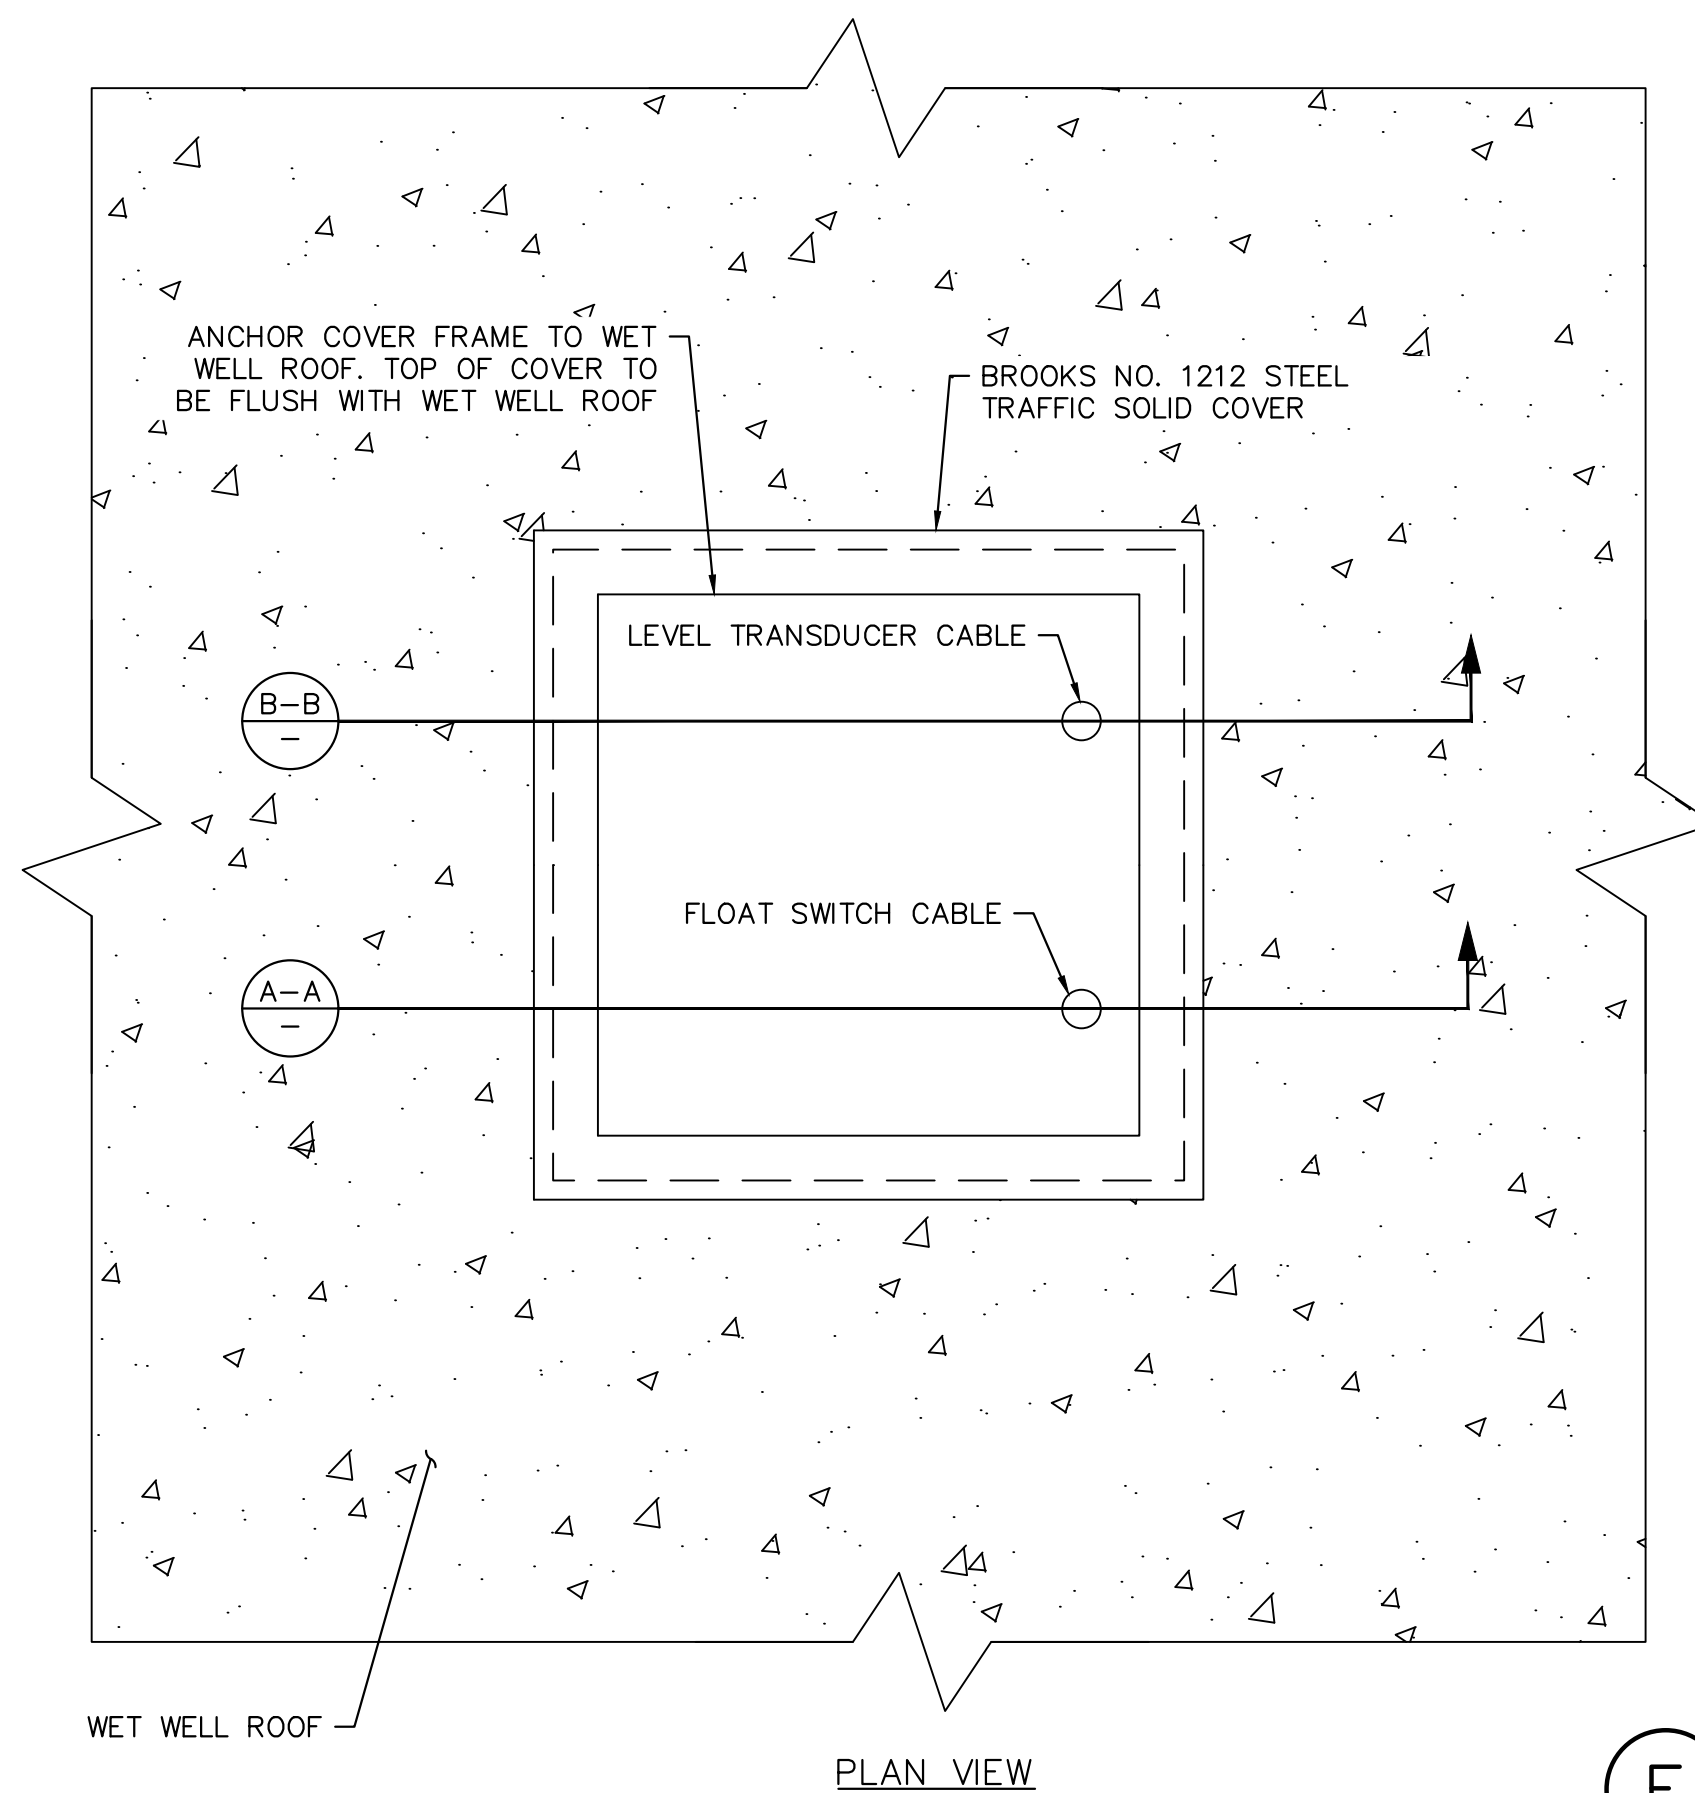

E FLOAT SWITCH AND LEVEL TRANSDUCER ACCESS OPENING DETAIL
NOT TO SCALE

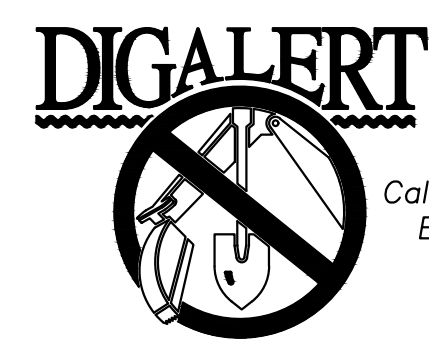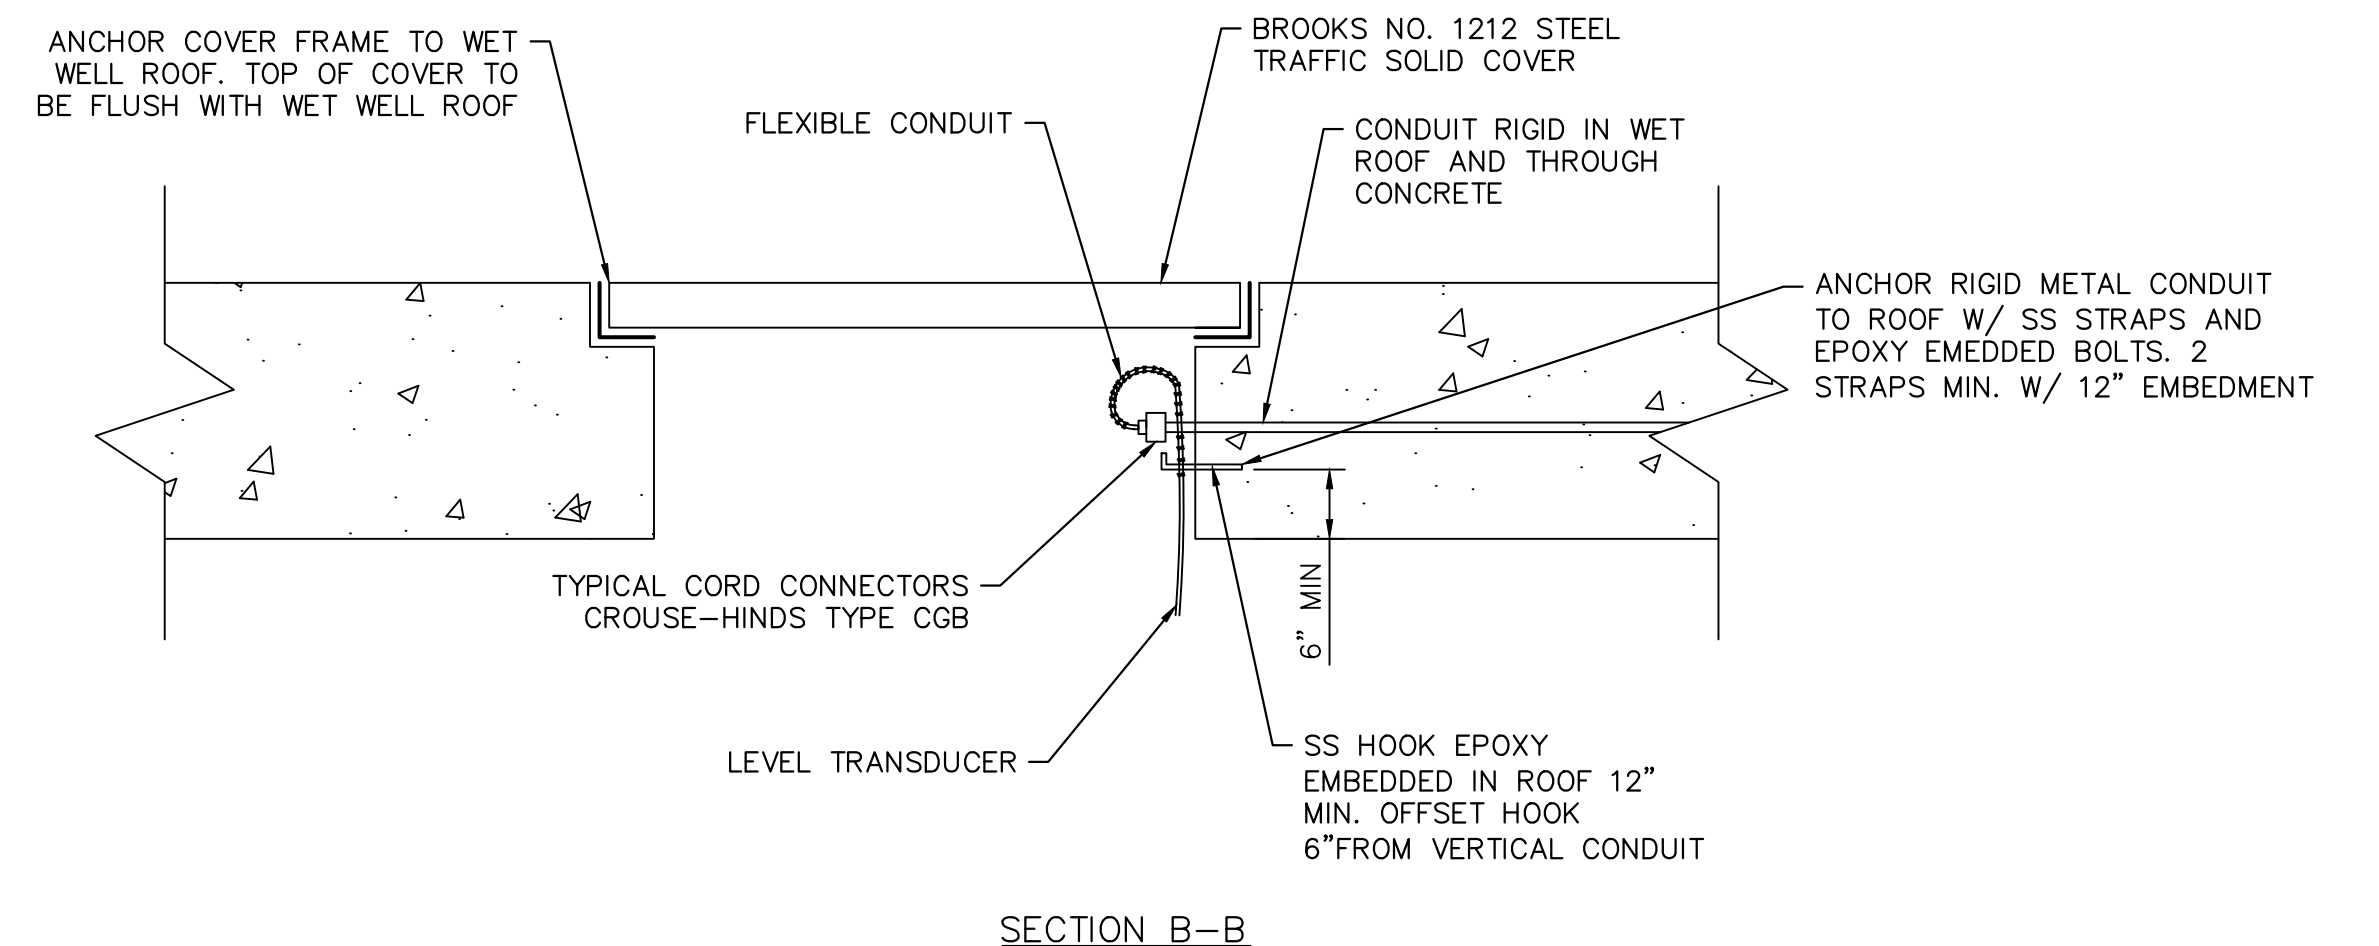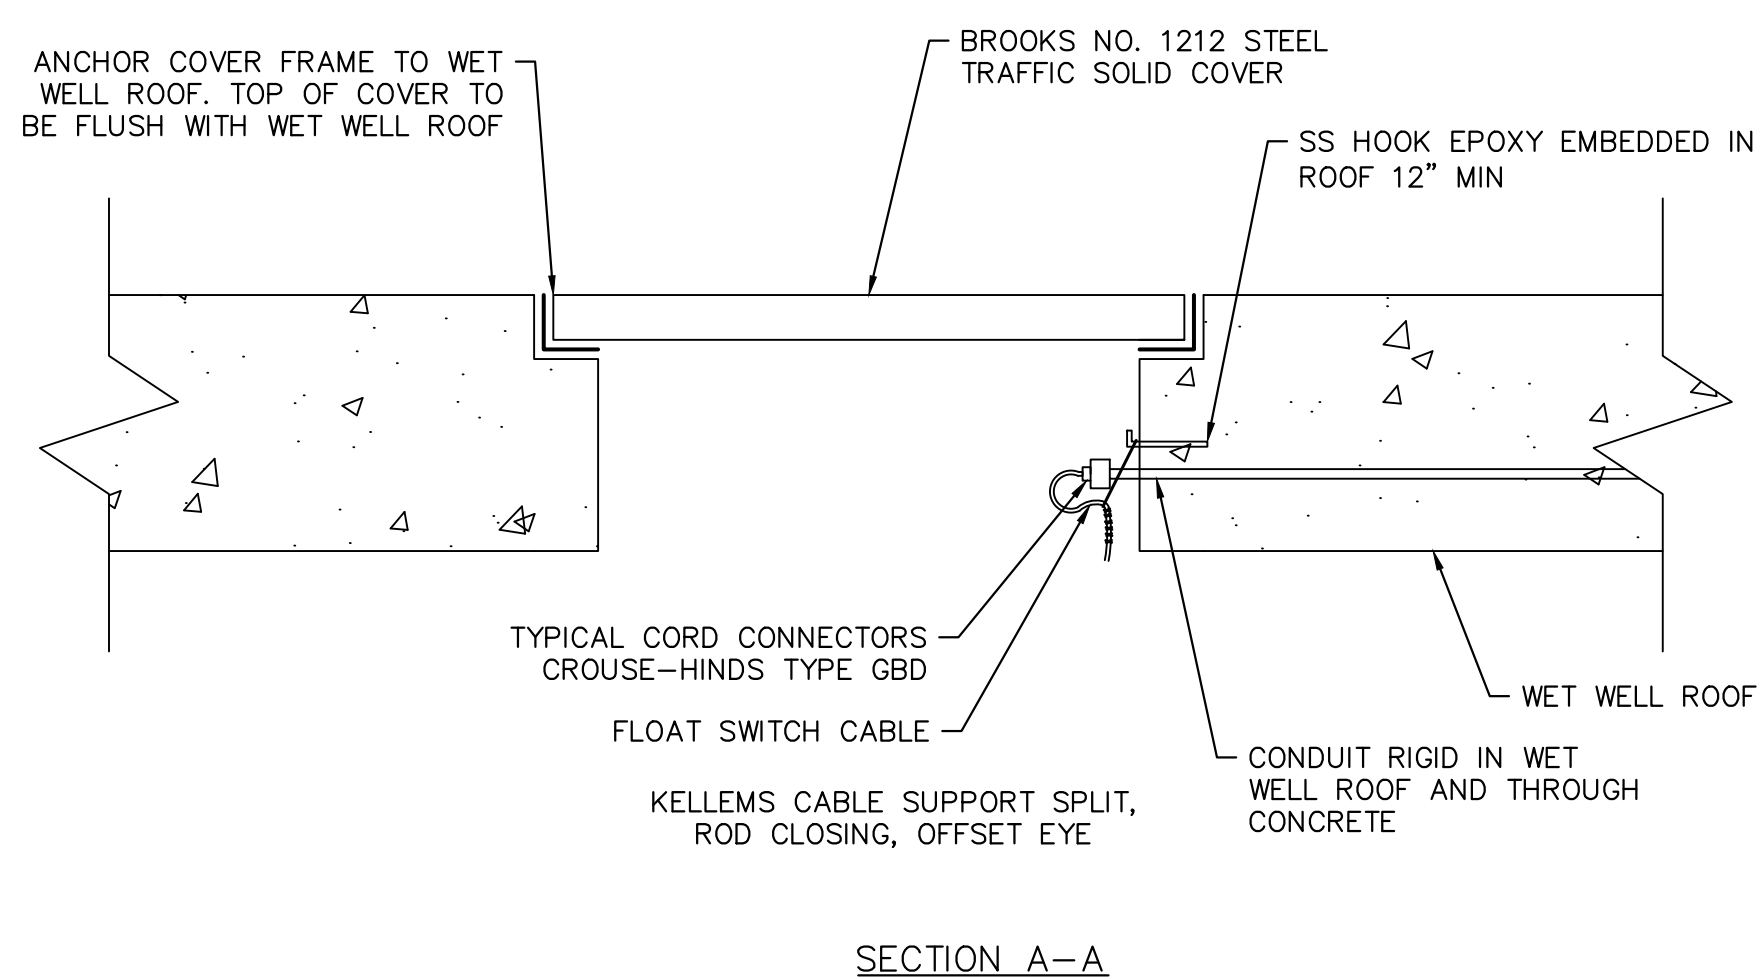


Call 2 Working Days
Before You Dig!
811

BENCHMARK:
NATIONAL GEODETIC SURVEY BENCHMARK NO. 1311
1.4 MILES WEST OF BEAUMONT ON INTERSTATE 10 TO SAN
TIMOTEO CANYON NEAR FRONTAGE ROAD ON SOUTH(WEST)
SIDE OF INTERSTATE 10, 0.1 MILES SOUTHWEST ALONG
FRONTAGE ROAD, SOUTH ACROSS THE ROAD FROM A GUY
POLE 25.9 FEET SOUTH OF THE CENTERLINE OF FRONTAGE
ROAD, 1.8 FEET WEST OF POWERPOLE AND 1.8 FEET EAST
OF A WITNESS POST, INSIDE A 4 INCH PVC PIPE WITH
SCREW PLUG 1 INCH ABOVE GROUND (ELEVATION =
2468.07). ALSO SHOWN ON HIGHWAY 69 / POTRERO BLVD.
INTERCHANGE STATIC GPS PROJECT CONTROL DIAGRAM
AND IDENTIFIED THEREON AS 3538 BM D33474 WHEN
THE PUBLISHED ELEVATION = 2468.07 IS CORRECTED WITH
A MEASURED ELEVATION = 2468.01, USED HEREON.
ELEV. 2468.01, (NVD '88), (STAMPED Q 1311 1978)

BY	MARK	DESCRIPTION	APPR.	DATE
ENGINEER		REVISIONS	CITY	

Kimley»Horn
401 B Street, Suite 600, San Diego, CA 92101
Phone: (619) 234-9411
WWW.KIMLEY-HORN.COM

Sam McWhorter
SAM L. MCWHORTER
R.C.E. 61788 8/23/2021

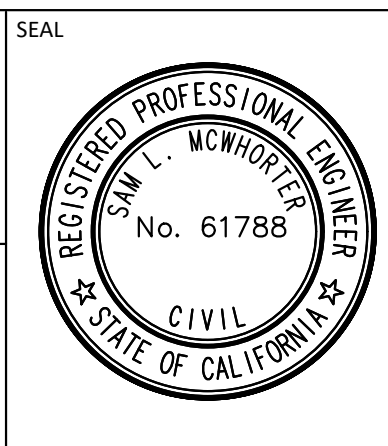

DESIGN BY:
SLM
DRAWN BY:
RC/SW
CHECKED BY:
TW/SS
SCALE:
DATE:
JOB NUMBER:
195284001



Reviewed By: _____ Date: _____
Staff Engineer

Recommended for Approval By: *[Signature]* Date: 11/19/2021
Administrative Engineer

Approved By: *[Signature]* Date: 11/23/2021
City Engineer/Director of Public Works


CITY OF BEAUMONT, PUBLIC WORKS DEPARTMENT
ENGINEERING DIVISION

CITY OF BEAUMONT, CALIFORNIA
IMPROVEMENT PLANS FOR:
**BEAUMONT CROSSROADS
LIFT STATION**


DETAILS

SHEET
10
OF 38 SHEETS
FILE NO:
3387


Plotted By: \\v\m\h\m\ Sam Sheet Set: BEAUMONT LIFT STATION Layout: DT-01 October 20, 2021 10:52:54am K:\ISND_WATER\195284001 Beaumont Lift Station\Design\Plan Sheets - 2020\DELTA SET\195284001 - .ADT.dwg

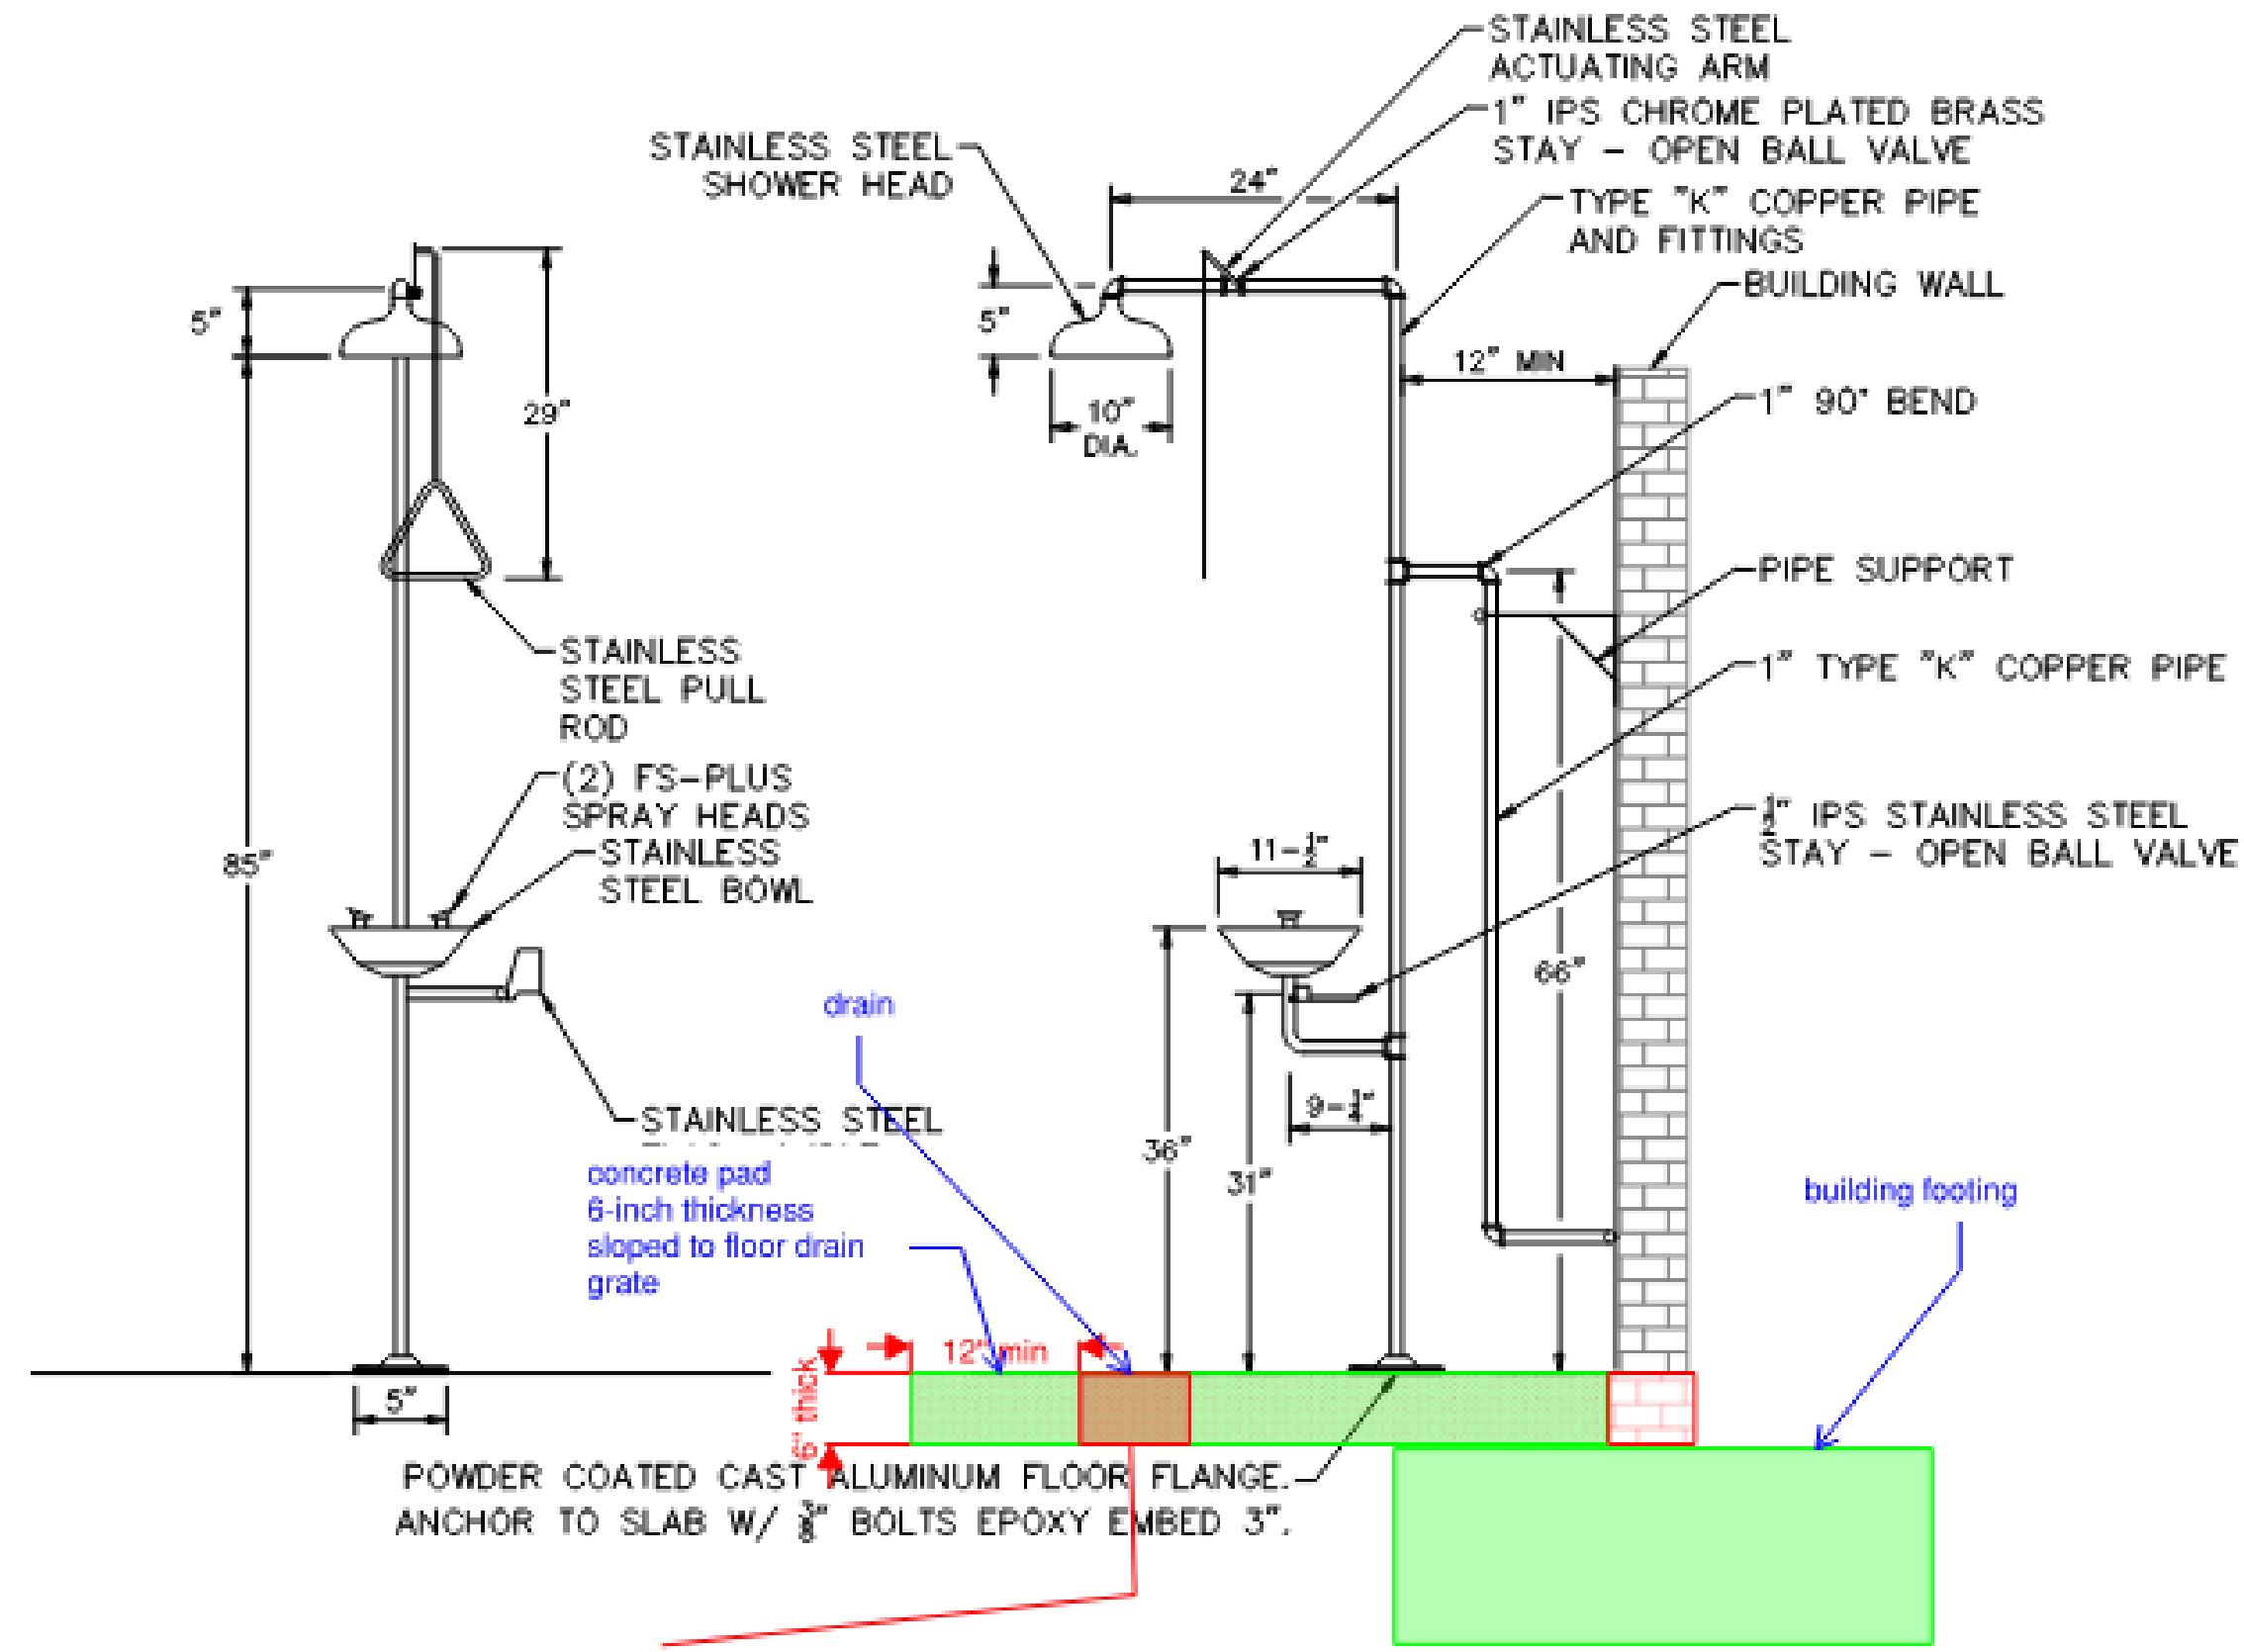


A COMBINATION EMERGENCY EYE WASH AND SHOWER STATION
NOT TO SCALE

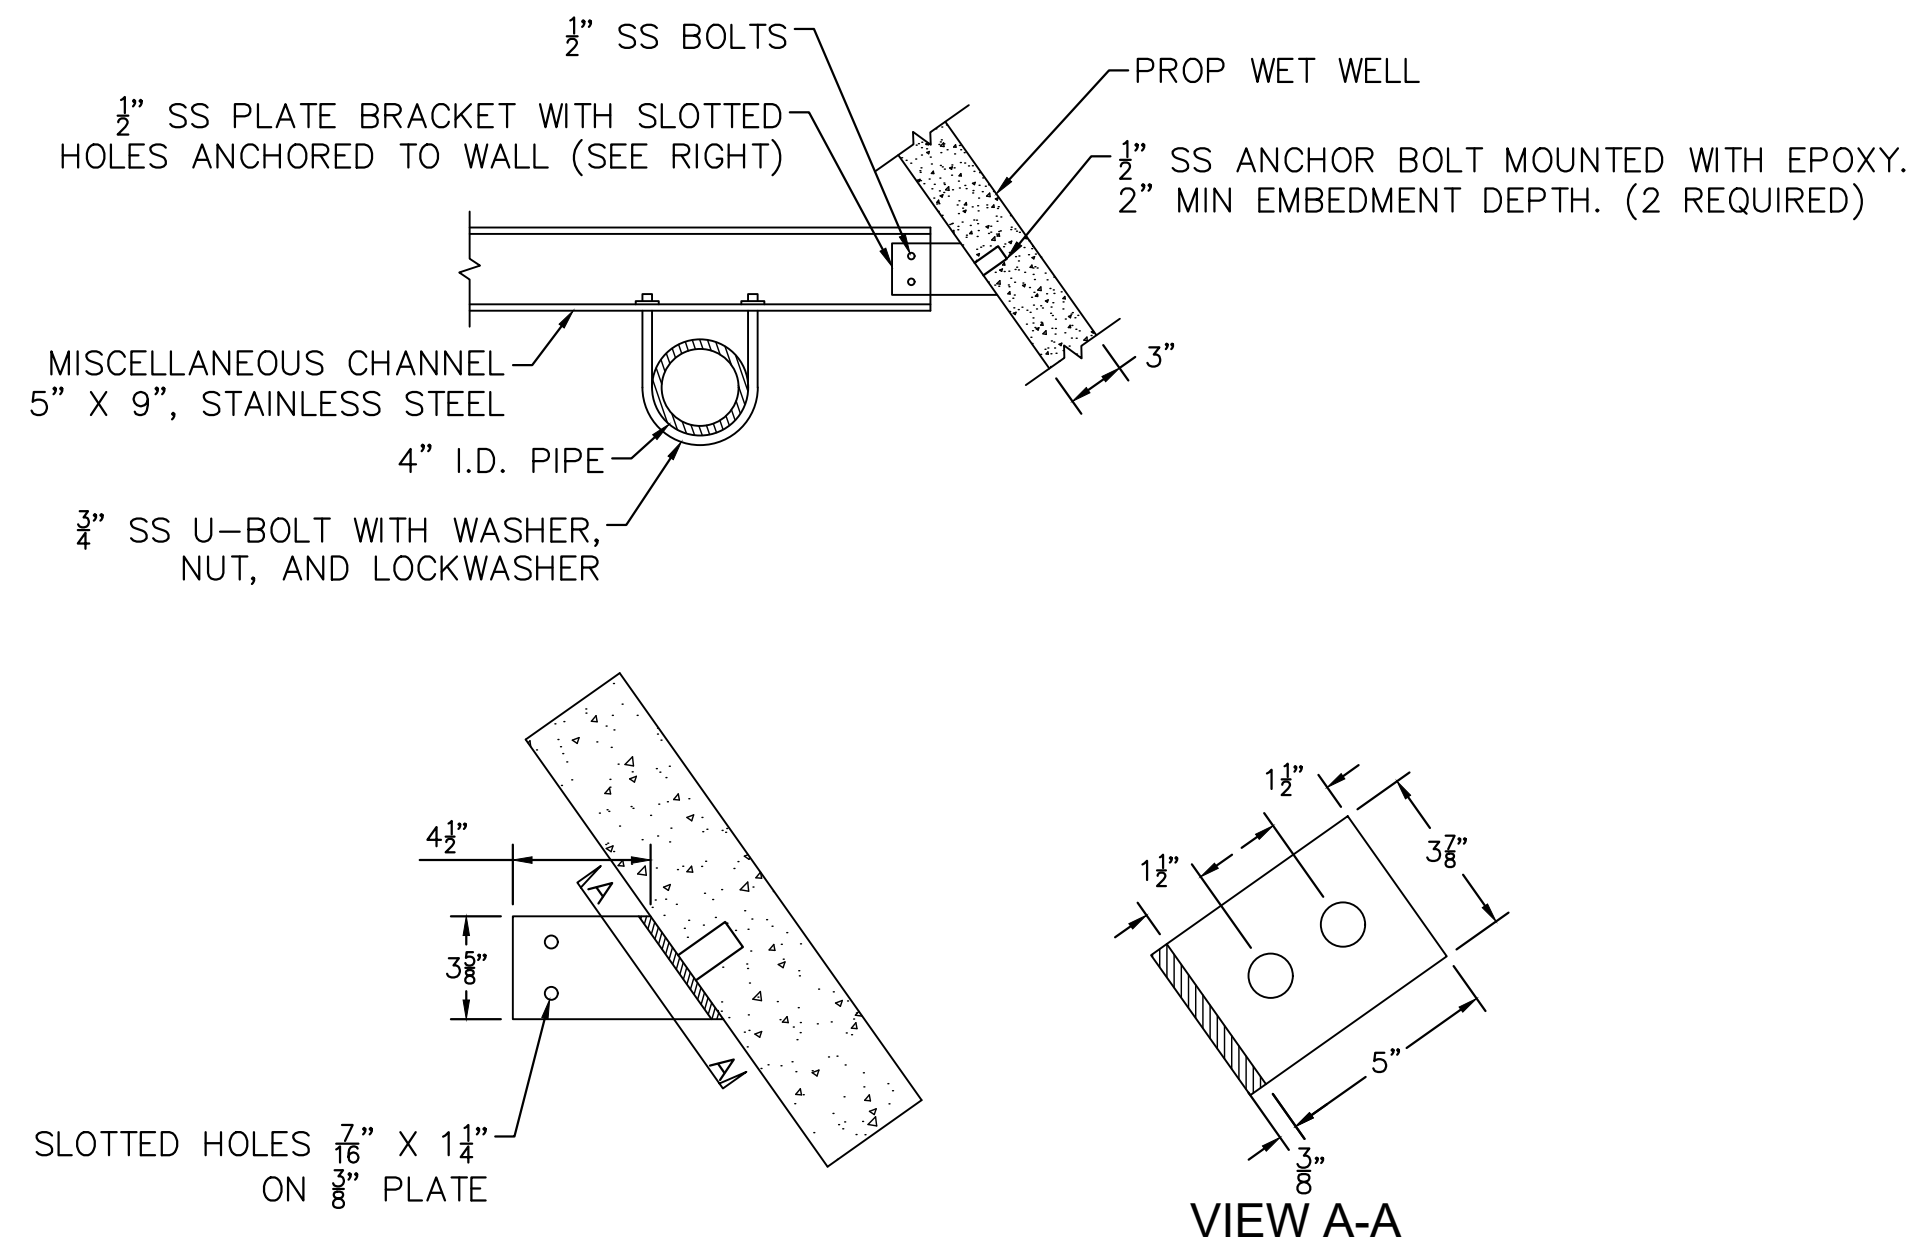


B STAINLESS STEEL SUPPORT
NOT TO SCALE

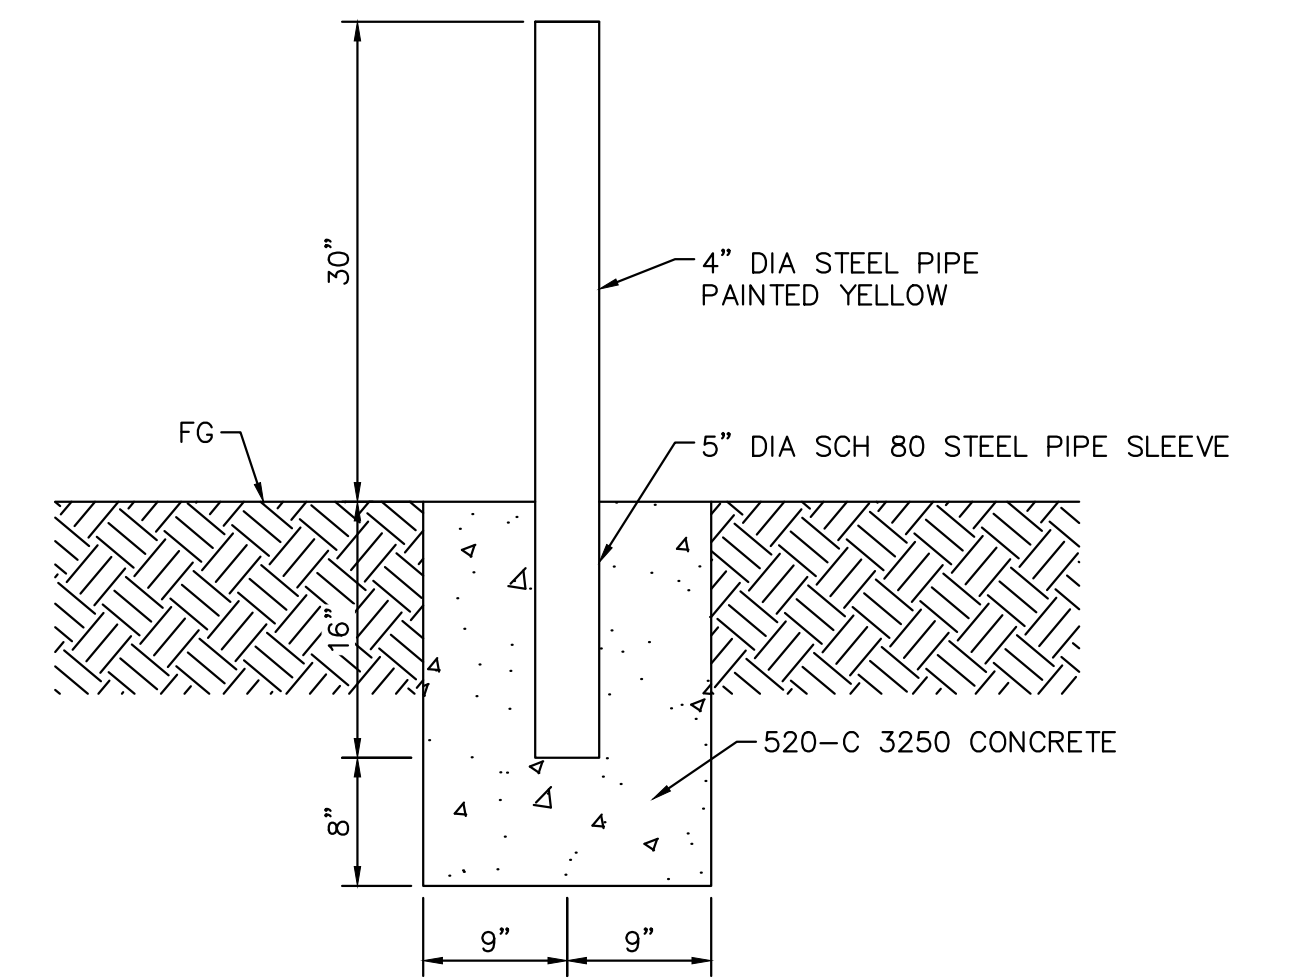

C BOLLARD SECTION DETAIL
NOT TO SCALE

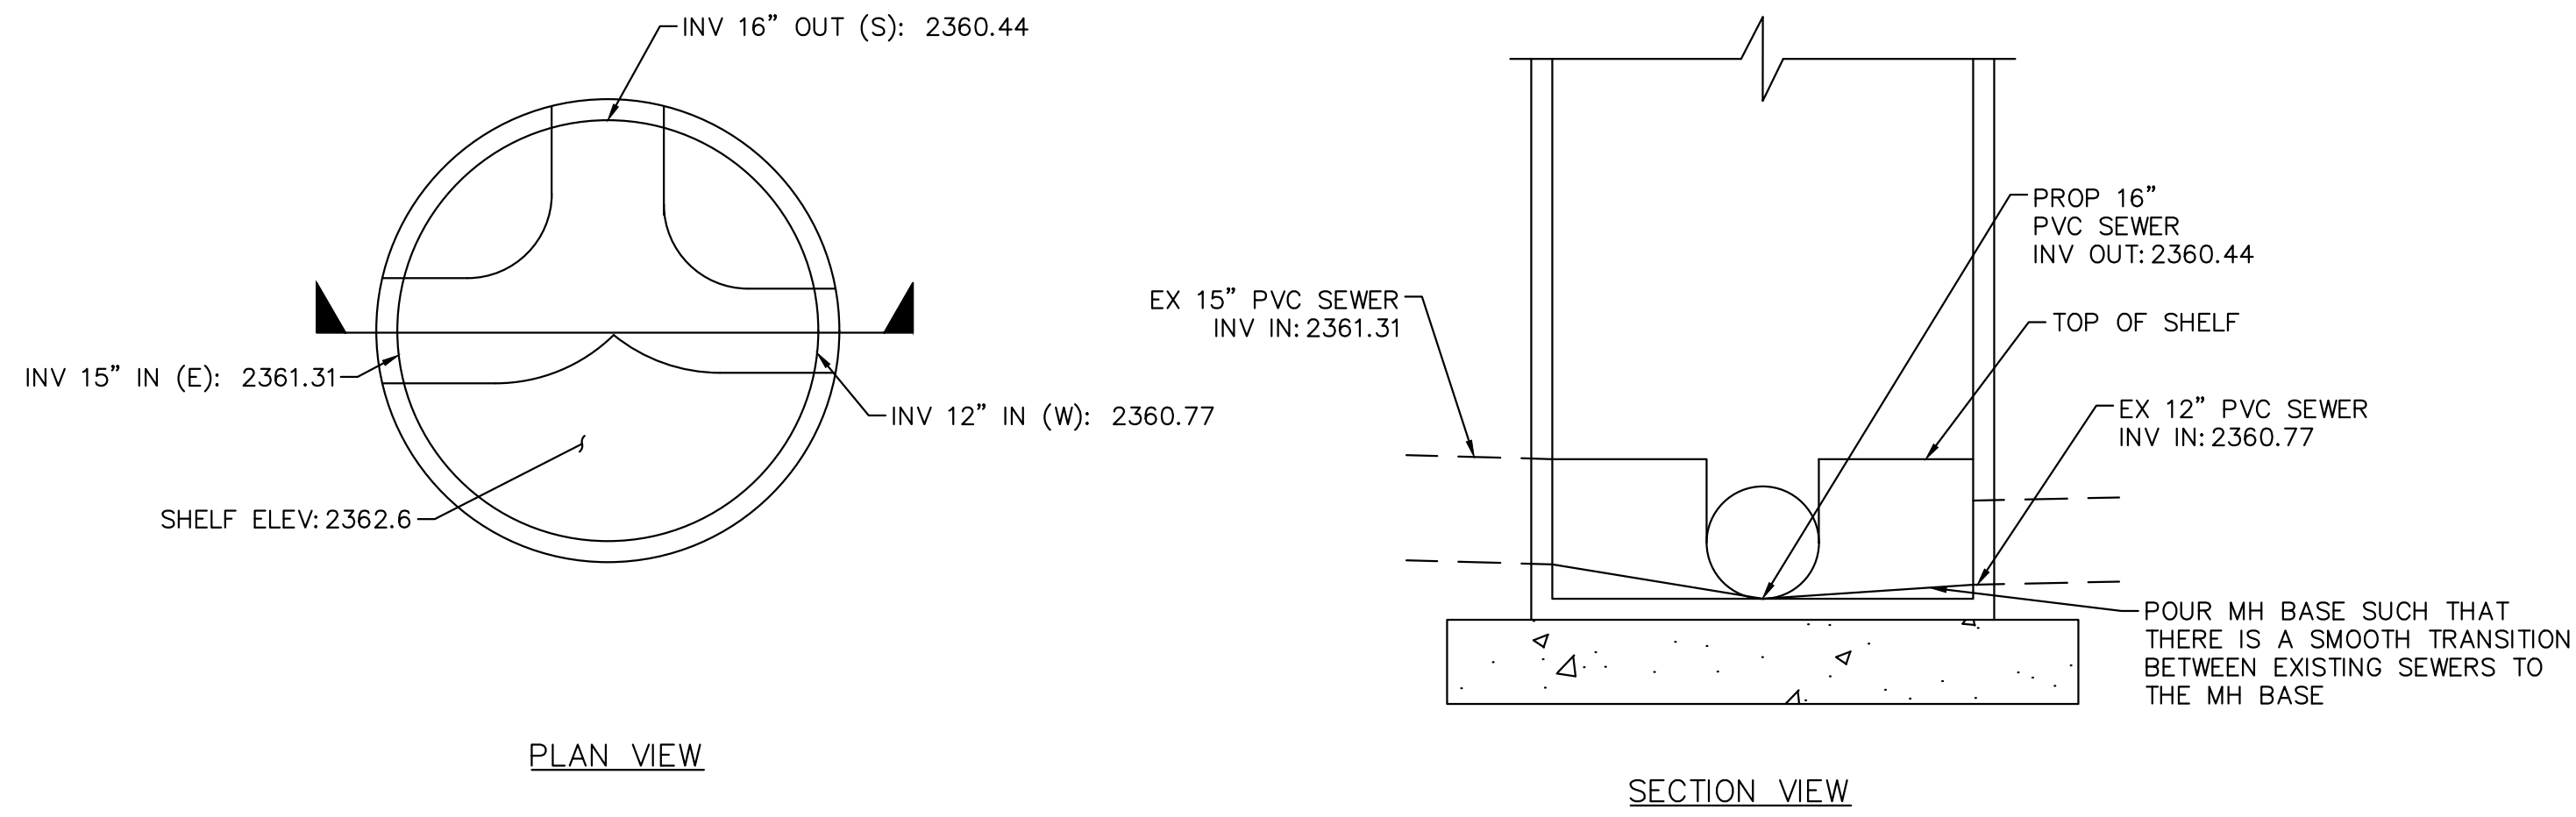


D PROPOSED MANHOLE SHELF
SCALE: 1" = 2'

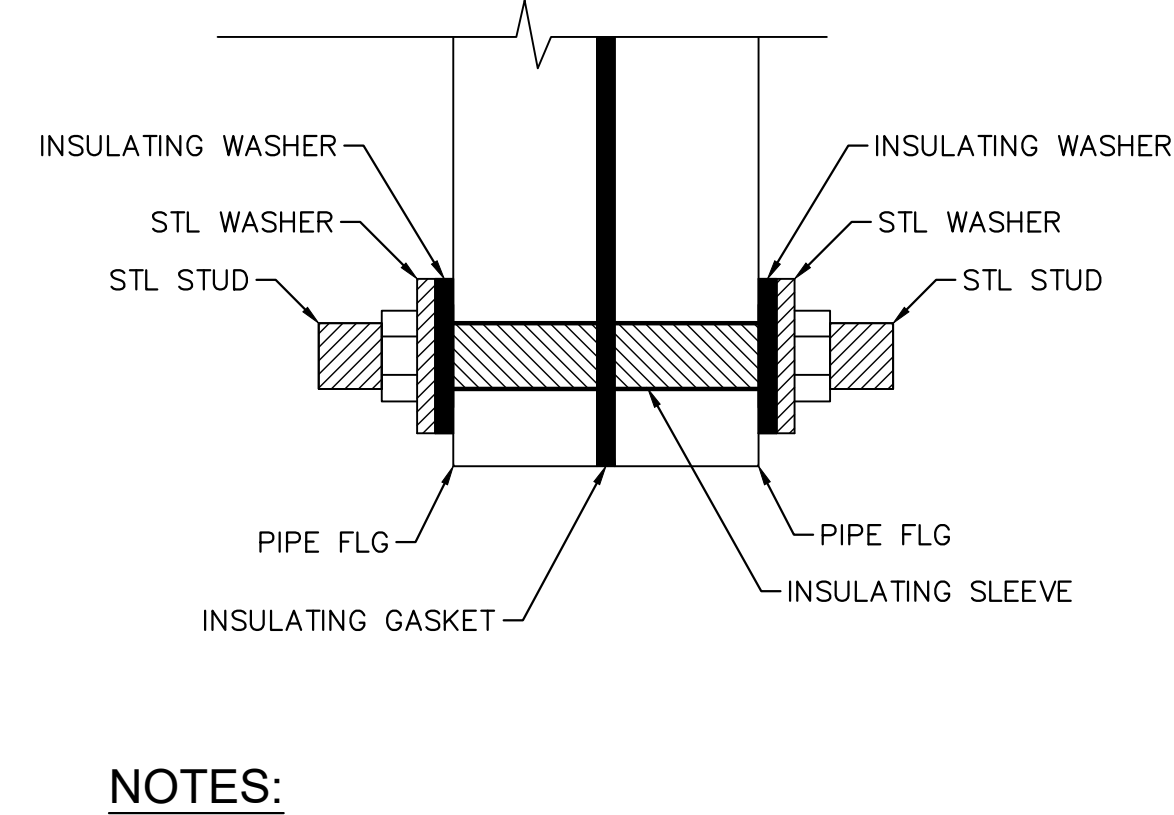


NOTES:
1. FULL LENGTH INSULATING SLEEVES REQUIRED AT ALL THRU-FLANGE BOLTS OR STUDS. INSULATING SLEEVES MUST EXTEND THROUGH THE RESTRAINING FLANGE, BOTH PIPE FLANGES, THE INSULATING GASKET, AND TWO INSULATING WASHERS.

E INSULATING FLANGE KIT
NOT TO SCALE

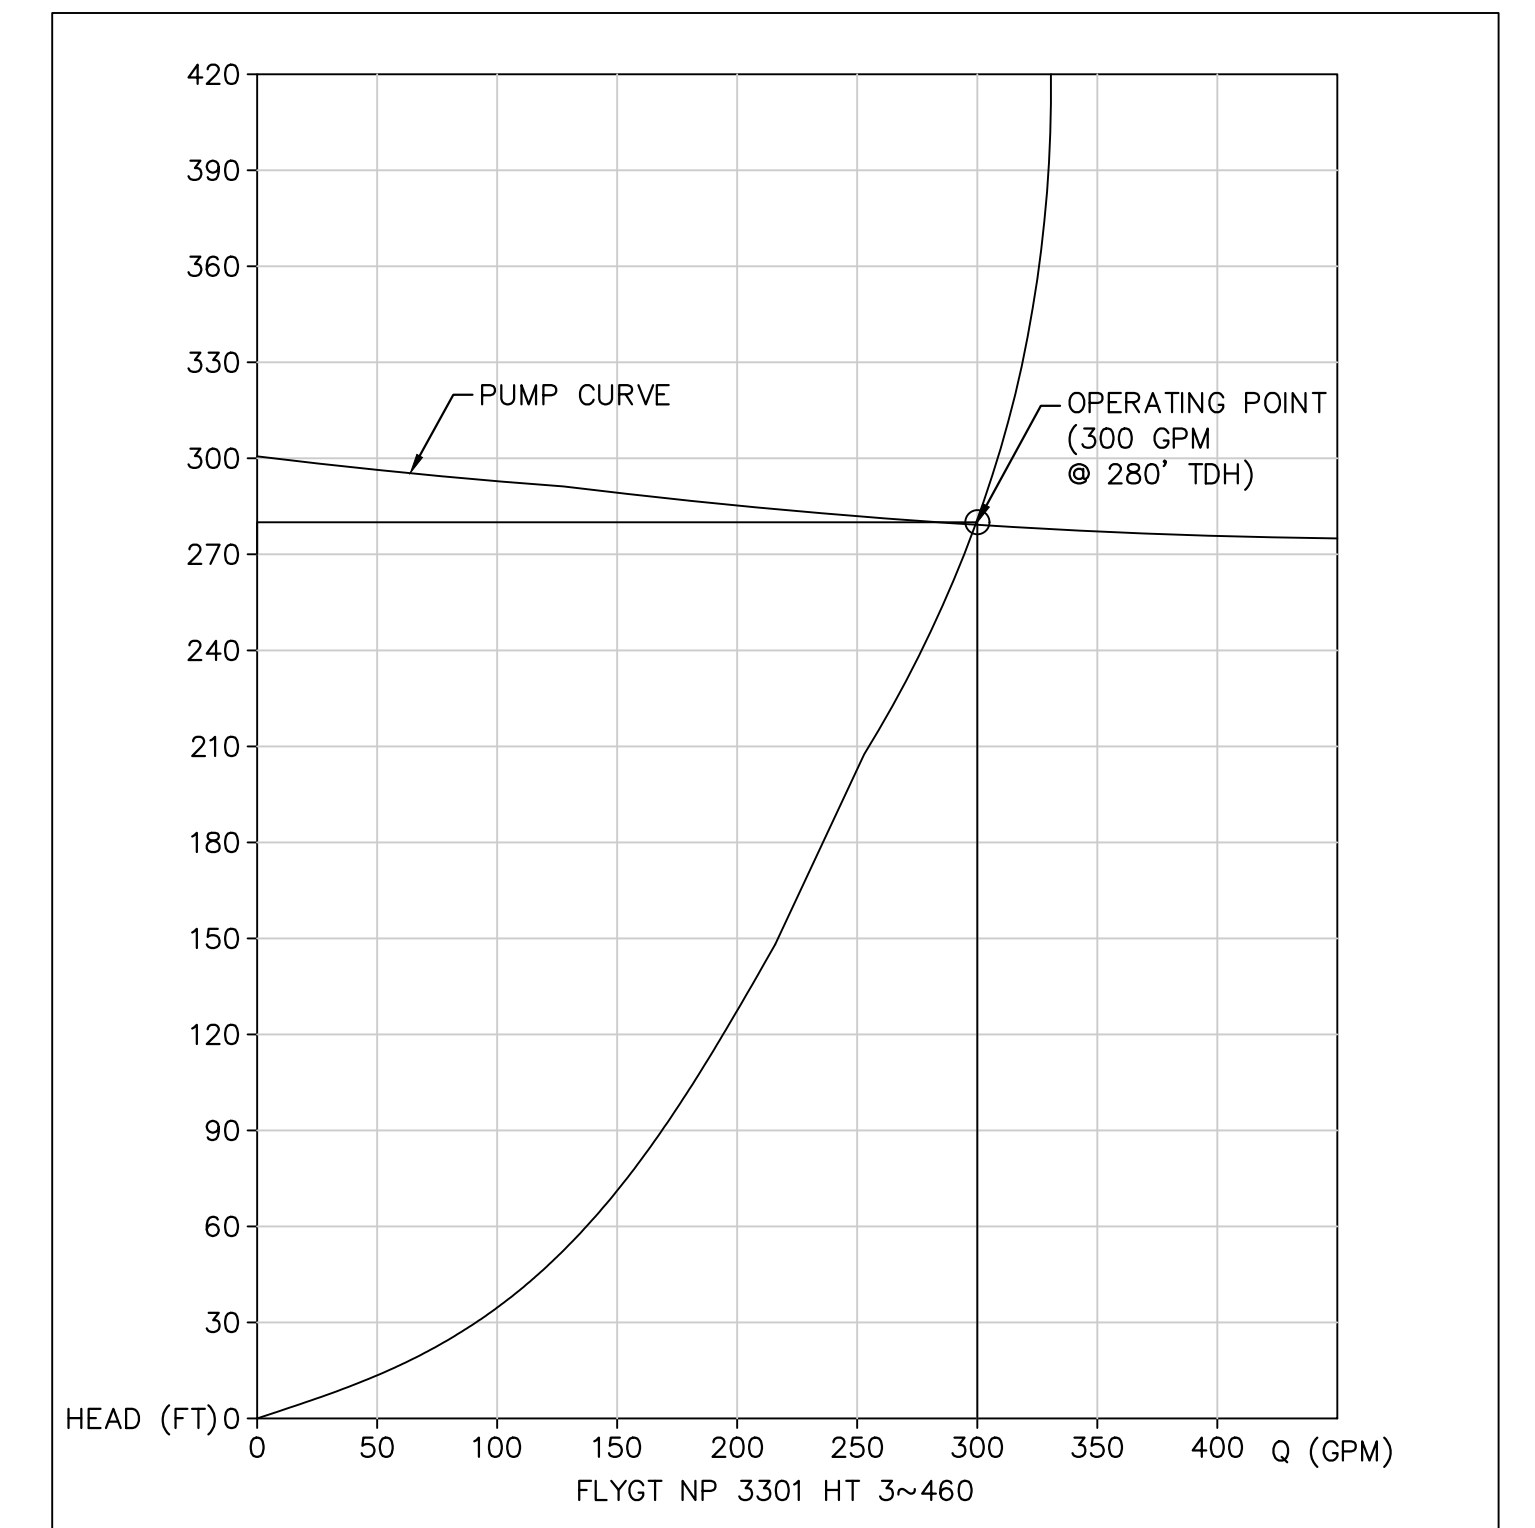

F PUMP CURVE
NOT TO SCALE

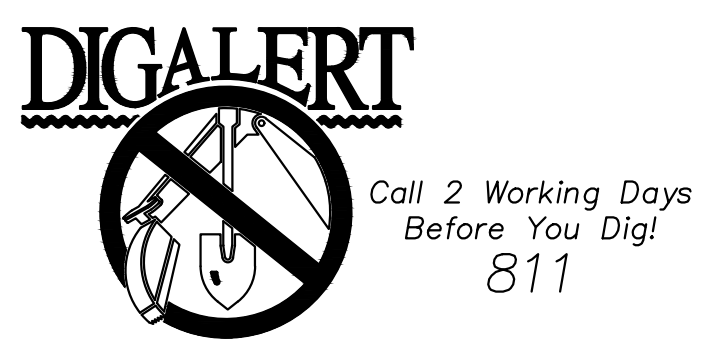


BENCHMARK:
NATIONAL GEODETIC SURVEY BENCHMARK NO. 1311
1.4 MILES WEST OF BEAUMONT ON INTERSTATE 10 TO SAN TIMOTEO CANYON NEAR FRONTAGE ROAD ON SOUTH(WEST) SIDE OF INTERSTATE 10, 0.1 MILES SOUTHWEST ALONG FRONTAGE ROAD, SOUTH ACROSS THE ROAD FROM A GUY POLE 25.9 FEET SOUTH OF THE CENTERLINE OF FRONTAGE ROAD, 1.8 FEET WEST OF POWERPOLE AND 1.8 FEET EAST OF A WITNESS POST, INSIDE A 4 INCH PVC PIPE WITH SCREW PLUG 1 INCH ABOVE GROUND (ELEVATION = 2468.07). ALSO SHOWN ON HIGHWAY 69 / POTRERO BLVD. INTERCHANGE STATIC GPS PROJECT CONTROL DIAGRAM AND IDENTIFIED THEREON AS 3538 BM D3474 WHEREIN THE PUBLISHED ELEVATION = 2468.07 IS CORRECTED WITH A MEASURED ELEVATION = 2468.01, USED HEREON.
ELEV. 2468.01, (NVD '88), (STAMPED Q 1311 1978)

BY	MARK	DESCRIPTION	APPR.	DATE
ENGINEER		REVISIONS	CITY	

Kimley»Horn
401 B Street, Suite 600, San Diego, CA 92101
Phone: (619) 234-9411
WWW.KIMLEY-HORN.COM

Sam McWhorter
SAM L. MCWHORTER
R.C.E. 61788
8/23/2021

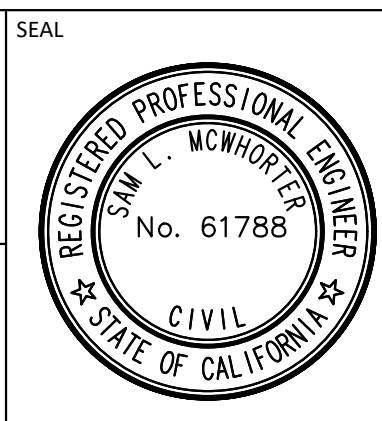

DESIGN BY: SLM
DRAWN BY: RC/SW
CHECKED BY: TW/SS
SCALE:
DATE:
JOB NUMBER: 195284001


Reviewed By: _____ Date: _____
Staff Engineer
Recommended for Approval By: *[Signature]* Date: 11/19/2021
Administrative Engineer
Approved By: *[Signature]* Date: 11/23/2021
City Engineer/Director of Public Works

CITY OF BEAUMONT, PUBLIC WORKS DEPARTMENT
ENGINEERING DIVISION
550E 6th St
Beaumont, CA 92223
TEL: (951) 769-8520 FAX: (951) 769-8526



CITY OF BEAUMONT, CALIFORNIA
IMPROVEMENT PLANS FOR:
**BEAUMONT CROSSROADS
LIFT STATION**
DETAILS

SHEET
11
OF 38 SHEETS
FILE NO:
3387

Plotted By: \mwhorter, Sam Sheet: S01 BEAUMONT LIFT STATION Design/Plan Sheets - 2020 DELTA SET 1195284001 - .ADT.dwg 10/22/2021 10:52:07am K:\BND_WATER\195284001 Beaumont Lift Station\Design\Plan Sheets - 2020 DELTA SET 1195284001 - .ADT.dwg

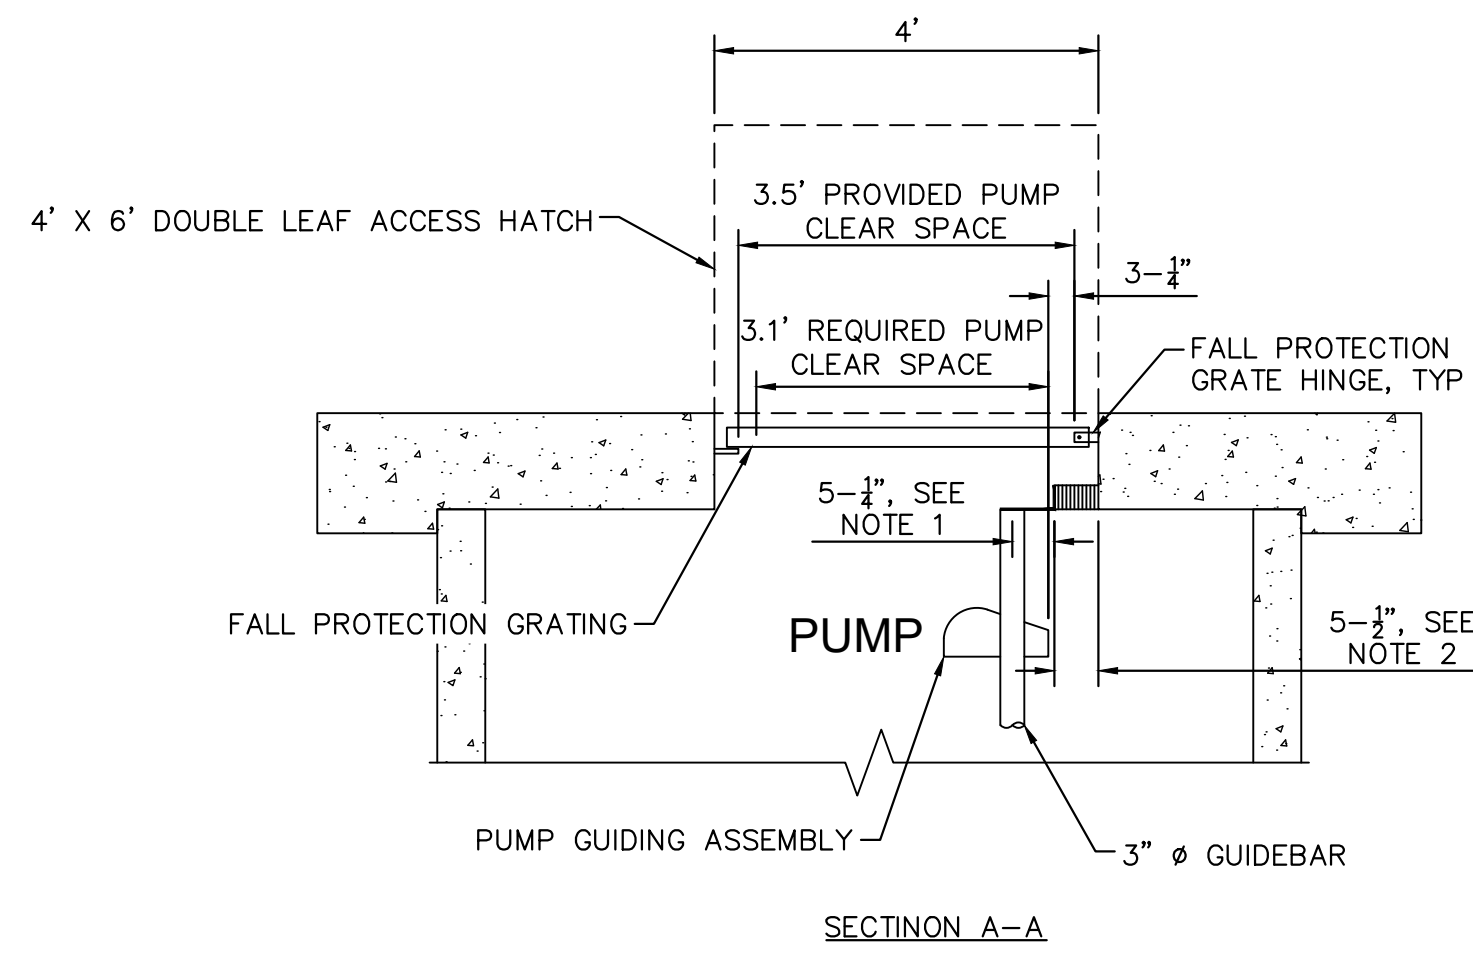


- NOTES:
- REFERENCE LINE TO CENTER OF GUIDE BAR PER FLYGT NP 3202 SH 3~273 DIMENSIONAL DRAWING.
 - PROVIDE 11 1/2" 316 STAINLESS STEEL SPACERS TO ACHIEVE A 3-1/4" CLEARANCE BETWEEN THE EDGE OF THE PUMP GUIDING ASSEMBLY AND THE EDGE OF THE FALL PROTECTION GRATE HINGE. CONTRACTOR SHALL VERIFY ALL DIMENSIONS PRIOR TO INSTALLATION.

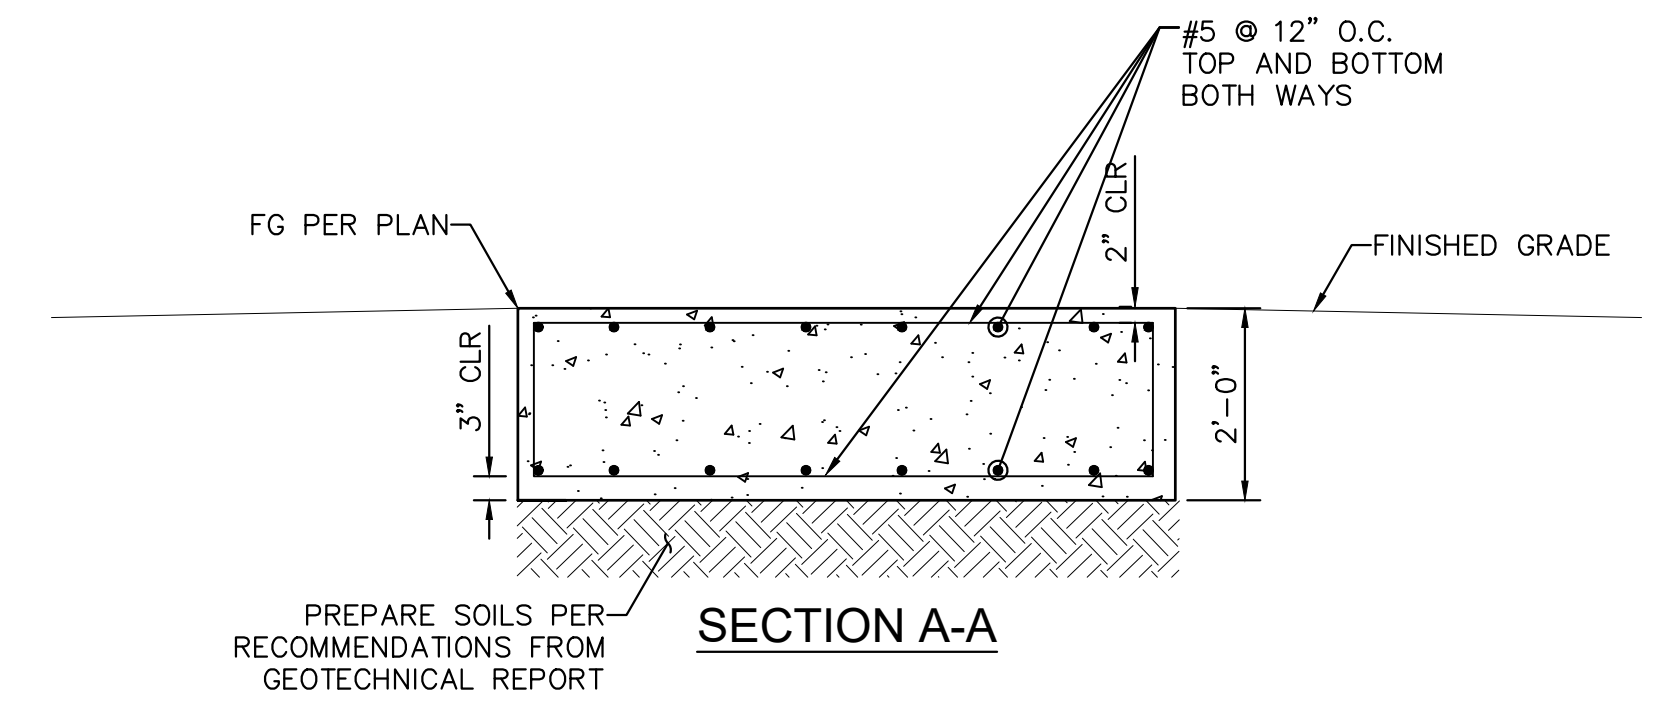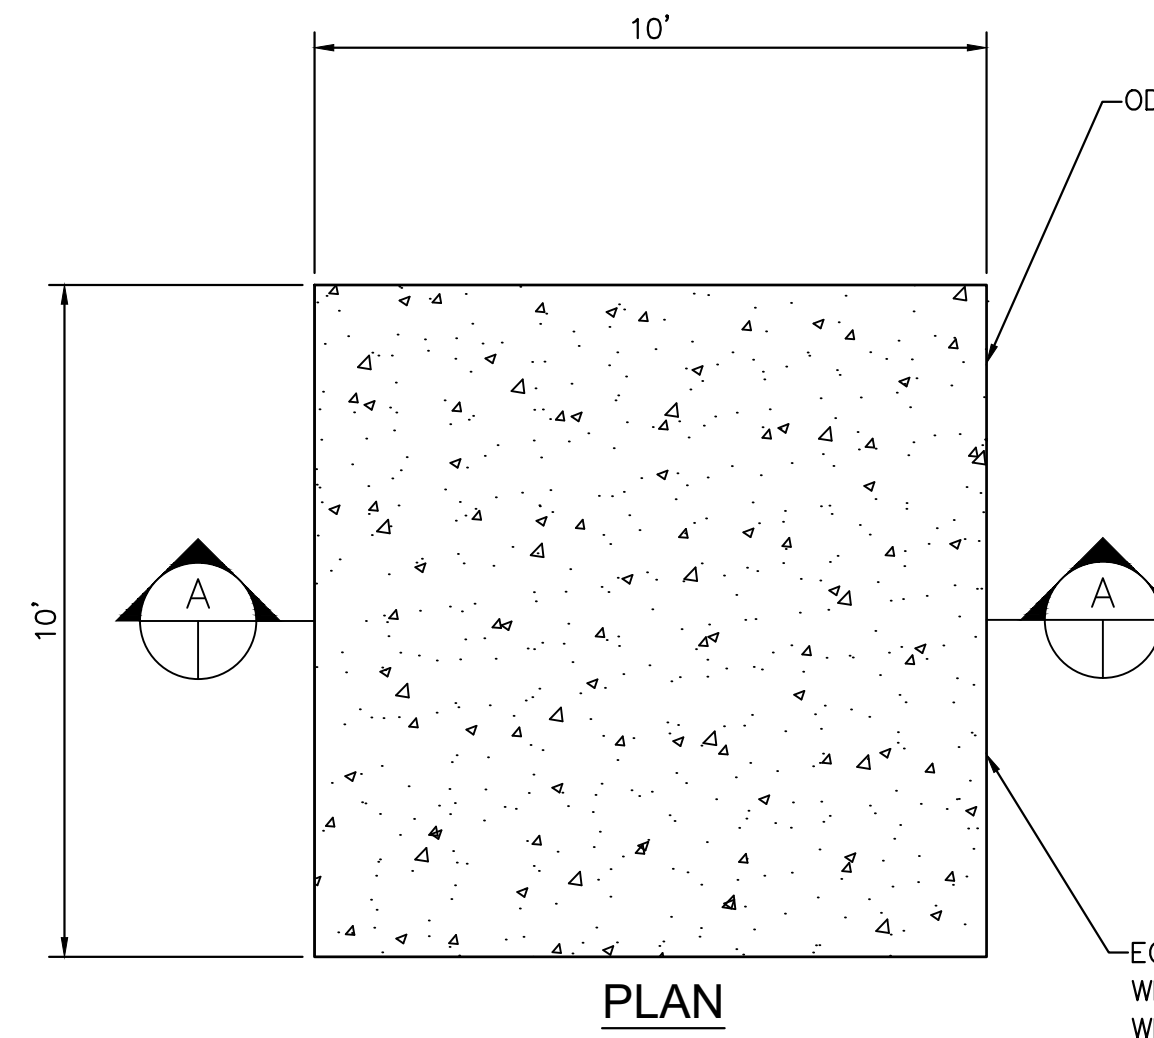

NOTE


- FOR ODOR CONTROL PAD ANCHORAGE TO FOUNDATION USE 3/8" HILTI BOLT TZ EXPANSION ANCHORS WITH 4-3/4" MINIMUM EMBEDMENT IN 5-3/4" DEEP HOLES.
- FOLLOW MANUFACTURER'S RECOMMENDATION FOR INSTALLATION.
- CONTRACTOR TO VERIFY GENERATOR WILL FIT WITHIN DIMENSIONS INDICATED WITH 12" MINIMUM CLEARANCE ON ALL SIDES. NOTIFY ENGINEER OF ANY CONFLICTS.
- DESIGN SPECIFICATIONS:
 REINFORCED CONCRETE
 $F_c = 3,000 \text{ psi}$
 $F_y = 60,000 \text{ psi}$

(B) ODOR CONTROL PAD
NOT TO SCALE

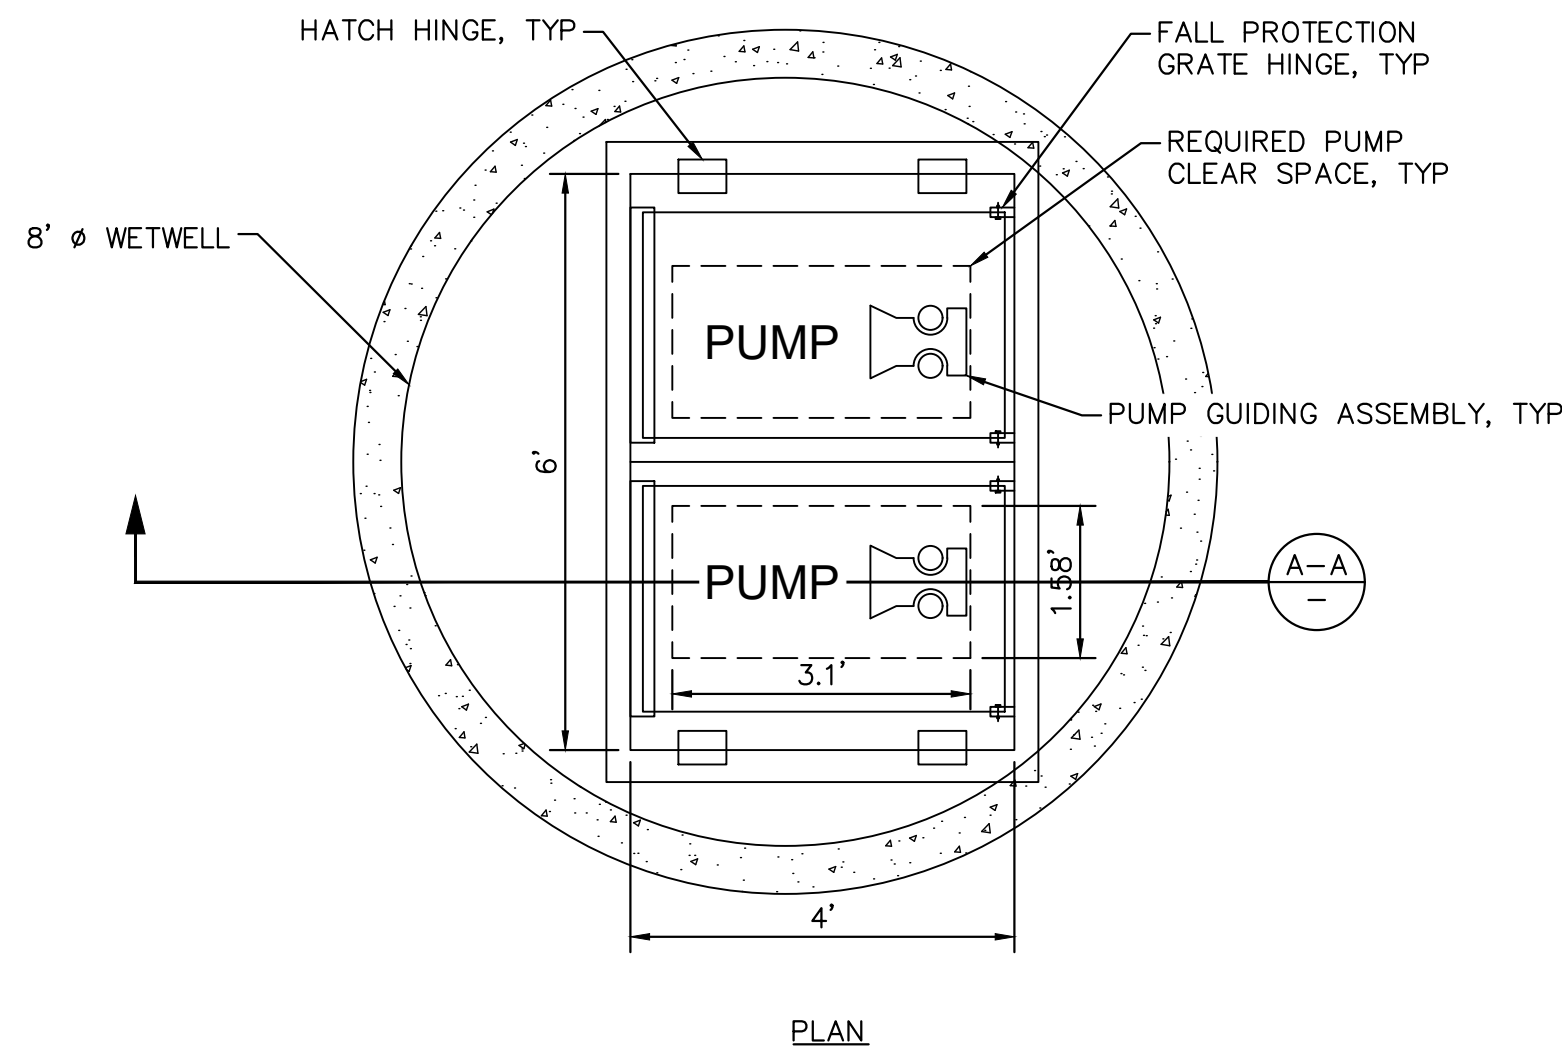


(A) MODIFIED PUMP GUIDERAIL
NOT TO SCALE

Used Detail C on sheet 12 instead of Detail 4 on sheet

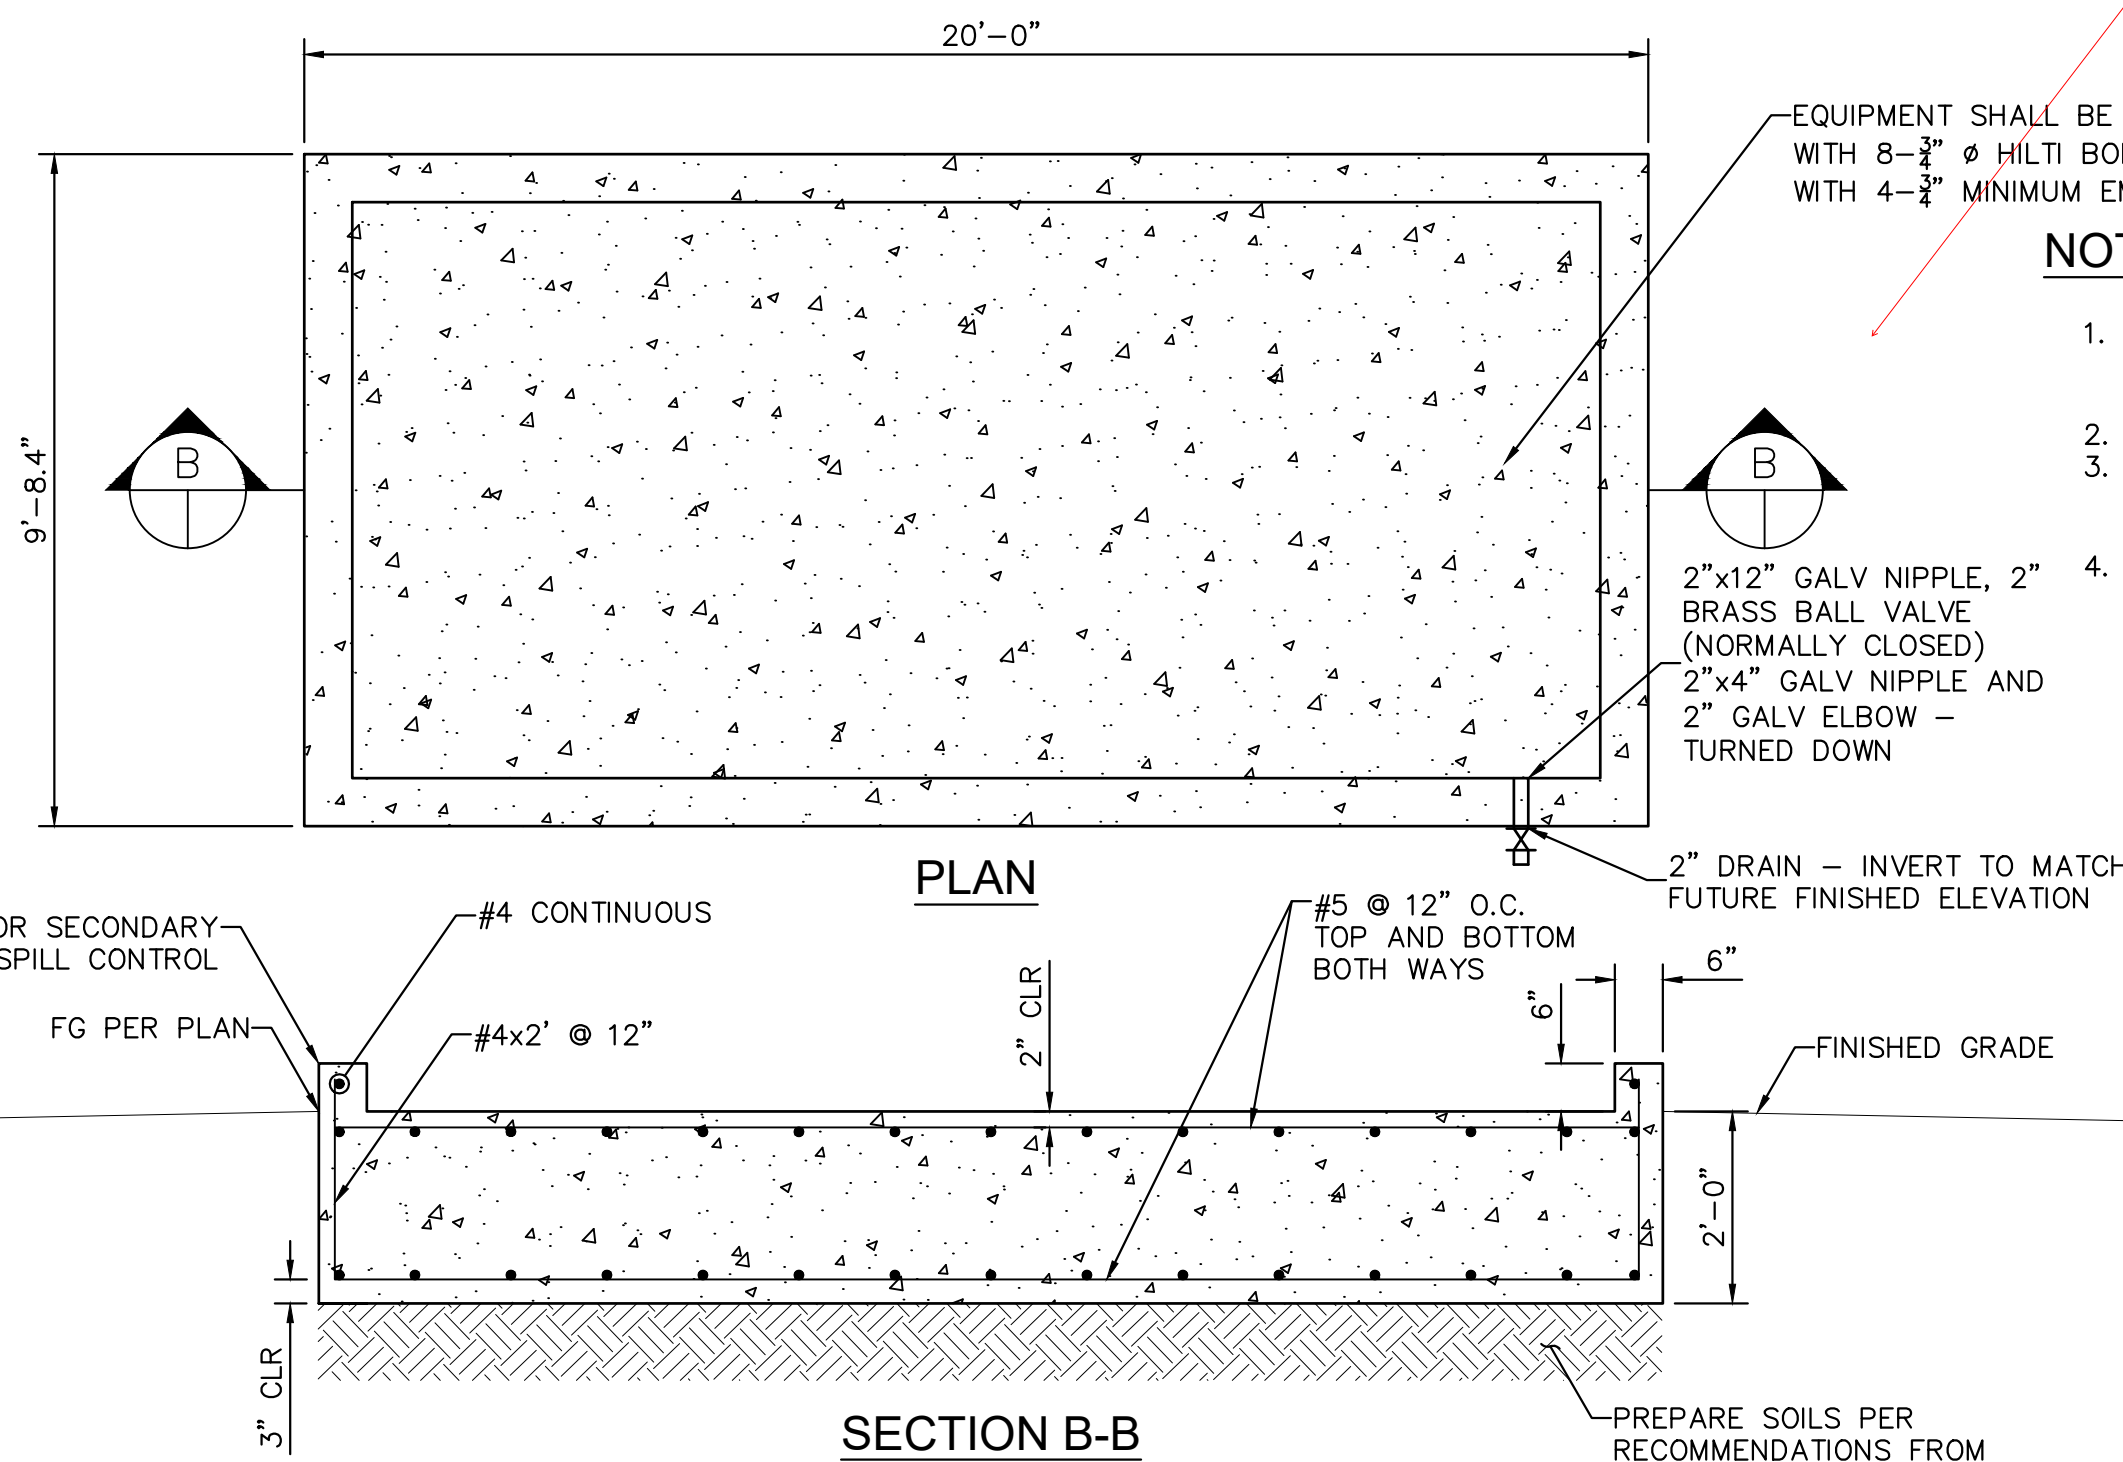


NOTE

- FOR GENERATOR ANCHORAGE TO FOUNDATION USE 3/8" HILTI BOLT TZ EXPANSION ANCHORS WITH 4-3/4" MINIMUM EMBEDMENT IN 5-3/4" DEEP HOLES.
- FOLLOW MANUFACTURER'S RECOMMENDATION FOR INSTALLATION.
- CONTRACTOR TO VERIFY GENERATOR WILL FIT WITHIN DIMENSIONS INDICATED WITHIN 12" MINIMUM CLEARANCE ON ALL SIDES. NOTIFY ENGINEER OF ANY CONFLICTS.
- DESIGN SPECIFICATIONS:
 REINFORCED CONCRETE
 $F_c = 3,000 \text{ psi}$
 $F_y = 60,000 \text{ psi}$

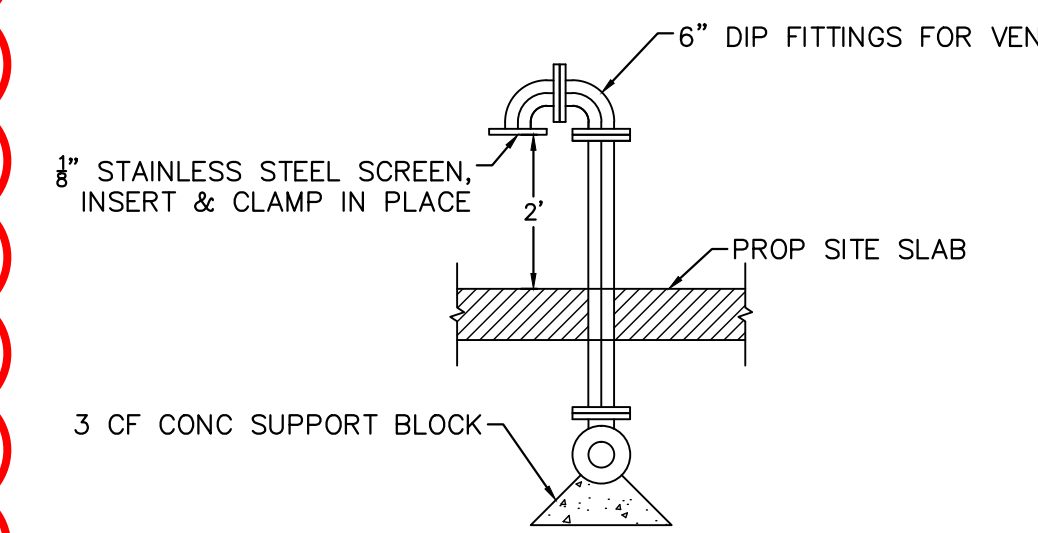


(D) WET WELL VENT
NOT TO SCALE

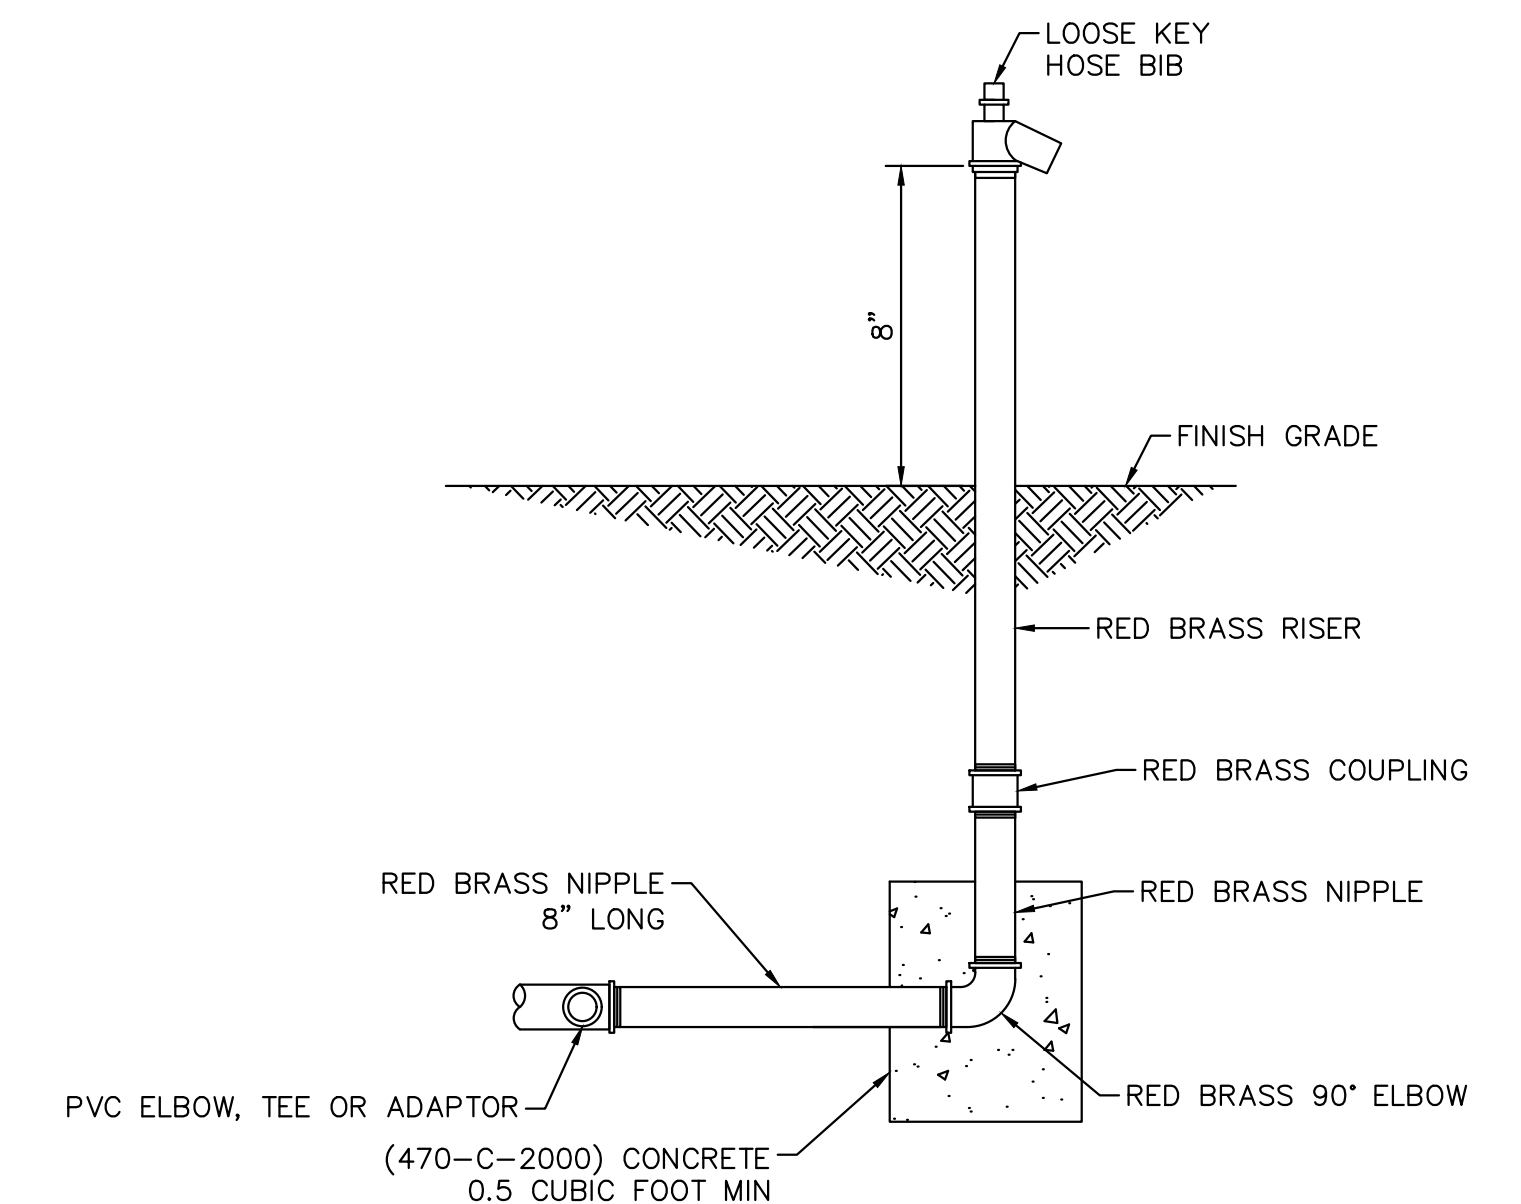

(E) HOSE BIB
NOT TO SCALE

(C) ELECTRIC GENERATOR PAD
NOT TO SCALE

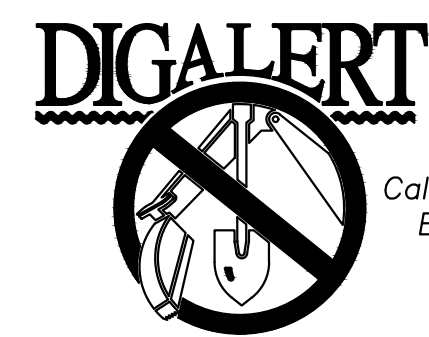


Call 2 Working Days Before You Dig! 811

BENCHMARK
 NATIONAL GEODETIC SURVEY BENCHMARK NO. 13111
 1.4 MILES WEST OF BEAUMONT ON INTERSTATE 10 TO SAN TIMOTEO CANYON NEAR FRONTAGE ROAD ON SOUTH(WEST) SIDE OF INTERSTATE 10, 0.1 MILES SOUTHWEST ALONG FRONTAGE ROAD, SOUTH ACROSS THE ROAD FROM A GUY POLE 25.9 FEET SOUTH OF THE CENTERLINE OF FRONTAGE ROAD, 1.8 FEET WEST OF POWERPOLE AND 1.5 FEET EAST OF A WITNESS POST, INSIDE A 4 INCH PVC PIPE WITH SCREW PLUG 1 INCH ABOVE GROUND (ELEVATION = 2468.07). ALSO SHOWN ON HIGHWAY 60 / POTRERO BLVD. INTERCHANGE STATIC GPS PROJECT CONTROL DIAGRAM AND IDENTIFIED THEREON AS 3558 BM D3474 WHEN THE PUBLISHED ELEVATION = 2468.07 IS CORRECTED WITH A MEASURED ELEVATION = 2468.01, USED HEREON.
 ELEV. 2468.01, (NVD '88), (STAMPED Q 1311 1978)

BY	MARK	DESCRIPTION	APPR.	DATE
ENGINEER		REVISIONS		CITY

Kimley Horn
 401 B Street, Suite 600, San Diego, CA 92101
 Phone: (619) 234-9411
 WWW.KIMLEY-HORN.COM

Sam McWhorter
 SAM L. MCWHORTER
 R.C.E. 61788 8/23/2021

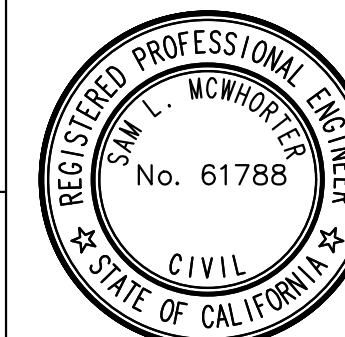

DESIGNED BY: SLM
 DRAWN BY: RC/SW
 CHECKED BY: TW/SS
 SCALE:
 DATE:
 JOB NUMBER: 195284001



Reviewed By: _____ Date: _____
 Staff Engineer

Recommended for Approval By: _____ Date: 11/19/2021
 Administrative Engineer


Approved By: _____ Date: 11/23/2021
 City Engineer/Director of Public Works

CITY OF BEAUMONT, PUBLIC WORKS DEPARTMENT
 ENGINEERING DIVISION


550E 6th St
 Beaumont, CA 92223
 TEL: (951) 789-8520 FAX: (951) 789-8528

CITY OF BEAUMONT, CALIFORNIA IMPROVEMENT PLANS FOR: BEAUMONT CROSSROADS LIFT STATION	SHEET 12 OF 38 SHEETS FILE NO: 3387
DETAILS	


Plotted By: V:\mwhorter, Sam, Sheet Set: BEAUMONT LIFT STATION, Layout: DT-03, October 20, 2021, 10:52:59am, K:\ISND_WATER\195284001_Beaumont Lift Station\Design\Plan Sheets - 2020\DELTA SET\195284001 - .ADT.dwg

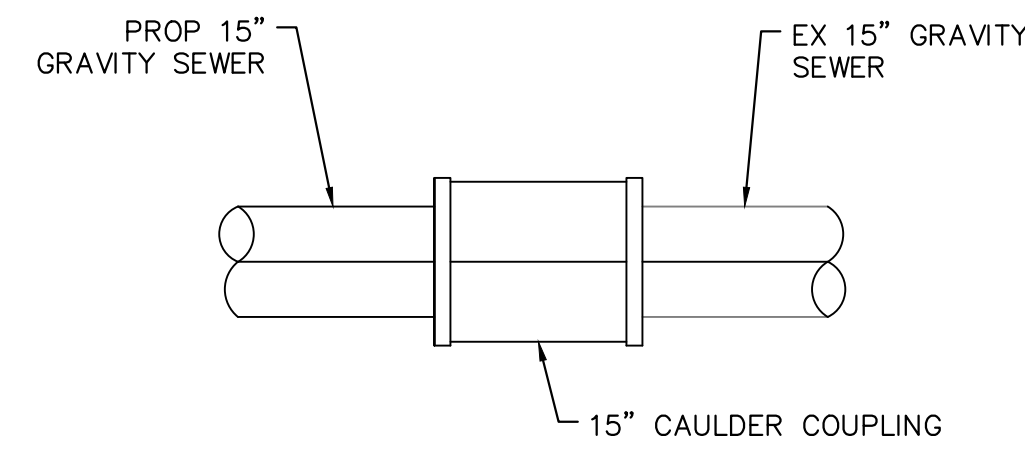


A CAULDER COUPLING
SCALE: 1" = 1'

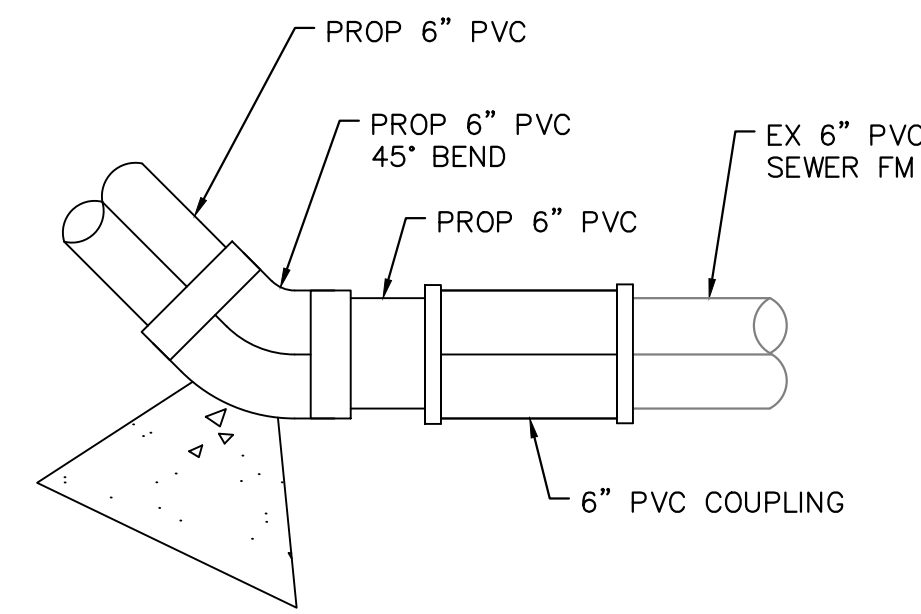

B PVC COUPLING
SCALE: 1" = 1'

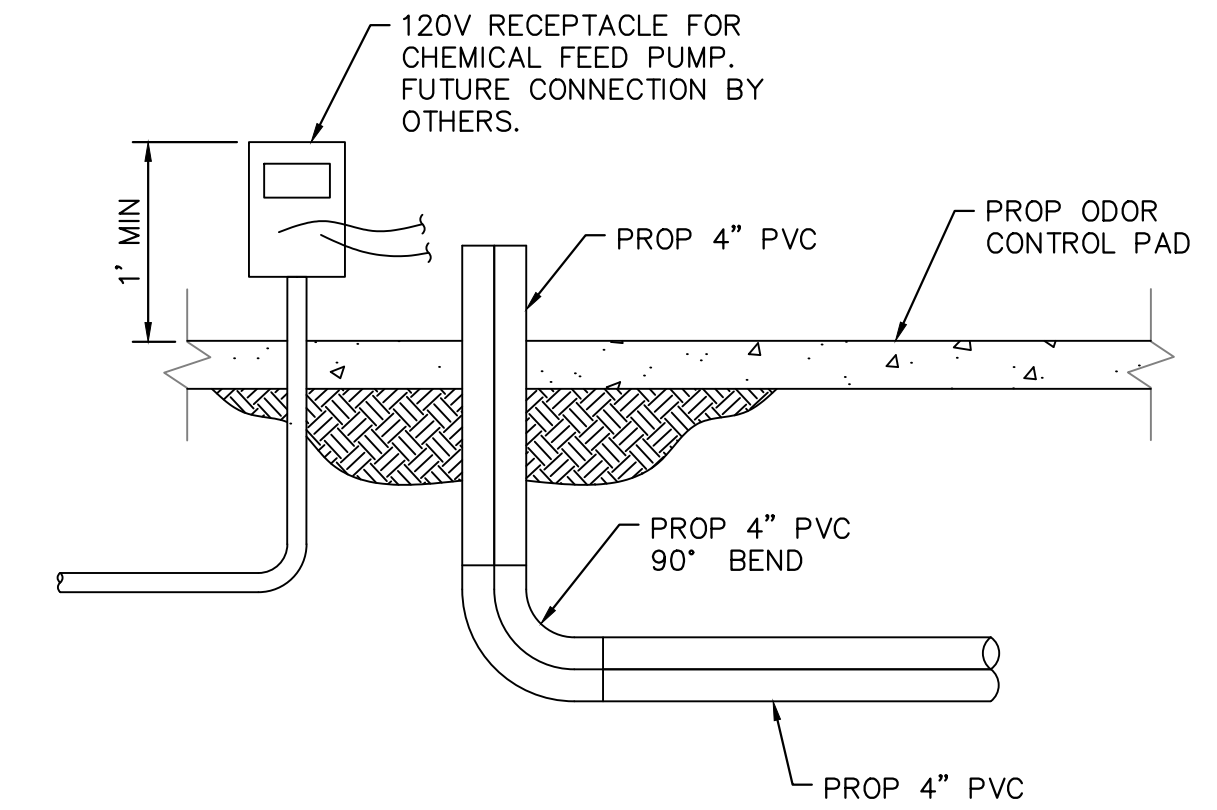

C CHEMICAL FEED PORT
SCALE: 1" = 1'

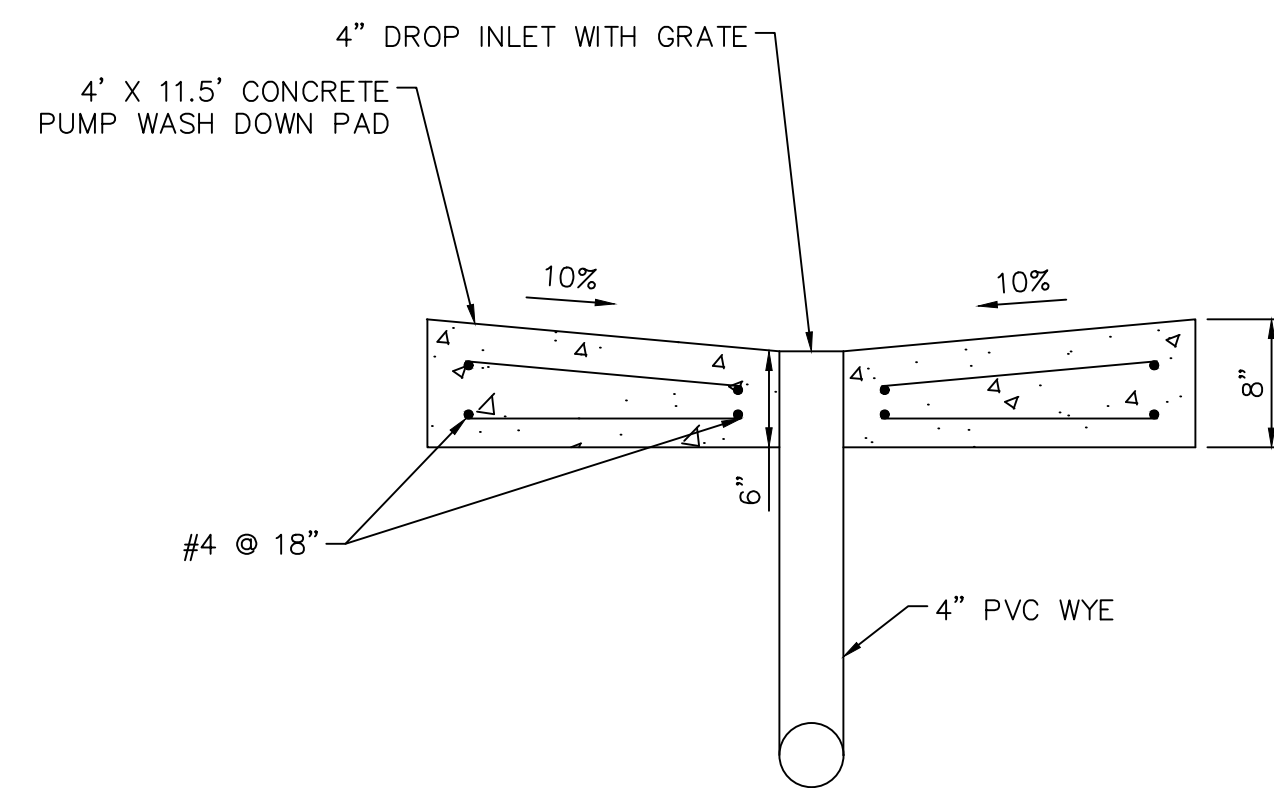

D PUMP WASH DOWN PAD
SCALE: 1" = 1'

Plotted By: \v\m\h\m\ Sam Sheet Set: BEAUMONT LIFT STATION Layout: DT-04 October 20, 2021 10:53:01 am K:\ISND_WATER\195284001 Beaumont Lift Station\Design\Plan Sheets - 2020\DELTA SET\195284001 - .ADT.dwg




BENCHMARK:
NATIONAL GEODETIC SURVEY BENCHMARK NO. Q 1311
1.4 MILES WEST OF BEAUMONT ON INTERSTATE 10 TO SAN TIMOTEO CANYON NEAR FRONTAGE ROAD ON SOUTH(WEST) SIDE OF INTERSTATE 10, 0.1 MILES SOUTHEAST ALONG FRONTAGE ROAD, SOUTH ACROSS THE ROAD FROM A GUY POLE 25.9 FEET SOUTH OF THE CENTERLINE OF FRONTAGE ROAD, 1.6 FEET WEST OF POWERPOLE AND 1.5 FEET EAST OF A WITNESS POST, INSIDE A 4 INCH PVC PIPE WITH SCREW PLUG 1 INCH ABOVE GROUND (ELEVATION = 2468.07). ALSO SHOWN ON HIGHWAY 69 // POTRERO BLVD. INTERCHANGE STATIC GPS PROJECT CONTROL DIAGRAM AND IDENTIFIED THEREON AS 3558 BM D33474 WHEN THE PUBLISHED ELEVATION = 2468.07 IS CORRECTED WITH A MEASURED ELEVATION = 2468.01, USED HEREON.
ELEV. 2468.01, (NVD '88), (STAMPED Q 1311 1978)

BY	MARK	DESCRIPTION	APPR.	DATE
ENGINEER		REVISIONS		CITY

Kimley»Horn
401 B Street, Suite 600, San Diego, CA 92101
Phone: (619) 234-9411
WWW.KIMLEY-HORN.COM

Sam McWhorter
SAM L. MCWHORTER
R.C.E. 61788 8/23/2021

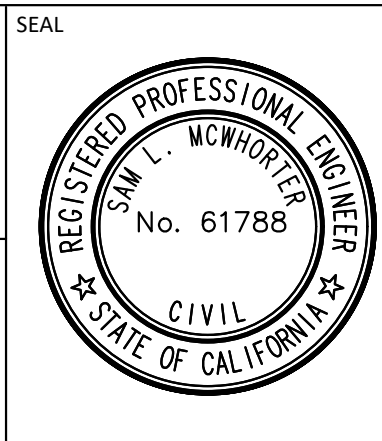

DESIGN BY: SLM
DRAWN BY:
RC/SW
CHECKED BY:
TW/SS
SCALE:
DATE:
JOB NUMBER:
195284001



Reviewed By: _____ Date: _____
Staff Engineer

Recommended for Approval By: *[Signature]* Date: 11/19/2021
Administrative Engineer

Approved By: *[Signature]* Date: 11/23/2021
City Engineer/Director of Public Works

CITY OF BEAUMONT, PUBLIC WORKS DEPARTMENT
ENGINEERING DIVISION

550E 6th St
Beaumont, CA 92223
TEL: (951) 769-8520 FAX: (951) 769-8526


CITY OF BEAUMONT, CALIFORNIA
IMPROVEMENT PLANS FOR:
**BEAUMONT CROSSROADS
LIFT STATION**

DETAILS

SHEET
13
OF 38 SHEETS
FILE NO:
3387

ELECTRICAL SYMBOLS


SINGLE LINE DIAGRAMS

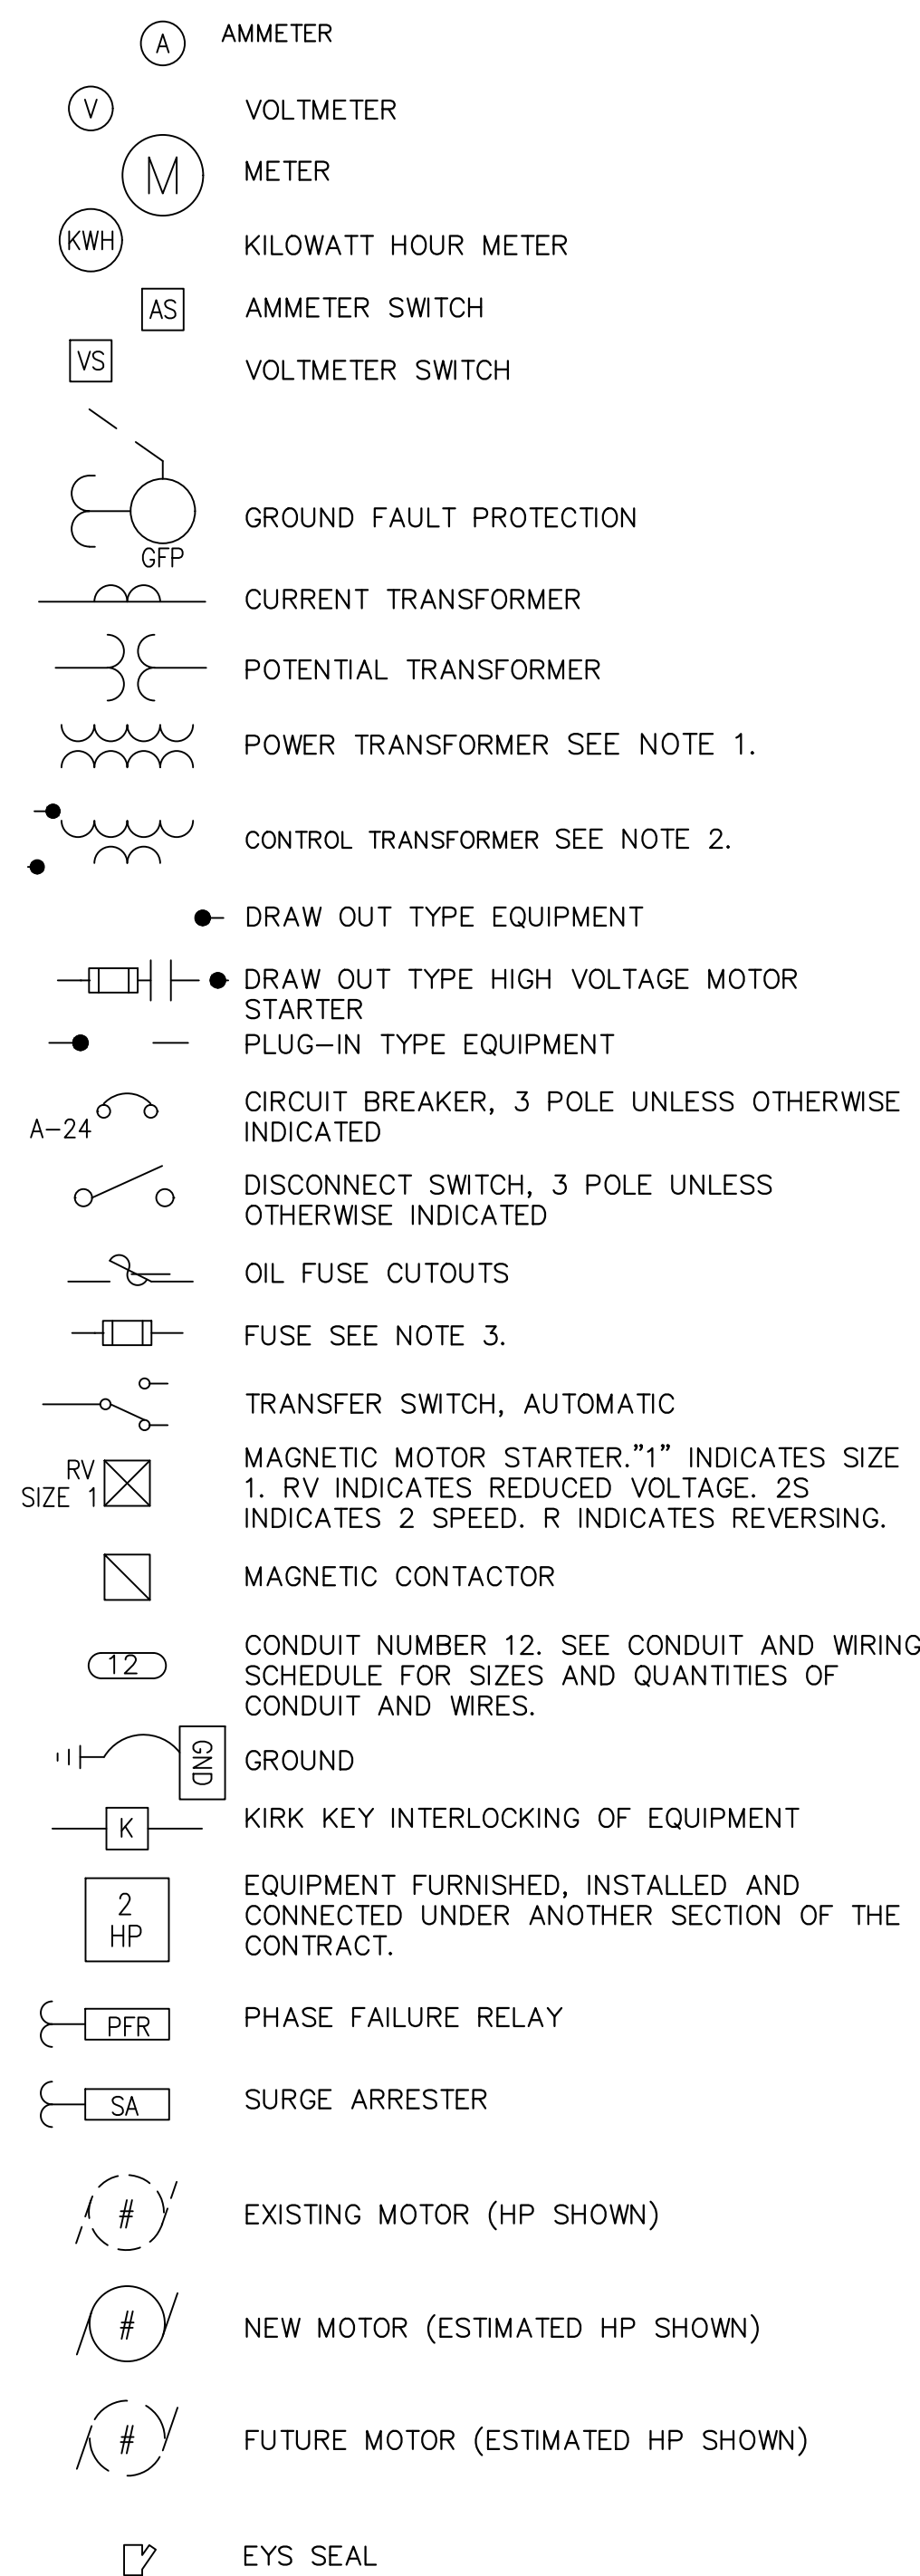


NOTES: (ELECTRICAL SYMBOLS)

- POWER TRANSFORMERS SHALL BE DRY TYPE 480-208Y/120 VOLTS, 3 PHASE 4 WIRE UNLESS OTHERWISE INDICATED.
- CONTROL TRANSFORMER SHALL BE DRY TYPE 480-120 VOLTS 1 PHASE UNLESS OTHERWISE INDICATED. SEE CONTROL WIRING DIAGRAMS FOR USE OF 120 VOLT CONTROL CIRCUITS CONTROL TRANSFORMERS SHALL BE SIZED TO HANDLE THE LOADS OF ALL RELAYS, PILOT LIGHTS, ETC. CONNECTED THERE TO PLUS 50 VA EXTRA CAPACITY.
- LOCATED IN OR ON MOTOR CONTROL CENTER UNLESS OTHERWISE INDICATED.

CONTROL WIRING DIAGRAMS

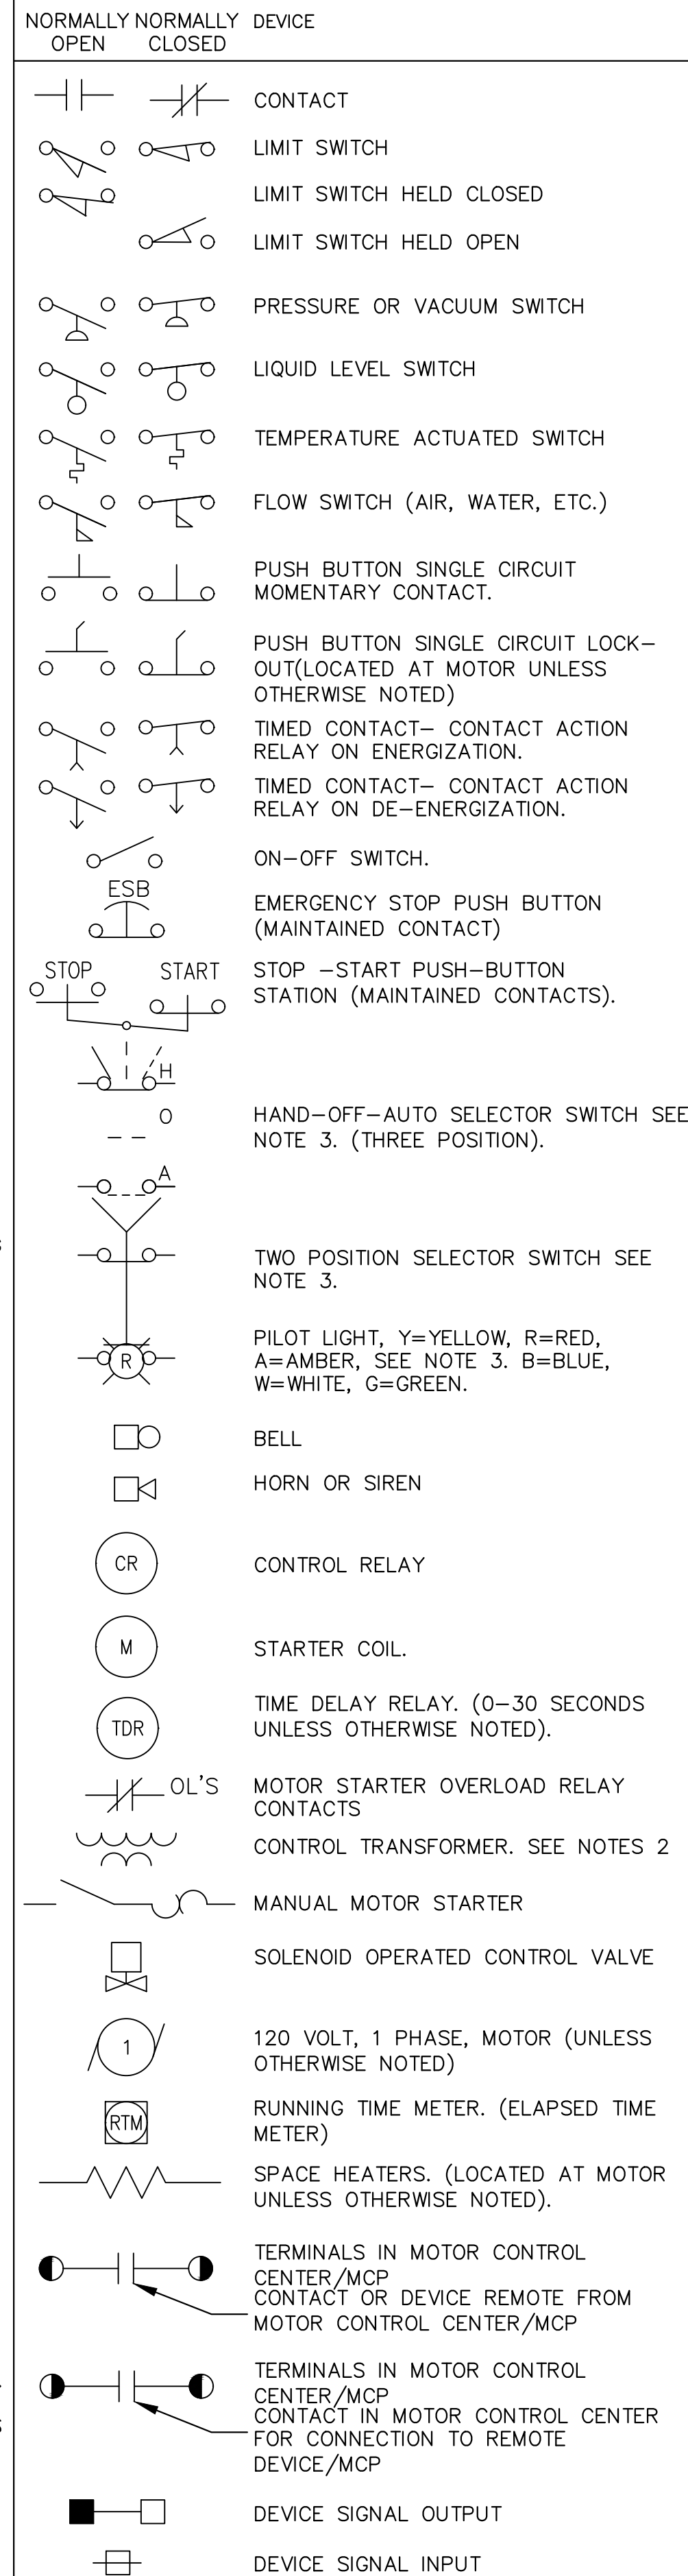

PLANS

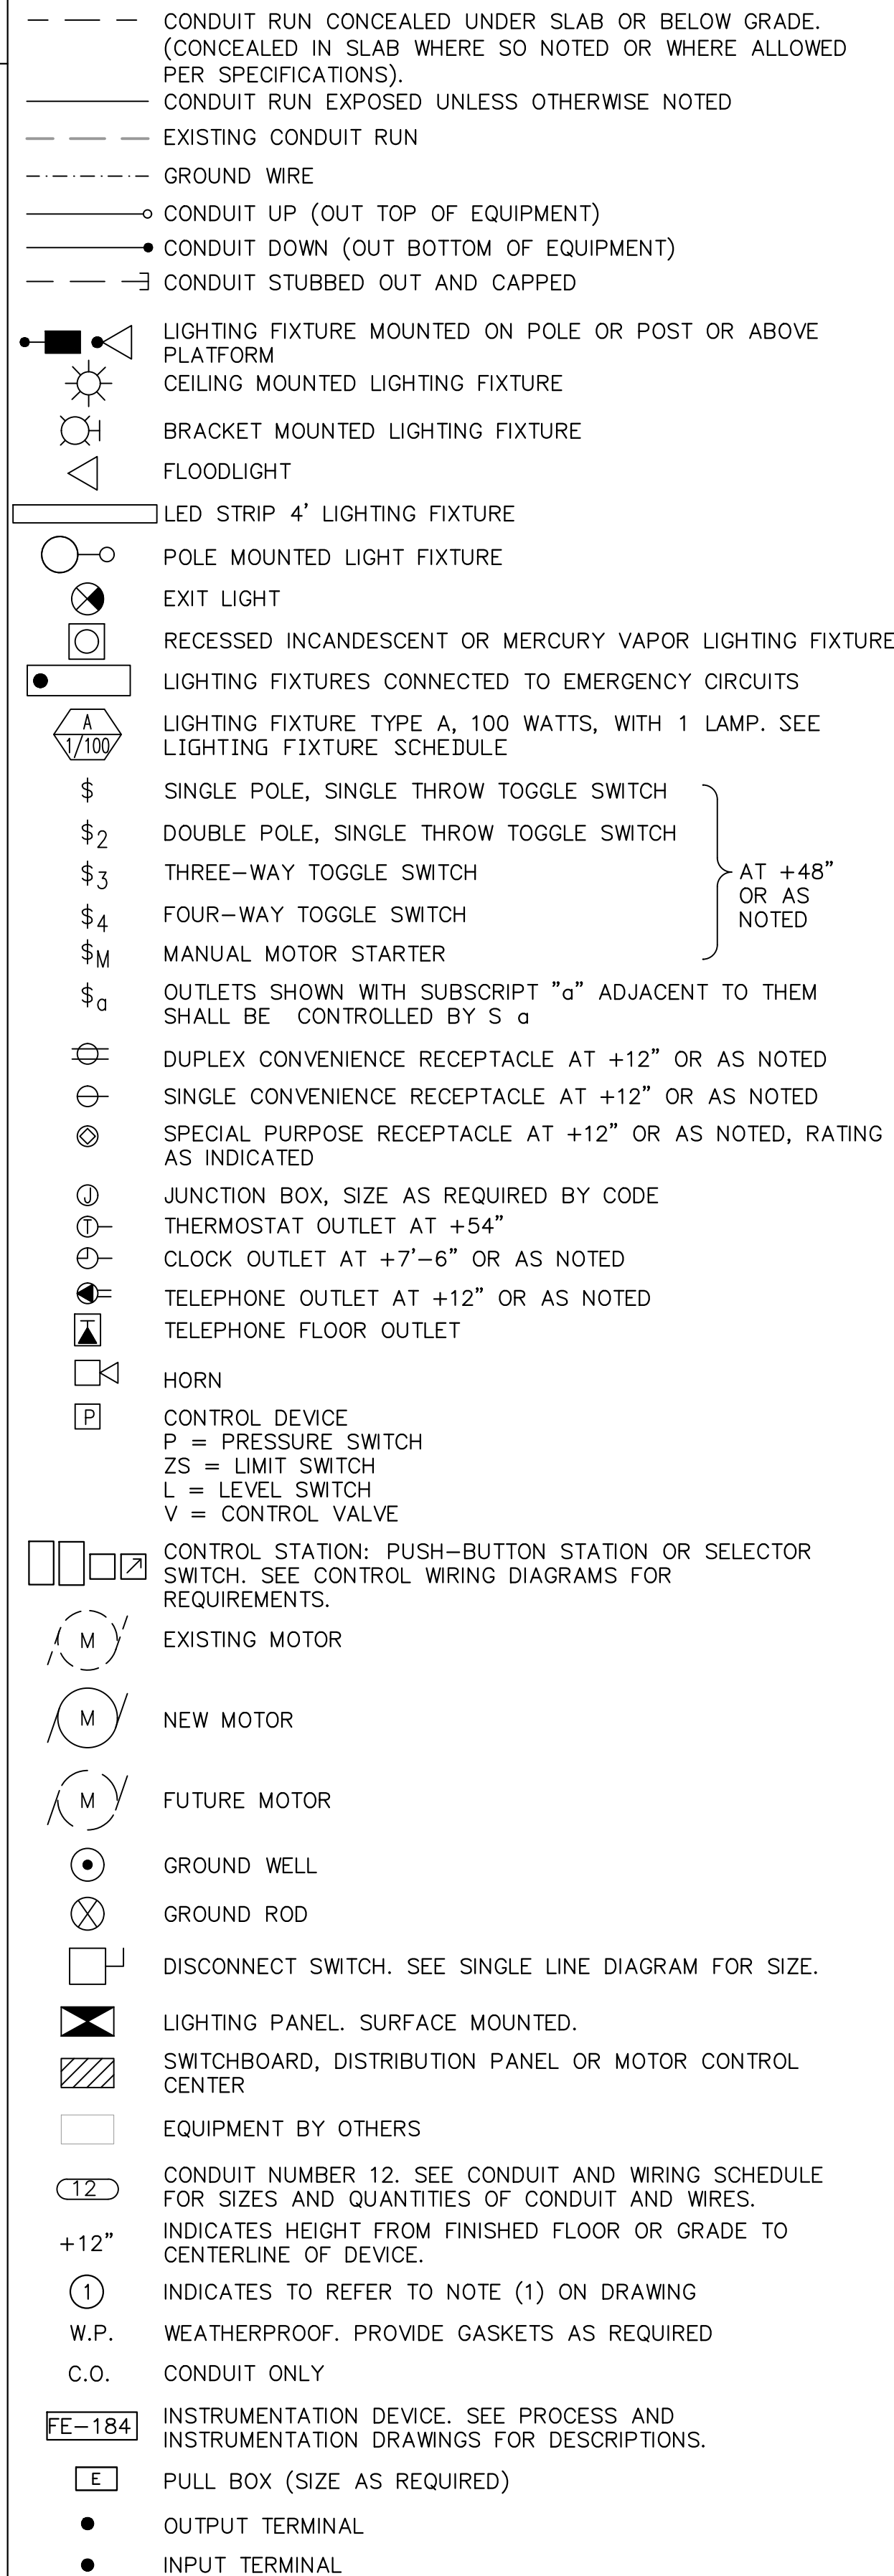

ABBREVIATIONS

AMP AMPERE	HZ HERTZ (CYCLES PER SECOND)	O & M OPERATIONS AND MAINTENANCE	V VOLTS
AL ALUMINUM	IC INTERRUPTING CAPACITY	P POLE	VAC VOLT ALTERNATING CURRENT
AT AMP TIP	JB JUNCTION BOX	PG&E PACIFIC GAS AND ELECTRIC	VFD VARIABLE FREQUENCY DRIVE
ATS AUTOMATIC TRANSFER SWITCH	KV KILOVOLTS	PLC PROGRAMMABLE LOGIC CONTROLLER	WP WEATHERPROOF
AWG AMERICAN WIRE GAUGE	LB ELBOW	PNL PANEL	XFMR TRANSFORMER
B.C. BARE COPPER	LCL LONG CONTINUOUS LOAD	PR PAIR	
BRK BREAKER	LSH LEVEL SWITCH HIGH	PVC POLYVINYL CHLORIDE	
CAT CATALOG	LSHH LEVEL SWITCH HIGH HIGH	R RADIUS	
CIRC.MIL CIRCULAR MILS (AWG)	LSL LEVEL SWITCH LOW	REC RECEPTACLE	
CLR CLEARANCE	LSLL LEVEL SWITCH LOW LOW	RGS RIGID GALVANIZED STEEL	
C.O. CONDUIT ONLY	LTG LIGHTING	RMS ROOT MEAN SQUARE	
CKT CIRCUIT	MA MILLIAMPERE	R/W RIGHT OF WAY	
CP CONTROL PANEL	MAX MAXIMUM	SCHED SCHEDULE	
CU CONDENSER UNIT	MCC MOTOR CONTROL CENTER	SES SERVICE ENTRANCE SECTION	
DIA DIAMETER	MCP MAIN CONTROL PANEL	SPECS SPECIFICATIONS	
DWG DRAWING	MCM THOUSAND CIRCULAR MIL (AWG)	SQ SQUARE	
EA EACH	MFR MANUFACTURER	SSS SOLID STATE STARTER	
ELECT ELECTRICAL	MIN MINIMUM	STD STANDARD	
ELEV ELEVATION	MIS MISCELLANEOUS	T THICK	
EXIST EXISTING	MPZ MINI POWER ZONE	TB TERMINAL BLOCK	
FLA FULL LOAD AMPS	MTG MOUNTING	TEL TELEPHONE	
FUT FUTURE	MV MERCURY VAPOR	TDR TIME DELAY RELAY	
GFCI GROUND FAULT CIRCUIT INTERRUPTER	N.C. NORMALLY CLOSED	TTB TELEPHONE TERMINAL BACKBOARD	
GND GROUND	N.E. NATIONAL ELECTRICAL CODE	TYP TYPICAL	
HOA HANDS-OFF-AUTO	N.O. NORMALLY OPEN	UCP UNIT CONTROL PANEL	
HP HORSEPOWER	NO. NUMBER	UG UNDERGROUND	
HPS HIGH PRESSURE SODIUM	O.C. ON CENTER	U.L. UNDERWRITERS LABORATORY	

GENERAL ELECTRICAL REQUIREMENTS


- THE COMPLETED INSTALLATION SHALL CONFORM TO ALL APPLICABLE FEDERAL, STATE AND LOCAL CODE ORDINANCES AND REGULATIONS. CONTRACTOR SHALL OBTAIN NECESSARY PERMITS AND INSPECTIONS REQUIRED BY THE AUTHORITIES HAVING JURISDICTION. ALL WORK SHALL BE DONE IN A NEAT, WORKMANLIKE, FINISHED AND SAFE MANNER, ACCORDING TO THE LATEST PUBLISHED N.E.C.A. STANDARDS OF INSTALLATION, UNDER COMPETENT SUPERVISION. INSTALL GROUNDING AS REQUIRED BY THE CODE(S).
- VISIT THE SITE PRIOR TO BIDDING TO BECOME FAMILIAR WITH EXISTING CONDITIONS AND ALL OTHER FACTORS WHICH MAY AFFECT THE EXECUTION OF THIS WORK. INCLUDE ALL RELATED COSTS IN THE INITIAL BID PROPOSAL.
- ALL MATERIALS SHALL BE NEW AND OF THE BEST QUALITY, MANUFACTURED IN ACCORDANCE WITH NEMA, ANSI, U.L. OR OTHER APPLICABLE STANDARDS. THE USE OF MANUFACTURER'S NAMES, MODELS, AND NUMBERS IS INTENDED TO ESTABLISH STYLE, QUALITY, APPEARANCE, USEFULNESS AND BID PRICE. PROPOSED SUBSTITUTIONS SHALL BE SUBMITTED IN WRITING AND REVIEWED BY THE ENGINEER BEFORE ORDERING.
- PROTECT ALL ELECTRICAL MATERIAL AND EQUIPMENT INSTALLED UNDER DIVISION 6 AGAINST DAMAGE BY OTHER TRADES, WEATHER CONDITIONS OR ANY OTHER CAUSES. EQUIPMENT FOUND DAMAGED OR IN OTHER THAN NEW CONDITION WILL BE REJECTED AS DEFECTIVE.
- LEAVE THE SITE CLEAN, REMOVE ALL DEBRIS, EMPTY CARTONS, TOOLS, CONDUIT, WIRE SCRAPS AND ALL MISCELLANEOUS SPARE EQUIPMENT AND MATERIALS USED IN THE WORK DURING CONSTRUCTION. ALL COMPONENTS SHALL BE FREE OF DUST, GRIT AND FOREIGN MATERIALS, LEFT AS NEW BEFORE FINAL ACCEPTANCE OF WORK.
- CIRCUIT CONDUCTORS #2 AWG OR SMALLER TO BE COPPER TYPE "XHHW" FOR BELOW GRADE INSTALLATION OR COPPER TYPE THHN/THWN FOR ABOVE GRADE INSTALLATIONS. #1 AWG OR LARGER SHALL BE COPPER TYPE "XHHW-2" STRANDED COPPER. MINIMUM CONDUCTOR SIZE TO BE #12 AWG WITH #12 GND.
- UNDERGROUND CONDUITS TO BE SCHEDULE 40 PVC. MINIMUM DEPTH 30", MINIMUM SIZE 1", UNLESS OTHERWISE SHOWN ON THE PLANS. CONDUITS AS SHOWN ARE FOR INFORMATION ONLY. EXACT CONDUIT ROUTING SHALL BE DETERMINED IN THE FIELD BY THE CONTRACTOR.
- OUTDOOR CONDUITS EXPOSED TO BE GALVANIZED RIGID STEEL, MINIMUM SIZE 3/4". UNLESS OTHERWISE NOTED ON THE PLANS. GRS CONDUIT SHALL EXTEND BELOW GRADE TO THE FIRST ELBOW. ALL RGS CONDUIT EXPOSED TO EARTH SHALL BE HALF LAPPED WRAPPED IN SCOTCHRAP 50 10 MIL TAPE OR EQUAL. EXTEND WRAP TO A HEIGHT OF 12" ABOVE GRADE. INDOOR CONDUITS SHALL BE IMC OR EMT UNLESS OTHERWISE SHOWN ON PLAN.
- ALL SAFETY SWITCHES AND OTHER DISTRIBUTION AND CONTROL ELECTRICAL EQUIPMENT SHALL BE U.L. LISTED AND RATED FOR HEAVY DUTY SERVICE.
- ALL WIRING DEVICES SHALL BE SPECIFICATION GRADE.
- ALL ELECTRICAL EQUIPMENT, CONDUIT, WIRING, BOXES, ETC. SHALL BE SUBMITTED TO THE ENGINEER FOR REVIEW PRIOR TO ORDERING. THE SUBMITTALS SHALL BE NEATLY GROUPED AND ORGANIZED. PERTINENT INFORMATION SHALL BE HIGHLIGHTED, AND THE SPECIFIC PRODUCT SHALL BE IDENTIFIED. ALL SUBMITTALS SHALL BE COMPLETE, AND PRESENTED IN ONE PACKAGE. THE SUBMITTAL SHALL INCLUDE A COMPLETE LIST OF THE EQUIPMENT AND MATERIALS, INCLUDING THE MANUFACTURER'S NAME, PRODUCT SPECIFICATION, DESCRIPTIVE DATA, TECHNICAL LITERATURE, PERFORMANCE CHARTS, CATALOG CUTS, INSTALLATION INSTRUCTIONS, AND SPARE PART RECOMMENDATIONS FOR EACH DIFFERENT ITEM OF THE EQUIPMENT SPECIFIED.
- IT IS THE OBLIGATION OF THE CONTRACTOR TO ORGANIZE HIS WORK, SO THAT A COMPLETE ELECTRICAL, INSTRUMENTATION, AND CONTROL SYSTEM FOR THE FACILITY WILL BE PROVIDED, AND WILL BE SUPPORTED BY ACCURATE SHOP AND RECORD DRAWINGS, AND O & M MANUALS.

BENCHMARK:
 NATIONAL GEODETIC SURVEY BENCHMARK NO. 1311
 1.4 MILES WEST OF BEAUMONT ON INTERSTATE 10 TO SAN TIMOTEO CANYON NEAR FRONTAGE ROAD ON SOUTH(WEST) SIDE OF INTERSTATE 10, 0.1 MILES SOUTHWEST ALONG FRONTAGE ROAD, SOUTH ACROSS THE ROAD FROM A GUY POLE 25.9 FEET SOUTH OF THE CENTERLINE OF FRONTAGE ROAD, 1.8 FEET WEST OF POWERPOLE AND 1.8 FEET EAST OF A WITNESS POST, INSIDE A 4 INCH PVC PIPE WITH SCREW PLUG 1 INCH ABOVE GROUND (ELEVATION = 2468.07). ALSO SHOWN ON HIGHWAY 69 / POTRERO BLVD. INTERCHANGE STATIC GPS PROJECT CONTROL DIAGRAM AND IDENTIFIED THEREON AS 3538 BM D33474 WHEN THE PUBLISHED ELEVATION = 2468.07 IS CORRECTED WITH A MEASURED ELEVATION = 2468.01, USED HEREON.
 ELEV. 2468.01, (NVD '88), (STAMPED Q 1311 1978)

BY	MARK	DESCRIPTION	APPR.	DATE
ENGINEER		REVISIONS	CITY	

Kimley»Horn
 401 B Street, Suite 600, San Diego, CA 92101
 Phone: (619) 234-9411
 WWW.KIMLEY-HORN.COM

BY: *Michael A. Colombo*
 MICHAEL A. COLOMBO
 R.C.E. 19280
 8/23/2021

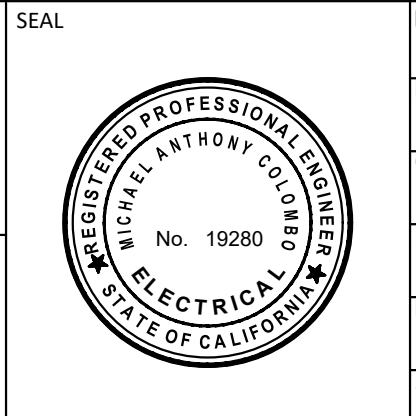

DESIGN BY: SLM
 DRAWN BY: RC/SW
 CHECKED BY: TW/SS
 SCALE: _____
 DATE: _____
 JOB NUMBER: 195284001

Reviewed By: _____ Date: _____
 Staff Engineer

Recommended for Approval By: *[Signature]* Date: 11/19/2021
 Administrative Engineer

Approved By: *[Signature]* Date: 11/23/2021
 City Engineer/Director of Public Works

CITY OF BEAUMONT, PUBLIC WORKS DEPARTMENT
 ENGINEERING DIVISION
 550E 6th St
 Beaumont, CA 92223
 TEL: (951) 769-8520 FAX: (951) 769-8526

CITY OF BEAUMONT, CALIFORNIA
 IMPROVEMENT PLANS FOR:
**BEAUMONT CROSSROADS
 LIFT STATION**


GENERAL ELECTRICAL NOTES

SHEET
14
 OF 38 SHEETS
 FILE NO: 3387

Plotted By: V:\m\l...
 October 20, 2021 10:50:27am
 K:\SND_WATER\195284001_Beaumont Lift Station\Design\Plan Sheets - 2020_DELTA_BET\195284001 - EL DELTA.dwg

CONSTRUCTION NOTES

- ① FURNISH AND INSTALL PROPOSED 400KW/500 KVA, 480/277 V, 3PHASE, 4 WIRE METER SERVICE. SEE SINGLE-LINE DIAGRAM ON SHEET 17.
- ② PROPOSED 400KW/500 KVA, 480/277 V, 3PHASE, 4W, NEMA 3R DIESEL GENERATOR WITH 693 GALLON BELLY TANK AND LEVEL 2 ACOUSTIC ENCLOSURE. SEE DETAIL 4 ON SHEET 18.
- ③ FURNISH AND INSTALL PULL BOX PER DETAIL 3 ON SHEET 18.
- ④ FURNISH AND INSTALL LIGHT FIXTURE, POLE AND FOUNDATION PER DETAIL 5 ON SHEET 18.
- ⑤ CONTRACTOR TO COORDINATE CONDUIT TO UTILITY TRANSFORMER PER UTILITY COMPANY STANDARDS.
- ⑥ SITE ANTENNA POLE. CONTRACTOR TO PERFORM PATHWAY STUDY PRIOR TO POLE AND ANTENNA SELECTION. SUBMIT POLE TO ENGINEER FOR APPROVAL.
- ⑦ PROVIDE GFCI STANCHION MOUNTED RECEPTACLE FOR ODOR CONTROL.
- ⑧ CONTRACTOR TO PROVIDE SPARE CONDUIT PER SCHEDULE AND LEAVE IN PULLBOX FOR FUTURE LIFT STATION.
- ⑨ SEE CONDUIT SCHEDULE PER DETAIL 'A', SHEET 21 FOR CONDUIT/CONDUCTOR INFORMATION AND ROUTING

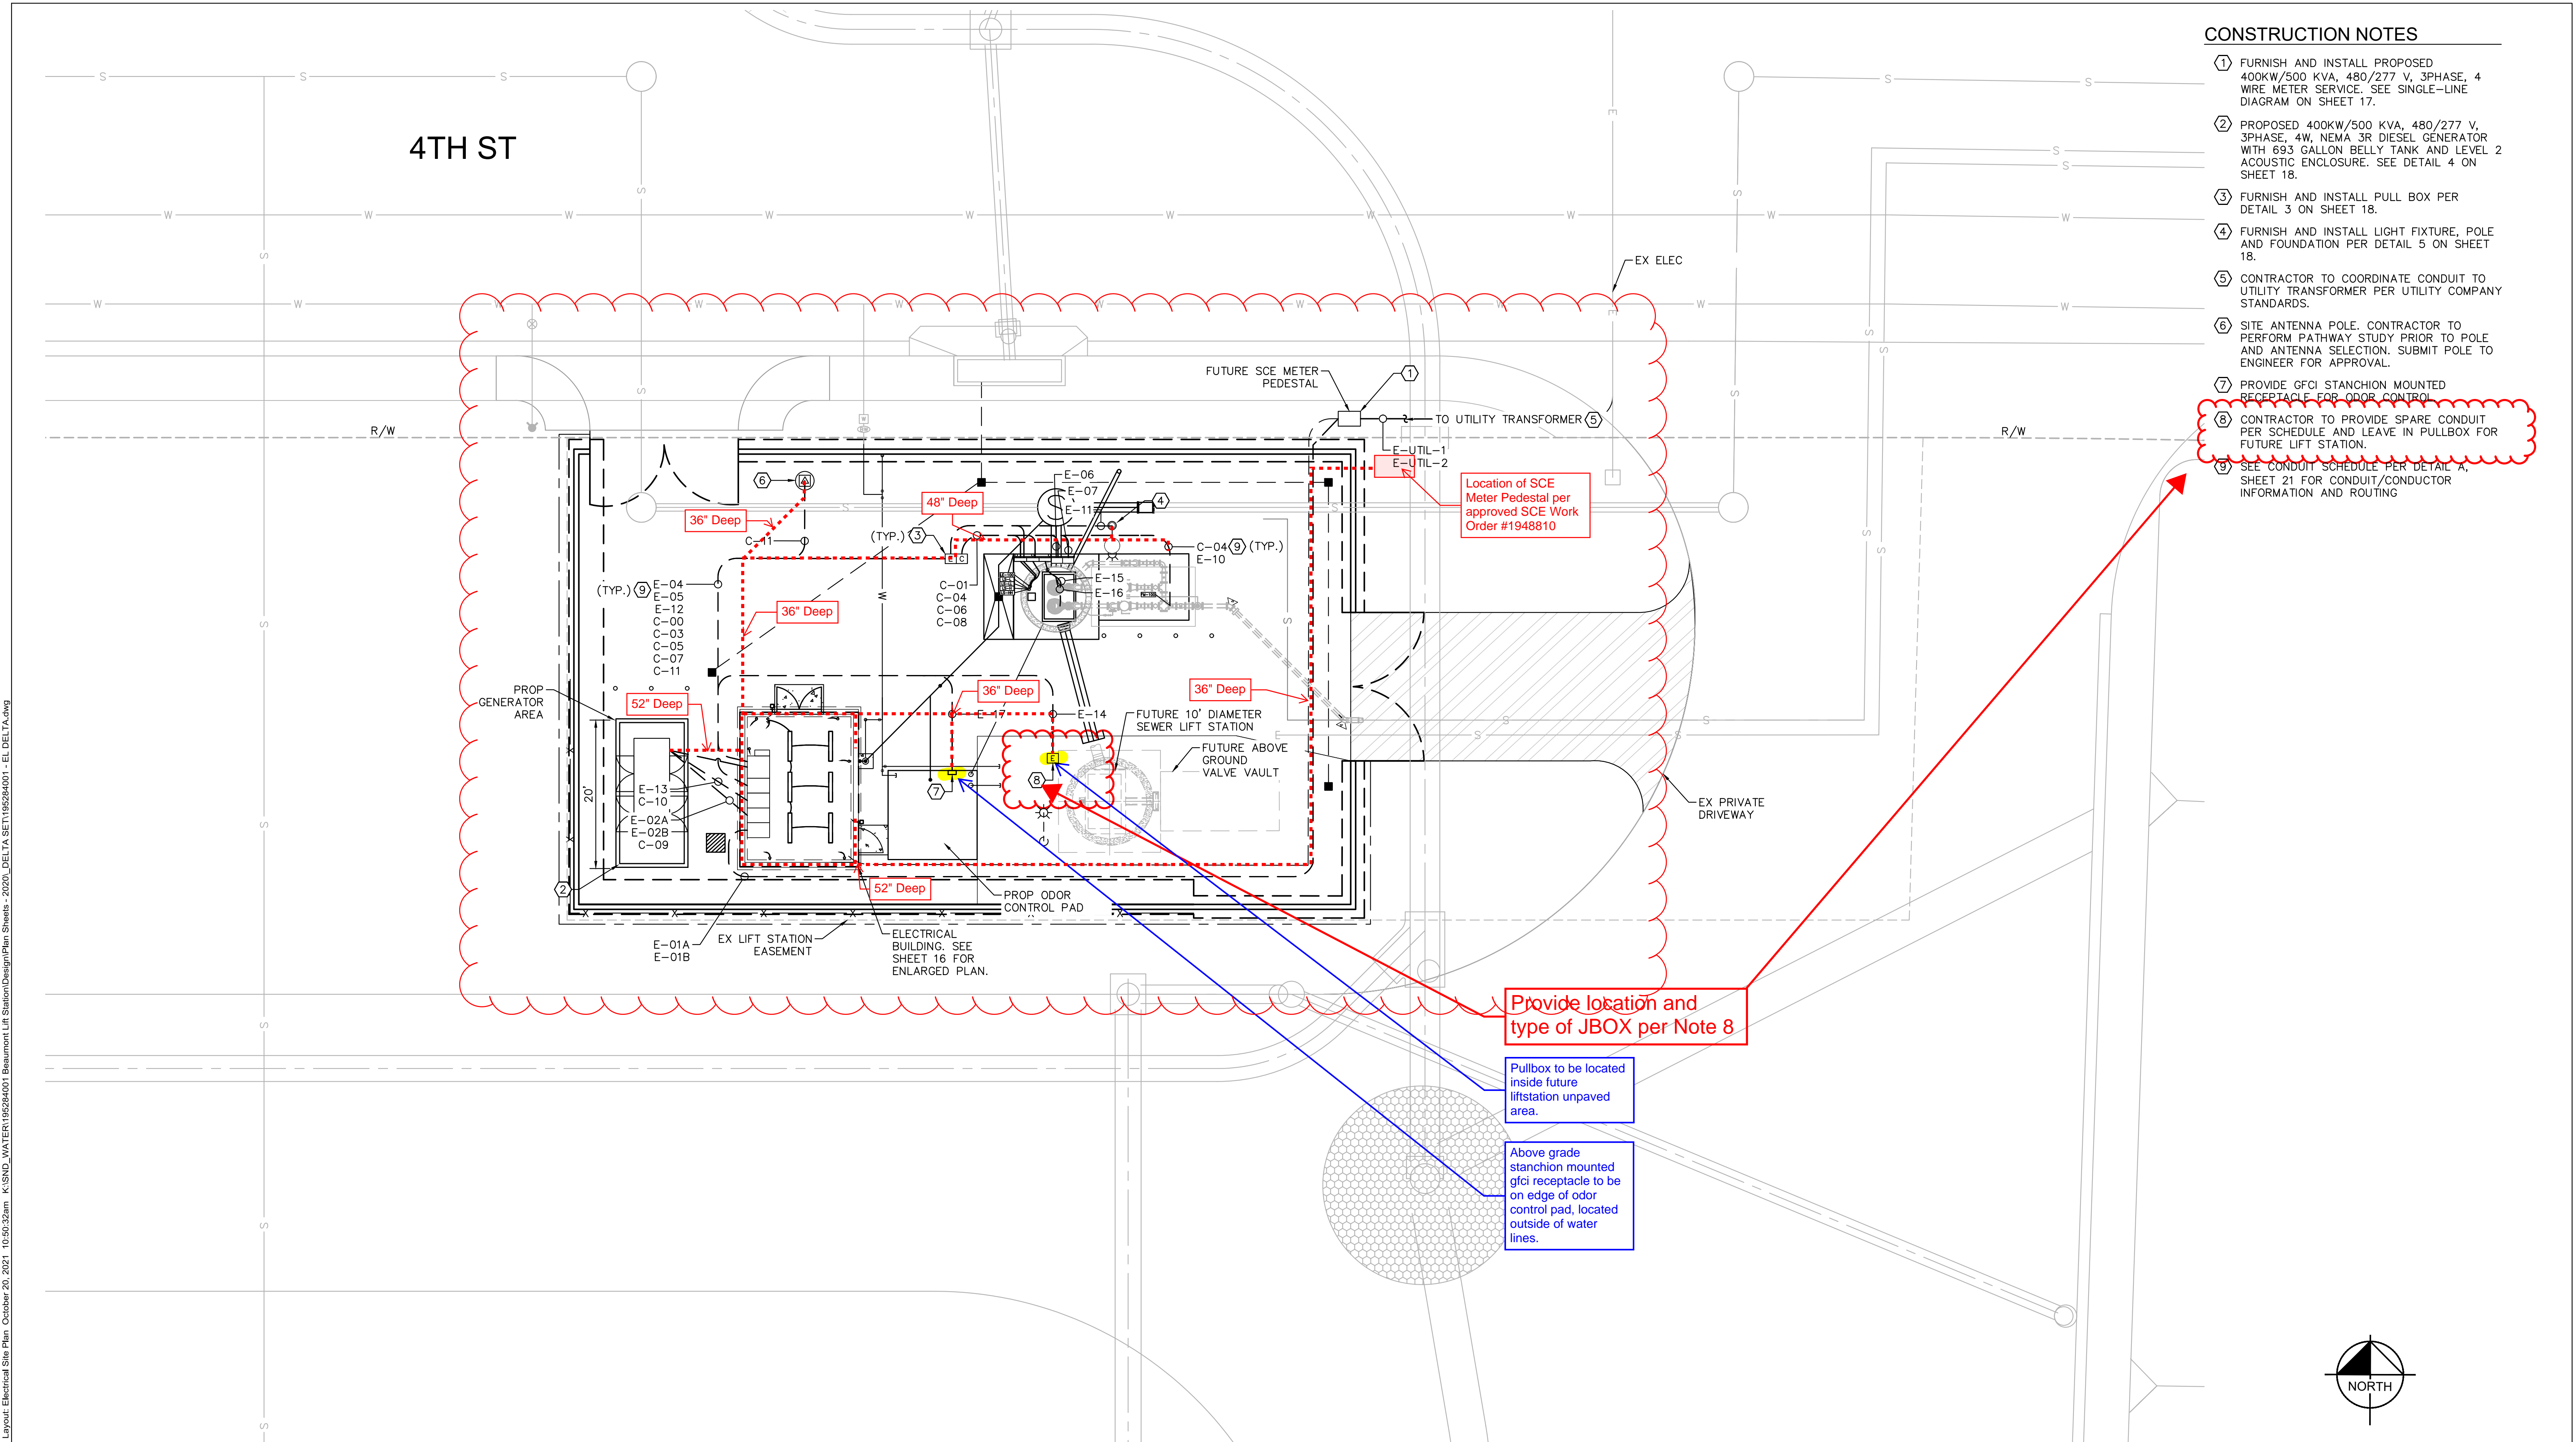


Provide location and type of JBOX per Note 8

Pullbox to be located inside future liftstation unpaved area.

Above grade stanchion mounted gfc receptacle to be on edge of odor control pad, located outside of water lines.

1
15 ELECTRICAL SITE PLAN
SCALE: 1" = 10'

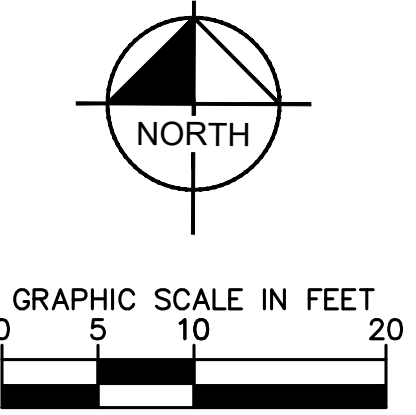

DIGALERT
Call 2 Working Days Before You Dig!
811

BENCHMARK:
NATIONAL GEODETIC SURVEY BENCHMARK NO. Q 1311
1.4 MILES WEST OF BEAUMONT ON INTERSTATE 10 TO SAN TIMOTEO CANYON NEAR FRONTAGE ROAD ON SOUTH(WEST) SIDE OF INTERSTATE 10, 0.1 MILES SOUTHWEST ALONG FRONTAGE ROAD, SOUTH ACROSS THE ROAD FROM A GUY POLE 25.9 FEET SOUTH OF THE CENTERLINE OF FRONTAGE ROAD, 1.8 FEET WEST OF POWERPOLE AND 1.8 FEET EAST OF A WITNESS POST, INSIDE A 4 INCH PVC PIPE WITH SCREW PLUG 1 INCH ABOVE GROUND. (ELEVATION = 2468.07). ALSO SHOWN ON HIGHWAY 69 / POTRERO BLVD. INTERCHANGE STATIC GPS PROJECT CONTROL DIAGRAM AND IDENTIFIED THEREON AS 3558 BM D34374 WHEN THE PUBLISHED ELEVATION = 2468.07 IS CORRECTED WITH A MEASURED ELEVATION = 2468.01, USED HEREON.
ELEV. 2468.01, (NVD '88), (STAMPED Q 1311 1978)

BY	MARK	DESCRIPTION	APPR.	DATE
ENGINEER		REVISIONS	CITY	

Kimley»Horn
401 B Street, Suite 600, San Diego, CA 92101
Phone: (619) 234-9411
WWW.KIMLEY-HORN.COM

Michael A. Colombo
MICHAEL A. COLOMBO
R.C.E. 19280
8/23/2021

SEAL

DESIGN BY: SLM
DRAWN BY: RC/SW
CHECKED BY: TW/SS
SCALE: _____
DATE: _____
JOB NUMBER: 195284001

Reviewed By: _____ Date: _____
Staff Engineer

Recommended for Approval By: *[Signature]* Date: 11/19/2021
Administrative Engineer

Approved By: *[Signature]* Date: 11/23/2021
City Engineer/Director of Public Works


CITY OF BEAUMONT, PUBLIC WORKS DEPARTMENT
ENGINEERING DIVISION
5506 6th St, Beaumont, CA 92223
TEL: (951) 769-8520 FAX: (951) 769-8526

CITY OF BEAUMONT, CALIFORNIA
IMPROVEMENT PLANS FOR:
BEAUMONT CROSSROADS LIFT STATION

ELECTRICAL SITE PLAN

SHEET
15
OF 38 SHEETS
FILE NO: 3387

Plotted By: \v\m\h\m\ Sam Sheet Set: BEAUMONT LIFT STATION - ONE LINE DIAGRAM - October 20, 2021, 10:50:39am K:\SND_WATER\195284001_Beaumont Lift Station\Design\Plan Sheets - 2020 DELTA SET\195284001 - EL DELTA.dwg

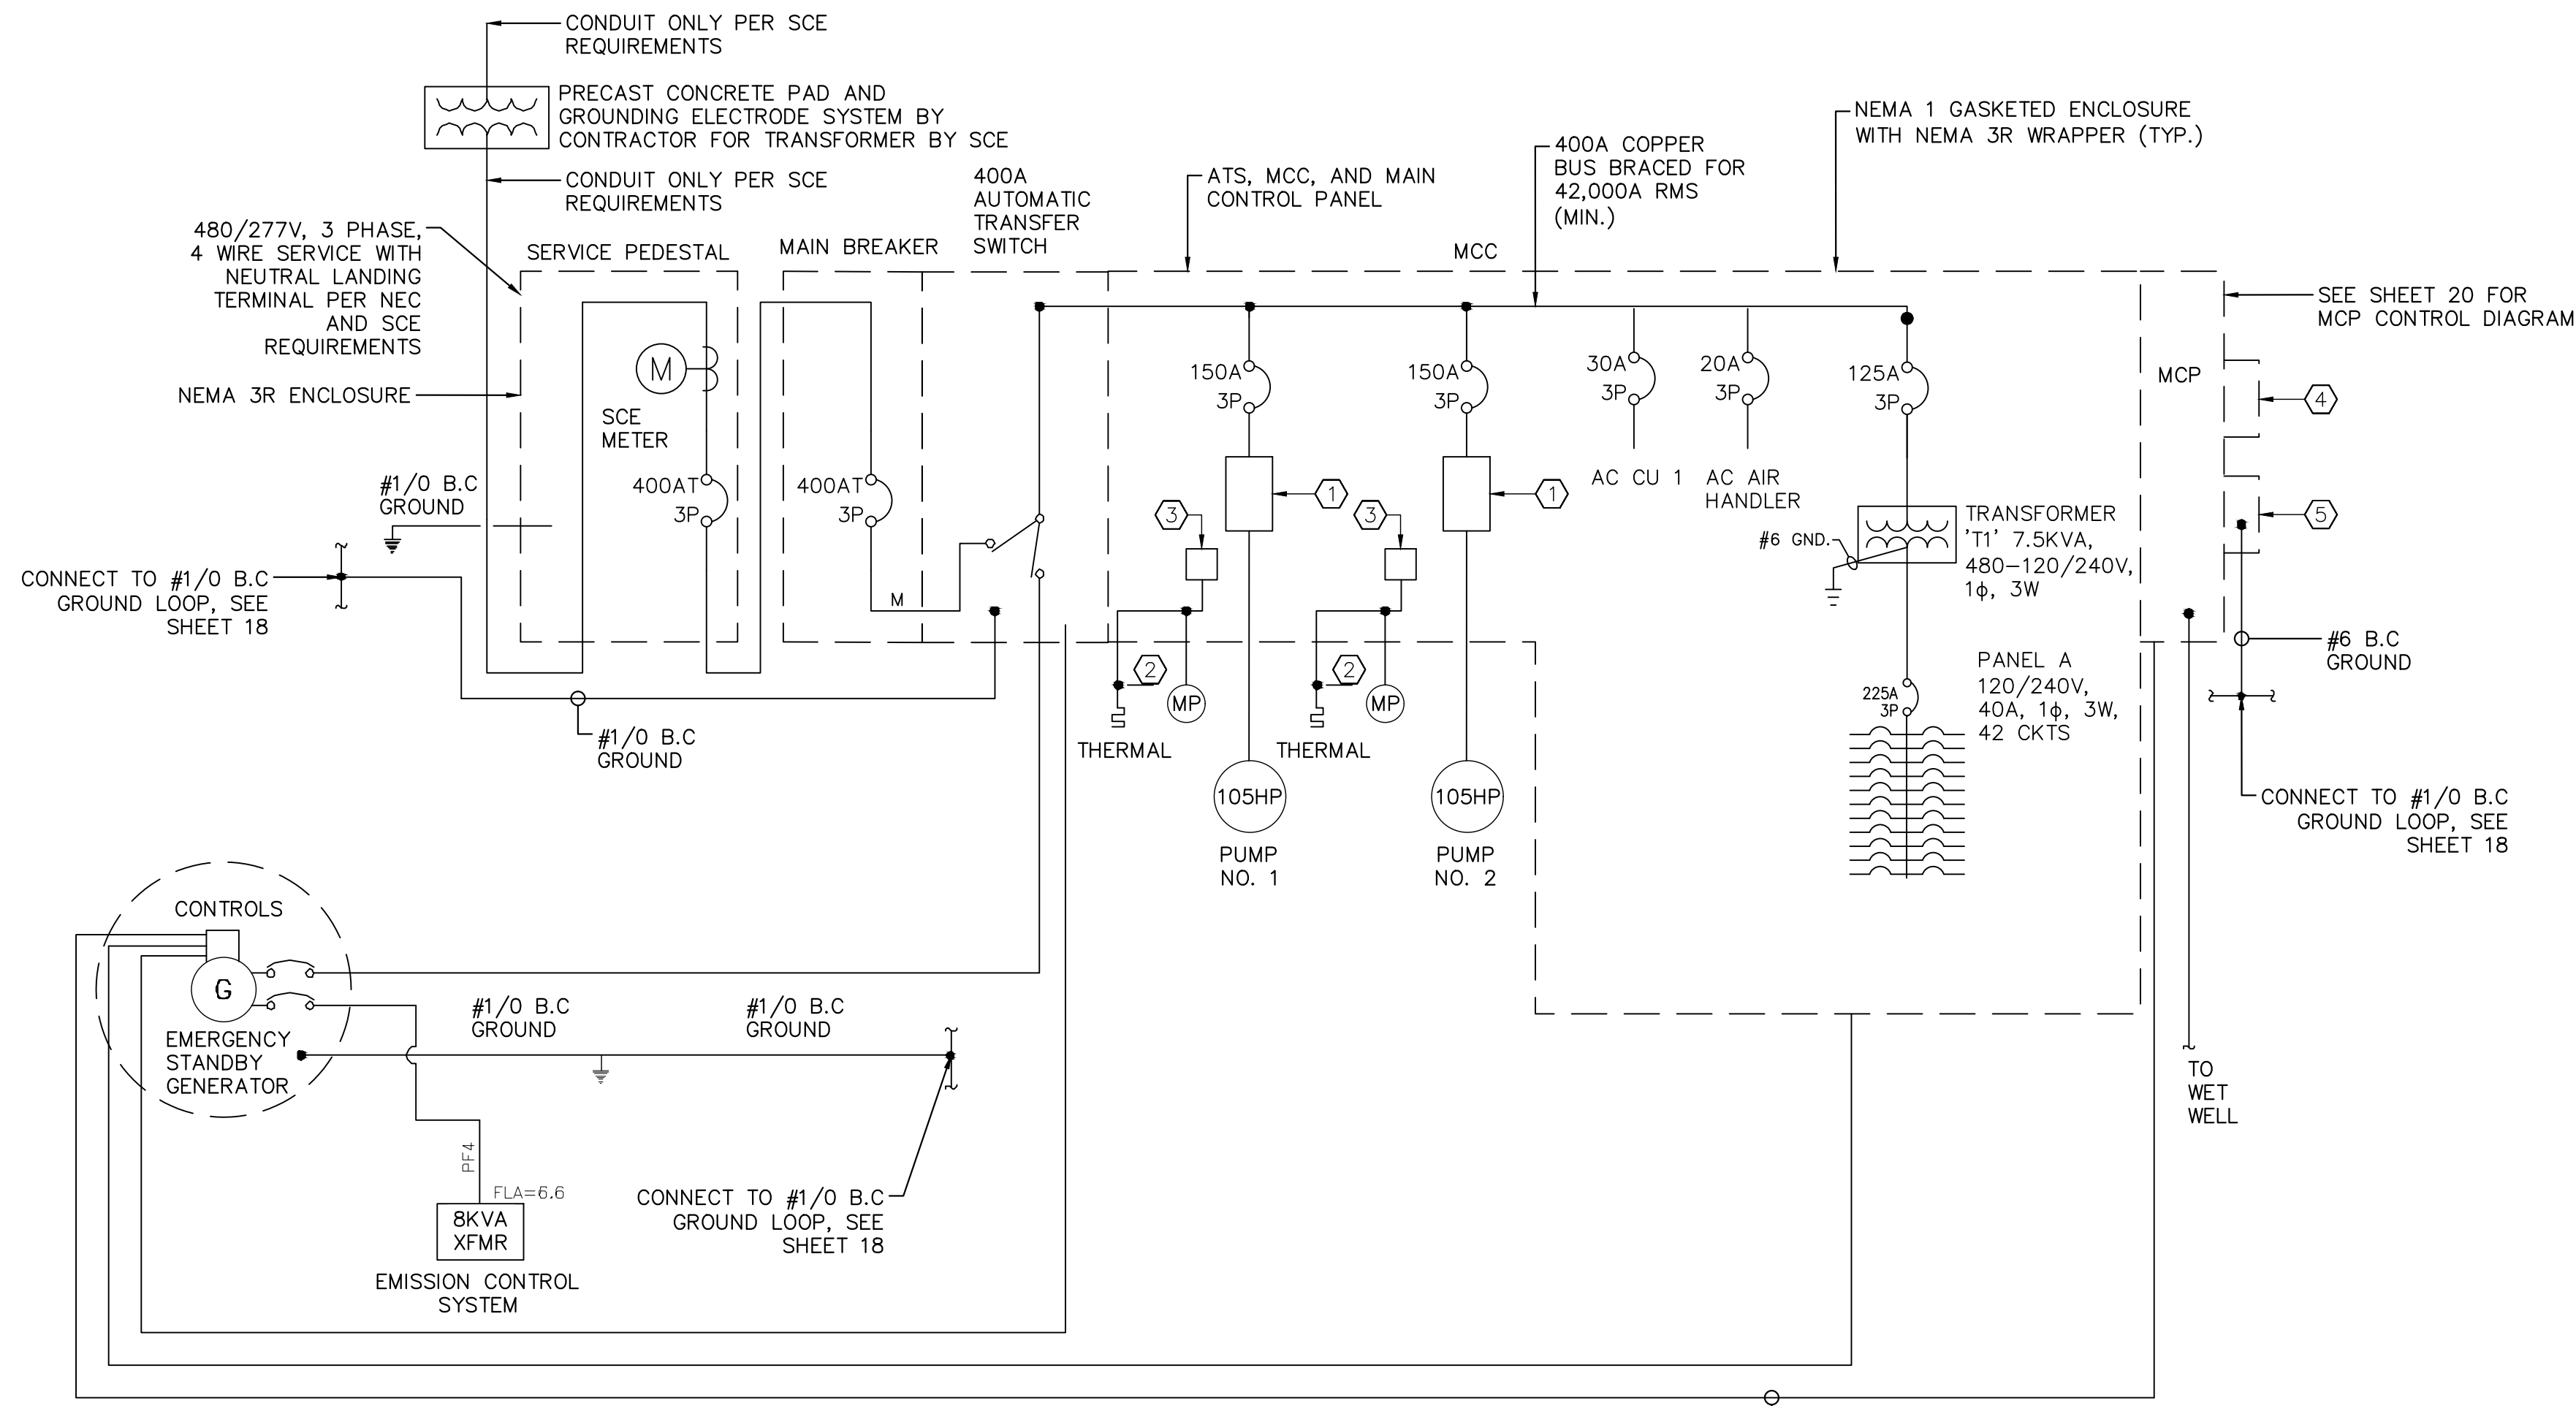


1 SINGLE LINE DIAGRAM
SCALE: NOT TO SCALE


CONNECT 2-#12 TO GENERATOR RUN, 2-#12 TO GENERATOR COMMON FAIL CONDITION, AND 2-#12 TO GENERATOR READY TO OPERATE. CONNECT REMAINING SPARES TO MCP TERMINAL STRIP

SINGLE-LINE DIAGRAM AND MCC NOTES




- 1 PROVIDE 125HP RATED VFD IN MCC, SIZE OCPD AS SHOWN ON ONE-LINE DIAGRAM.
2 THERMAL SENSOR AND MOISTURE PROBES IN PUMPING UNIT.
3 MOTOR THERMAL AND MOISTURE PROTECTION CONTROL MODULE(S), IF REQUIRED, TO BE FURNISHED BY PUMP MANUFACTURER. MOUNT MODULE(S) IN MAIN CONTROL PANEL 'MCP'.
4 RTU PANEL, CONTRACTOR SHALL FURNISH AND INSTALL HOFFMAN PANEL, C-SD30248 WITH LOCKING HANDLE C-WHPTO, AND DATA POCKET A-DP2, DISTRICT WILL FURNISH BACK PANEL WITH RTU FOR CONTRACTOR TO INSTALL AND TERMINATE CONDUCTORS.
5 RADIO LIGHTNING ARRESTOR PANEL, CONTRACTOR SHALL FURNISH AND INSTALL HOFFMAN PANEL, C-SD20208 WITH CP2020 BACK PANEL AND LOCKING HANDLE C-WHPTO. RADIO LIGHTNING ARRESTOR WILL BE FURNISHED AND INSTALLED BY DISTRICT.
6 2" LB and 2" RIGID ALUMINUM CONDUIT WITH WEATHER HEAD. ATTACH TO SIDE OF MCP WITH UNISTRUT SUPPORTS.
7 PANEL ANCHOR BOLTS SHALL BE 316 S.S. DEFERRED BOLTING DEVICES PER SPECIFICATION REQUIREMENTS. CONTRACTOR SHALL SUBMIT ANCHORAGE CALCULATIONS IN ACCORDANCE WITH SPECIFICATION REQUIREMENTS.
8 OPERATOR INTERFACE TERMINAL (OIT) C-MORE TOUCH PANEL PART NO. EA7-T6CL-R (NO SUBSTITUTES). PROVIDE 2-#14, 1-#14 GRD., 24VDC POWER CONDUCTORS, AND 8-CONDUCTOR FLAT COMMUNICATIONS CABLE FROM OIT TO RTU CABINET (DISTRICT WILL CONNECT TO RTU).
9 PAPERLESS CHART RECORDER, EZTREND QXE, AS MANUFACTURED BY HONEYWELL MODEL TVEZQX-60-000-22 (NO SUBSTITUTES) CHART RECORDER SHALL BE FLUSH MOUNTED TO FACE OF MCP DOOR. CHART RECORDER SHALL ACCEPT A MINIMUM OF FOUR 4-20MA INPUTS AND OPERATE ON 120VAC POWER. CHART RECORDER SHALL BE INSTALLED IN ACCORDANCE WITH MANUFACTURER'S PRINTED INSTRUCTIONS. SUPPLIER OR CONTACT TRENDVIEW RECORDERS 1-800-843-6307
10 FLUSH MOUNT ULTRASONIC CONTROLLER ON MCP DOOR.
11 FLUSH MOUNT REMOTE FLOW METER SIGNAL CONVERTER ON MCP DOOR. CONTRACTOR SHALL PROVIDE DOOR CUT-OUT, SUPPORT BRACKETS, AND BEZEL AS REQUIRED FOR FLUSH DOOR MOUNTING.
12 PLEXIGLASS SHIELD TO COVER BACK OF DOOR MOUNTED DEVICES (LIGHTS, SWITCHES, OIT, ETC.). 1/8" THICK PLEXIGLASS SHIELD WITH 1/4" DIA. S.S. BOLTS AT EACH CORNER OF SHIELD AND SPACERS BETWEEN MCP DOOR AND PLEXIGLASS SHIELD.

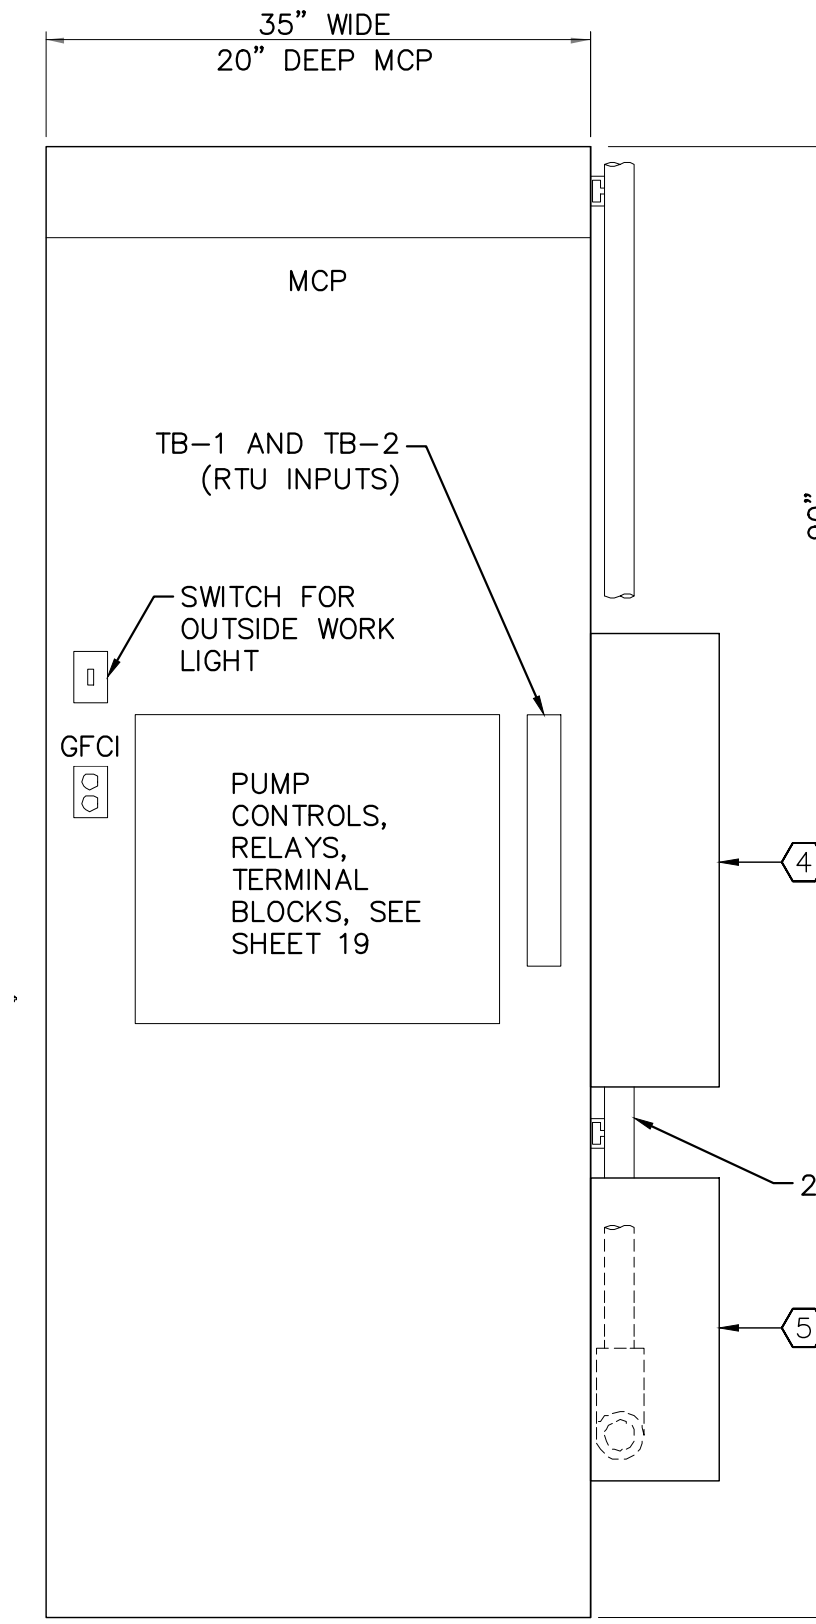


2 MCP LAYOUT
SCALE: NOT TO SCALE

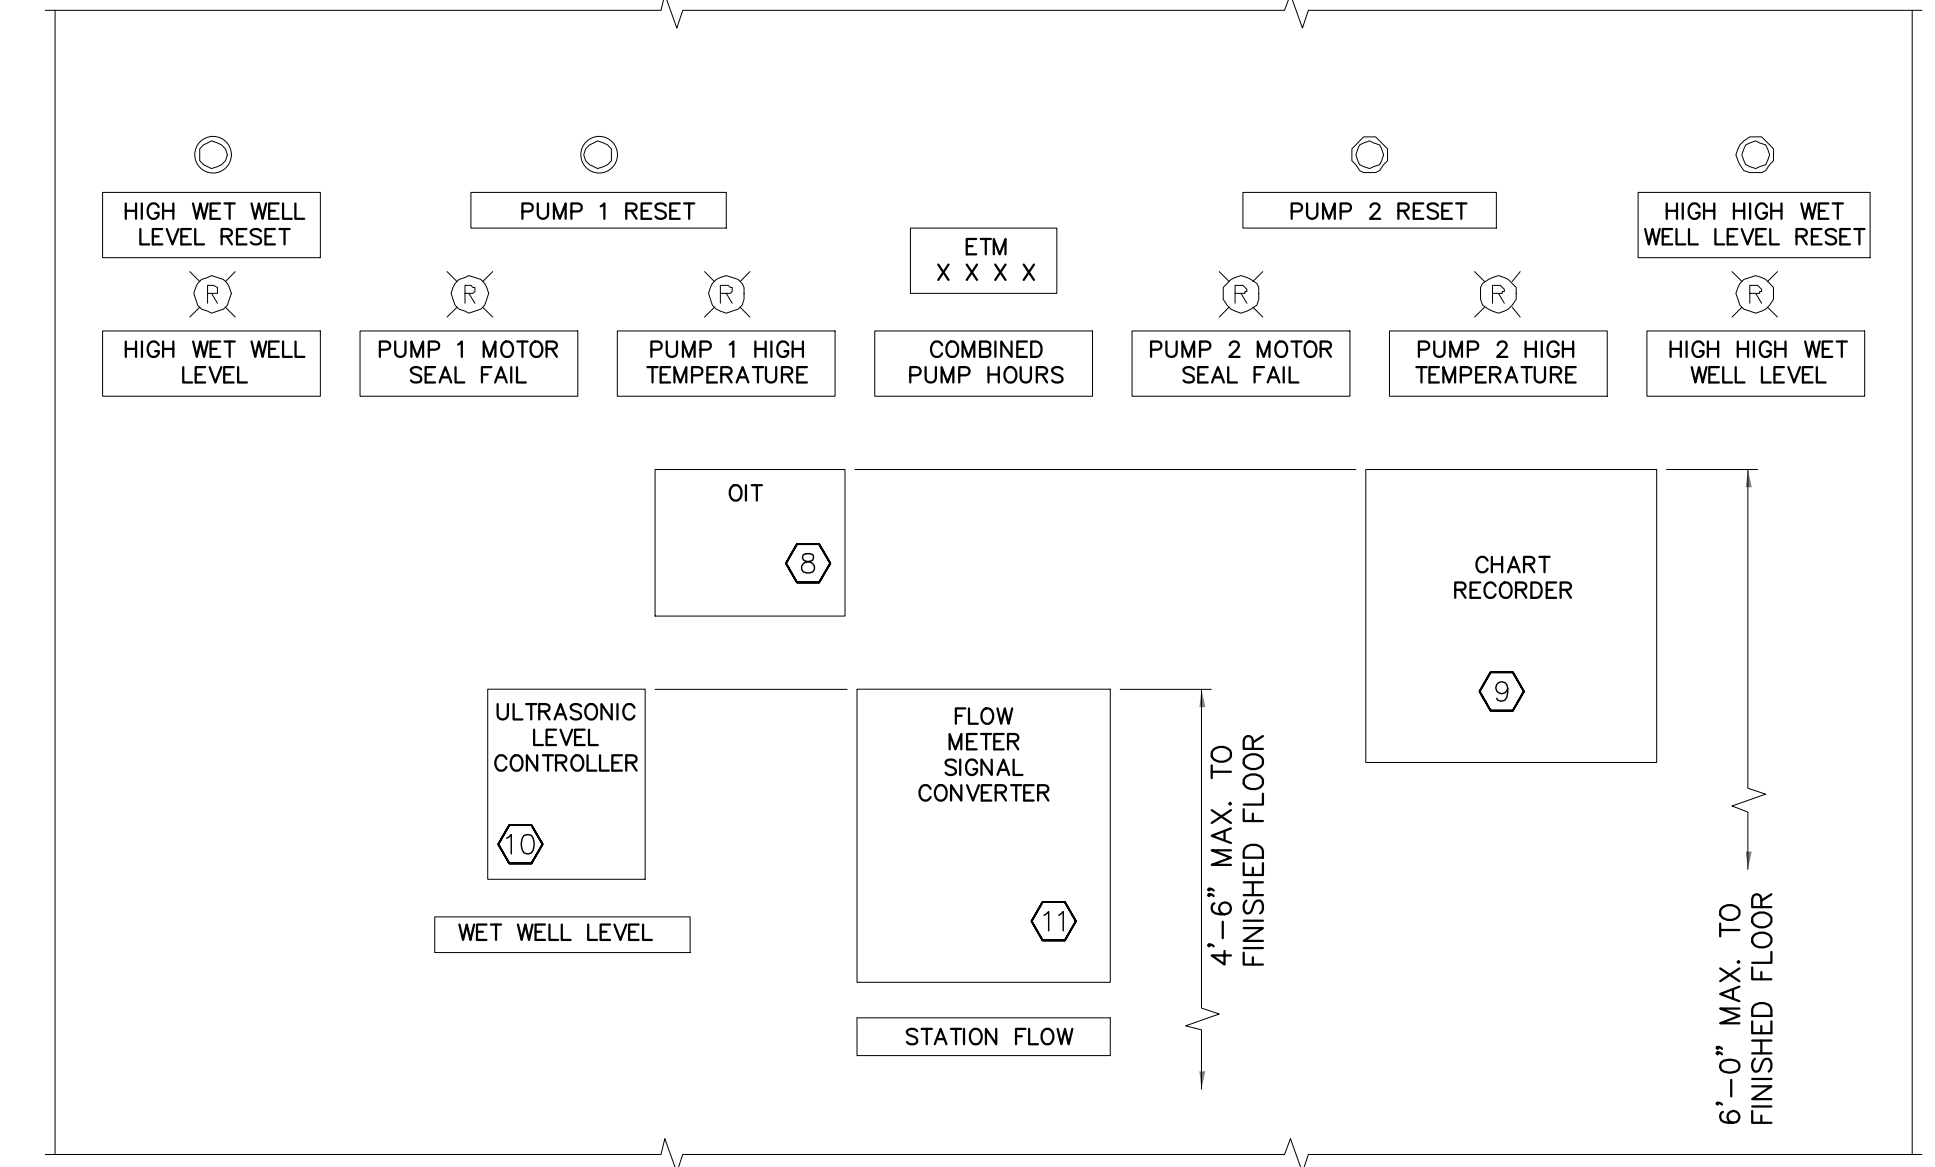

3 MCP DOOR LAYOUT
SCALE: NOT TO SCALE

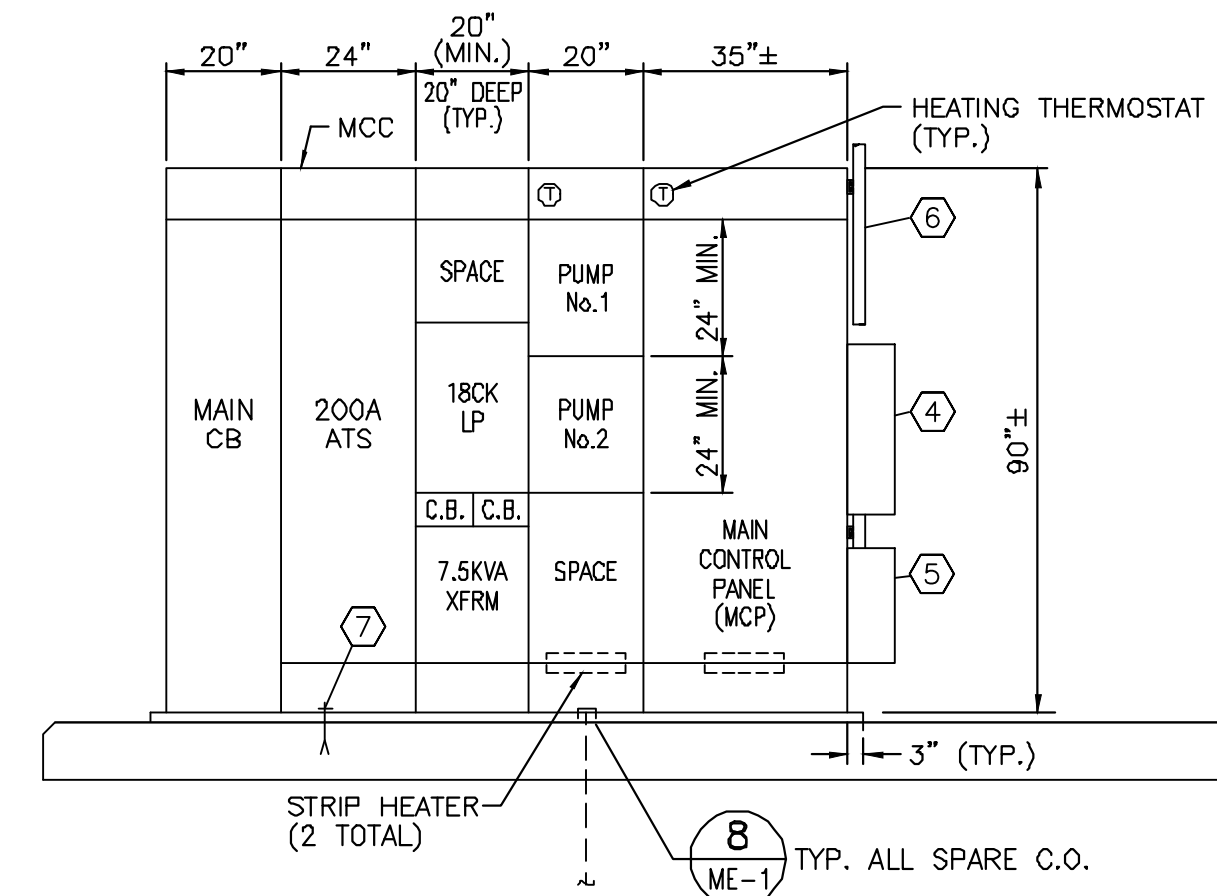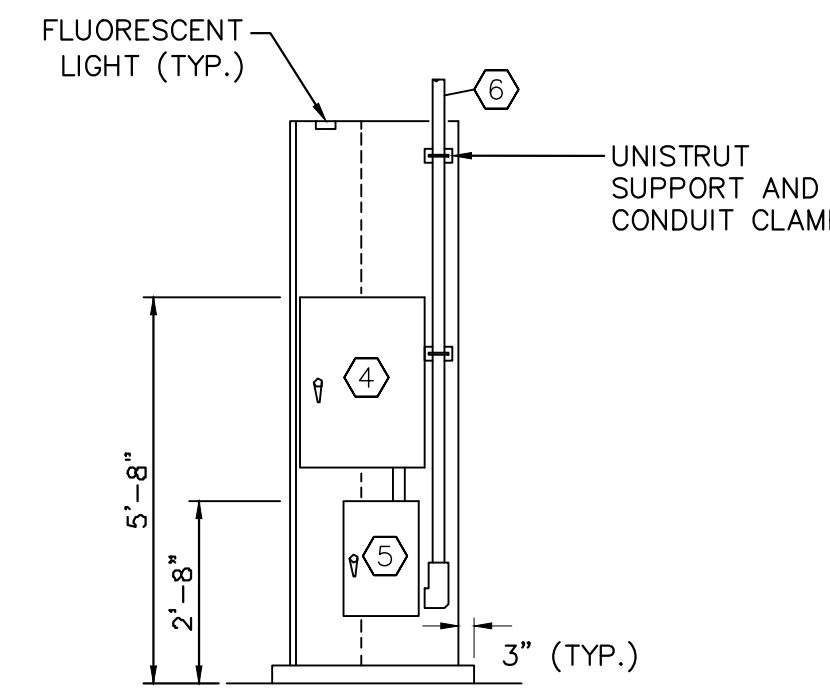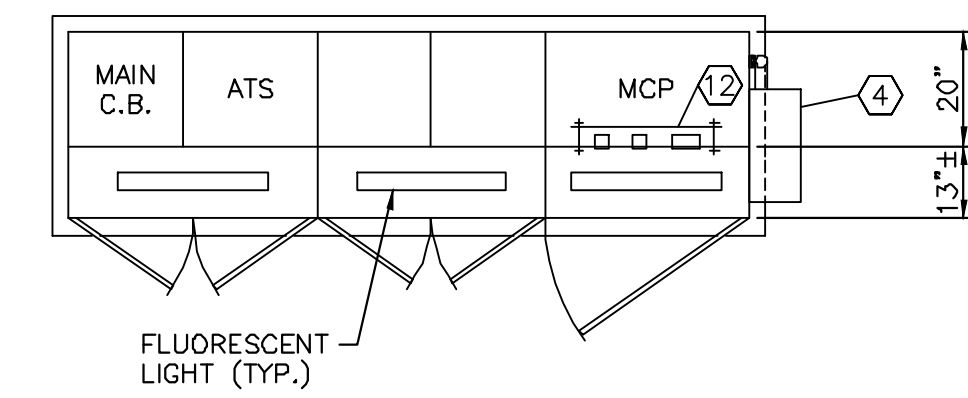

4 MCC PLAN AND SECTION VIEW
SCALE: NOT TO SCALE

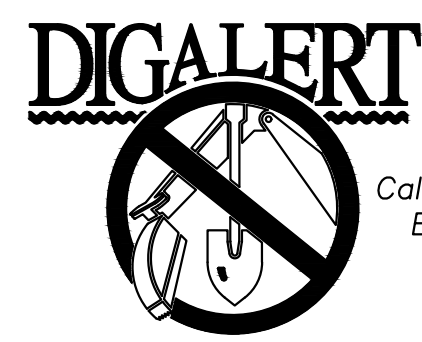


Call 2 Working Days Before You Dig! 811

BENCHMARK: NATIONAL GEODETIC SURVEY BENCHMARK NO. 1311 1.4 MILES WEST OF BEAUMONT ON INTERSTATE 10 TO SAN TIMOTEO CANYON NEAR FRONTAGE ROAD ON SOUTH(WEST) SIDE OF INTERSTATE 10, 0.1 MILES SOUTHWEST ALONG FRONTAGE ROAD, SOUTH ACROSS THE ROAD FROM A GUY POLE 25.8 FEET SOUTH OF THE CENTERLINE OF FRONTAGE ROAD, 1.8 FEET WEST OF POWERPOLE AND 1.8 FEET EAST OF A WITNESS POST, INSIDE A 4 INCH PVC PIPE WITH SCREW PLUG 1 INCH ABOVE GROUND (ELEVATION = 2468.07). ALSO SHOWN ON HIGHWAY 69 / POTRERO BLVD. INTERCHANGE STATIC GPS PROJECT CONTROL DIAGRAM AND IDENTIFIED THEREON AS 3558 BM D34374 WHEN THE PUBLISHED ELEVATION = 2468.07 IS CORRECTED WITH A MEASURED ELEVATION = 2468.01, USE HEREON. ELEV. 2468.01, (NVD '88), (STAMPED Q 1311 1978)

Table with columns: BY, MARK, DESCRIPTION, APPR., DATE. Includes a REVISIONS section.

Kimley & Horn logo and contact information. Includes signature of Michael A. Colombo, dated 8/23/2021.

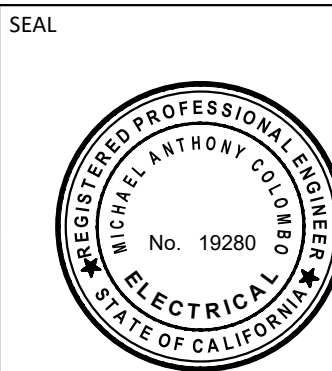


DESIGN BY: SLM DRAWN BY: RC/SW CHECKED BY: TW/SS SCALE: DATE: JOB NUMBER: 195284001




Reviewed By: Staff Engineer Date: Recommended for Approval: Administrative Engineer Date: 11/19/2021 Approved By: City Engineer/Director of Public Works Date: 11/23/2021 CITY OF BEAUMONT, PUBLIC WORKS DEPARTMENT ENGINEERING DIVISION

CITY OF BEAUMONT, CALIFORNIA IMPROVEMENT PLANS FOR: BEAUMONT CROSSROADS LIFT STATION ELECTRICAL SINGLE LINE AND SCHEDULES


SHEET 17 OF 38 SHEETS FILE NO: 3387

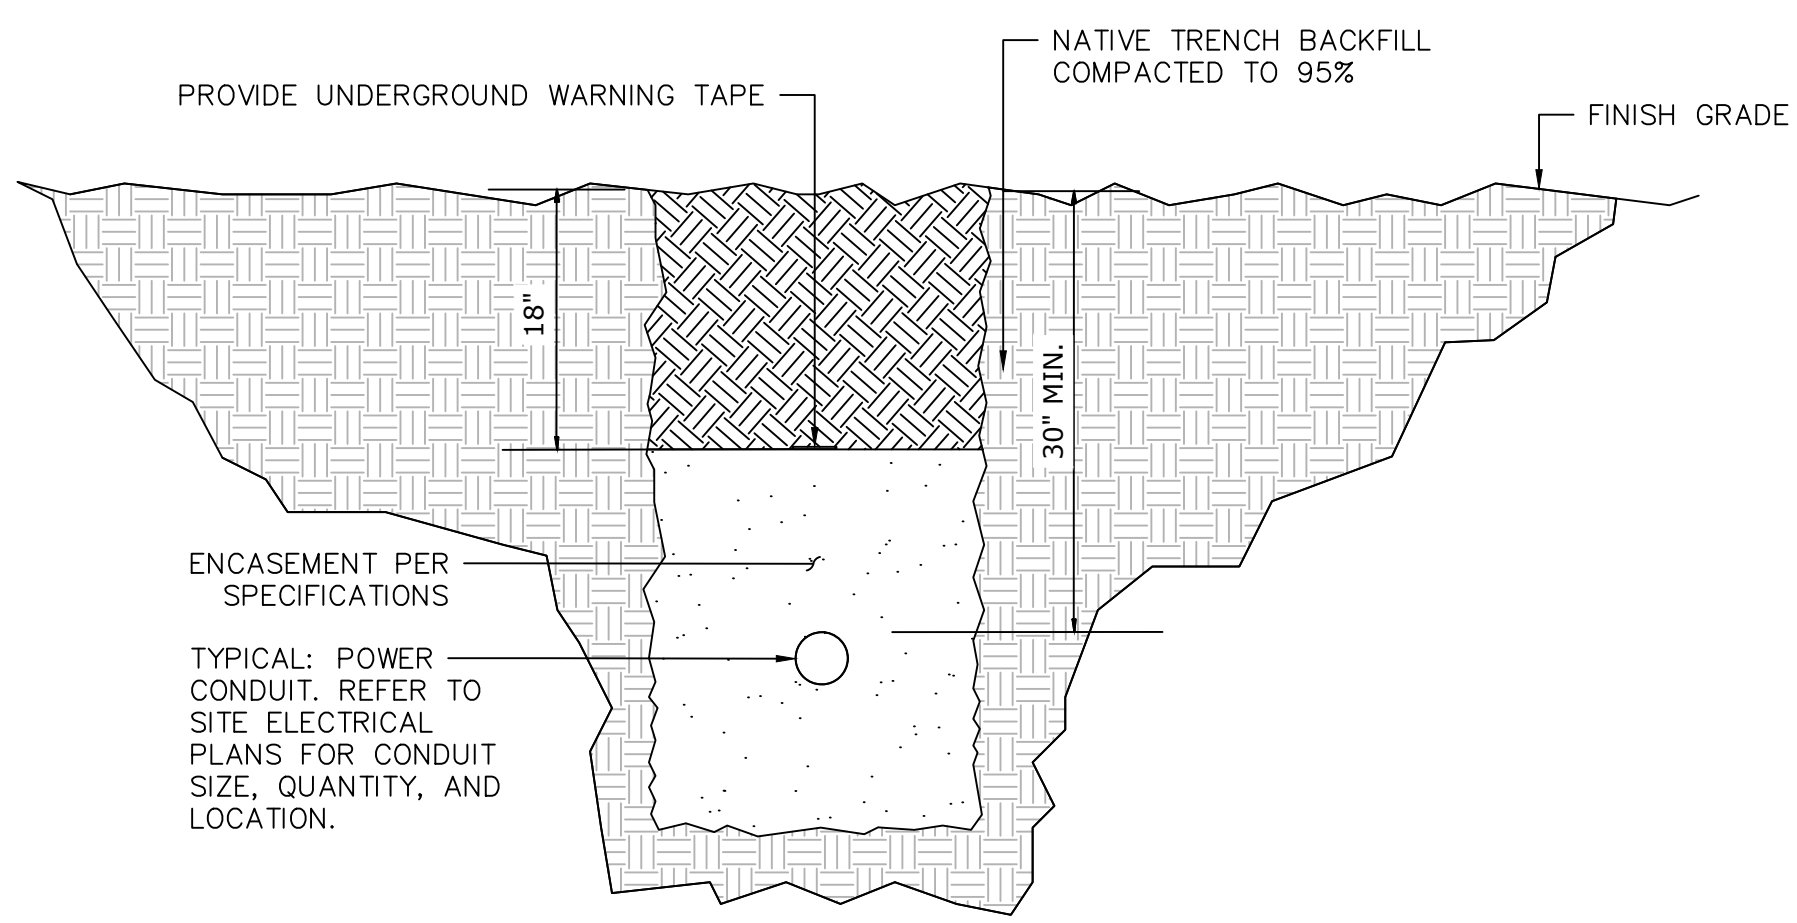



1
18 TRENCH DETAIL
NOT TO SCALE

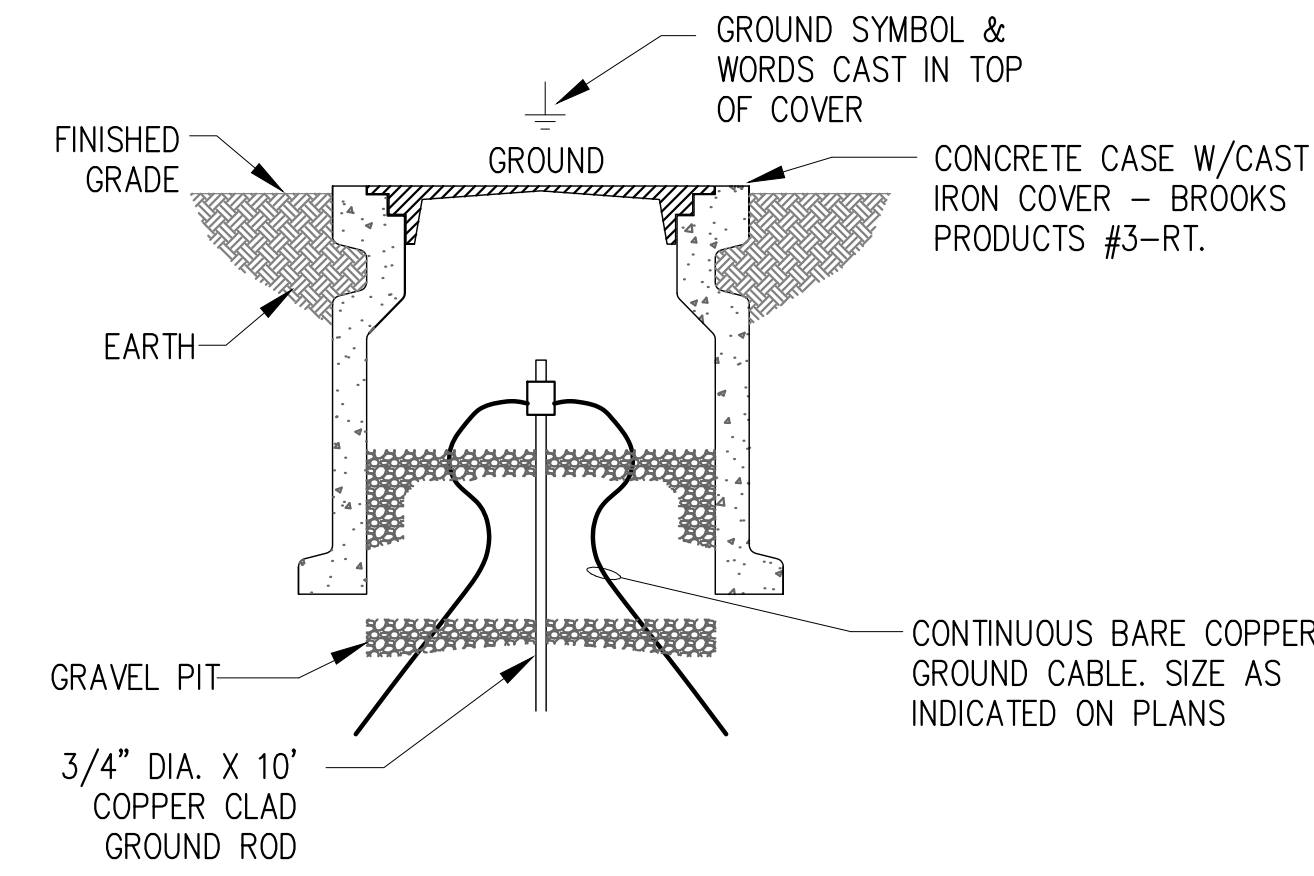

2
18 GROUND ROD & WELL DETAIL
NOT TO SCALE

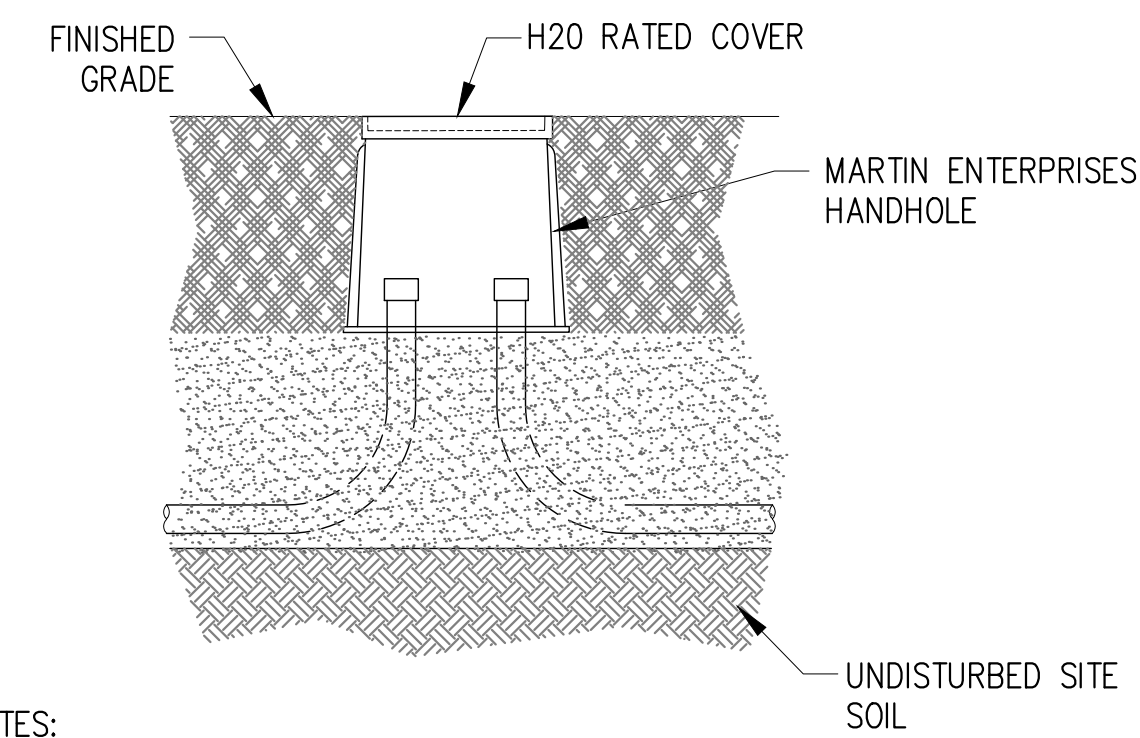


3
18 ELECTRICAL HANDHOLE DETAIL
SCALE: NOT TO SCALE

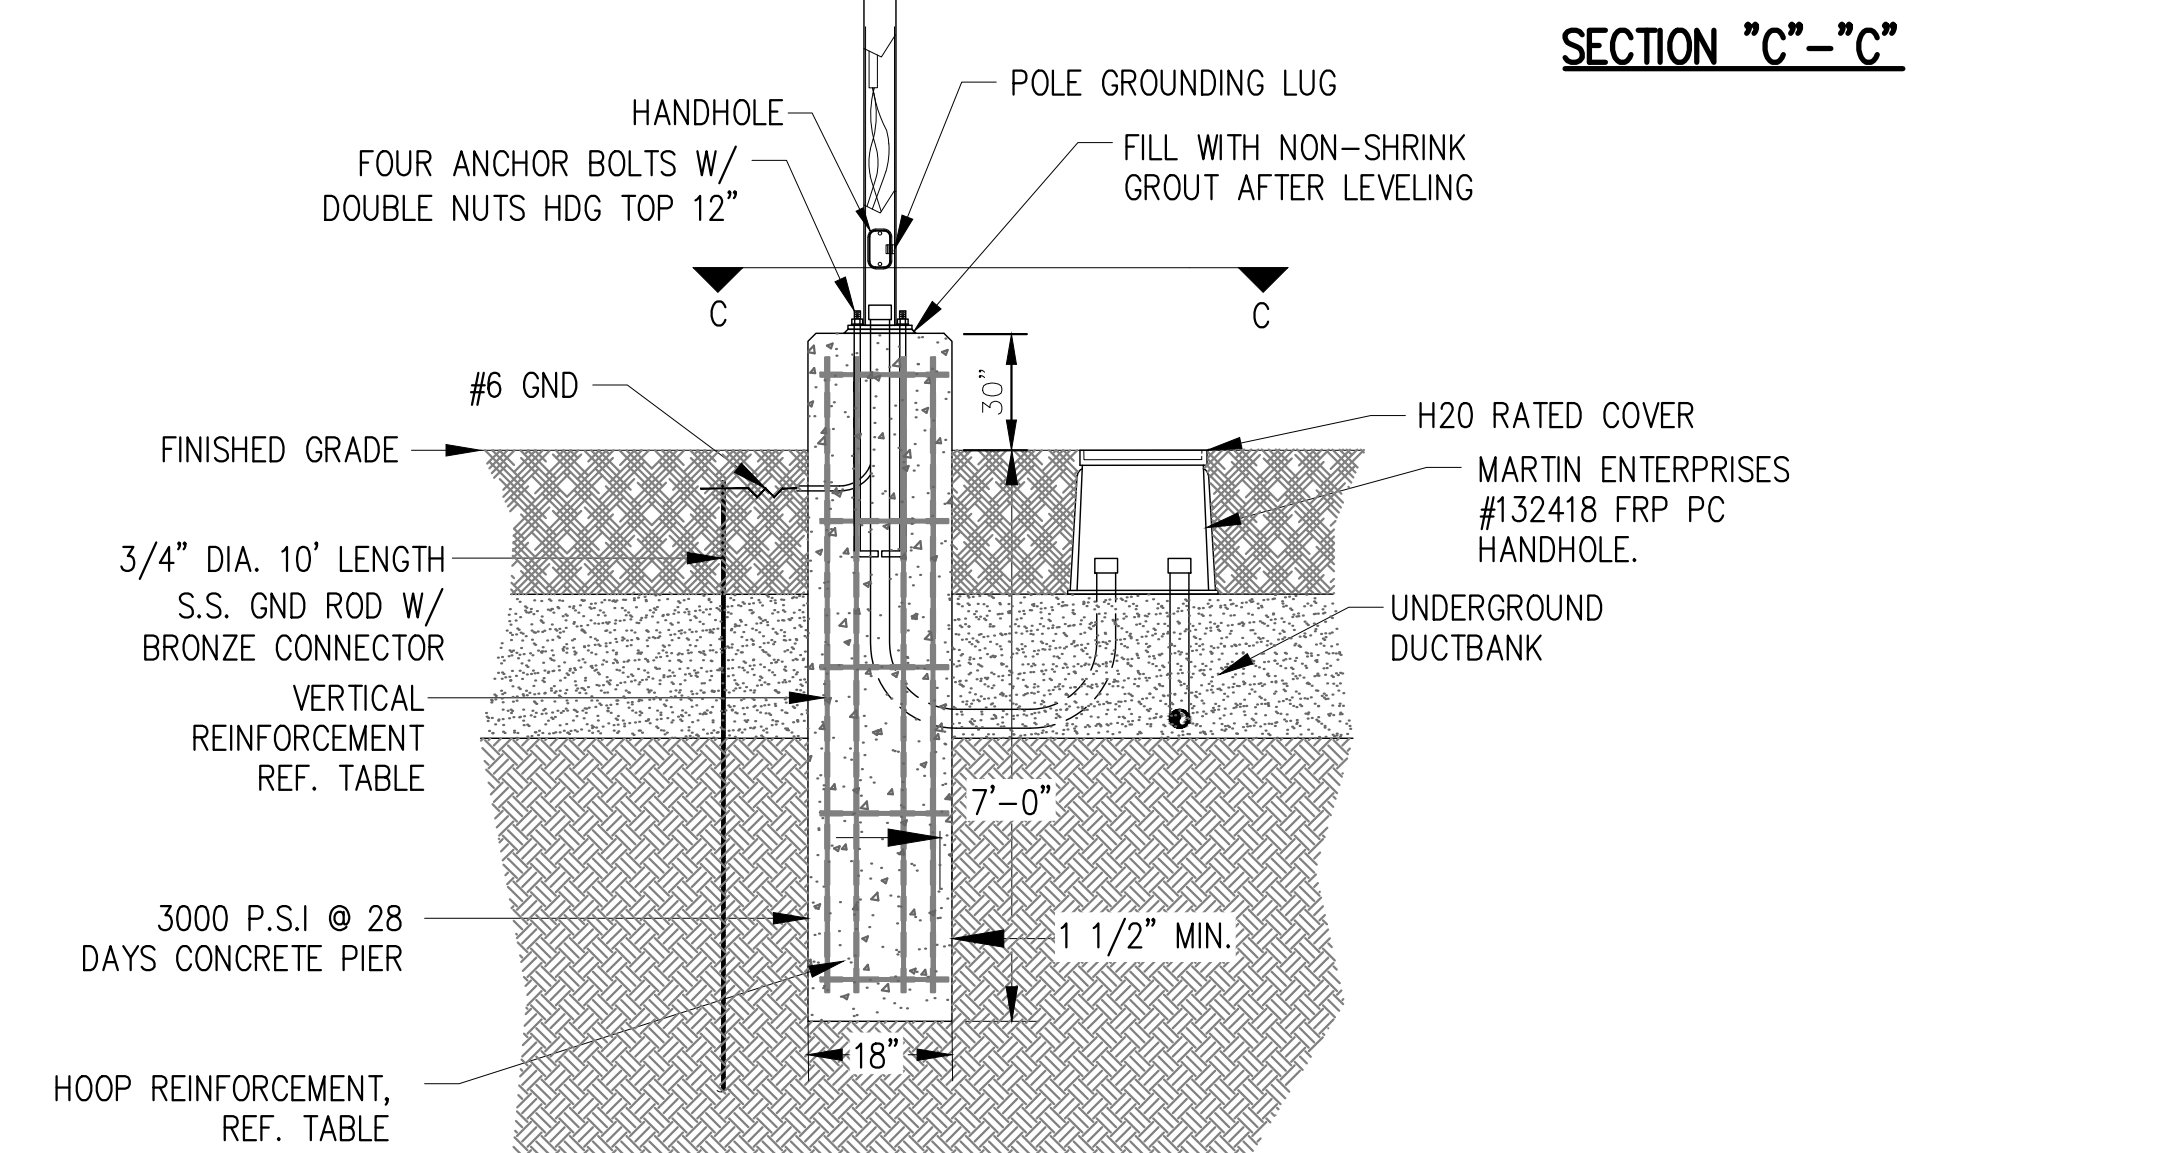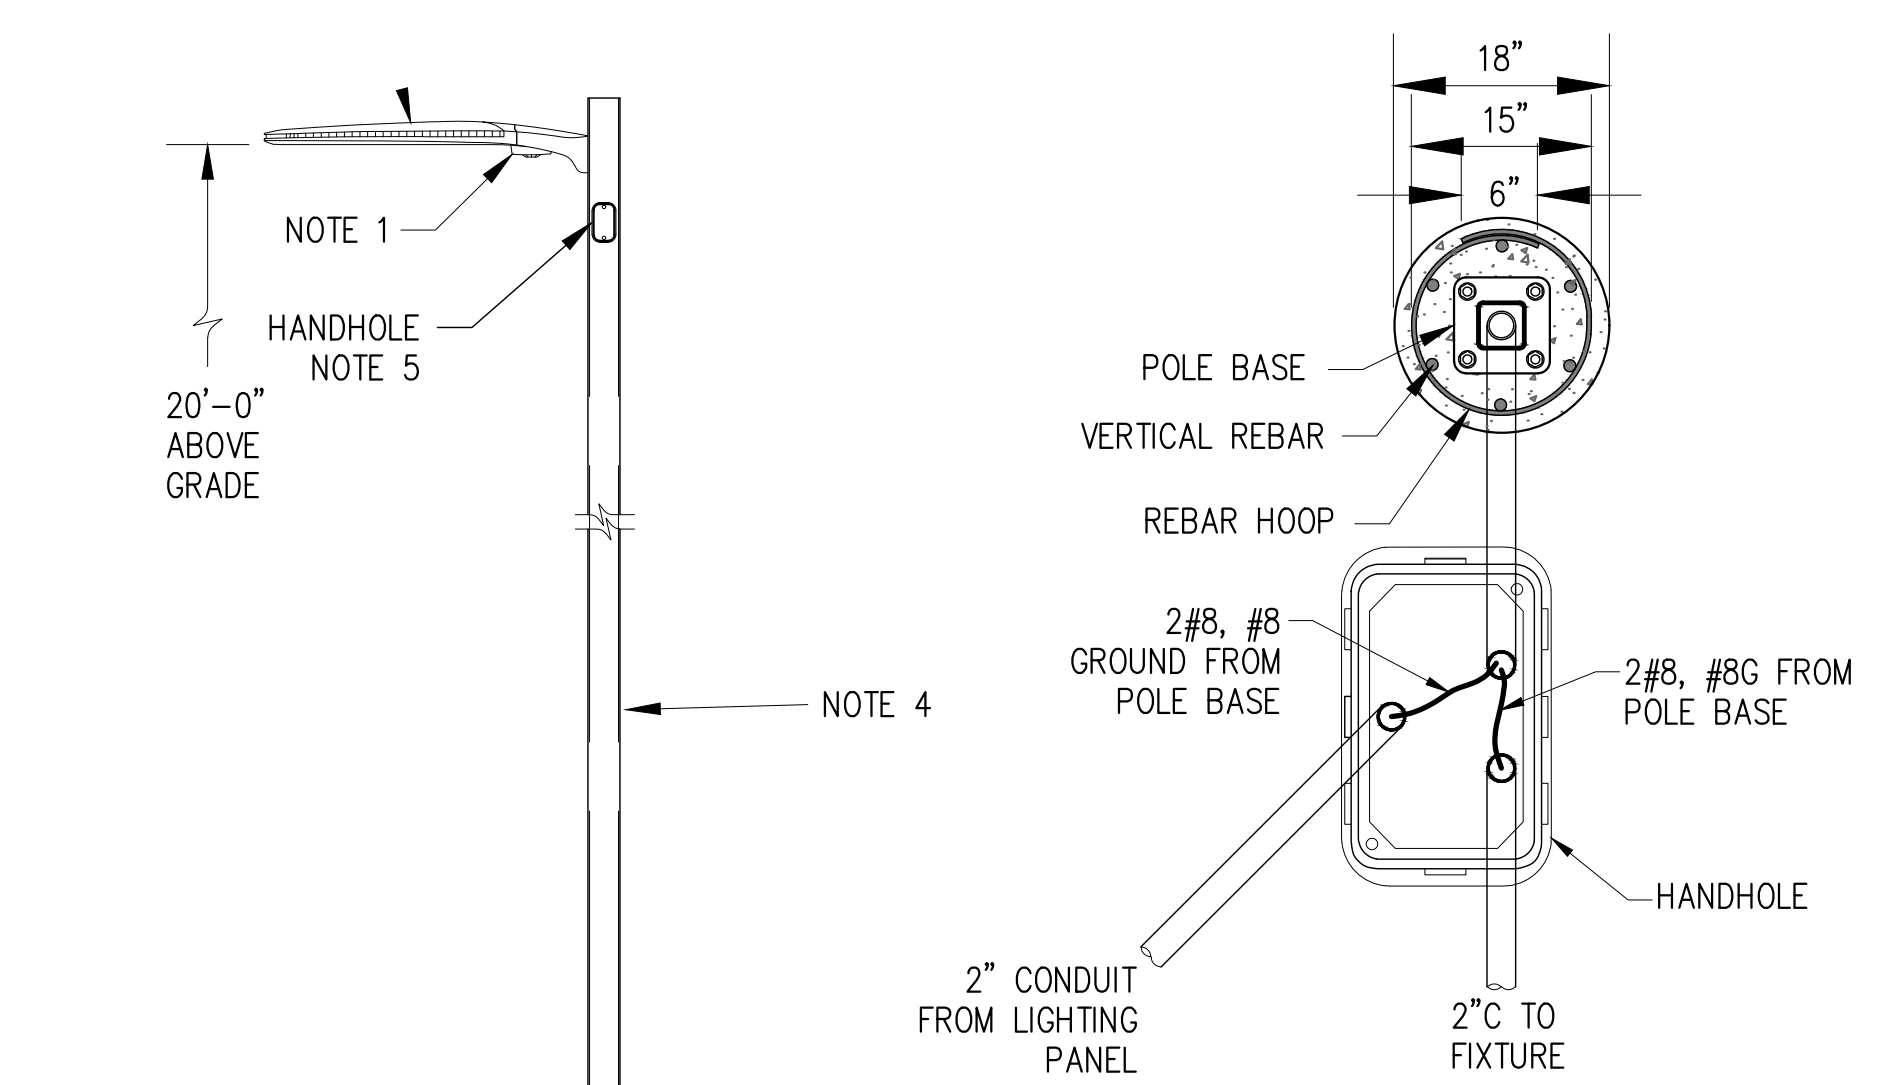

- NOTES:
- LITHONIA "P1RH" BI-LEVEL MOTION/AMBIENT SENSOR ON EACH POLE.
 - MOTION/AMBIENT SENSOR SHALL UTILIZE 100% DIGITAL PASSIVE INFRARED TECHNOLOGY THAT IS TUNED FOR WALKING-SIZED MOTION WHILE PREVENTING FALSE TRIPPING FROM THE ENVIRONMENT.
 - MOTION/AMBIENT SENSOR SHALL BE PROGRAMMED TO BE FULL-ON AT DUSK AND SHALL RAMP DOWN TO 30% AT 10:00 PM. IF MOTION IS DETECTED, SENSOR SHALL RAMP UP TO FULL POWER IN 3 SECONDS. AFTER MOTION IS NO LONGER DETECTED A 5 MINUTE TIME DELAY BEGINS. WHEN TIME DELAY EXPIRES, LIGHTS RAMP DOWN TO 30% POWER AND WILL REMAIN AT LOW LEVEL SETTING UNTIL NEW MOTION IS DETECTED, AT WHICH POINT THE LUMINARIE RAMP BACK UP TO 100% POWER. THIS CYCLE REPEATS ONCE THERE IS NO MOTION IN THE SPACE AGAIN. TEST & VERIFY OPERATION AFTER INSTALLATION.
 - POLE SHALL BE 4" SQUARE STRAIGHT STEEL RATED @ 100 MPH + 30% GUST FACTOR. POLE AND FIXTURE INSTALLATION SHALL UTILIZE THE SPECIFIED PRODUCTS. SHOULD A CONTRACTOR DESIRE TO SUBSTITUTE AN ALTERNATE LIGHT FIXTURE AND/OR POLE FOR THAT SPECIFIED, PRE-APPROVAL MUST BE GRANTED BY THE CITY AND THE ENGINEER AND A POINT-TO-POINT LIGHTING CALCULATION SHALL BE SUBMITTED FOR REVIEW. THIS DECISION TO ALLOW AN ALTERNATE WILL BE DETERMINED AFTER THE CONTRACT IS AWARDED.
 - PROVIDE HANDHOLE NEAR TOP OF POLE. MOUNT FUSE BLOCK NEAR UPPER HANDHOLE.

5
18 LIGHT FIXTURE & POLE INSTALLATION DETAIL
SCALE: NOT TO SCALE

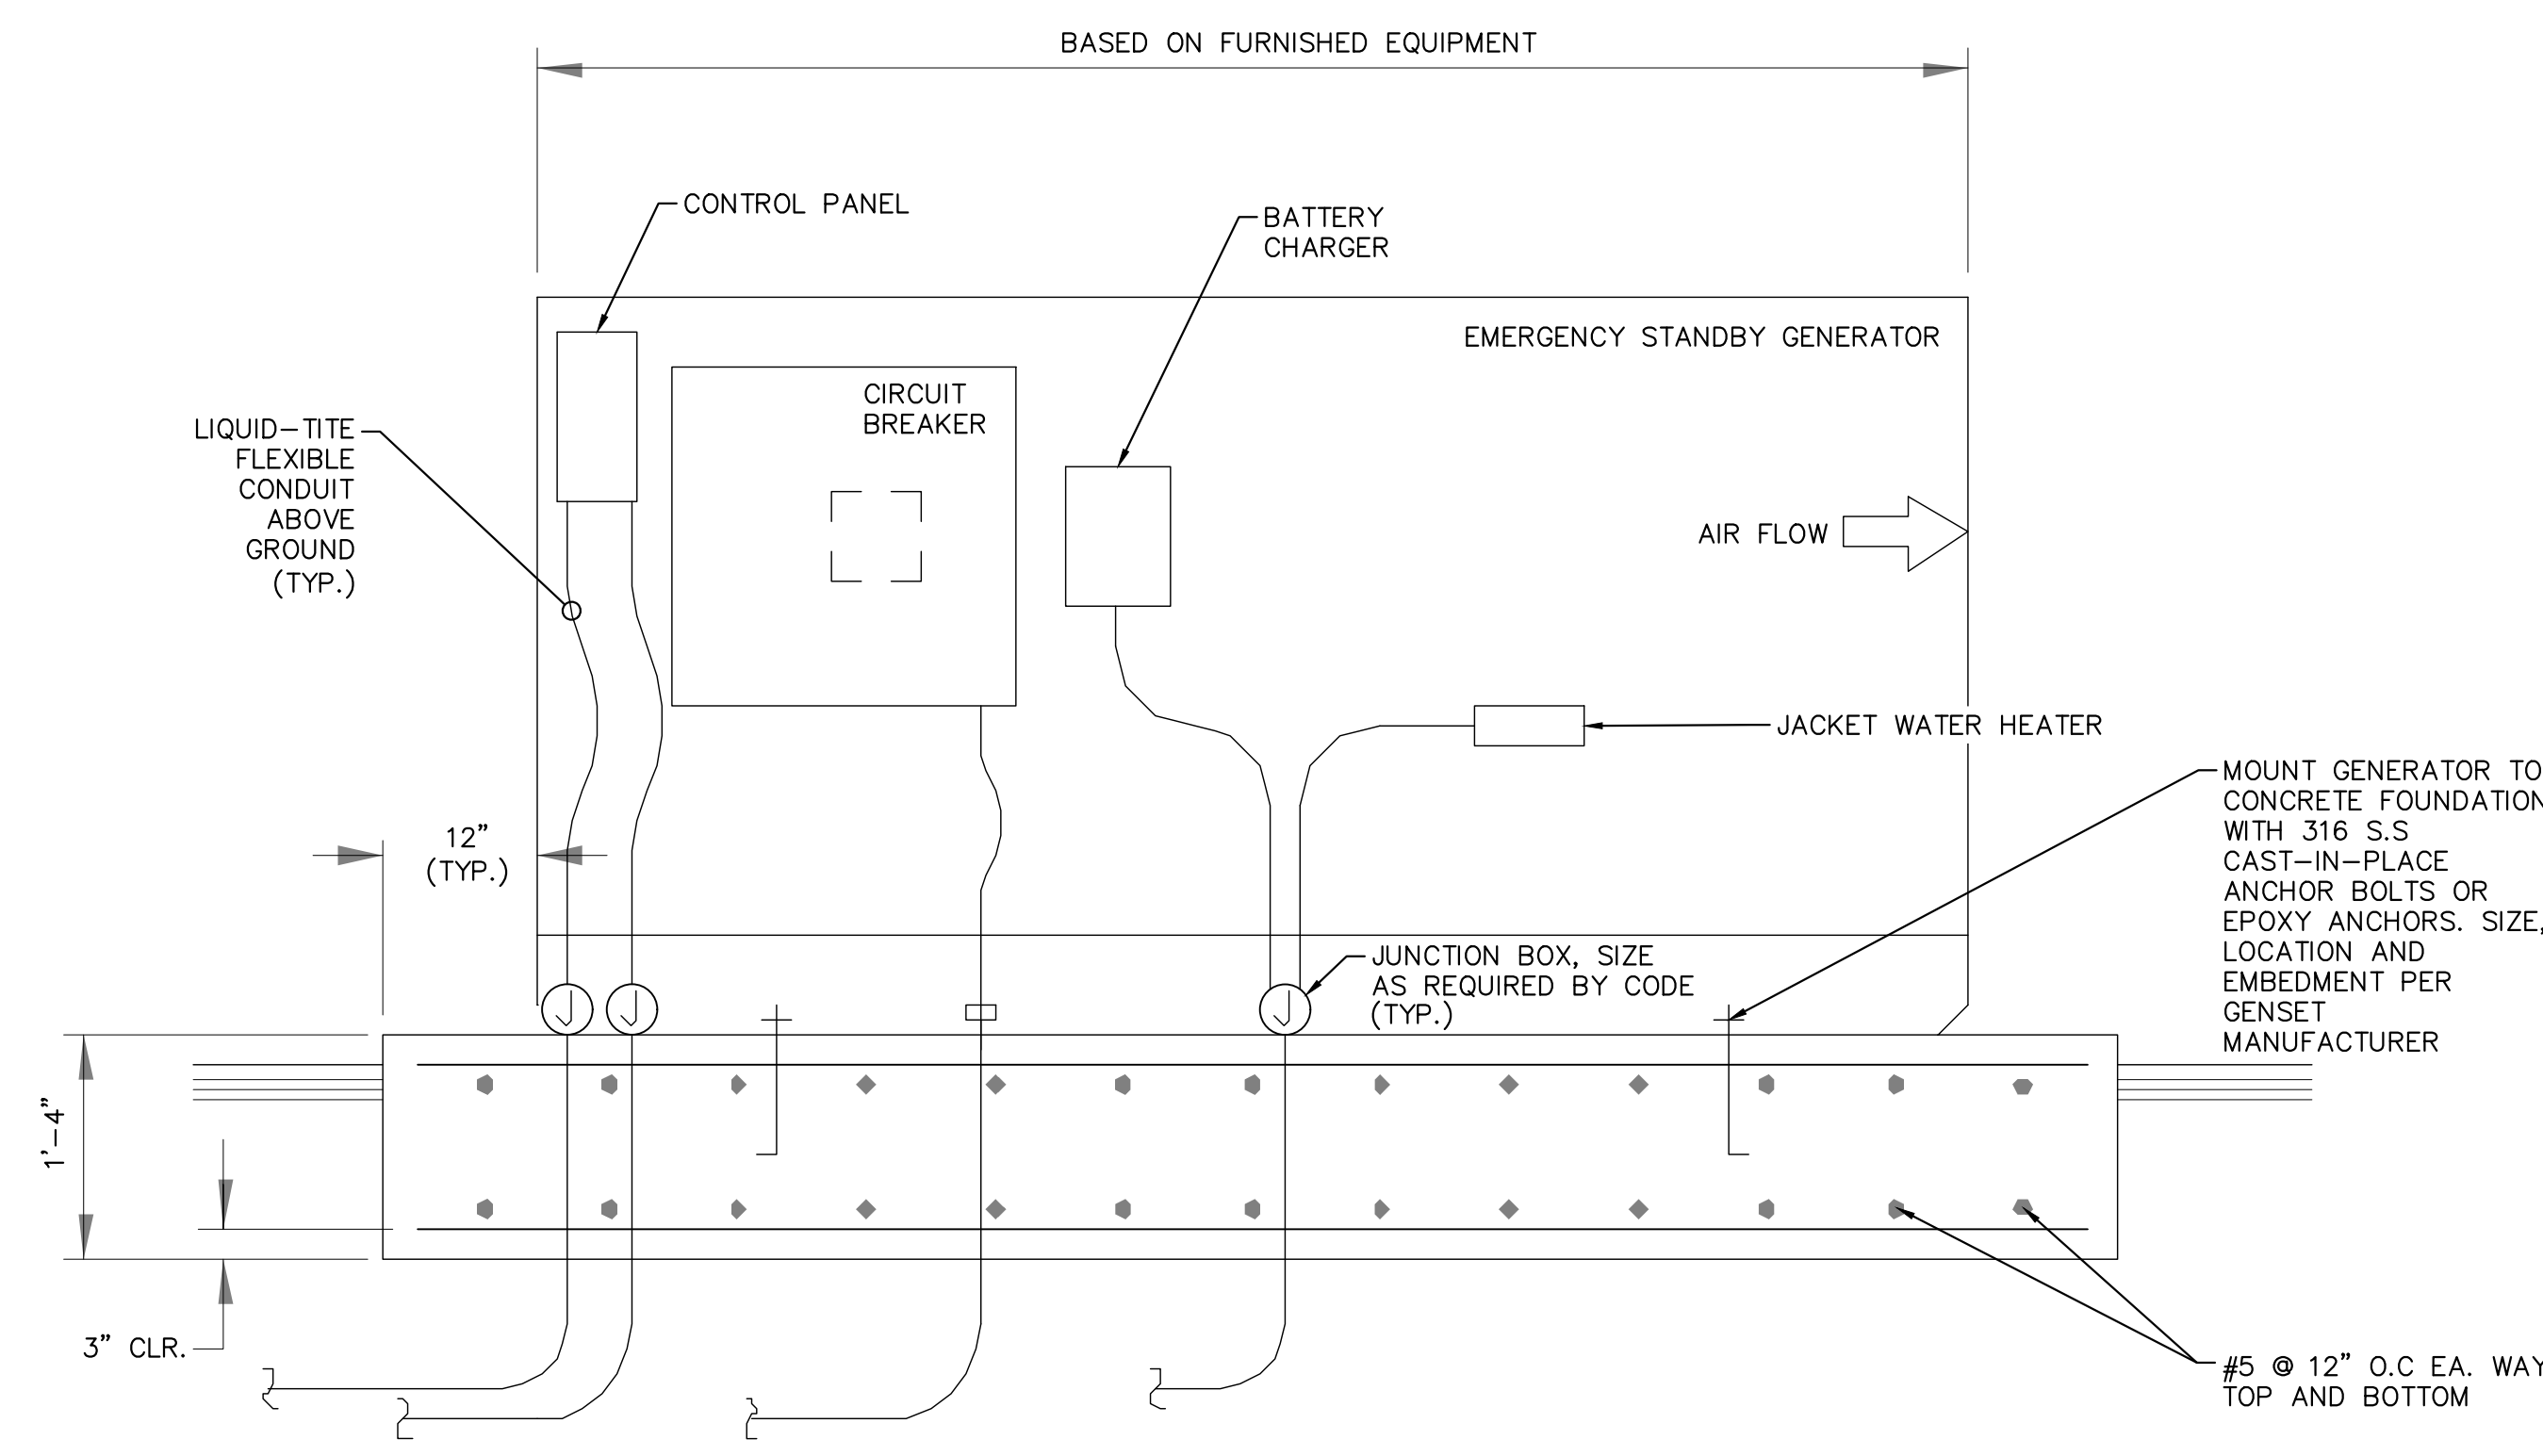

4
18 EMERGENCY STANDBY GENERATOR DETAIL
SCALE: NOT TO SCALE

BENCHMARK:
NATIONAL GEODETIC SURVEY BENCHMARK NO. 13111
1.4 MILES WEST OF BEAUMONT ON INTERSTATE 10 TO SAN TIMOTHY CANYON NEAR FRONTAGE ROAD ON SOUTH(WEST) SIDE OF INTERSTATE 10, 0.1 MILES SOUTHWEST ALONG FRONTAGE ROAD, SOUTH ACROSS THE ROAD FROM A GUY POLE 25.9 FEET SOUTH OF THE CENTERLINE OF FRONTAGE ROAD, 1.8 FEET WEST OF POWERPOLE AND 1.5 FEET EAST OF A WITNESS POST, INSIDE A 4 INCH PVC PIPE WITH SCREW PLUG 1 INCH ABOVE GROUND (ELEVATION = 2468.07). ALSO SHOWN ON HIGHWAY 69 / POTRERO BLVD. INTERCHANGE STATIC GPS PROJECT CONTROL DIAGRAM AND IDENTIFIED THEREON AS 3508 BM D3474 WHEN THE PUBLISHED ELEVATION = 2468.07 IS CORRECTED WITH A MEASURED ELEVATION = 2468.01, USED HEREON.
ELEV. 2468.01, (NVD '88), (STAMPED Q 1311 1978)

BY	MARK	DESCRIPTION	APPR.	DATE
ENGINEER		REVISIONS	CITY	


Kimley»Horn	401 B Street, Suite 600, San Diego, CA 92101 Phone: (619) 234-9411 WWW.KIMLEY-HORN.COM
	DESIGN BY: SLM DRAWN BY: RC/SW CHECKED BY: TW/SS SCALE: DATE: JOB NUMBER: 195284001
	Reviewed By: _____ Date: _____ Staff Engineer Recommended for Approval By: _____ Date: 11/19/2021 Administrative Engineer Approved By: _____ Date: 11/23/2021 City Engineer/Director of Public Works
	CITY OF BEAUMONT, CALIFORNIA IMPROVEMENT PLANS FOR: BEAUMONT CROSSROADS LIFT STATION ELECTRICAL DETAILS 1

	DESIGN BY: SLM DRAWN BY: RC/SW CHECKED BY: TW/SS SCALE: DATE: JOB NUMBER: 195284001		Reviewed By: _____ Date: _____ Staff Engineer
			Recommended for Approval By: _____ Date: 11/19/2021 Administrative Engineer
			Approved By: _____ Date: 11/23/2021 City Engineer/Director of Public Works
		CITY OF BEAUMONT, PUBLIC WORKS DEPARTMENT ENGINEERING DIVISION	

CITY OF BEAUMONT, CALIFORNIA IMPROVEMENT PLANS FOR: BEAUMONT CROSSROADS LIFT STATION ELECTRICAL DETAILS 1	S H E E T 18 OF 38 SHEETS FILE NO. 3387
---	--

Plotted By: VuQuhner, Sam, Sheet Set: BEAUMONT LIFT STATION, Electrical Details 1, October 20, 2021, 10:50:41am, K:\NSD_WATER\195284001_Beaumont Lift Station\Design\Plan Sheets - 2020\DELTA SET\195284001 - EL DELTA.dwg


Plotted By: V:\...\m\st\105284001\Beamont Lift Station\Design\Plan_Sheets - 2020\DELTA SET\195284001 - EL DELTA.dwg
 K:\SND_WATER\195284001_ Beamont Lift Station\Design\Plan_Sheets - 2020\DELTA SET\195284001 - EL DELTA.dwg

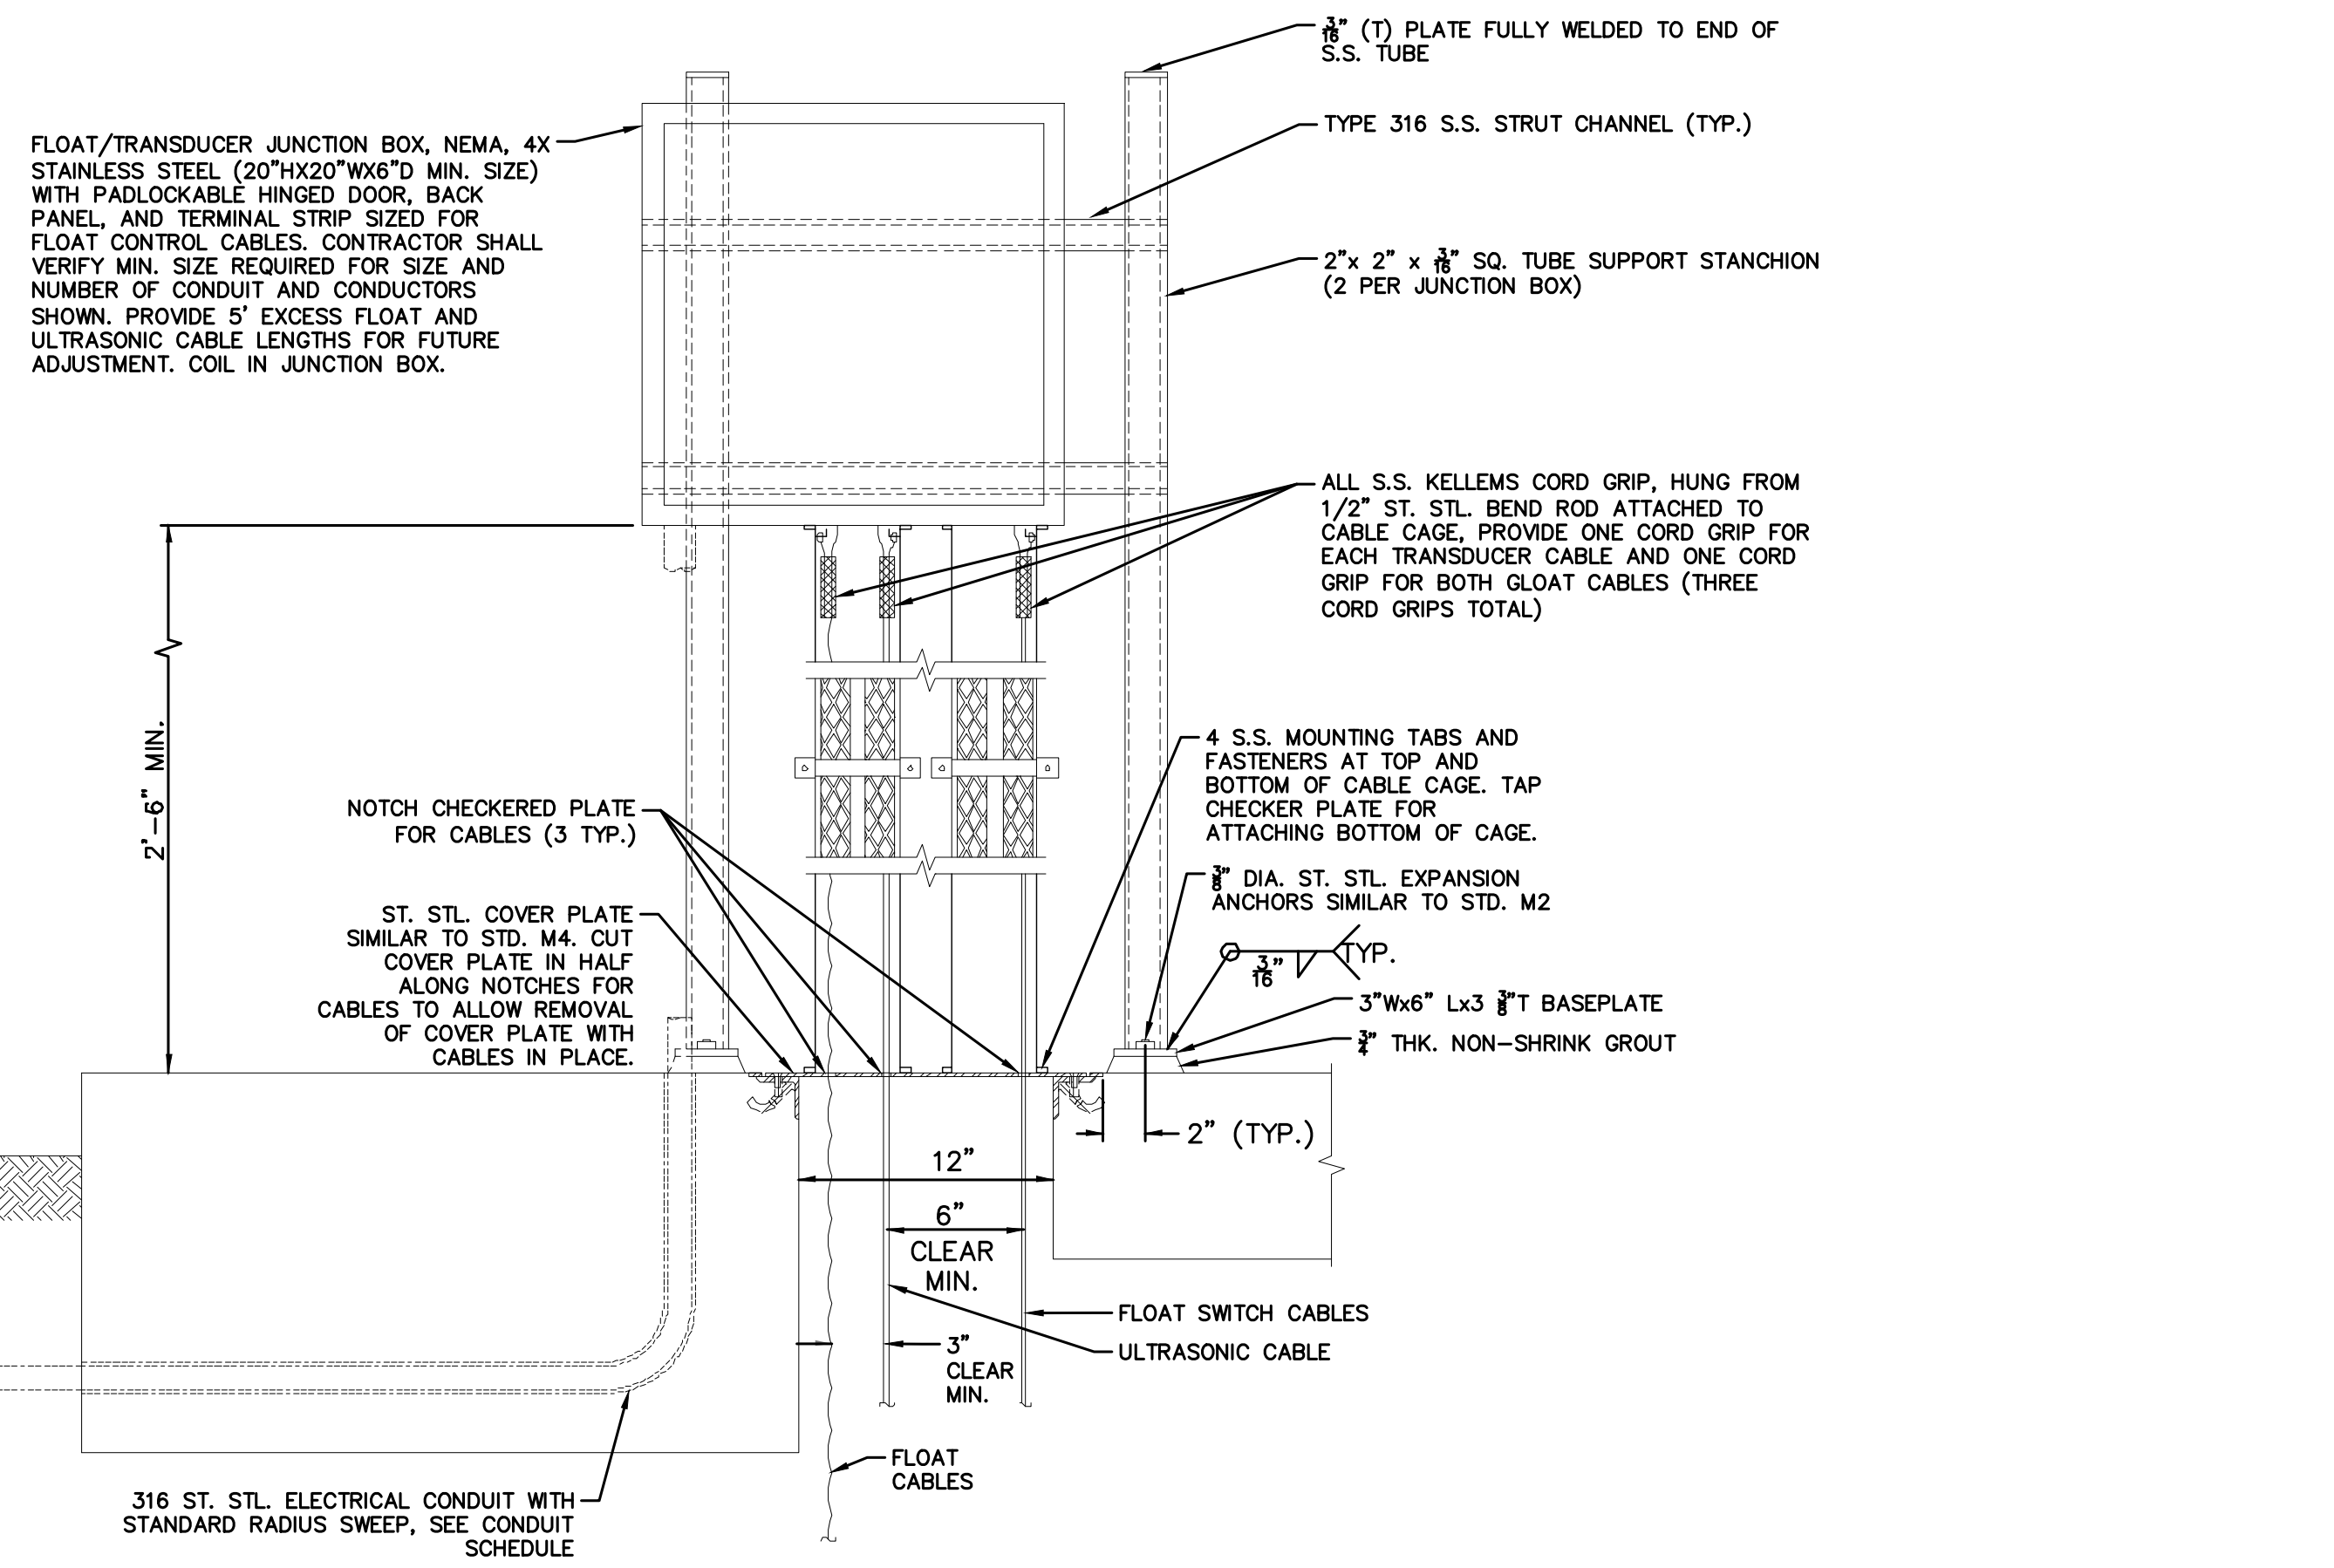

- NOTES:
1. JUNCTION BOX SUPPORT STANCHIONS SHALL BE CONSTRUCTED OF 316 STAINLESS STEEL.
 2. CONTRACTOR SHALL SUBMIT SHOP DRAWINGS FOR CABLE CAGE TO THE CITY FOR APPROVAL PRIOR TO FABRICATION.
 3. WET WELL SHAFT NOT SHOWN FOR CLARITY.
 4. LEVEL TRANSDUCER CABLE CONTINUOUS TO LEVEL CONTROLLER IN MCP.
 5. ELECTRICAL PULL BOX NOT SHOWN FOR CLARITY.

1
19

FLOAT SWITCH/LEVEL TRANSDUCER JUNCTION BOX
DETAIL
NOT TO SCALE

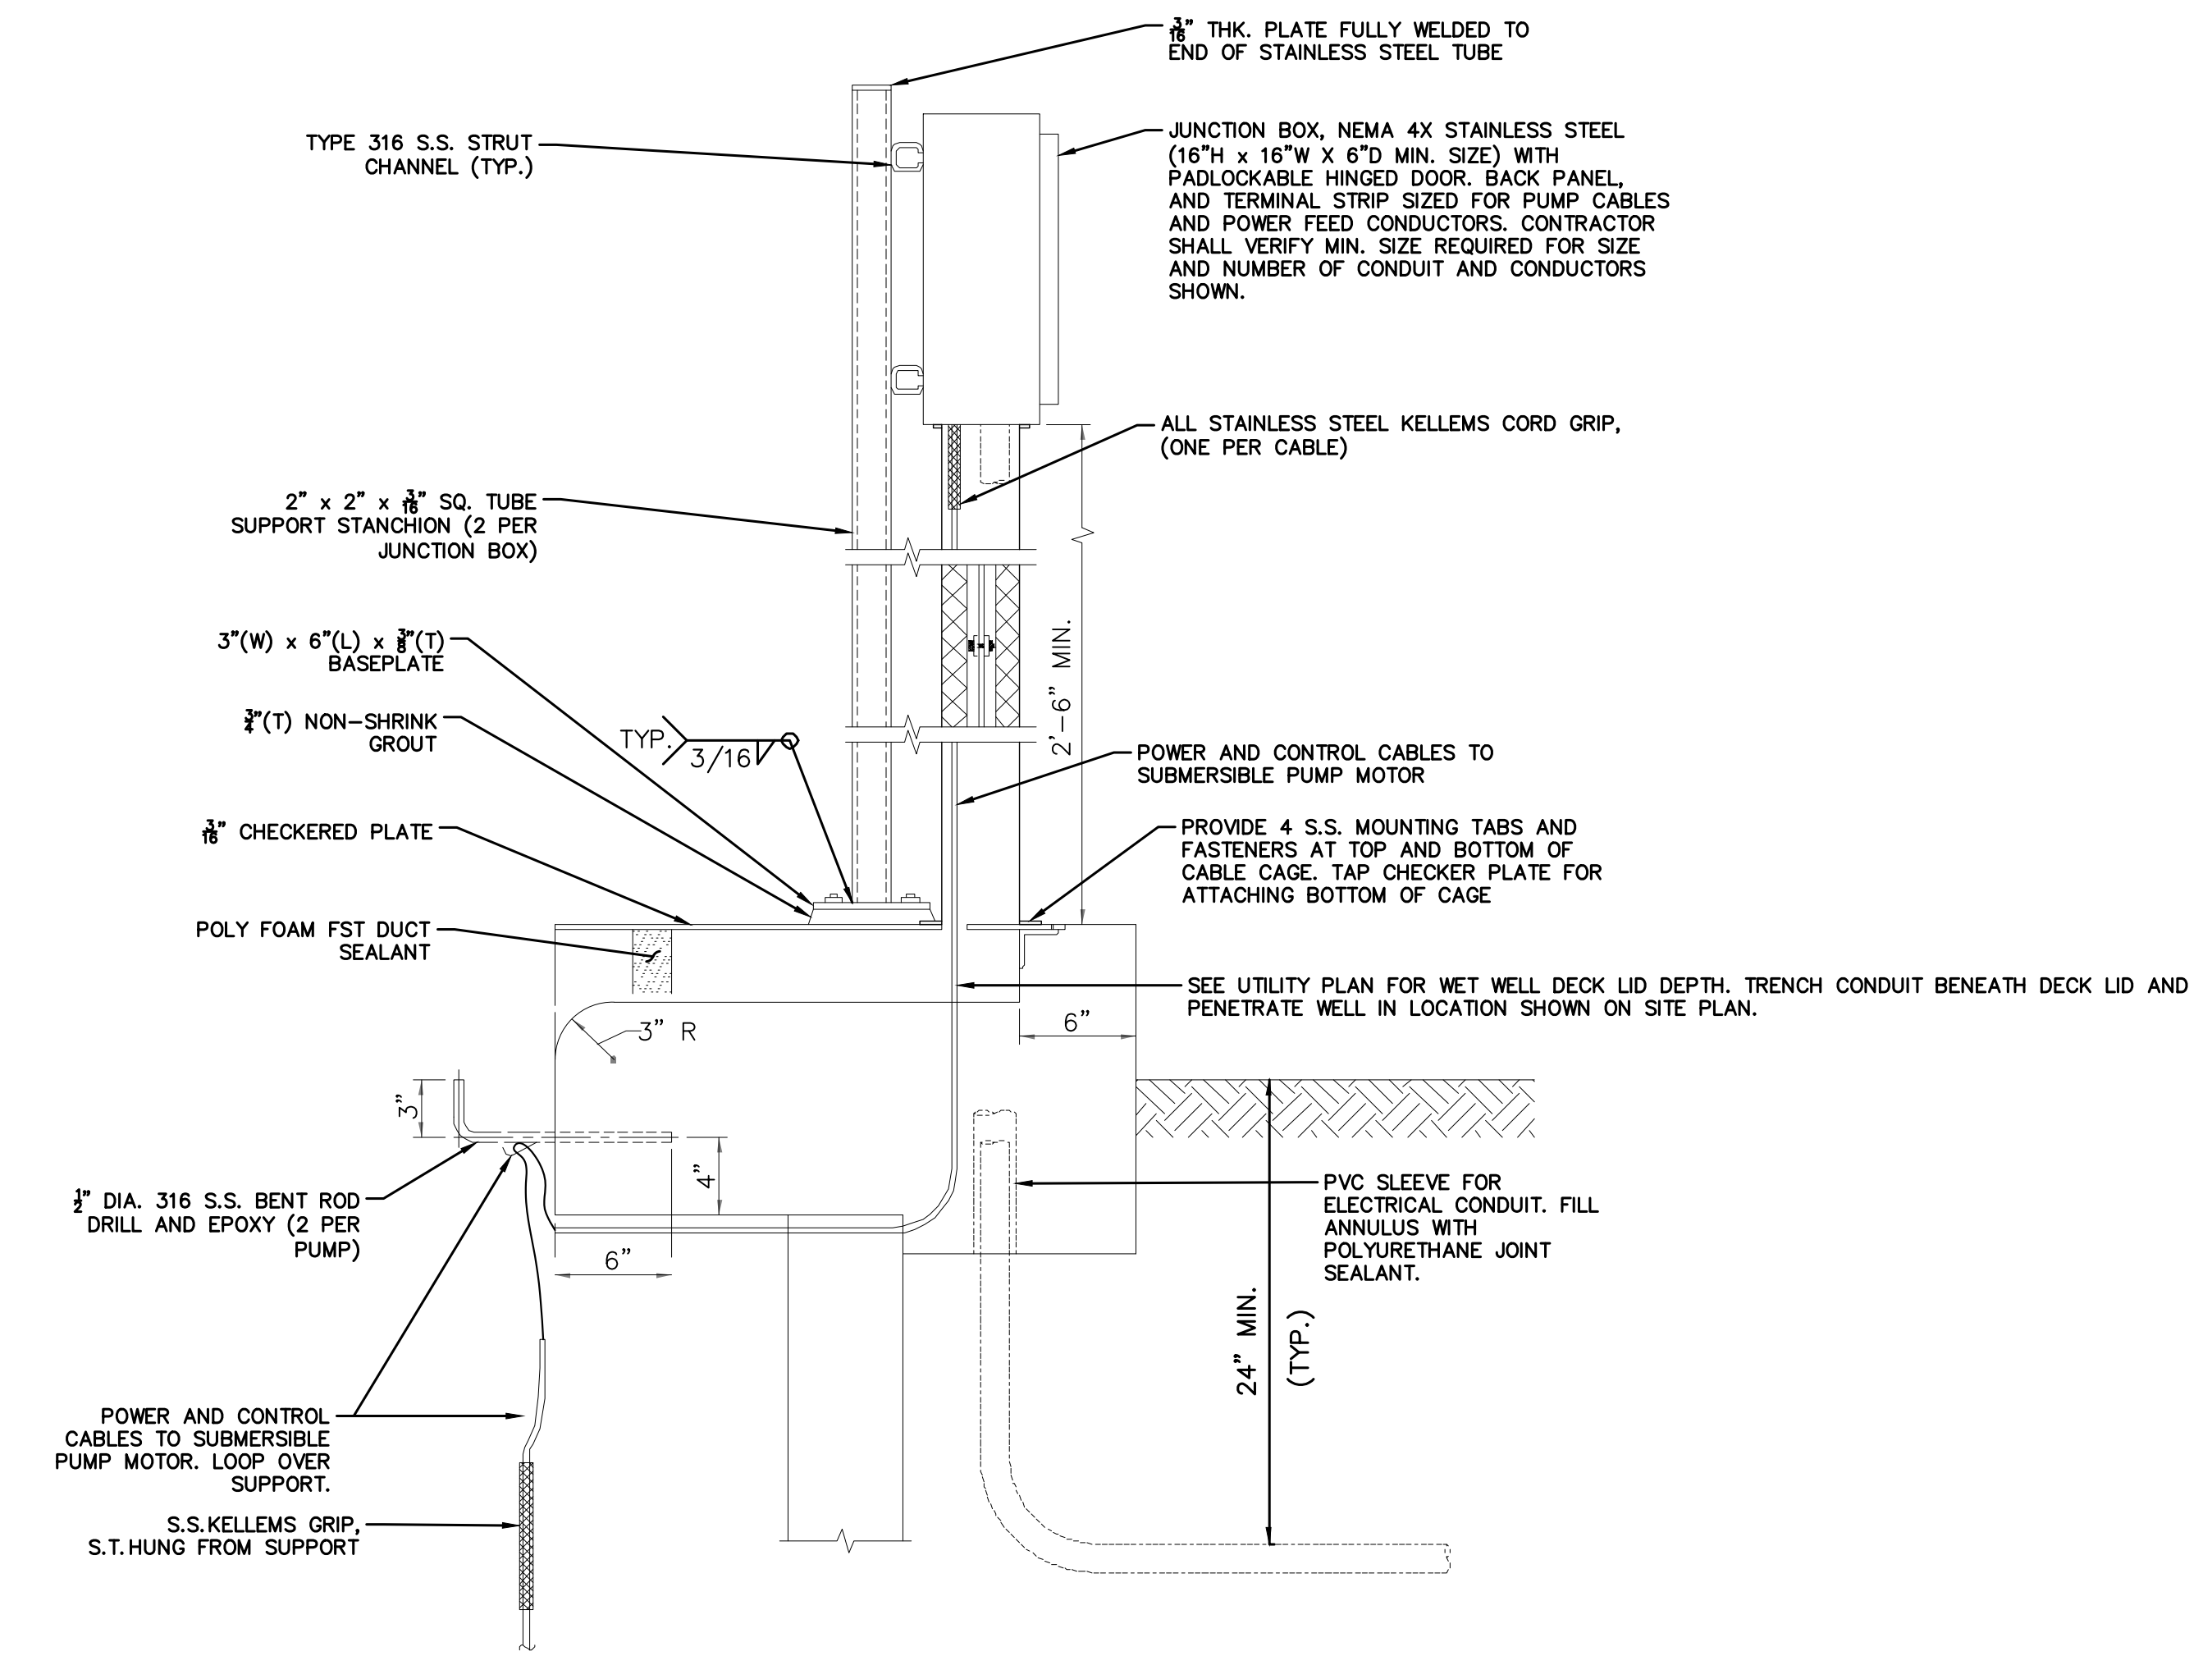

- NOTES:
1. JUNCTION BOX SUPPORT STANCHIONS SHALL BE CONSTRUCTED OF 316 STAINLESS STEEL.
 2. CONTRACTOR SHALL SUBMIT SHOP DRAWINGS FOR PUMP CABLE CAGE TO THE CITY FOR APPROVAL PRIOR TO FABRICATION.

2
19

PUMP POWER JUNCTION BOX
DETAIL
NOT TO SCALE




BENCHMARK:
 NATIONAL GEODETIC SURVEY BENCHMARK NO. 1311
 1.4 MILES WEST OF BEAUMONT ON INTERSTATE 10 TO SAN TIMOTEY CANYON NEAR FRONTAGE ROAD ON SOUTH(WEST) SIDE OF INTERSTATE 10, 0.1 MILES SOUTHWEST ALONG FRONTAGE ROAD, SOUTH ACROSS THE ROAD FROM A GUY POLE 25.8 FEET SOUTH OF THE CENTERLINE OF FRONTAGE ROAD, 1.6 FEET WEST OF POWERPOLE AND 1.6 FEET EAST OF A WITNESS POST, INSIDE A 4 INCH PVC PIPE WITH SCREW PLUG 1 INCH ABOVE GROUND (ELEVATION = 2468.07). ALSO SHOWN ON HIGHWAY 69 / POTRERO BLVD. INTERCHANGE STATIC GPS PROJECT CONTROL DIAGRAM AND IDENTIFIED THEREON AS 3558 BM D3474 WHEREIN THE PUBLISHED ELEVATION = 2468.07 IS CORRECTED WITH A MEASURED ELEVATION = 2468.01, USED HEREON.
 ELEV. 2468.01, (NVD '88), (STAMPED Q 1311 1978)

BY	MARK	DESCRIPTION	APPR.	DATE
R E V I S I O N S				
ENGINEER				CITY

Kimley»Horn
 401 B Street, Suite 600, San Diego, CA 92101
 Phone: (619) 234-9411
 WWW.KIMLEY-HORN.COM

Michael A. Colombo
 R.C.E. 19280
 8/23/2021

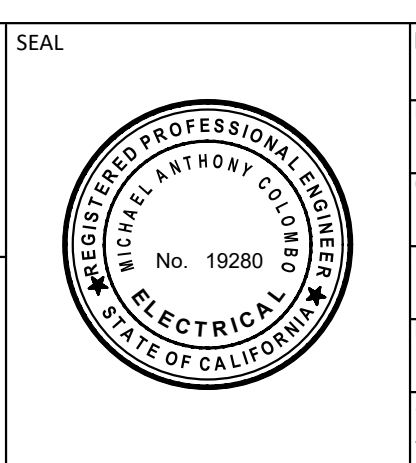


DESIGN BY: SLM
 DRAWN BY: RC/SW
 CHECKED BY: TW/SS
 SCALE:
 DATE:
 JOB NUMBER: 195284001

Reviewed By: _____ Staff Engineer Date: _____
 Recommended for Approval By: _____ Administrative Engineer Date: 11/19/2021
 Approved By: _____ City Engineer/Director of Public Works Date: 11/23/2021


CITY OF BEAUMONT, PUBLIC WORKS DEPARTMENT
 ENGINEERING DIVISION
 5506 6th St
 Beaumont, CA 92223
 TEL: (951) 769-8520 FAX: (951) 769-8526

CITY OF BEAUMONT, CALIFORNIA
 IMPROVEMENT PLANS FOR:
**BEAUMONT CROSSROADS
 LIFT STATION**
 ELECTRICAL DETAILS 2


S H E E T
19
 OF 38 SHEETS
 FILE NO.: 3387

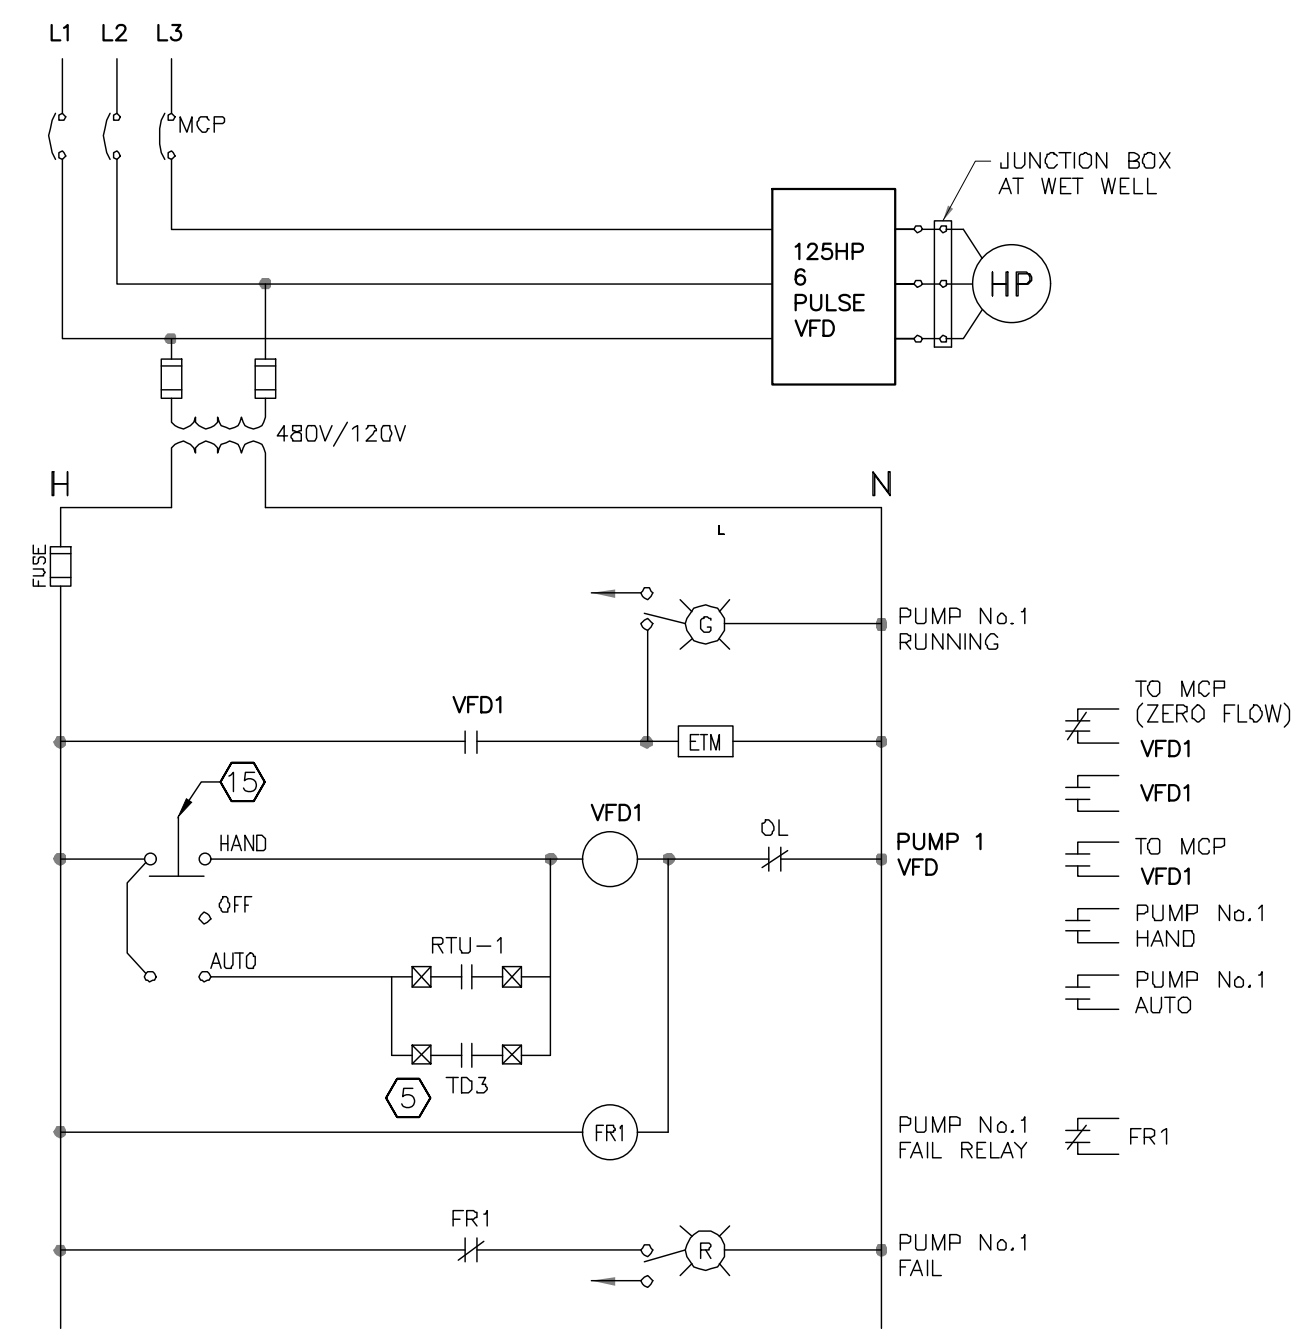


1
20 PUMP 1 CONTROL
LOCATED IN THE MCC BUCKET

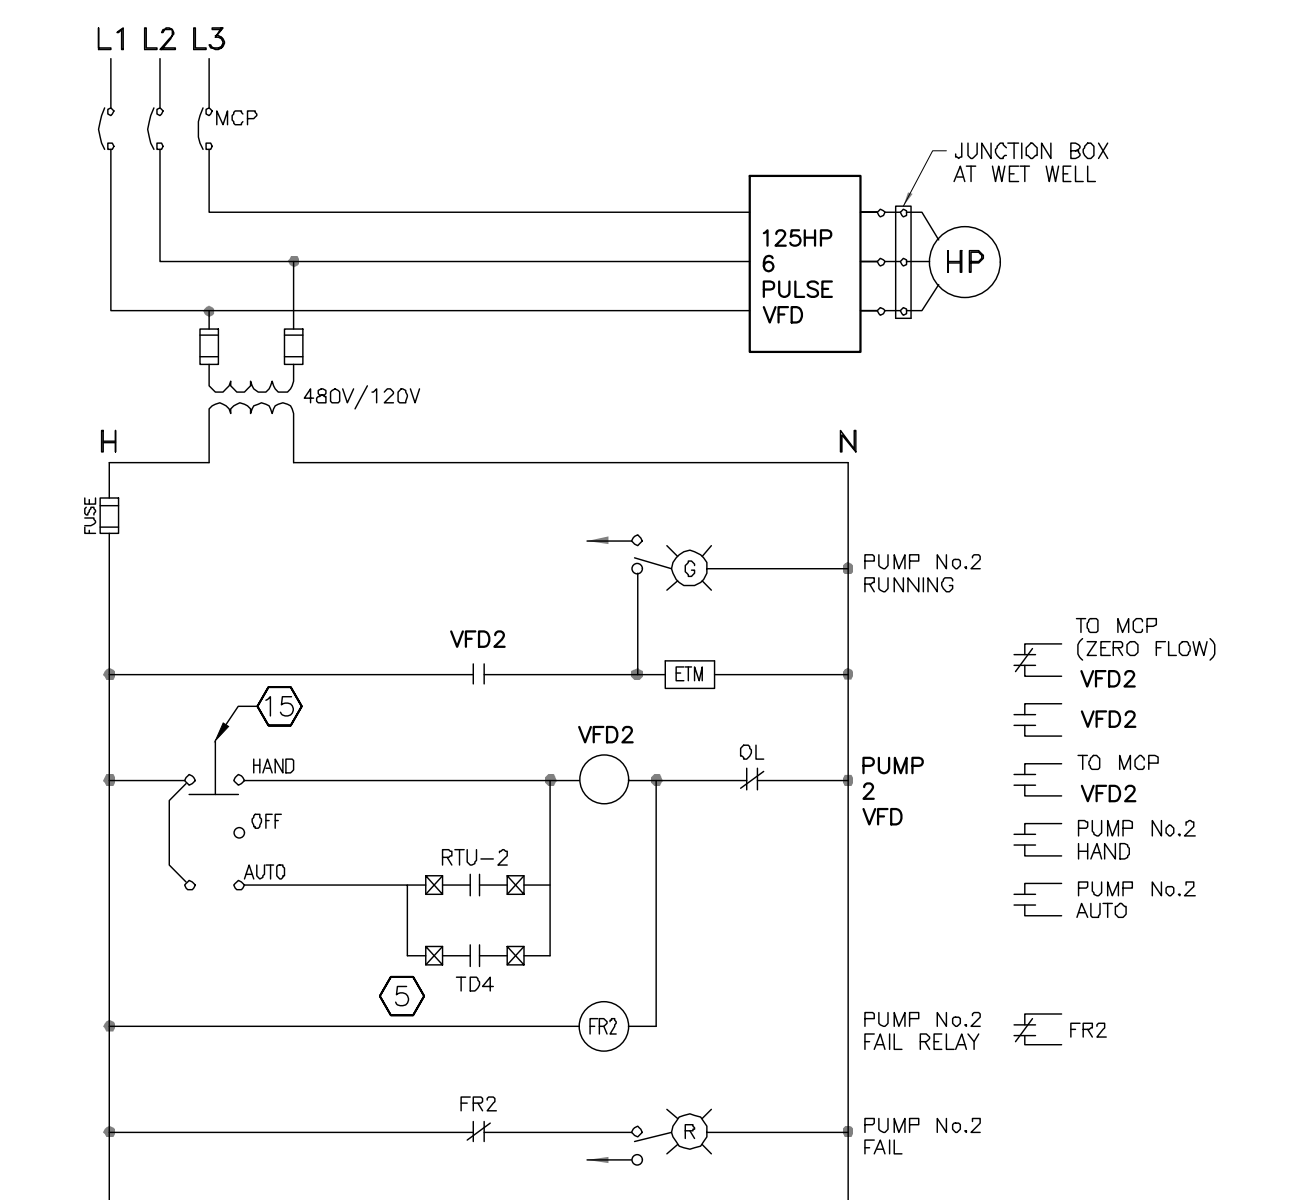


2
20 PUMP 2 CONTROL
LOCATED IN THE MCC BUCKET

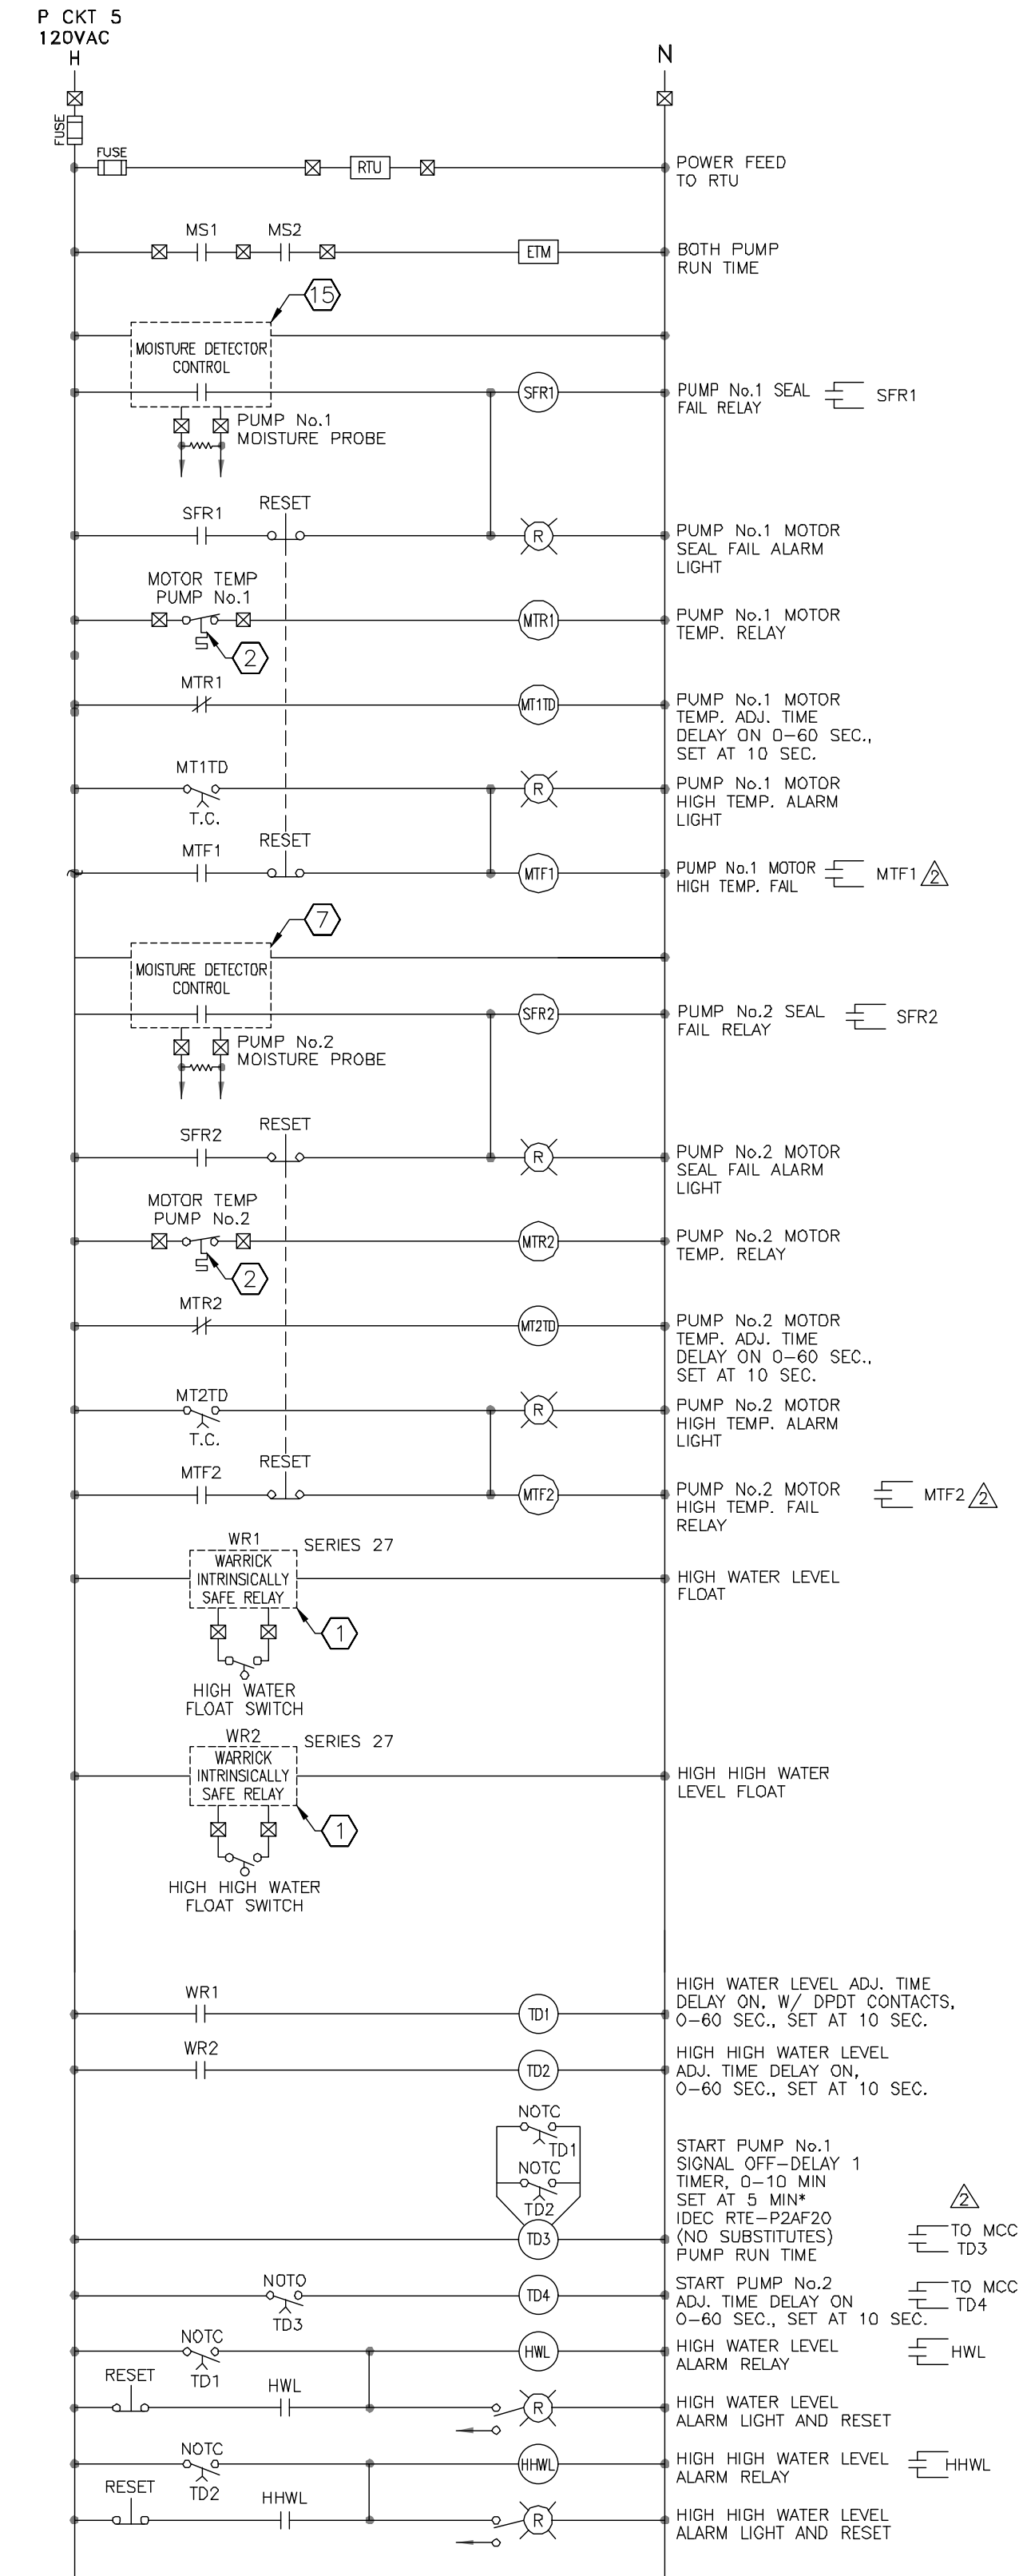


3
20 MCP CONTROL DIAGRAM
LOCATED IN THE MCP PANEL

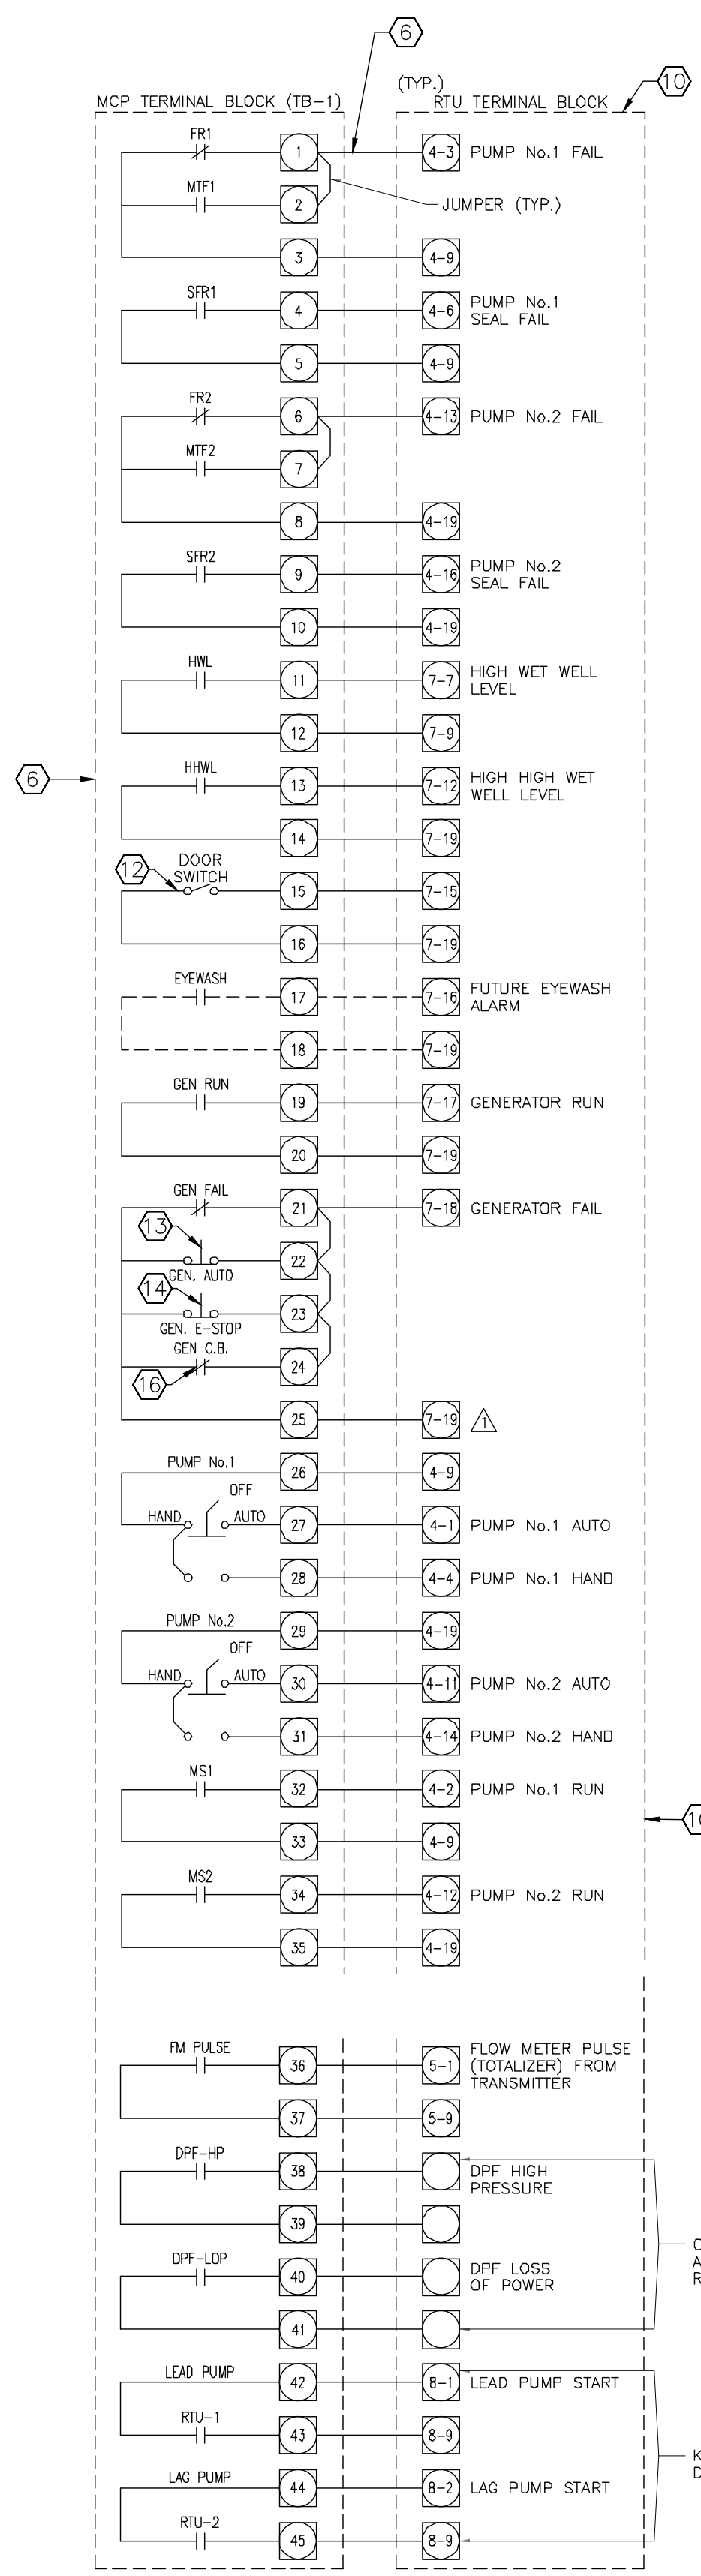


4
20 RTU DIGITAL I/O
LOCATED IN THE MCP PANEL

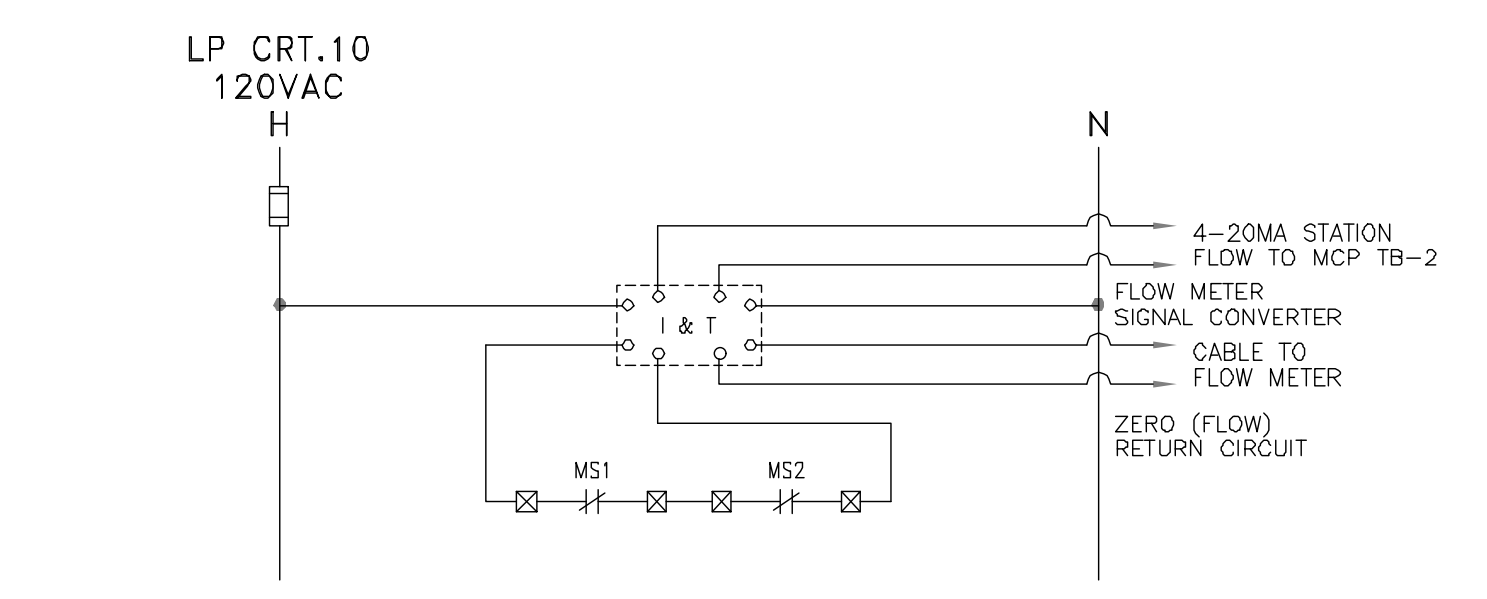


7
20 FLOWMETER CONTROL
LOCATED IN THE MCP PANEL

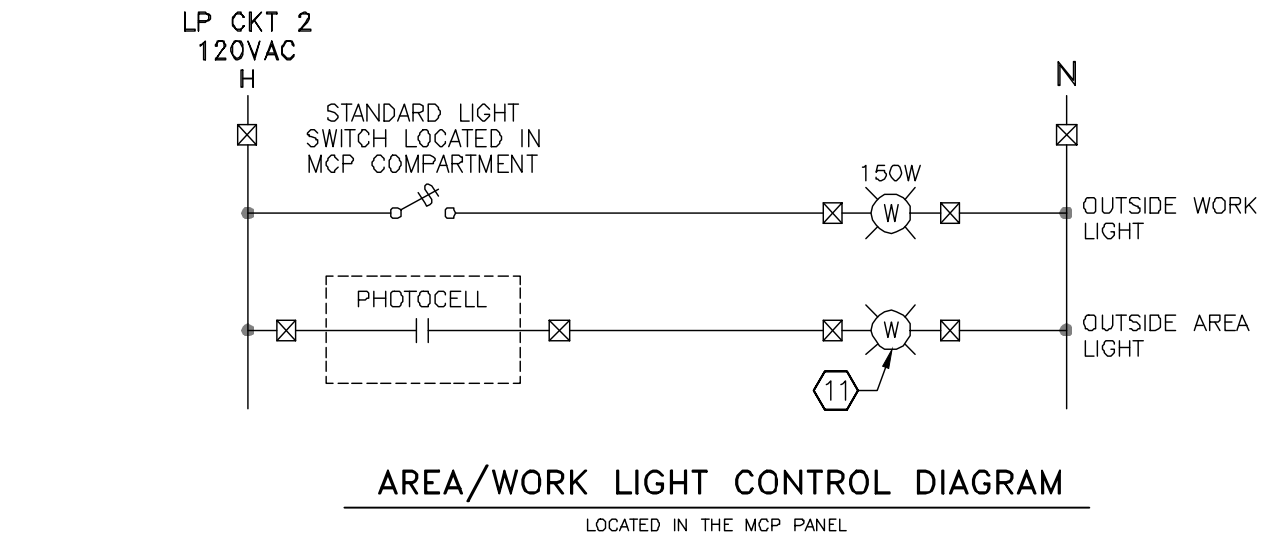

6
20 LIGHT CONTROL DIAGRAM
LOCATED IN THE MCP PANEL

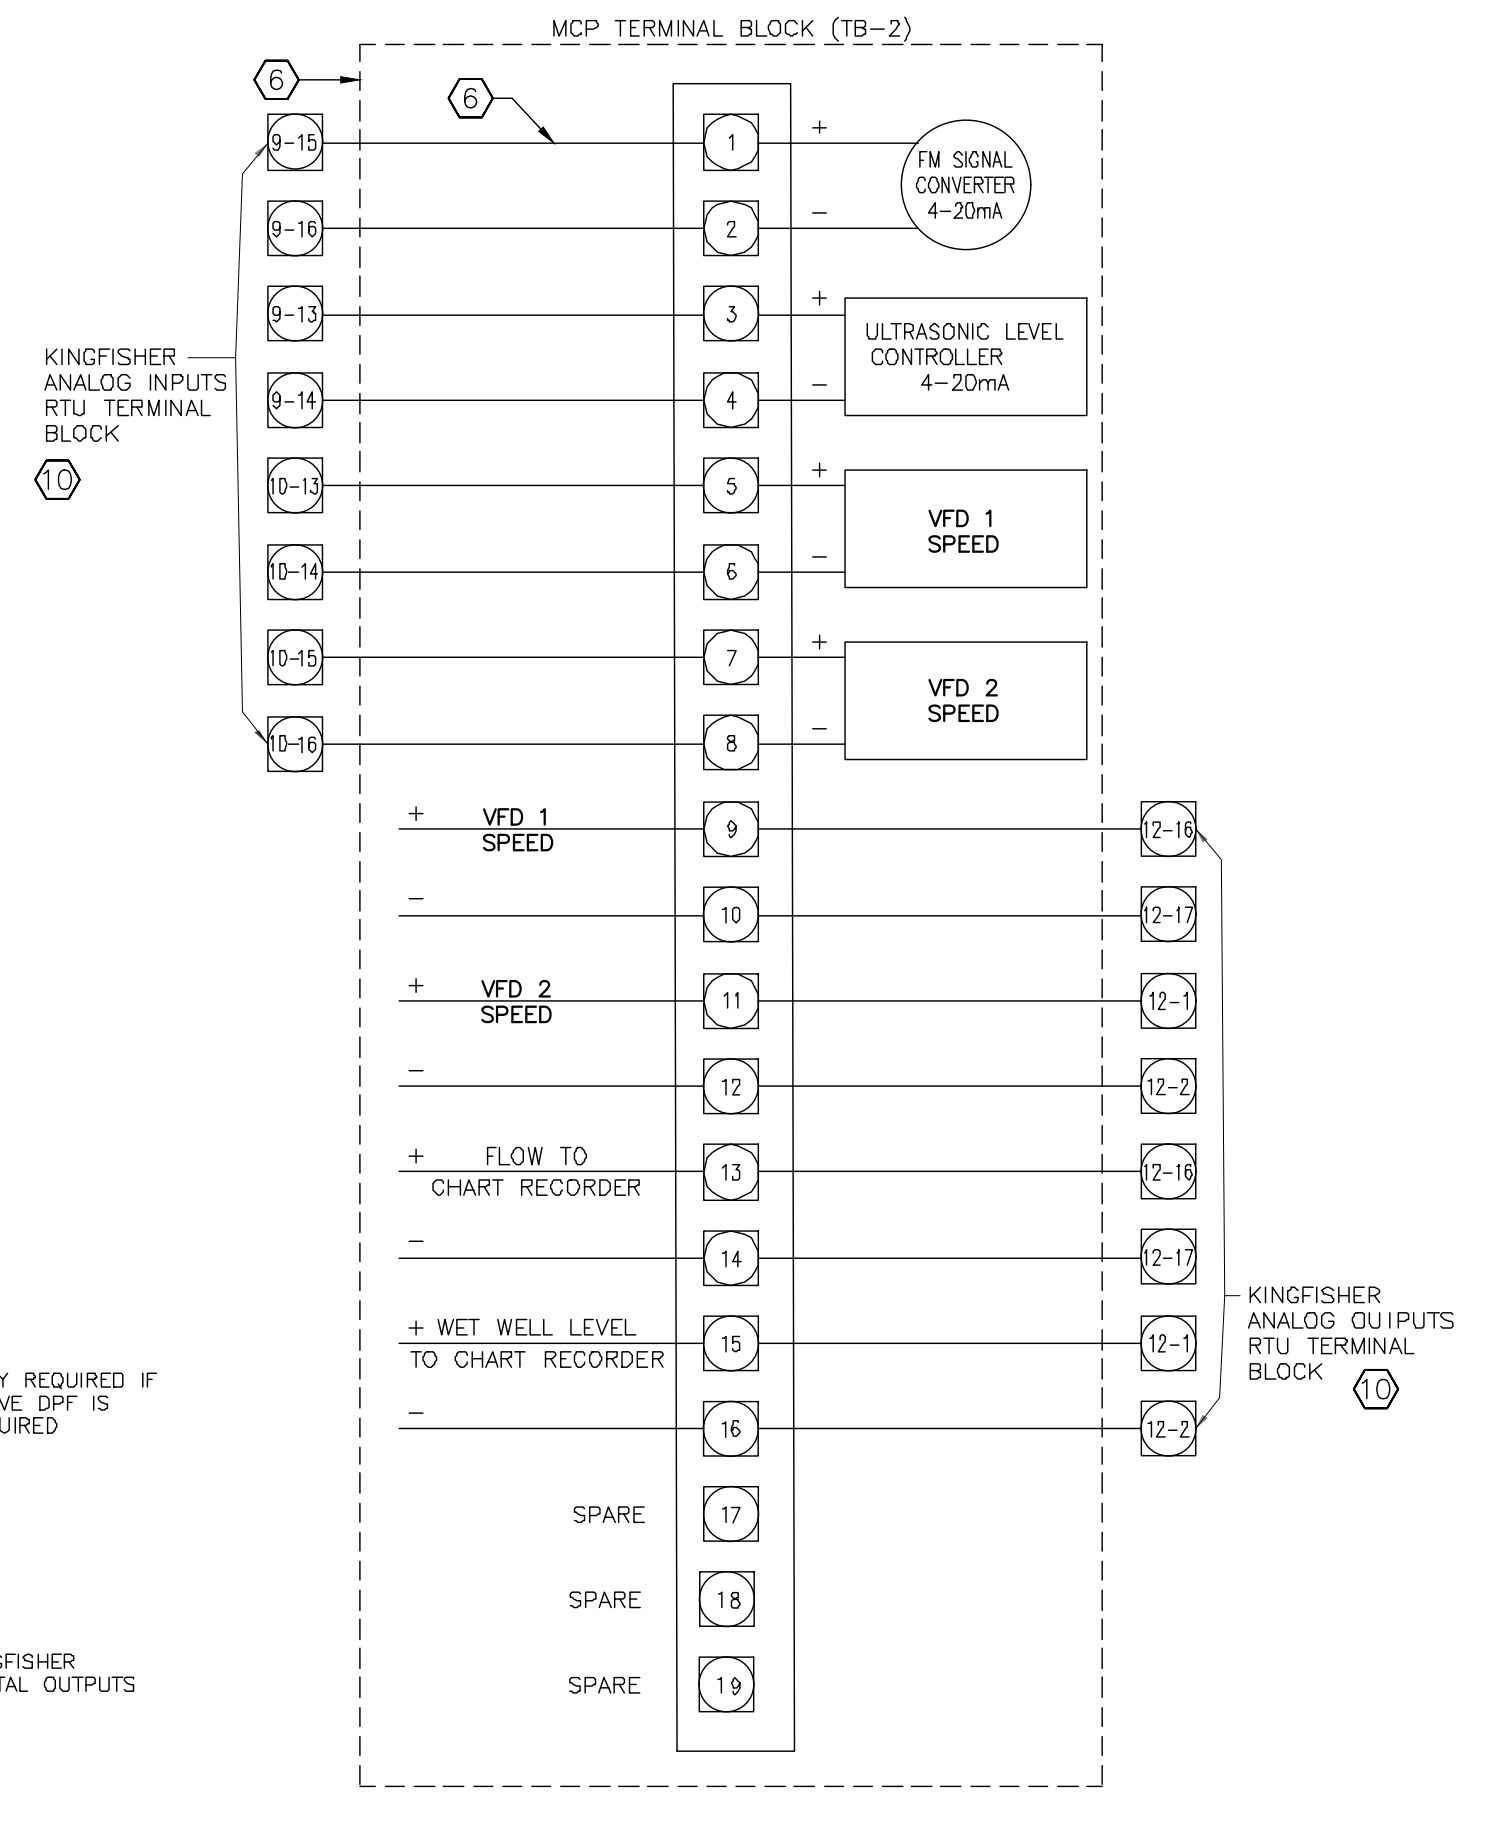

5
20 RTU ANALOG I/O
LOCATED IN THE MCP PANEL

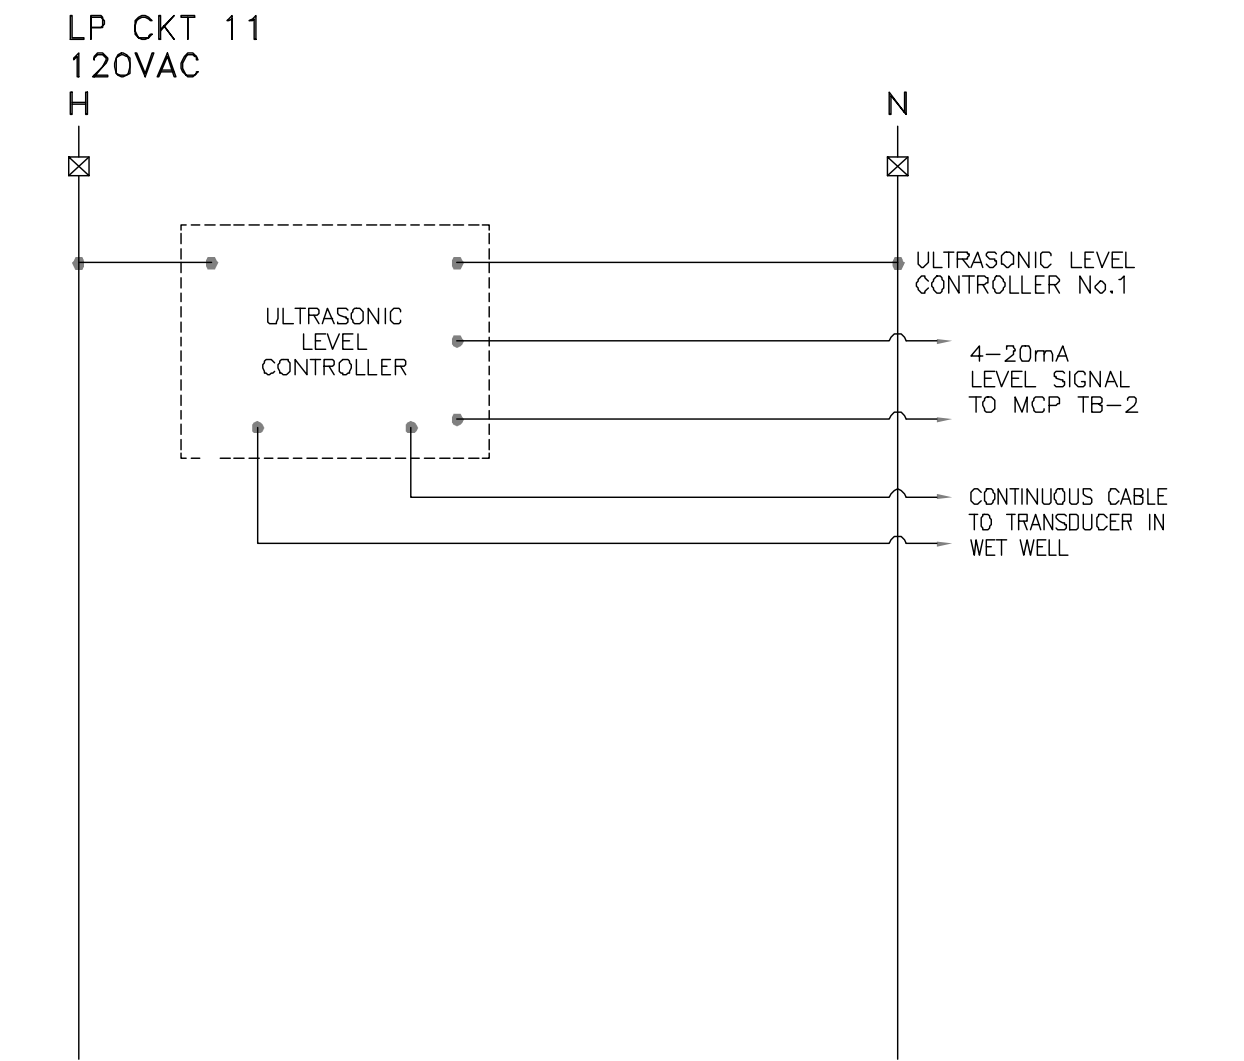

8
20 ULTRASONIC LEVEL CONTROL
LOCATED IN THE MCP PANEL

ELECTRICAL NOTES

- 1 WARRICK INTRINSICALLY SAFE RELAY (NO SUBSTITUTES)
- 2 NORMALLY CLOSED, OPENS ON HIGH TEMPERATURE
- 3 LIGHTS, STARTERS, ETM'S, OVERLOAD RELAYS, AND HOA SWITCHES SHALL BE LOCATED WITHIN MCC BUCKETS AS SHOWN HEREON
- 4 RELAYS, LIGHTS, SELECTOR SWITCHES, AND ETM SHALL BE LOCATED IN THE MAIN CONTROL PANEL AS SHOWN HEREON
- 5 USE CONTACT FROM TD3 FOR PUMP NO.1 AND TD4 FOR PUMP NO.2
- 6 CONTRACTOR TO PROVIDE TERMINAL BLOCKS TB-1 AND TB-2 IN MCP WIRED TO STATUS/ALARM SIGNALS AS SHOWN. CONTRACTOR SHALL CONNECT FROM MCP TERMINAL BLOCKS TO RTU TERMINAL BLOCK. CONTRACTOR SHALL TERMINATE CONDUCTORS ON RTU TERMINAL BLOCK AND LABEL CONDUCTORS USING WIRING NUMBER DESIGNATION SHOWN HEREON. (IE. 4-1, 4-4, ETC.)
- 7 MOISTURE DETECTION MODULE TO BE FURNISHED BY PUMP MANUFACTURER
- 8 ALL SELECTOR SWITCHES, PUSH BUTTONS, AND LIGHTS SHALL BE HEAVY DUTY NEMA 4/13. LIGHTS SHALL BE PUSH-TO-TEST TYPE.
- 9 CONTRACTOR SHALL SUBMIT A CONTROL PANEL LAYOUT DRAWING SHOWING ALL ALARM LIGHTS, SWITCHES, AND NAME PLATES FOR THE CITY'S REVIEW AND APPROVAL.
- 10 RTU, INCLUDING RTU TERMINAL BLOCK SHALL BE CITY FURNISHED, CONTRACTOR INSTALLED.
- 11 AREA LIGHT SHALL MEET THE REQUIREMENT OF THE COUNTY OF RIVERSIDE ORDINANCE NO.655.
- 12 DOOR SWITCH LOCATED ON RTU PANEL, TO BE CONNECTED TO RTU INPUT BY THE CITY.
- 13 GENERATOR HOA SWITCH, CLOSED WHEN HOA SWITCH IS IN AUTO POSITION
- 14 NORMALLY CLOSED CONTACT FROM GENERATOR EMERGENCY STOP PUSHBUTTON. OPEN CONTACT WHEN EMERGENCY STOP PUSHBUTTON IS DEPRESSED.
- 15 MULTIPLE CONTACT HOA SWITCH FOR "AUTO" AND "HAND" POSITION SIGNAL TO RTU.
- 16 NORMALLY CLOSED CONTACT FROM GENERATOR CIRCUIT BREAKER, OPEN CONTACT WHEN GENERATOR CIRCUIT BREAKER IS OPEN.

DIGALERT
Call 2 Working Days Before You Dig! 811

BENCHMARK:
NATIONAL GEODETIC SURVEY BENCHMARK NO. 1311
1.4 MILES WEST OF BEAUMONT ON INTERSTATE 10 TO SAN TIMOTEO CANYON NEAR FRONTAGE ROAD ON SOUTH (WEST) SIDE OF INTERSTATE 10, 0.1 MILES SOUTHWEST ALONG FRONTAGE ROAD, SOUTH ACROSS THE ROAD FROM A GUY POLE 25.9 FEET SOUTH OF THE CENTERLINE OF FRONTAGE ROAD, 1.8 FEET WEST OF POWERPOLE AND 1.5 FEET EAST OF A WITNESS POST, INSIDE A 4 INCH PVC PIPE WITH SCREW PLUG 1 INCH ABOVE GROUND (ELEVATION = 2468.07). ALSO SHOWN ON HIGHWAY 69 / POTRERO BLVD. INTERCHANGE STATIC GPS PROJECT CONTROL DIAGRAM AND IDENTIFIED THEREON AS 3558 BM D3474 WHEREIN THE PUBLISHED ELEVATION = 2468.07 IS CORRECTED WITH A MEASURED ELEVATION = 2468.01, USED HEREON.
ELEV. 2468.01, (NVD '88), (STAMPED Q 1311 1978)

BY	MARK	DESCRIPTION	APPR.	DATE
ENGINEER		REVISIONS	CITY	

Kimley»Horn
401 B Street, Suite 600, San Diego, CA 92101
Phone: (619) 234-9411
WWW.KIMLEY-HORN.COM

DESIGN BY: SLM
DRAWN BY: RC/SW
CHECKED BY: TW/SS
SCALE:
DATE:
JOB NUMBER: 195284001

Reviewed By: _____ Date: _____
Recommended for Approval By: _____ Date: 11/19/2021
Approved By: _____ Date: 11/23/2021

CITY OF BEAUMONT, CALIFORNIA
IMPROVEMENT PLANS FOR:
BEAUMONT CROSSROADS LIFT STATION
MOTOR CONTROL

550E 6th St
Beaumont, CA 92223
TEL: (951) 789-8520 FAX: (951) 789-8528

Kimley»Horn
REGISTERED PROFESSIONAL ENGINEER
MICHAEL ANTHONY COLOMBO
No. 19280
ELECTRICAL
STATE OF CALIFORNIA

CITY OF BEAUMONT
CALIFORNIA
NOV. 18, 1972

DESIGN BY: SLM
DRAWN BY: RC/SW
CHECKED BY: TW/SS
SCALE:
DATE:
JOB NUMBER: 195284001

Reviewed By: _____ Date: _____
Recommended for Approval By: _____ Date: 11/19/2021
Approved By: _____ Date: 11/23/2021

CITY OF BEAUMONT, CALIFORNIA
IMPROVEMENT PLANS FOR:
BEAUMONT CROSSROADS LIFT STATION
MOTOR CONTROL

550E 6th St
Beaumont, CA 92223
TEL: (951) 789-8520 FAX: (951) 789-8528

SHEET
20
OF 38 SHEETS
FILE NO:
3387

Plotted By: W. Miller, Sam Sheet Set: BEAUMONT LIFT STATION Motor Control October 20, 2021 10:50:46am K:\ISND_WATER\195284001\Beaumont Lift Station Design\Plan Sheets - 2020\DELTA SET\195284001 - EL DELTA.dwg

CONDUIT SCHEDULE							
NO.	CONDUIT		WIRE		FROM	TO	REMARKS
	SIZE	TYPE	POWER	GROUND			
E-UTIL-1	3"	SCHED 40 PVC UG			UTILITY METER	UTILITY TRANSFORMER	CONTRACTOR TO COORDINATE UTILITY TRANSFORMER LOCATION
E-UTIL-2	3"	SCHED 40 PVC UG			UTILITY METER	UTILITY TRANSFORMER	CONTRACTOR TO COORDINATE UTILITY TRANSFORMER LOCATION
E-01A	2"	SCHED 40 PVC UG	4-#3/0 AWG	1-#4 GND	UTILITY METER	MCC MAIN BREAKER	PARALLEL SET TO ATS
E-01B	2"	SCHED 40 PVC UG	4-#3/0 AWG	1-#4 GND	UTILITY METER	MCC MAIN BREAKER	PARALLEL SET TO ATS
E-02A	2"	SCHED 40 PVC UG	4-#3/0 AWG	1-#4 GND	GENERATOR	ATS	PARALLEL SET TO ATS
E-02B	2"	SCHED 40 PVC UG	4-#3/0 AWG	1-#4 GND	GENERATOR	ATS	PARALLEL SET TO ATS
E-03A		RUN IN WIREWAY	4-#3/0 AWG	1-#4 GND	MCC MAIN BREAKER	ATS	RUN IN WIREWAY
E-03B		RUN IN WIREWAY	4-#3/0 AWG	1-#4 GND	MCC MAIN BREAKER	ATS	RUN IN WIREWAY
E-04	2.5"	SCHED 40 PVC UG	4-#3/0 AWG	1-#6 GND	MCC DISTRIBUTION BOARD	SITE ELECTRICAL PULL BOX	PUMP #1 POWER
E-05	2.5"	SCHED 40 PVC UG	4-#3/0 AWG	1-#6 GND	MCC DISTRIBUTION BOARD	SITE ELECTRICAL PULL BOX	PUMP #2 POWER
E-06	2.5"	SCHED 40 PVC UG	4-#3/0 AWG	1-#6 GND	SITE ELECTRICAL PULL BOX	PUMP #1 200A DISCONNECT	
E-07	2.5"	SCHED 40 PVC UG	4-#3/0 AWG	1-#6 GND	SITE ELECTRICAL PULL BOX	PUMP #2 200A DISCONNECT	
E-08	-	-	-	-	-	-	NOT USED
E-09	-	-	-	-	-	-	NOT USED
E-10	1"	SCHED 40 PVC UG	2-#12 AWG	1-#12 GND	SITE ELECTRICAL PULL BOX	FLOW METER	FLOW METER POWER
E-11	1"	SCHED 40 PVC UG	2-#12 AWG	1-#12 GND	SITE ELECTRICAL PULL BOX	SITE LIGHT	SITE LIGHTING
E-12	1"	RGS AG/SCHED 40 PVC UG	2-#10 AWG	1-#10 GND	PANEL A	SITE ELECTRICAL PULL BOX	FLOW METER POWER
E-13	1"	RGS AG/SCHED 40 PVC UG	2-#10 AWG	1-#10 GND	PANEL A	GENERATOR	SITE LIGHTING
E-14	2"	RGS AG/SCHED 40 PVC UG	-	-	MCC DISTRIBUTION BOARD	FUTURE LIFT STATION PULL BOX	GENERATOR BATTERY CHARGER
E-15	3"	PVC COATED RGS	MFR CABLE		NEMA 4X POWER JB	PUMP #1	GENERATOR BLOCK HEATER
E-16	3"	PVC COATED RGS	MFR CABLE		NEMA 4X POWER JB	PUMP #2	SPARE FOR FUTURE USE
E-17	1"	SCHED 40 PVC UG	2-#12 AWG	1-#12 GND	PANEL A	ODOR CONTROL PAD GFI RECEPTACLE	PENETRATE WET WELL PER DETAIL 2, SHEET 16.
C-00	1"	SCHED 40 PVC UG	4-PR #16 AWG		MCP	SITE COMMUNICATIONS PULL BOX	PENETRATE WET WELL PER DETAIL 2, SHEET 16.
C-01	1"	SCHED 40 PVC UG	4-PR #16 AWG		SITE COMMUNICATIONS PULL BOX	NEMA 4X FLOAT SWITCH JB	PUMP #1, PUMP #2 LEAK/OVERTEMP
C-02	1"	PVC COATED RGS	4-PR #16 AWG		NEMA 4X FLOAT SWITCH JB	NEMA 4X POWER JB	PUMP #1, PUMP #2 LEAK/OVERTEMP
C-03	1"	RGS AG/SCHED 40 PVC UG	MFR CABLE		MCP	SITE COMMUNICATIONS PULL BOX	SPLICE MFR PUMP POWER CABLE
C-04	1"	SCHED 40 PVC UG/ PVC COATED RGS	MFR CABLE		SITE COMMUNICATIONS PULL BOX	FLOW METER FM-100	FLOW METER 4-20Ma INSTANTANEOUS FLOW, TOTAL FLOW PULSE
C-05	1"	SCHED 40 PVC UG	MFR CABLE		MCP	SITE COMMUNICATIONS PULL BOX	FLOW METER 4-20Ma INSTANTANEOUS FLOW, TOTAL FLOW PULSE
C-06	1"	SCHED 40 PVC UG	MFR CABLE		SITE COMMUNICATIONS PULL BOX	NEMA 4X US SENSOR JB	US LEVEL SENSOR LE-100
C-07	1"	SCHED 40 PVC UG	8-PR #16 AWG		MCP	SITE COMMUNICATIONS PULL BOX	US LEVEL SENSOR LE-100
C-08	1"	SCHED 40 PVC UG	8-PR #16 AWG		SITE COMMUNICATIONS PULL BOX	NEMA 4X FLOAT JB	FLOAT SWITCHES LSL, LSL, LSH, LSHH
C-09	1"	SCHED 40 PVC UG	2-PR #16 AWG		ATS	GENERATOR	FLOAT SWITCHES LSL, LSL, LSH, LSHH
C-10	1"	SCHED 40 PVC UG	4-PR #16 AWG		MCP	GENERATOR	2-WIRE GENERATOR START/STOP SIGNAL
							GENERATOR RUN, FAIL ALARMS, SPARES

1
21 CONDUIT SCHEDULE
SCALE: NOT TO SCALE

PANEL: PANEL A									
VOLTAGE: 120/240					PANEL BUS: 40 AMPS				
PHASE WIRES: 1φ, 3W					MAIN: 40A BREAKER				
SCCR (AMPS): 10,000									
SOURCE: T-1									
DESCRIPTION	VA	CB	CKT	A	B	CKT	CB	VA	DESCRIPTION
BUILDING INTERIOR LIGHTING	240	20/1	1	3.0		2	20/1	120	FLOW METER
BUILDING EXTERIOR LIGHTING	180	20/1	3		13.2	4	20/1	1400	RTU CABINET
LIGHTING CONTROL CABINET	180	20/1	5	3.5		6	20/1	240	GENERATOR BATTERY CHARGER
SITE LIGHTING	240	20/1	7		7.0	8	20/1	600	GENERATOR BLOCK HEATER
BUILDING RECEPTACLES	720	20/1	9						SPACE
BUILDING RECEPTACLES	720	20/1	11	6.0		6.0	12		
SITE RECEPTACLES	720	20/1	13	6.0					
BIOXIDE/ODOR CONTROL PUMP	600	20/1	15		5.0	16			
SPARE			17	0.0		18			
			19	0.0		20			
			21	0.0		22			
			23	0.0		24			
TOTALS		18.5	31.2	AMPS					

LOAD CALCULATIONS: SUBTOTAL (VA): 5960
+25% PER NEC (VA): 1490
TOTAL (VA): 7450 @ 240V, I₀ = 31.1 AMPS

2
21 PANEL SCHEDULE
SCALE: NOT TO SCALE

MANUFACTURER: SCHNEIDER	VOLTS/PHASE/WIRE 480V/3 PHASE/4W
EQUIPMENT LOCATION: ELECTRICAL ROOM	MAIN BUS RATING: 400A
FED FROM: UTILITY	MAIN BREAKER (AMPS): 400A
	AIC RATING (AMPS): 45,000

SECTION NO.	BREAKER SIZE	STARTER SIZE	FEEDER CABLE SIZE	EQUIPMENT NAME	KVA	HP	FLA	BREAKER TRIP RATING
1	150A	VFD		PUMP 1		105	125.0	
2	150A	VFD		PUMP 2		105	125.0	
3				7.5KVA TRANSFORMER	6		7.2	
4				AC CU 1	15		18.0	
5				AC AIR HANDLER	2		2.4	
FLA FOR NON-MOTOR LOAD (AMPS):								27.6
FLA FOR MOTOR LOAD (AMPS):								250.0
PLUS 25% OF LARGEST MOTOR:								31.3
TOTAL AMPS								308.9
SERVICE SIZE								400.0
% LOADED (NO LARGER THAN 80% OF SELECTED LOAD SERVICE SIZE):								77%

3
21 LOAD SUMMARY
SCALE: NOT TO SCALE

Plotted By: Vu/luhner, Sam Sheet Set: BEAUMONT LIFT STATION Electrical Schedules October 20, 2021 10:50:48am K:\ISND_WATER\195284001 Beaumont Lift Station Design\Plan Sheets - 2020\DELTA SET\195284001 - EL DELTA.dwg




BENCHMARK:
NATIONAL GEODETIC SURVEY BENCHMARK NO. Q 1311
1.4 MILES WEST OF BEAUMONT ON INTERSTATE 10 TO SAN TIMOTEO CANYON NEAR FRONTAGE ROAD ON SOUTH(WEST) SIDE OF INTERSTATE 10, 0.1 MILES SOUTHEAST ALONG FRONTAGE ROAD, SOUTH ACROSS THE ROAD FROM A GUY POLE 25.9 FEET SOUTH OF THE CENTERLINE OF FRONTAGE ROAD, 1.6 FEET WEST OF POWERPOLE AND 1.5 FEET EAST OF A WITNESS POST, INSIDE A 4 INCH PVC PIPE WITH SCREW PLUG 1 INCH ABOVE GROUND (ELEVATION = 2468.07). ALSO SHOWN ON HIGHWAY 69 // POTRERO BLVD. INTERCHANGE STATIC GPS PROJECT CONTROL DIAGRAM AND IDENTIFIED THEREON AS 3558 BM D33474 WHEN THE PUBLISHED ELEVATION = 2468.07 IS CORRECTED WITH A MEASURED ELEVATION = 2468.01, USED HEREON.
ELEV. 2468.01, (NVD '88), (STAMPED Q 1311 1978)

BY	MARK	DESCRIPTION	APPR.	DATE
ENGINEER		REVISIONS	CITY	

Kimley»Horn
401 B Street, Suite 600, San Diego, CA 92101
Phone: (619) 234-9411
WWW.KIMLEY-HORN.COM

Michael A. Colombo
R.C.E. 19280
8/23/2021

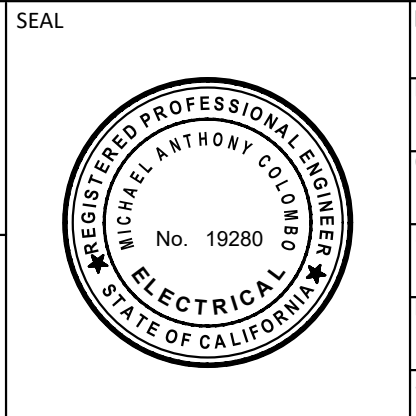

DESIGN BY: SLM
DRAWN BY: RC/SW
CHECKED BY: TW/SS
SCALE:
DATE:
JOB NUMBER: 195284001



Reviewed By: _____ Date: _____
Recommended for Approval By: _____ Date: 11/19/2021
Approved By: _____ Date: 11/23/2021
City Engineer/Director of Public Works

CITY OF BEAUMONT, PUBLIC WORKS DEPARTMENT
ENGINEERING DIVISION
550E 6th St
Beaumont, CA 92223
TEL: (951) 769-8520 FAX: (951) 769-8526

CITY OF BEAUMONT, CALIFORNIA
IMPROVEMENT PLANS FOR:
BEAUMONT CROSSROADS LIFT STATION

ELECTRICAL SCHEDULES

SHEET
21
OF 38 SHEETS
FILE NO: 3387

STRUCTURAL GENERAL NOTES

10.00 REINFORCED CONCRETE (CAST-IN-PLACE)

- 10.01 THE GENERAL CONTRACTOR SHALL ASSIST AND COOPERATE WITH AN INDEPENDENT TESTING LABORATORY (TO BE RETAINED BY THE OWNER) WHICH SHALL CONDUCT ALL OF THE SPECIFIED TESTS REQUIRED FOR THE CONCRETE WORK AND REPORT THE RESULTS OF THESE TESTS DIRECTLY AND PROMPTLY TO THE ENGINEER FOR HIS REVIEW.
10.02 DETAILING OF REBAR SHALL BE IN ACCORDANCE WITH THE LATEST REVISION OF THE ACI DETAILING MANUAL, AND CONCRETE REINFORCING INSTITUTE'S LATEST EDITION OF "MANUAL OF STANDARD PRACTICE". ALL SHOP DRAWINGS PERTAINING TO REBAR DETAILS SHALL BE SUBMITTED TO THE ENGINEER FOR HIS REVIEW.
10.03 CONCRETE MIX DESIGN FOR ALL CONCRETE WORK IS REQUIRED TO BE SUBMITTED TO THE ENGINEER FOR HIS REVIEW. IT IS TO BE NOTED THAT THE CONCRETE SUPPLIER SHALL HAVE A QUALITY CONTROL PROCEDURE FOR THE PRODUCTION OF ALL CONCRETE, WHICH MUST BE ACCEPTABLE TO THE ENGINEER AND MEETS CURRENT ACI STANDARDS.
10.04 CONSTRUCTION JOINTS SHALL BE AS APPROVED BY THE ENGINEER. ENGINEER SHALL BE INFORMED AT LEAST 48 HOURS PRIOR TO THE COMMENCEMENT OF ANY CONCRETE WORK.
10.05 COPY OF ACI 301 "SPECIFICATIONS FOR STRUCTURAL CONCRETE FOR BUILDINGS" AND ACI SP 15 "FIELD REFERENCE MANUAL" SHALL BE KEPT IN THE PROJECT FIELD OFFICE AT ALL TIMES.
10.06 CONCRETE COMPRESSIVE DESIGN STRENGTH IN 28 DAYS: CONCRETE EXPOSURE CLASS F1 FOR SPREAD FOOTINGS, WALL FOOTINGS, AND SLAB-ON-GRADE, SEE ACI 318-14 TABLE 19.3.1.1 AND TABLE 19.3.2.1.

Table with 3 columns: Item, Description, Value. Includes spread footings (4,000 PSI MAX), wall footings (4,000 PSI), and slab-on-grade (4,000 PSI) with W/C ratios.

- 10.07 CLEAR DISTANCE FROM FACE OF CONCRETE TO MAIN STEEL SHALL BE AS SHOWN ON THE STRUCTURAL DRAWINGS. WHERE CLEAR DISTANCE IS NOT SHOWN, ACI 301 SHALL CONTROL.
10.08 PROVIDE 3/4 INCH CHAMFERS AT ALL EXPOSED EDGES UNO.
10.09 EMBEDDED ITEMS THAT WILL SUPPORT STRUCTURAL STEEL CONSTRUCTION SHALL BE PLACED WITHIN THE TOLERANCES PRESCRIBED IN THE LATEST EDITION OF THE AISC "CODE OF STANDARD PRACTICE". GENERAL CONTRACTOR SHALL FIELD VERIFY LOCATION OF EMBEDDED ITEMS PRIOR TO FABRICATION AND DELIVERY OF STRUCTURAL STEEL TO THE PROJECT SITE.
10.10 BAR SUPPORTS, DESIGN, DETAILING, FABRICATION, AND PLACING OF REINFORCING BARS SHALL BE IN ACCORDANCE WITH ACI 318-14 (BUILDING CODE REQUIREMENTS FOR STRUCTURAL CONCRETE) AND THE LATEST EDITION OF THE ACI DETAILING MANUAL.
10.11 WHERE SHOWN OR SPECIFIED ON PLANS, PROVIDE STANDARD ACI 90-DEGREE OR 180-DEGREE HOOK, AS APPLICABLE.
10.12 REINFORCING: ASTM A615, GRADE 60, FOR SLABS, RETAINING / STAIR WALLS, AND FOUNDATIONS IS ACCEPTABLE. ALL REINFORCING TO BE A706 GRADE WHERE WELDING IS REQUIRED.
10.13 BAR DETAILS AND SUPPORTS: ACI DETAILING MANUAL AND BUILDING CODE. LAP ALL SPLICES AS SHOWN ON THE STRUCTURAL DRAWINGS.
10.14 CLEAR DISTANCE FROM FACE OF CONCRETE TO REINFORCING STEEL SHALL BE AS SHOWN ON THE STRUCTURAL DRAWINGS. WHERE CLEAR DISTANCE IS NOT ILLUSTRATED, ACI 301 REQUIREMENTS SHALL CONTROL.
10.15 ALL REINFORCEMENT SHOWN IS INTENDED TO BE CONTINUOUS UNLESS NOTED OTHERWISE. LAP SPLICES SHALL BE 40 BAR DIAMETERS FOR #5 AND SMALLER, 48 BAR DIAMETERS FOR #6 AND LARGER.
10.16 CORE DRILLING SHALL NOT BE ALLOWED THROUGH IN-PLACE CONCRETE ELEMENTS UNLESS SPECIFICALLY APPROVED BY THE ENGINEER. PENETRATIONS THROUGH CONCRETE ELEMENTS SHALL BE ILLUSTRATED ON SHOP DRAWINGS AND SHALL UTILIZE SCHEDULE 40 STEEL PIPE. CLEARANCE REQUIRED WITHIN PIPE SLEEVE SHALL BE CONFIRMED BY SUBCONTRACTOR RESPONSIBLE FOR THE MATERIAL PASSING THROUGH THE SLEEVE. REINFORCEMENT CLEAR COVER SHALL BE MAINTAINED AROUND THE SLEEVE PENETRATION.
10.17 FOLLOWING FOUNDATION PLACEMENT AND PRIOR TO STEEL ERECTION, THE CONCRETE CONTRACTOR SHALL PROVIDE THE STEEL ERECTOR WITH WRITTEN DOCUMENTATION STATING THAT COLUMN FOUNDATION ELEMENTS HAVE REACHED A MINIMUM OF 75% OF DESIGN COMPRESSIVE STRENGTH AND THAT ALL ANCHOR BOLT PLACEMENT IS IN CONFORMANCE WITH CONTRACT DOCUMENTS OR THAT REPAIRS WERE COMPLETED PER EOR DIRECTION. REFER TO 1926 OSHA REGULATIONS SUBPART R FOR ADDITIONAL DETAILS.

11.00 ELEVATED METAL DECK

- 11.01 ALL NOTES APPLY TO NONCOMPOSITE AND COMPOSITE METAL FLOOR DECKING WITH CONCRETE TOPPING AND UNTOPPED ROOF DECKING, UNLESS NOTED OTHERWISE.
11.02 REFER TO CONTRACT DRAWINGS FOR CONNECTION DETAILS AND DEFINITION OF PERIMETER AND CORNER AREAS.
11.03 METAL DECK SHALL BE PROVIDED IN LONGEST LENGTHS POSSIBLE, PROVIDED A MINIMUM OF 3-SPAN CONDITIONS IN ALL LOCATIONS.
11.04 STEEL DECK SHALL CONFORM TO ASTM A653 AND SDI DESIGN MANUAL FOR COMPOSITE DECKS, FORM DECKS AND ROOF DECKS. STEEL DECK SHALL BE RECOGNIZED UNDER THE LATEST VERSION OF ICC-ES AC43 ACCEPTANCE CRITERIA FOR STEEL DECK, ROOF AND FLOOR SYSTEMS.
11.05 SHOP DRAWINGS INDICATING STEEL DECK LAYOUT, FASTENING METHOD AND PATTERN SHALL BE SUBMITTED TO THE ENGINEER OF RECORD PRIOR TO STEEL DECK INSTALLATION.
11.06 CONTRACTOR SHALL TAKE ALL NECESSARY PRECAUTIONS TO ENSURE STEEL DECK IS NOT DAMAGED PRIOR TO INSTALLATION DURING STORAGE, HANDLING AND ERECTION. DAMAGED STEEL DECK SHALL BE REPLACED.
11.07 STEEL DECK SHALL BE STORED OFF THE GROUND WITH ONE END ELEVATED TO PROVIDE DRAINAGE AND SHOULD BE PROTECTED FROM THE ELEMENTS WITH A WATERPROOF COVERING VENTILATED TO PREVENT CONDENSATION.

- 11.08 STEEL DECK PANELS SHALL BE PLACED STRAIGHT AND TRUE WITH A MAXIMUM 1/4-INCH HORIZONTAL MISALIGNMENT IN 100 FEET LENGTH. STEEL DECK SHALL BE MARKED OVER JOIST CHORDS PRIOR TO FASTENING TO PREVENT WELD BURN THROUGH OR MECHANICAL FASTENER PUNCH THROUGH.
11.09 ENDLAPS OF STEEL DECK SHALL OVERLAP ADJACENT SHEETS A MINIMUM OF 2 INCHES UNLESS NOTED OTHERWISE.
11.10 FRAMING AROUND TYPICAL OPENINGS SHALL BE IN ACCORDANCE WITH STANDARD PRACTICE DETAILS PROVIDED IN SDI "MANUAL OF CONSTRUCTION WITH STEEL DECK."
11.11 NO MECHANICAL, ELECTRICAL, PLUMBING, ARCHITECTURAL OR MISCELLANEOUS ELEMENTS SHALL BE SUPPORTED FROM THE UNDERSIDE OF THE METAL DECK.
11.12 REFER TO ARCHITECTURAL AND MECHANICAL DRAWINGS FOR SIZE AND LOCATION OF ALL ROOF OPENINGS, ROOF DRAIN DETAILS, SKYLIGHT AND ROOF HATCH DETAILS.
11.13 MECHANICAL FASTENERS:
A. INSTALL POWDER-ACTUATED FASTENERS ACCORDING TO THE MANUFACTURER'S RECOMMENDATIONS.
B. POWDER-ACTUATED FASTENERS SHALL BE MANUFACTURED FROM AISI 1070 MODIFIED STEEL, AUSTEMPERED TO A ROCKWELL C HARDNESS OF 52-58. FASTENERS SHALL HAVE MINIMUM TENSILE AND SHEAR STRENGTHS OF 285 KSI AND 182 KSI RESPECTIVELY.
C. POWDER-ACTUATED FASTENERS SHALL HAVE BALLISTIC POINTS AND KNURLED SHANKS AND MINIMUM 12-MILLIMETER DIAMETER STEEL WASHERS.

ABBREVIATIONS AND DEFINITIONS:

Table with 2 columns: Abbreviation, Definition. Lists terms like AREA, AMERICAN CONCRETE INSTITUTE, AMERICAN INSTITUTE OF STEEL CONSTRUCTION, etc.

STEEL SPECIAL INSPECTION TABLE

Table with 5 columns: TYPE, CONTINUOUS SPECIAL INSPECTION, PERIODIC SPECIAL INSPECTION, REFERENCE, QUALIF. Lists inspection items like REVIEW SHOP FABRICATION, WELDER QUALIFICATION RECORDS, etc.

SOIL SPECIAL INSPECTION TABLE

Table with 3 columns: TYPE, CONTINUOUS SPECIAL INSPECTION, PERIODIC SPECIAL INSPECTION. Lists inspection items like VERIFY MATERIALS BELOW SHALLOW FOUNDATIONS, EXCAVATIONS, etc.

CONCRETE SPECIAL INSPECTION TABLE

Table with 5 columns: TYPE, CONTINUOUS SPECIAL INSPECTION, PERIODIC SPECIAL INSPECTION, REFERENCED STANDARD, CBC REFERENCE. Lists inspection items like INSPECT REINFORCEMENT AND VERIFY PLACEMENT, ANCHORS CAST IN CONCRETE, etc.

MASONRY SPECIAL INSPECTION TABLE

Table with 5 columns: TYPE, CONTINUOUS SPECIAL INSPECTION, PERIODIC SPECIAL INSPECTION, TMS 402/ACI 530/ASCE 5, TMS 602/ACI 530.1/ASCE 6. Lists inspection items like VERIFY COMPLIANCE WITH THE APPROVED SUBMITTAL, CONSTRUCTION MORTAR JOINTS, etc.

Plotted By: V. Wulfeher, Stam, Sheet Set: BEAUMONT LIFT STATION, Layout: S GEN NOTES II, October 20, 2021, 10:48:49am, K:\SND_WATER\192524001_Beaumont Lift Station\Design\Plan Sheets - 2020\DELTA SET\192524001 - xST.dwg

DIGALERT logo and text: Call 2 Working Days Before You Dig! 811

BENCHMARK: NATIONAL GEODETIC SURVEY BENCHMARK NO. 1311, 1.4 MILES WEST OF BEAUMONT ON INTERSTATE 10 TO SAN TIMOTEO CANYON NEAR FRONTAGE ROAD ON SOUTH (WEST) SIDE OF INTERSTATE 10, 0.1 MILES SOUTHWEST ALONG FRONTAGE ROAD, SOUTH ACROSS THE ROAD FROM A GUY POLE 25.9 FEET SOUTH OF THE CENTERLINE OF FRONTAGE ROAD, 1.8 FEET WEST OF POWERPOLE AND 1.5 FEET EAST OF A WITNESS POST, INSIDE A 4 INCH PVC PIPE WITH SCREW PLUG 1 INCH ABOVE GROUND (ELEVATION = 2468.07). ALSO SHOWN ON HIGHWAY 69 / POTERO BLVD. INTERCHANGE STATIC GPS PROJECT CONTROL DIAGRAM AND IDENTIFIED THEREON AS 3558 BM D33474 WHEREIN THE PUBLISHED ELEVATION = 2468.07 IS CORRECTED WITH A MEASURED ELEVATION = 2468.01, USED HEREON. ELEV. 2468.01, (NVD '88), (STAMPED Q 1311 1978)

Table with 4 columns: BY, MARK, DESCRIPTION, APPR. DATE. Includes REVISIONS section.

Kimley-Horn logo and contact information: 401 B Street, Suite 600, San Diego, CA 92101, Phone: (619) 234-9411, www.kimley-horn.com

Professional Engineer seal for Justin L. Brue, State of California, No. C87614


City of Beaumont logo and design information: DESIGN BY: SLM, DRAWN BY: RC/SW, CHECKED BY: TW/SS, SCALE: DATE: JOB NUMBER: 195284001

Approval and review information: Reviewed By: Staff Engineer, Date: 11/19/2021, Recommended for Approval By: Administrative Engineer, Date: 11/23/2021, Approved By: City Engineer/Director of Public Works


CITY OF BEAUMONT, CALIFORNIA IMPROVEMENT PLANS FOR: BEAUMONT CROSSROADS LIFT STATION, GENERAL STRUCTURAL NOTES II

SHEET 23 OF 38 SHEETS, FILE NO. 3387

Plotted By: W:\m\luc... Kimley_Horn\Projects\2021\10-48-51\m... K:\SND_WATER\195284001_Beamont Lift Station\Design\Plan Sheets - 2021\DELTA SET\195284001 - .AST.dwg

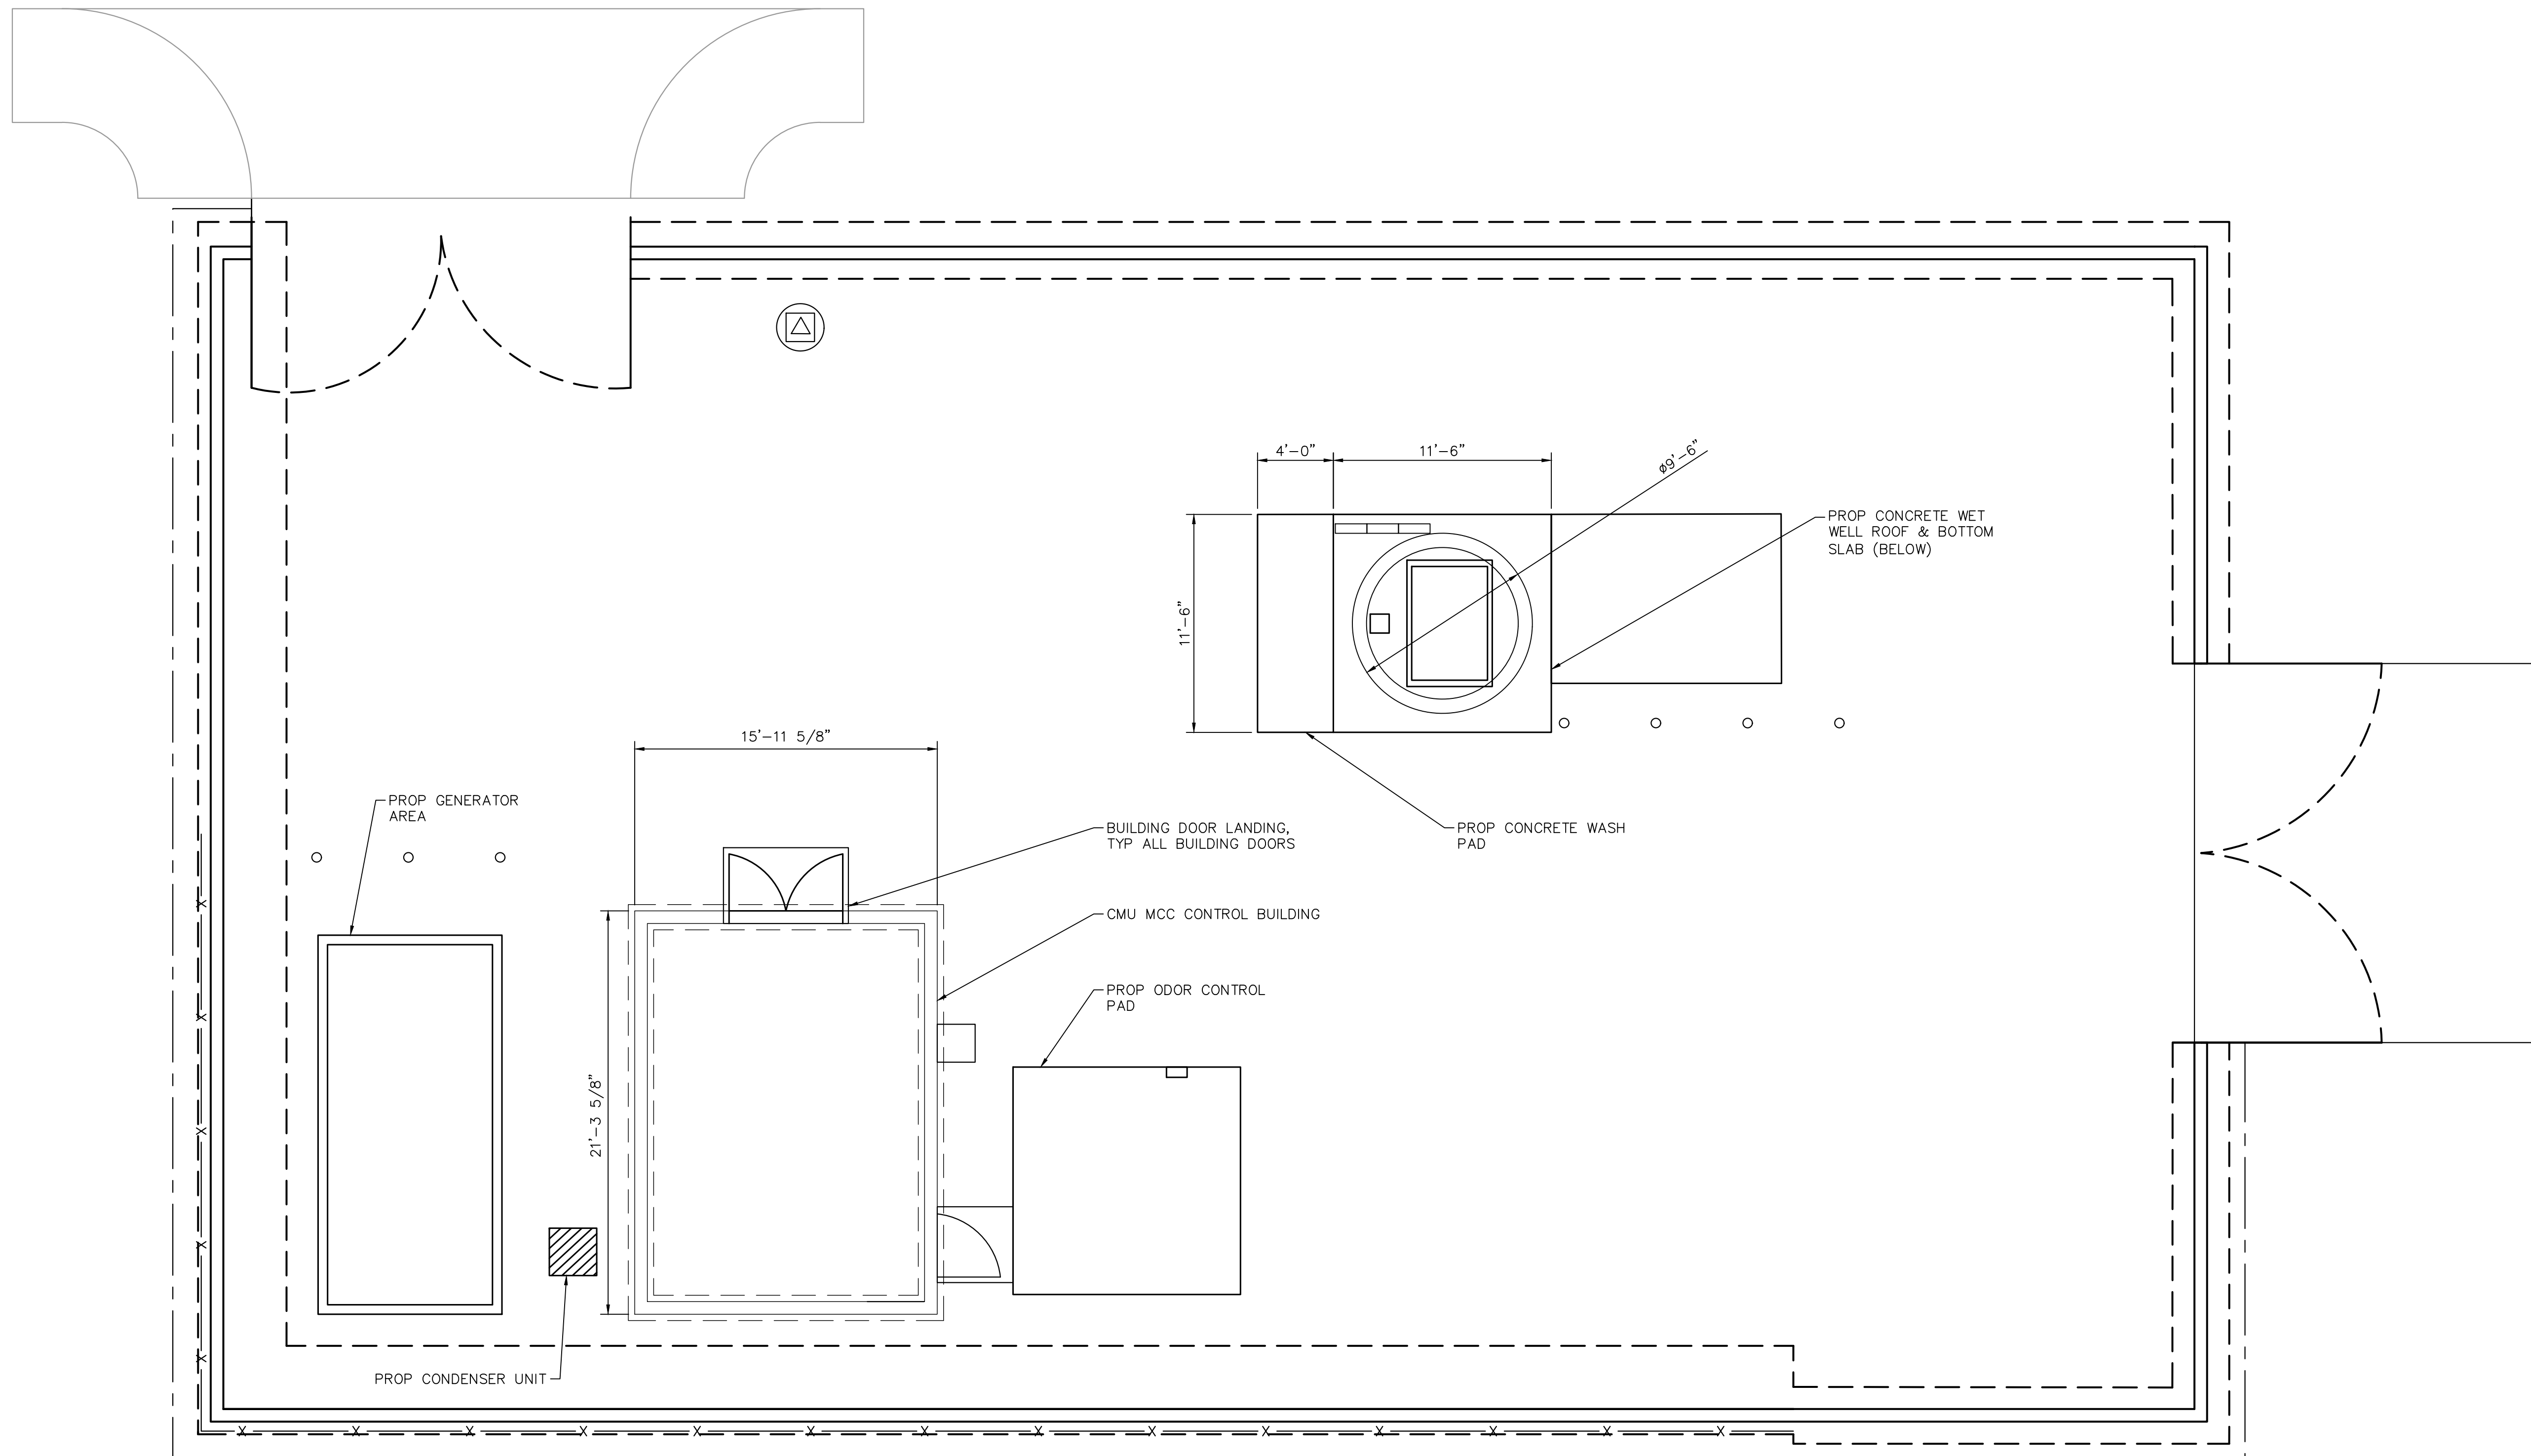

1
24 STRUCTURAL SITE PLAN
SCALE: 1" = 5'-0"

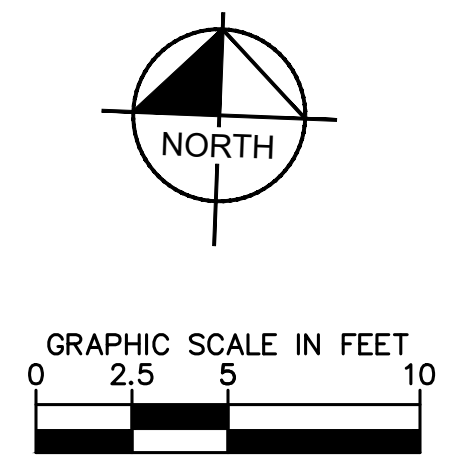


BENCHMARK:
NATIONAL GEODETIC SURVEY BENCHMARK NO. Q 1311
1.4 MILES WEST OF BEAUMONT ON INTERSTATE 10 TO SAN
TIMOTEO CANYON NEAR FRONTAGE ROAD ON SOUTH(WEST)
SIDE OF INTERSTATE 10, 0.1 MILES SOUTHEAST ALONG
FRONTAGE ROAD, SOUTH ACROSS THE ROAD FROM A GUY
POLE 25.9 FEET SOUTH OF THE CENTERLINE OF FRONTAGE
ROAD, 1.8 FEET WEST OF POWERPOLE AND 1.8 FEET EAST
OF A WITNESS POST, INSIDE A 4 INCH PVC PIPE WITH
SCREW PLUG 1 INCH ABOVE GROUND (ELEVATION =
2468.07). ALSO SHOWN ON HIGHWAY 69 // POTRERO BLVD.
INTERCHANGE STATIC GPS PROJECT CONTROL DIAGRAM
AND IDENTIFIED THEREON AS 3508 BM D3474 WHEN
THE PUBLISHED ELEVATION = 2468.07 IS CORRECTED WITH
A MEASURED ELEVATION = 2468.01, USED HEREON.
ELEV. 2468.01, (NVD '88), (STAMPED Q 1311 1978)

BY	MARK	DESCRIPTION	APPR.	DATE
ENGINEER		REVISIONS	CITY	

Kimley»Horn
401 B Street, Suite 600, San Diego, CA 92101
Phone: (619) 234-9411
WWW.KIMLEY-HORN.COM

J. Brue
JUSTIN L. BRUE
R.C.E. 87614
8/23/2021

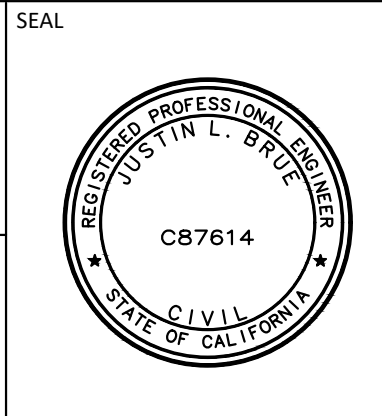

DESIGN BY: SLM
DRAWN BY:
RC/SW
CHECKED BY:
TW/SS
SCALE:
DATE:
JOB NUMBER:
195284001



Reviewed By: _____ Date: _____
Staff Engineer

Recommended for Approval By: *[Signature]* Date: 11/19/2021
Administrative Engineer


Approved By: *[Signature]* Date: 11/23/2021
City Engineer/Director of Public Works

CITY OF BEAUMONT, PUBLIC WORKS DEPARTMENT
ENGINEERING DIVISION
550E 6th St
Beaumont, CA 92223
TEL: (951) 769-8520 FAX: (951) 769-8526


CITY OF BEAUMONT, CALIFORNIA
IMPROVEMENT PLANS FOR:
BEAUMONT CROSSROADS
LIFT STATION
STRUCTURAL SITE PLAN

SHEET
24
OF 38 SHEETS
FILE NO:
3387


Plotted By: V:\M\Shirley_Sam_Sheet_Sets\BEAUMONT LIFT STATION - BUILDING FOUNDATION PLAN - October 20, 2021, 10:48:56am K:\SND_WATER\195284001_Beaumont Lift Station\Design\Plan_Sheets - 2020\DELTA SET\195284001 - MST.dwg

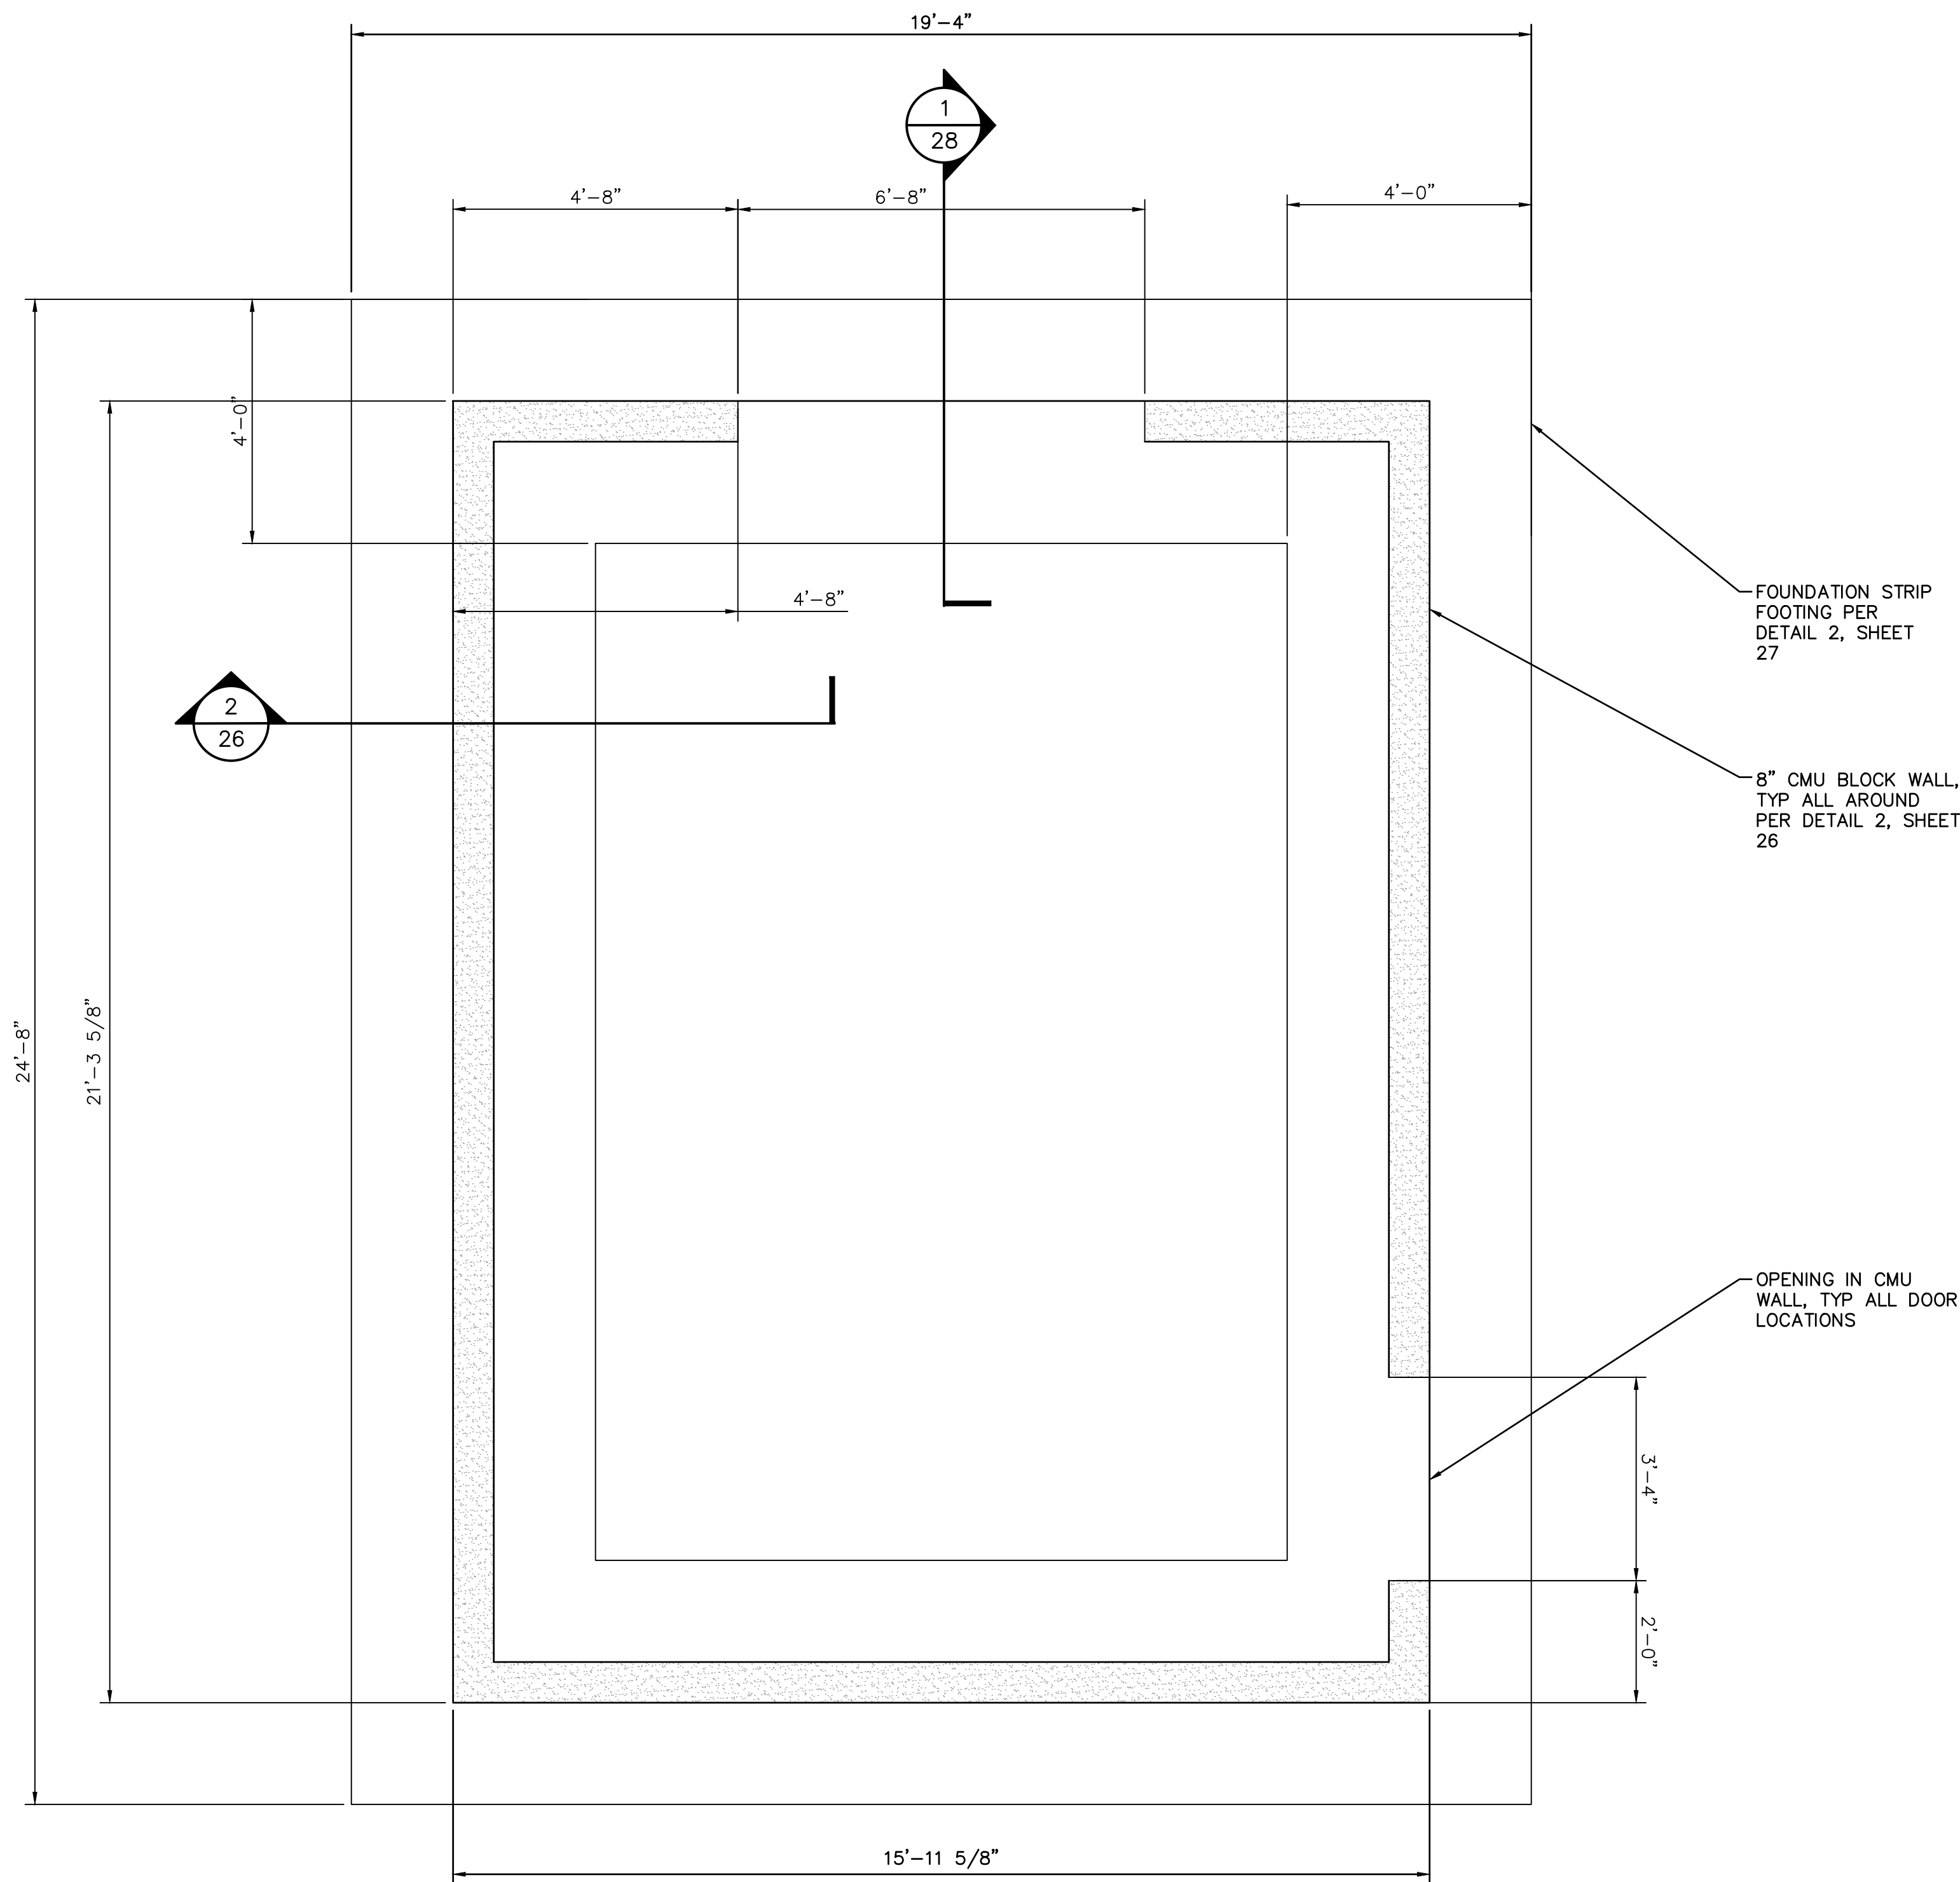

1
25 BUILDING FOUNDATION PLAN
SCALE: 1/2" = 1'-0"

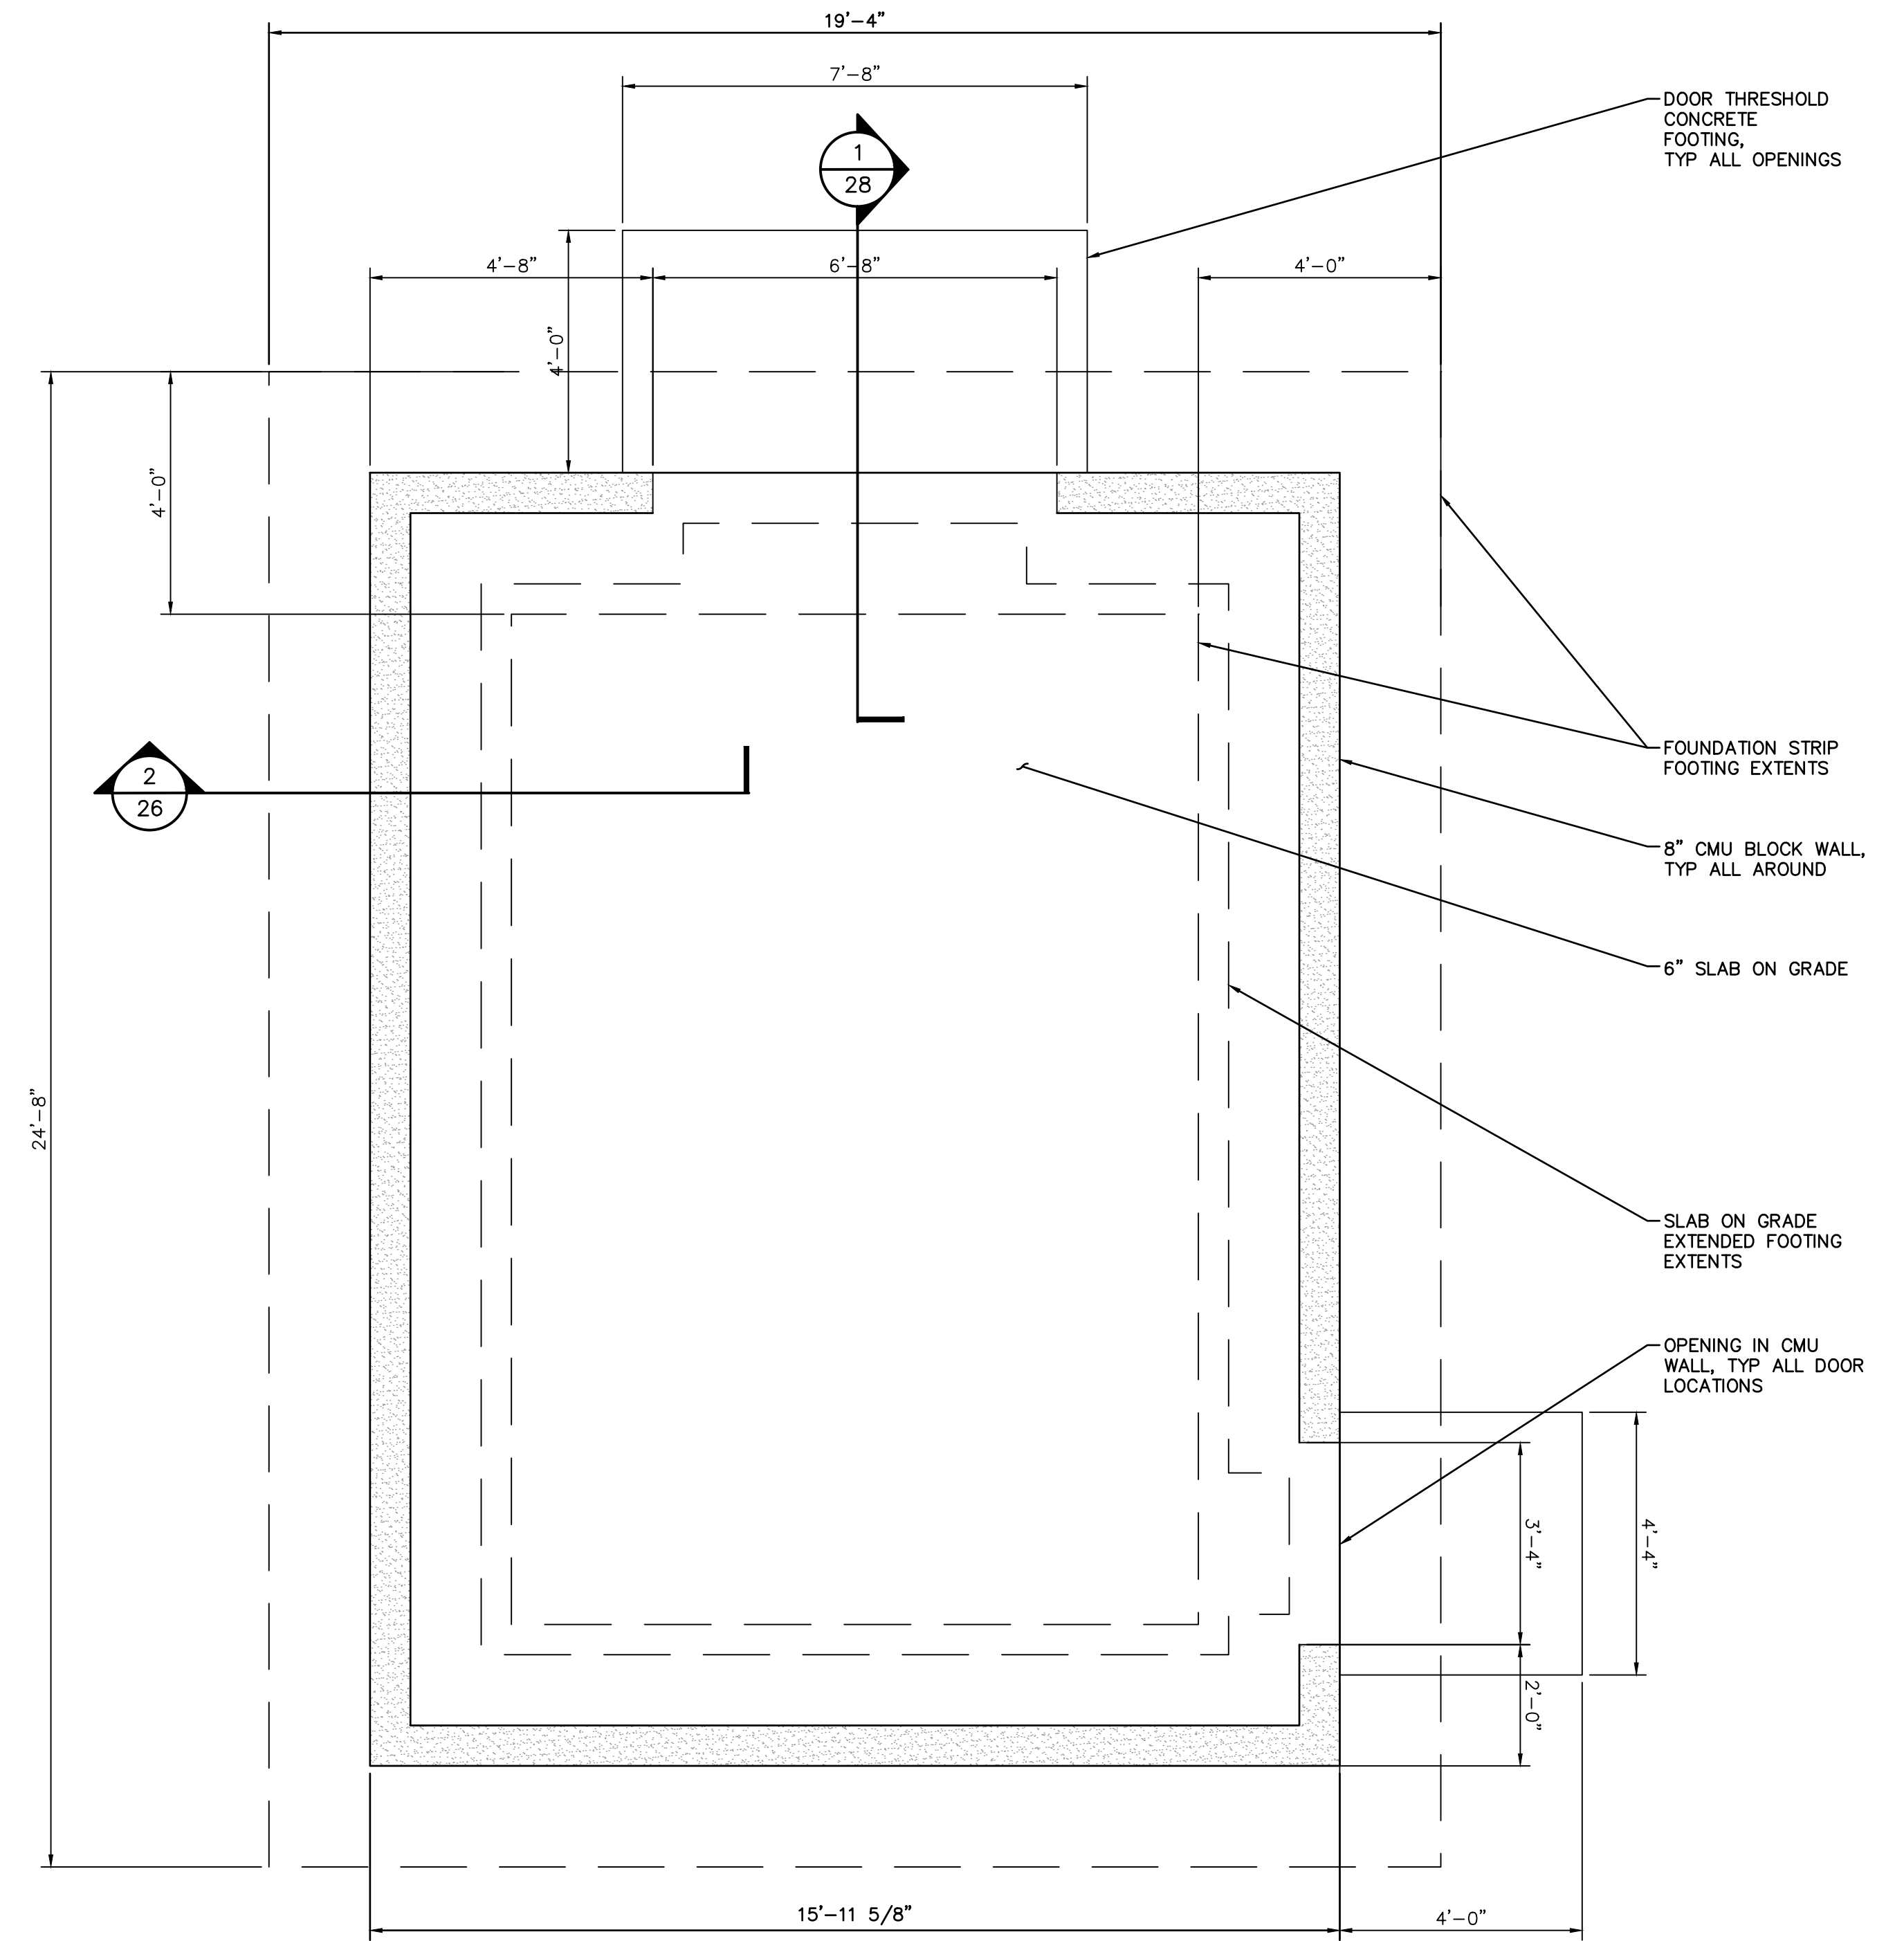

2
25 BUILDING SLAB ON GRADE PLAN
SCALE: 1/2" = 1'-0"

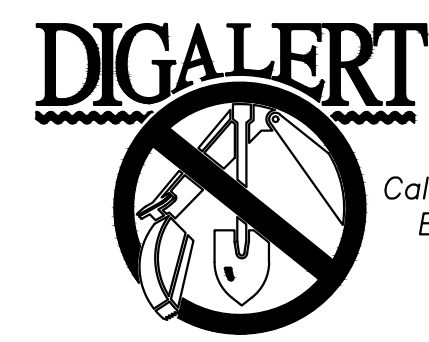


BENCHMARK:
NATIONAL GEODETIC SURVEY BENCHMARK NO. Q 1311
1.4 MILES WEST OF BEAUMONT ON INTERSTATE 10 TO SAN
TIMOTEO CANYON NEAR FRONTAGE ROAD ON SOUTH(WEST)
SIDE OF INTERSTATE 10, 0.1 MILES SOUTHEAST ALONG
FRONTAGE ROAD, SOUTH ACROSS THE ROAD FROM A GUY
POLE 25.9 FEET SOUTH OF THE CENTERLINE OF FRONTAGE
ROAD, 1.6 FEET WEST OF POWERPOLE AND 1.8 FEET EAST
OF A WITNESS POST, INSIDE A 4 INCH PVC PIPE WITH
SCREW PLUG 1 INCH ABOVE GROUND (ELEVATION =
2468.07). ALSO SHOWN ON HIGHWAY 69 // POTRERO BLVD.
INTERCHANGE STATIC GPS PROJECT CONTROL DIAGRAM
AND IDENTIFIED THEREON AS 3558 BM D33474 WHEN
THE PUBLISHED ELEVATION = 2468.07 IS CORRECTED WITH
A MEASURED ELEVATION = 2468.01, USED HEREON.
ELEV. 2468.01, (NVD '88), (STAMPED Q 1311 1978)

BY	MARK	DESCRIPTION	APPR.	DATE
ENGINEER		REVISIONS	CITY	

Kimley»Horn
401 B Street, Suite 600, San Diego, CA 92101
Phone: (619) 234-9411
WWW.KIMLEY-HORN.COM

Justin L. Brue
JUSTIN L. BRUE
P.C.E. 87614
8/23/2021

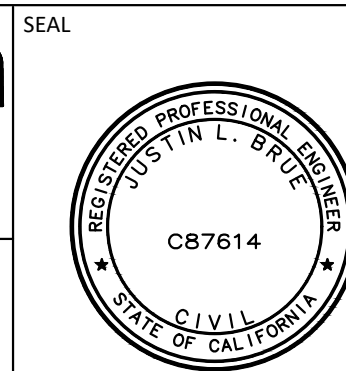

DESIGN BY:
SLM
DRAWN BY:
RC/SW
CHECKED BY:
TW/SS
SCALE:
DATE:
JOB NUMBER:
195284001



Reviewed By: _____ Date: _____
Staff Engineer

Recommended
for Approval By: *[Signature]* Date: 11/19/2021
Administrative Engineer

Approved By: *[Signature]* Date: 11/23/2021
City Engineer/Director of Public Works



CITY OF BEAUMONT, PUBLIC WORKS DEPARTMENT
ENGINEERING DIVISION

CITY OF BEAUMONT, CALIFORNIA
IMPROVEMENT PLANS FOR:
**BEAUMONT CROSSROADS
LIFT STATION**
MCC BUILDING FOUNDATION PLAN

S H E E T
25
OF 38 SHEETS
FILE NO:
3387


550E 6th St
Beaumont, CA 92223
TEL: (951) 769-8520 FAX: (951) 769-8528

Plotted By: j.walker, Sam Sheet Set: BEAUMONT LIFT STATION BUILDING ROOF PLAN October 20, 2021 10:48:58am K:\SND_WATER\195284001 Beaumont Lift Station\Design\Plan Sheets - 2020_DELTA SET\195284001 - .xst.dwg

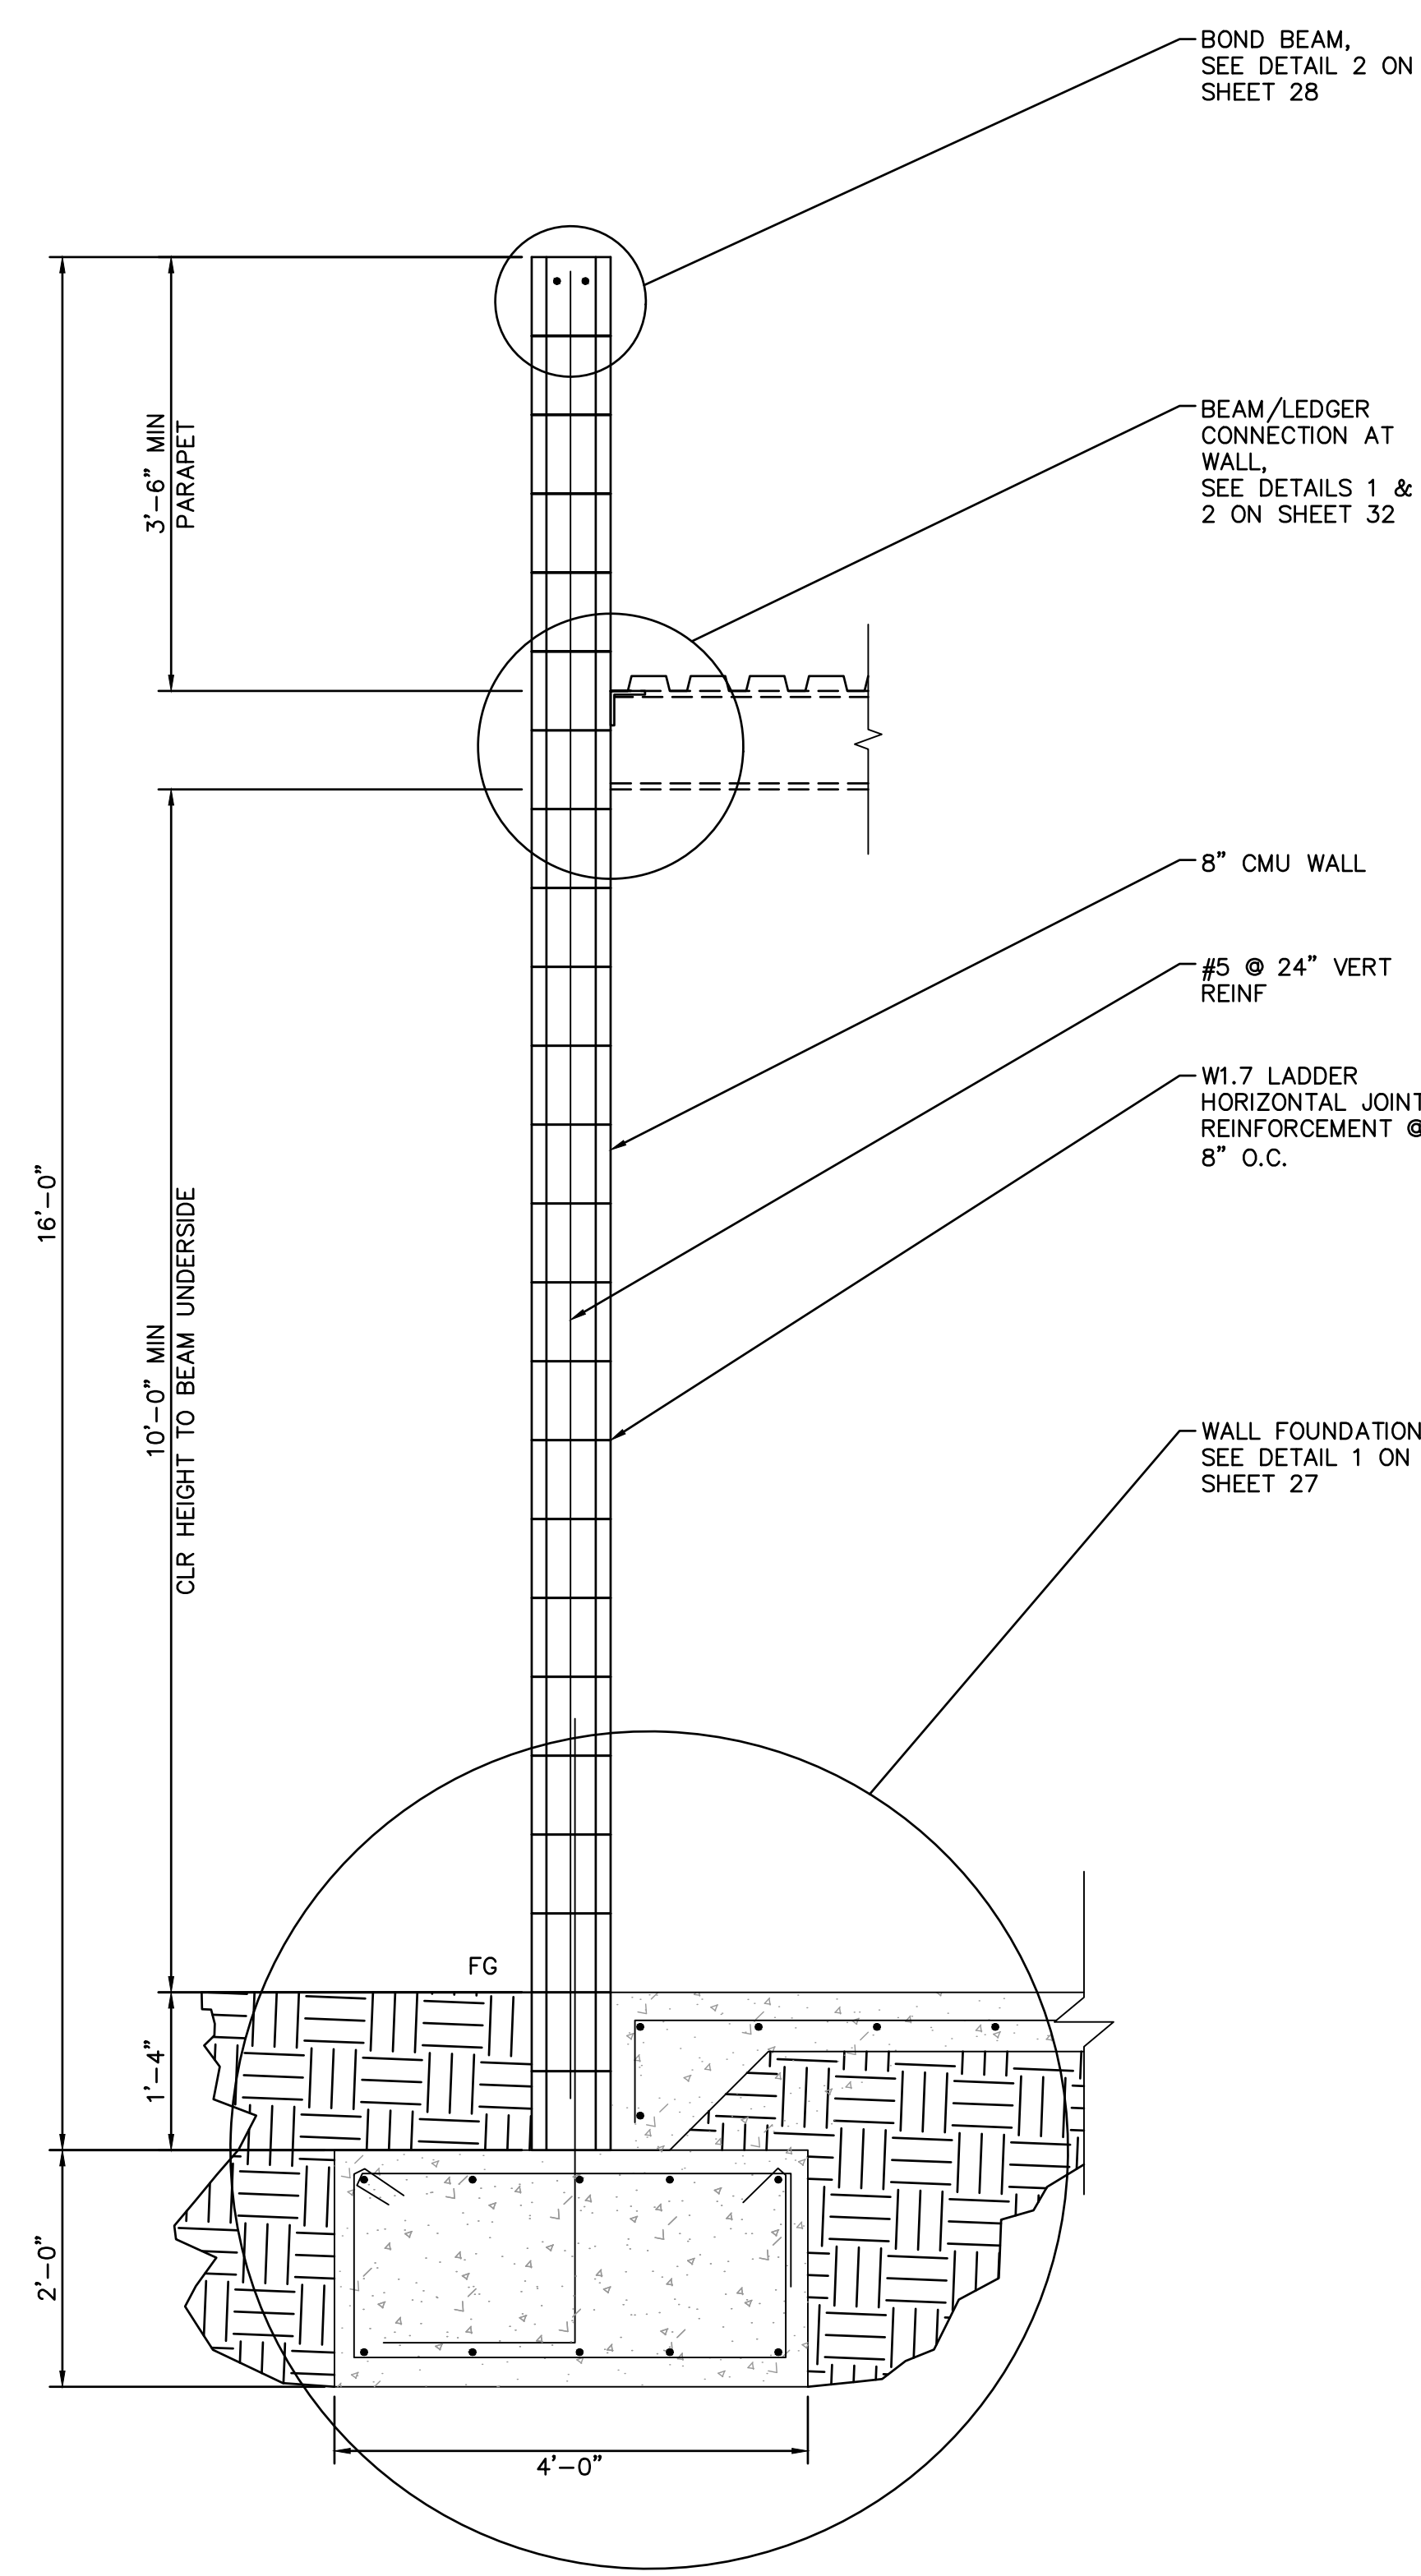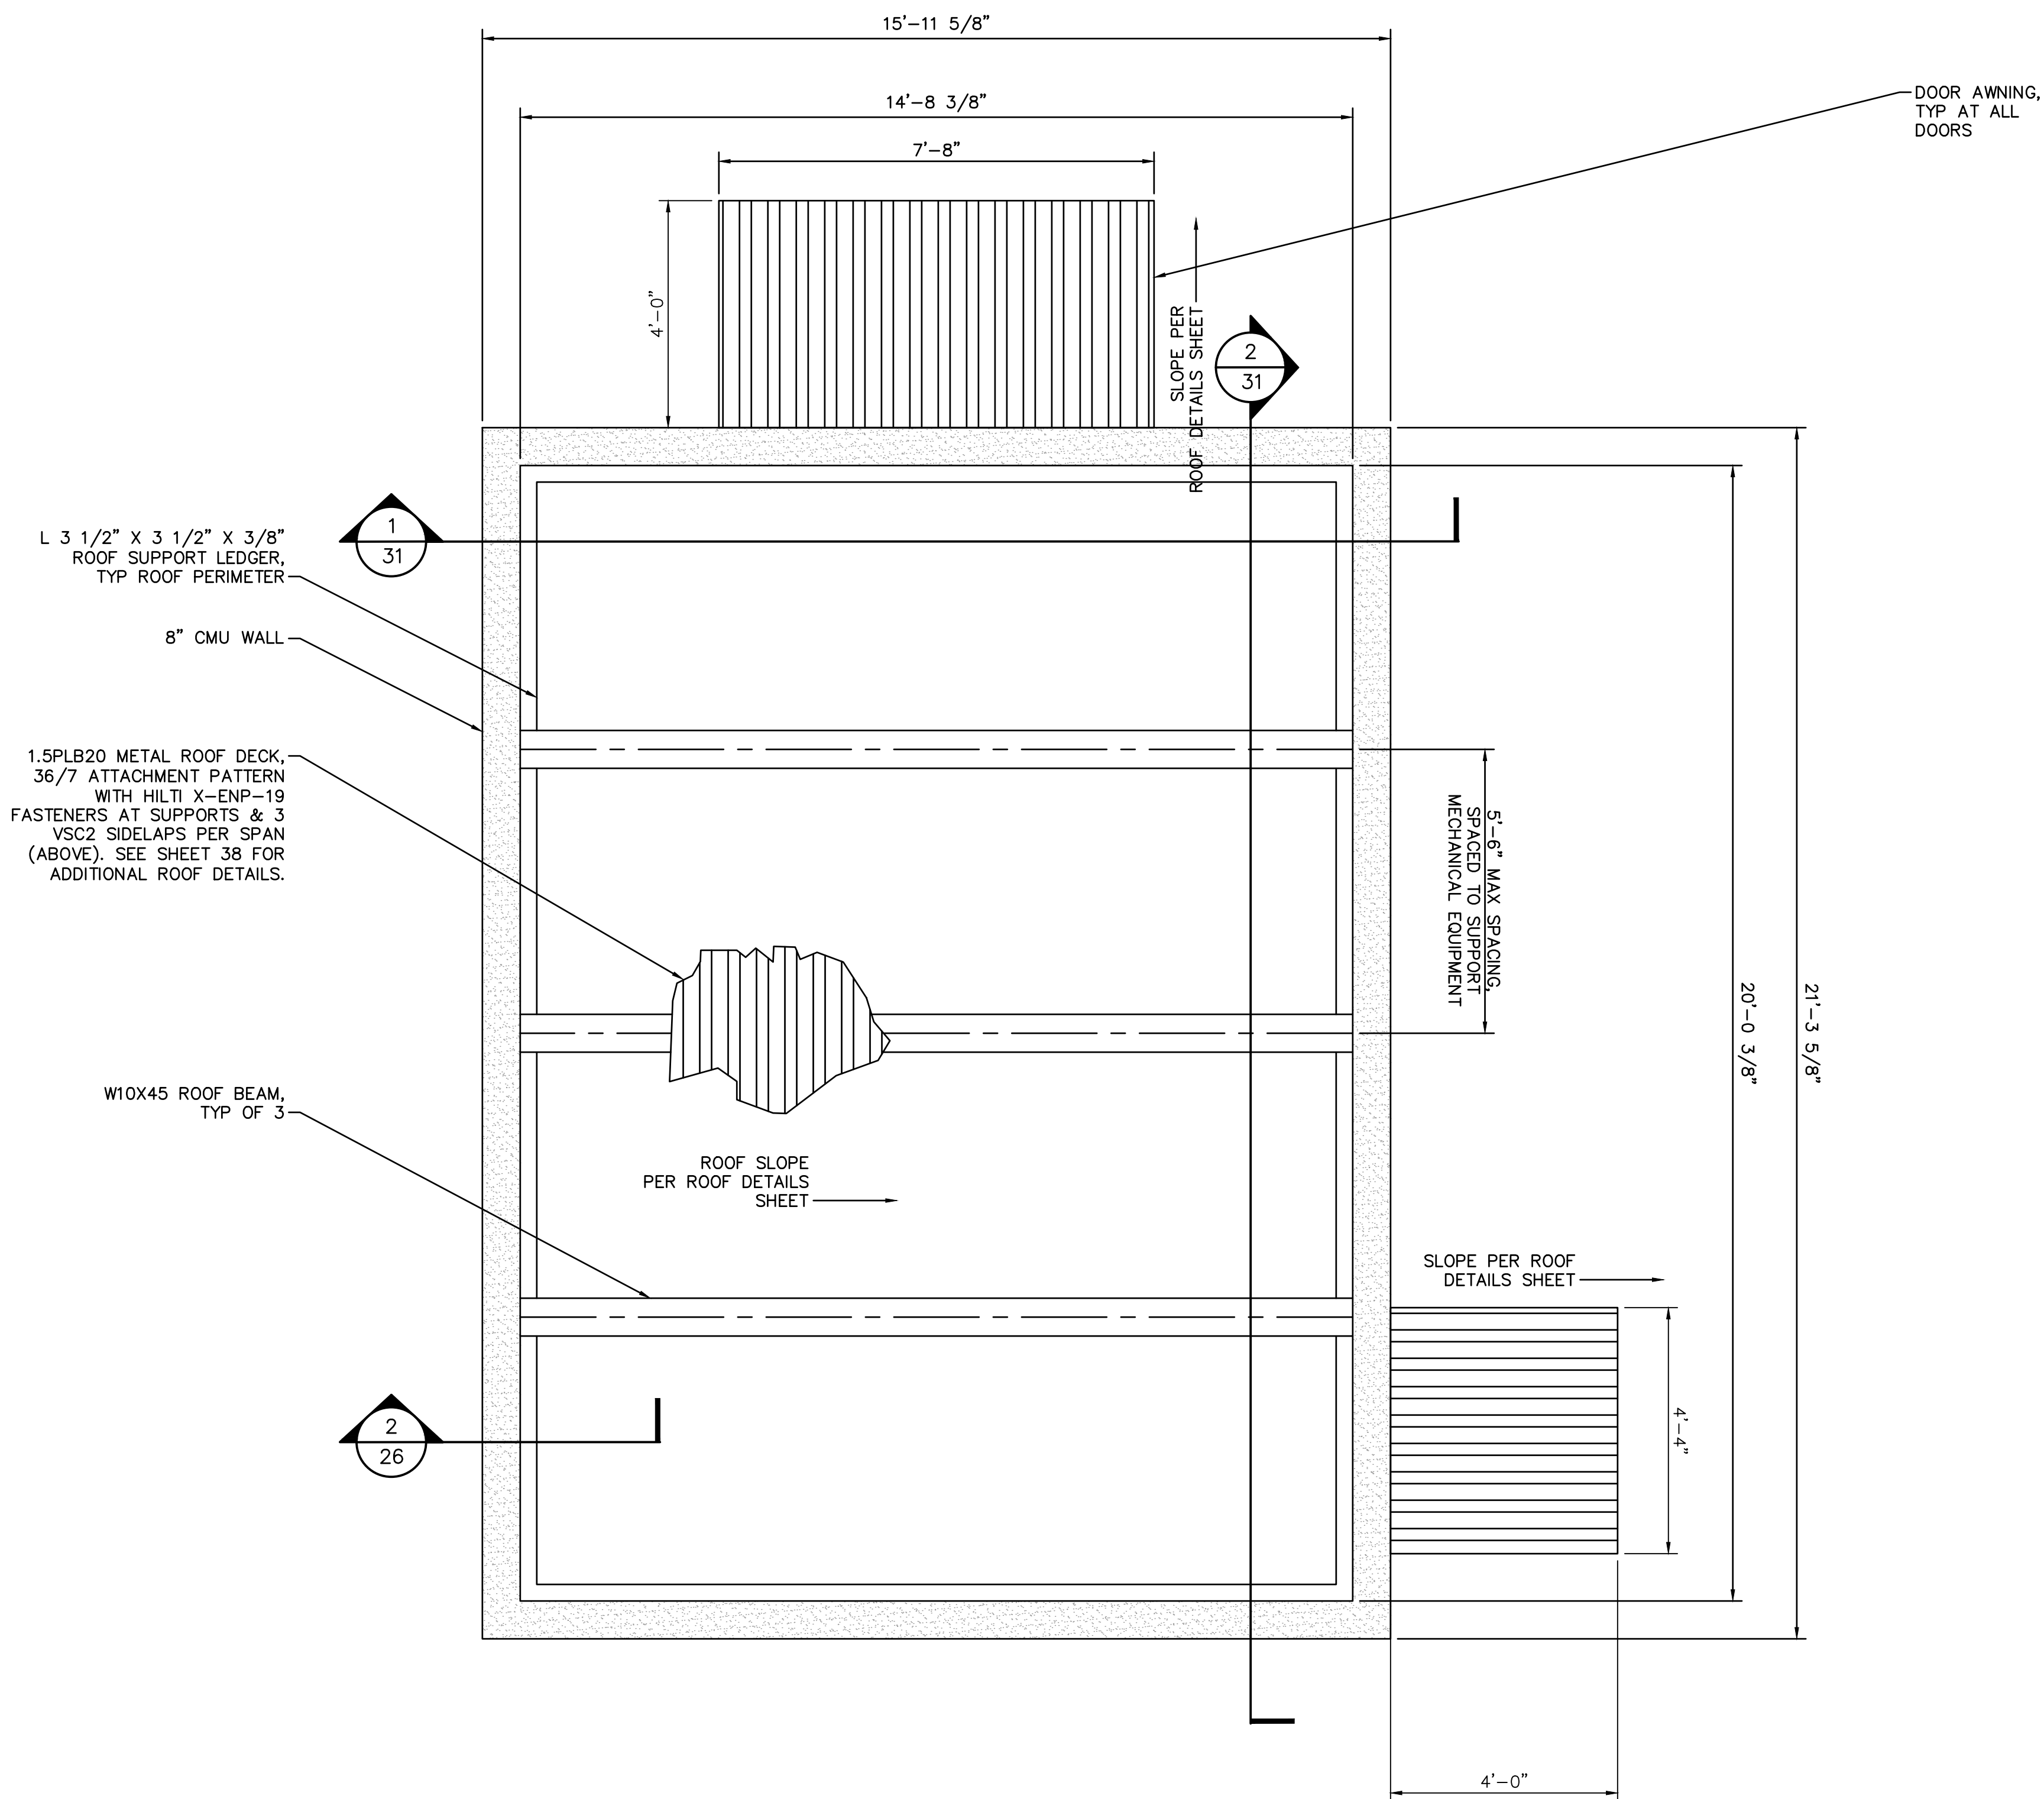

1
26 BUILDING ROOF PLAN
SCALE: 1/2" = 1'-0"

2
26 TYPICAL BUILDING WALL SECTION
SCALE: 3/4" = 1'-0"

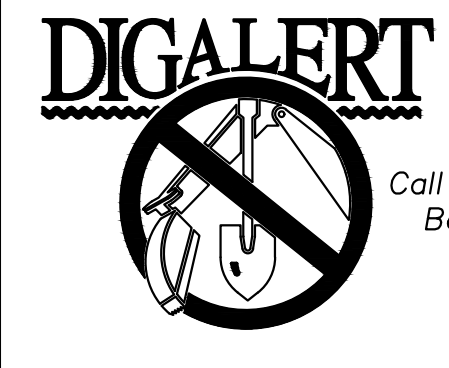


BENCHMARK:
NATIONAL GEODETIC SURVEY BENCHMARK NO. 1311
1.4 MILES WEST OF BEAUMONT ON INTERSTATE 10 TO SAN TIMOTEO CANYON NEAR FRONTAGE ROAD ON SOUTH(WEST) SIDE OF INTERSTATE 10, 0.1 MILES SOUTHEAST ALONG FRONTAGE ROAD, SOUTH ACROSS THE ROAD FROM A GUY POLE 25.9 FEET SOUTH OF THE CENTERLINE OF FRONTAGE ROAD, 1.8 FEET WEST OF POWERPOLE AND 1.8 FEET EAST OF A WITNESS POST, INSIDE A 4 INCH PVC PIPE WITH SCREW PLUG 1 INCH ABOVE GROUND (ELEVATION = 2468.07). ALSO SHOWN ON HIGHWAY 69 / POTRERO BLVD. INTERCHANGE STATIC GPS PROJECT CONTROL DIAGRAM AND IDENTIFIED THEREON AS 3558 BM D33474 WHEN THE PUBLISHED ELEVATION = 2468.07 IS CORRECTED WITH A MEASURED ELEVATION = 2468.01, USED HEREON.
ELEV. 2468.01, (NVD '88), (STAMPED Q 1311 1978)

BY	MARK	DESCRIPTION	APPR.	DATE
ENGINEER		REVISIONS	CITY	

Kimley»Horn
401 B Street, Suite 600, San Diego, CA 92101
Phone: (619) 234-9411
WWW.KIMLEY-HORN.COM

J. Brue
JUSTIN L. BRUE
P.E. 87614
8/23/2021

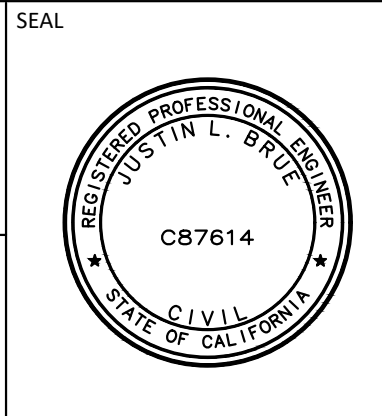

DESIGN BY: SLM
DRAWN BY: RC/SW
CHECKED BY: TW/SS
SCALE:
DATE:
JOB NUMBER: 195284001



Reviewed By: _____ Date: _____
Staff Engineer

Recommended for Approval By: *[Signature]* Date: 11/19/2021
Administrative Engineer

Approved By: *[Signature]* Date: 11/23/2021
City Engineer/Director of Public Works

CITY OF BEAUMONT, PUBLIC WORKS DEPARTMENT
ENGINEERING DIVISION


550E 6th St
Beaumont, CA 92223
TEL: (951) 769-8520 FAX: (951) 769-8526

CITY OF BEAUMONT, CALIFORNIA
IMPROVEMENT PLANS FOR:
**BEAUMONT CROSSROADS
LIFT STATION**


MCC BUILDING ROOF PLAN

SHEET
26
OF 38 SHEETS
FILE NO:
3387


Plotted By: \wulfine, Sam Sheet Set: BEAUMONT LIFT STATION MCC BUILDING ELEVATION I October 20, 2021 10:49:03am K:\SND_WATERS\195284001 Beaumont Lift Station\Design\Plan Sheets - 2020\DELTA SET\195284001 - .xst.dwg

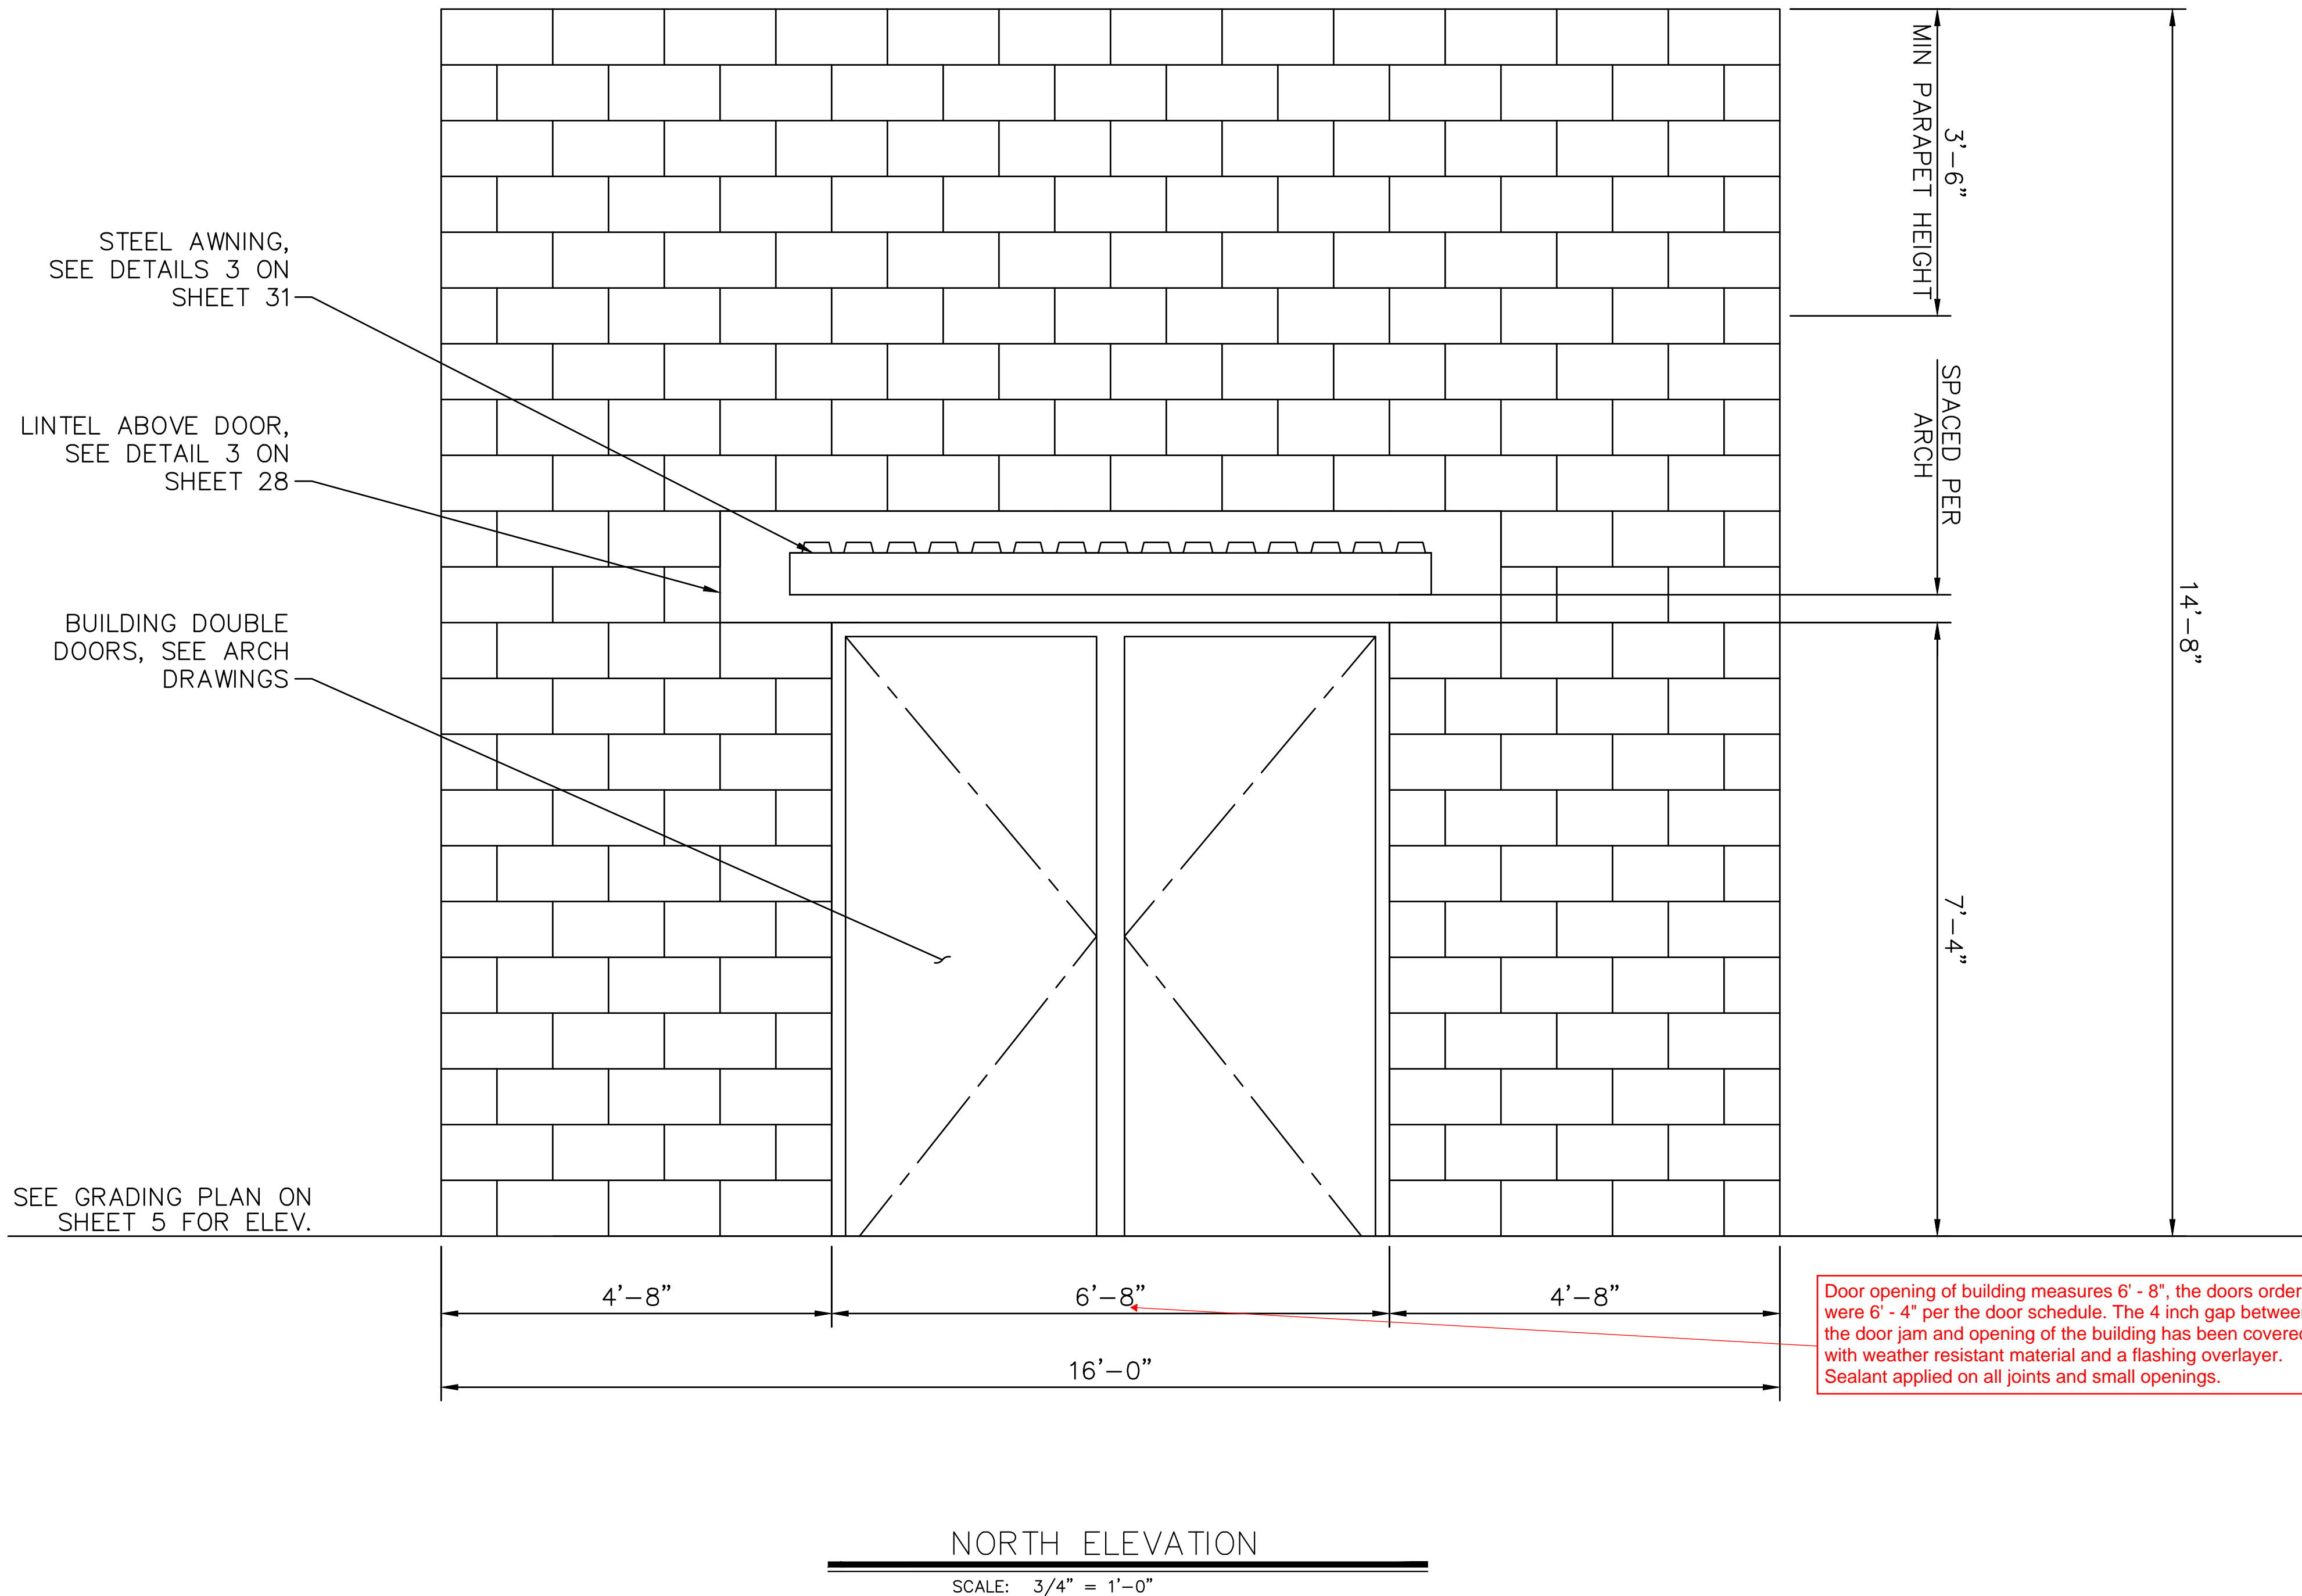


Door opening of building measures 6' - 8", the doors ordered were 6' - 4" per the door schedule. The 4 inch gap between the door jam and opening of the building has been covered with weather resistant material and a flashing overlay. Sealant applied on all joints and small openings.

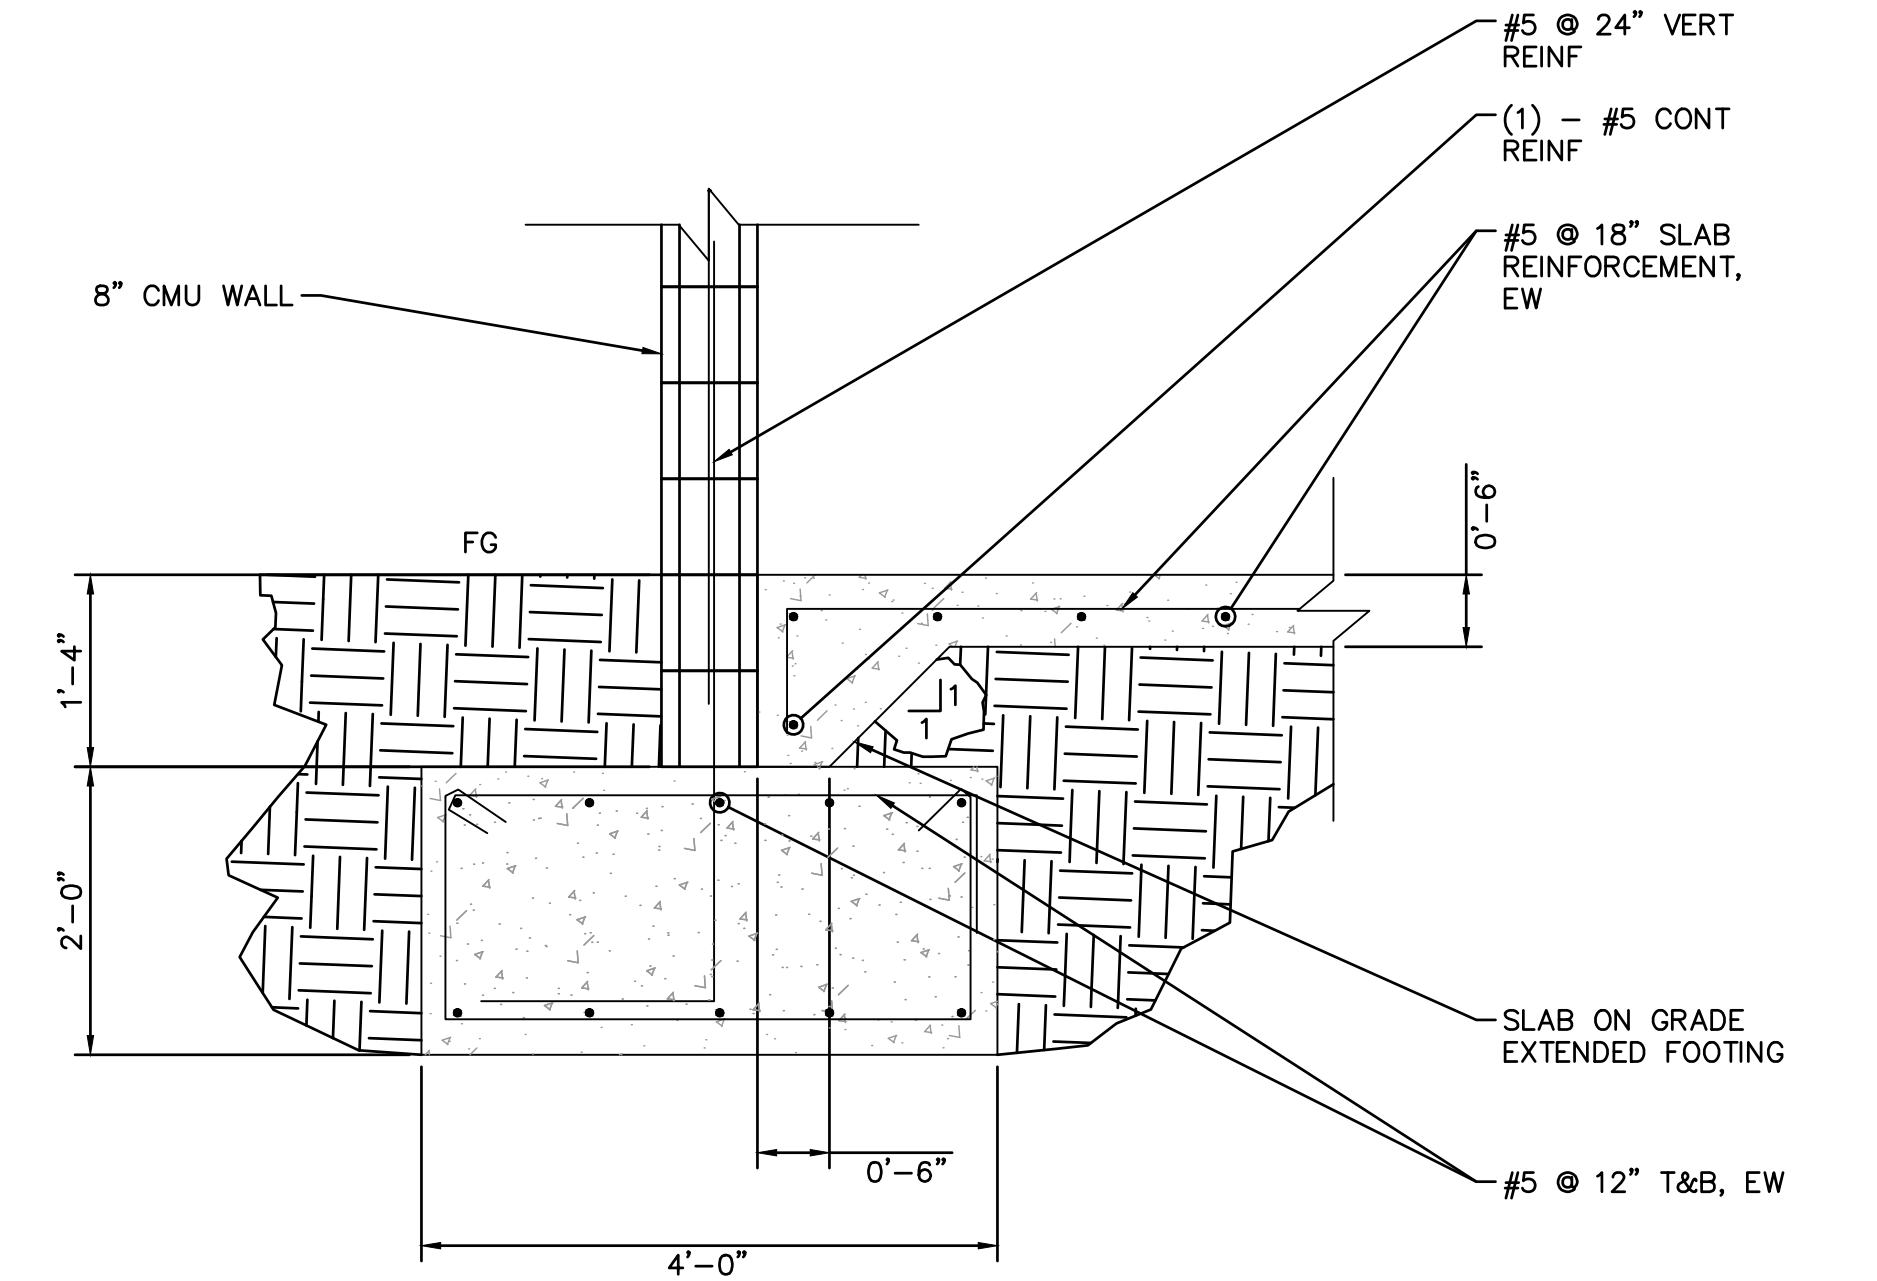

1 WALL FOUNDATION
SCALE: 3/4" = 1'-0"

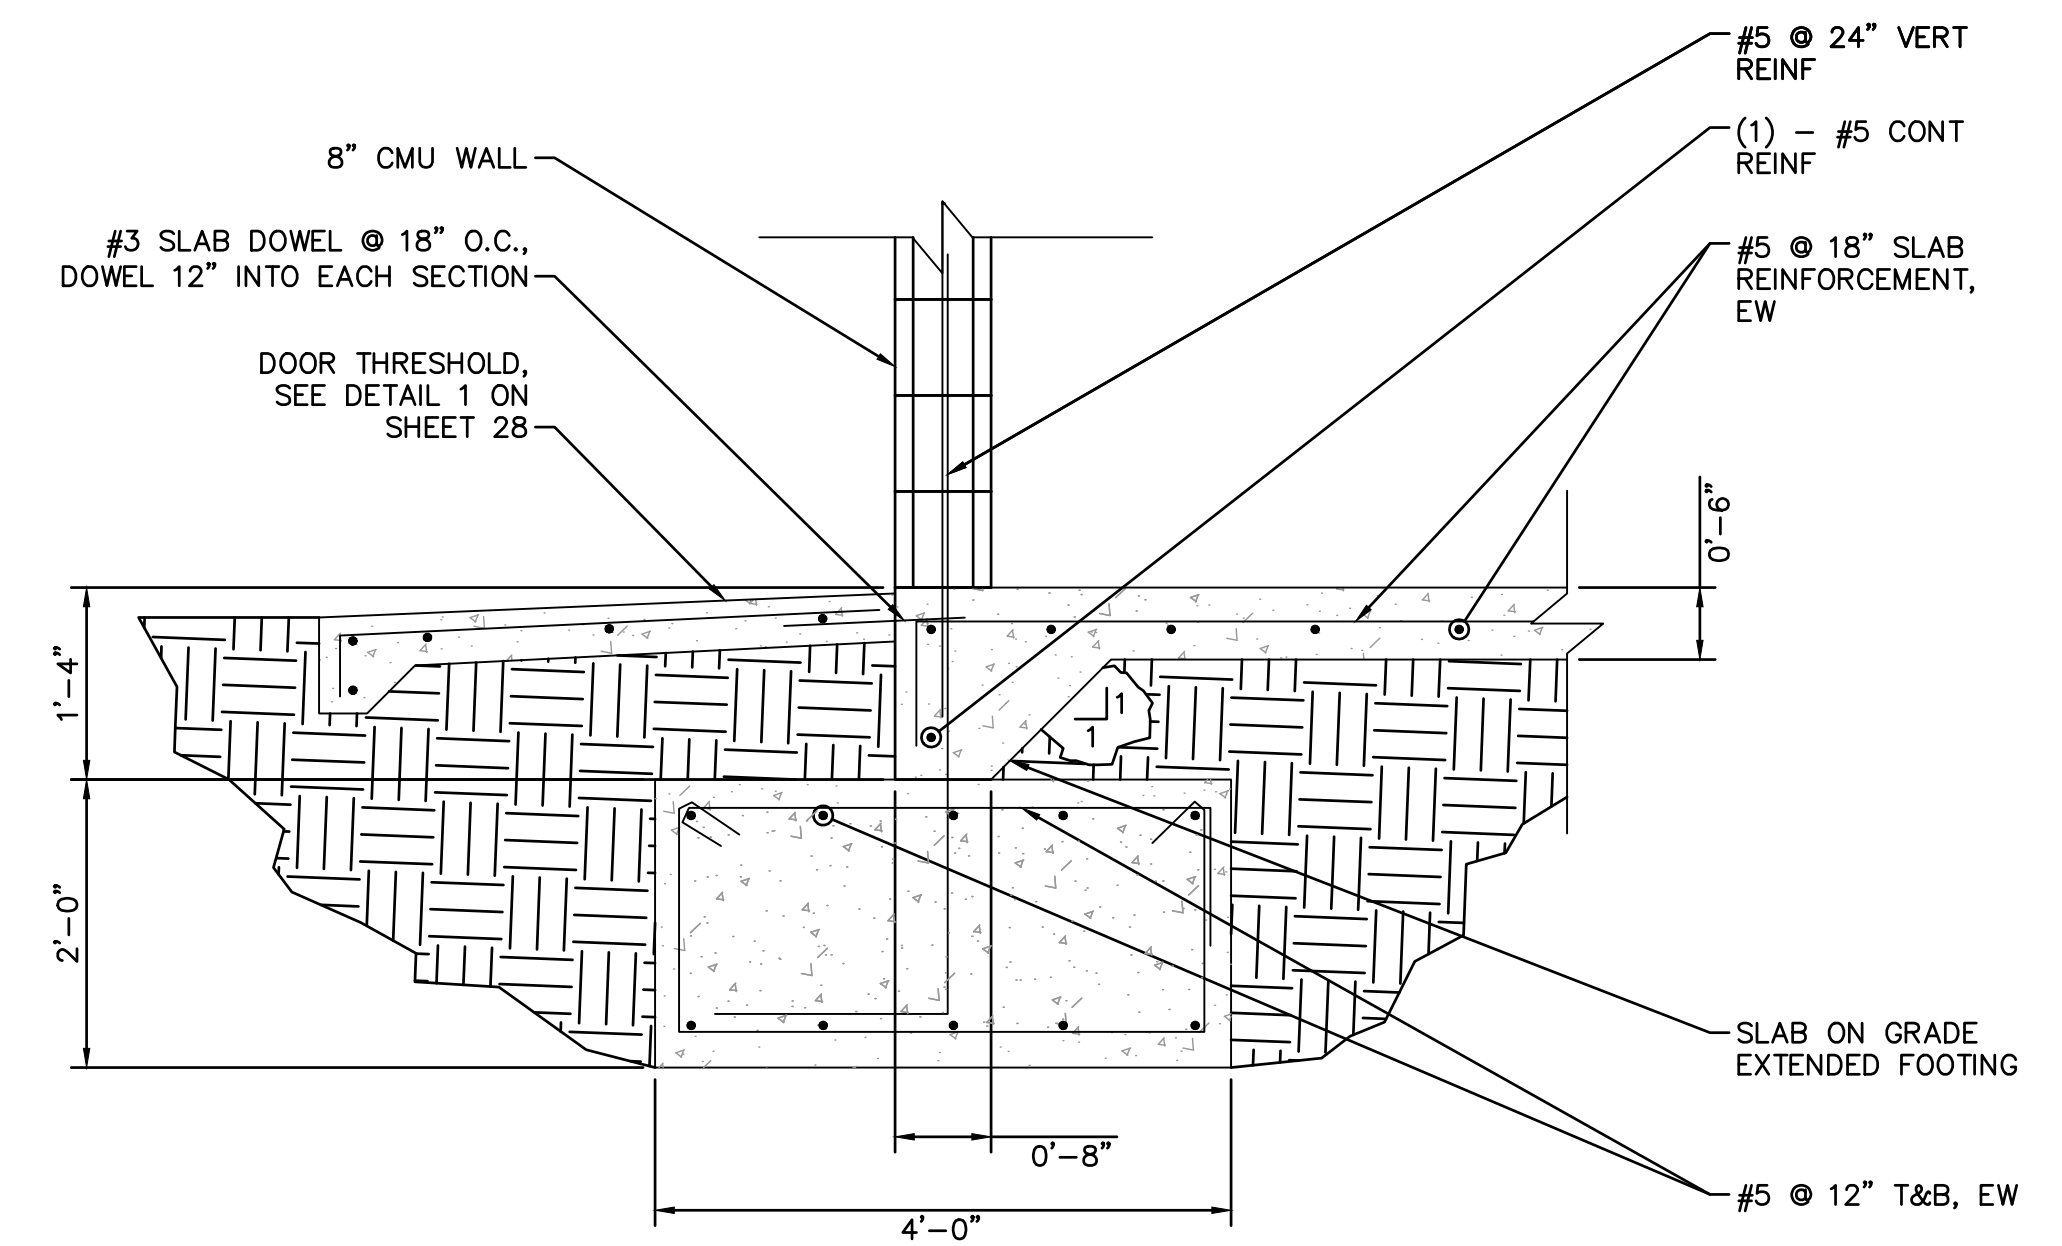

2 WALL FOUNDATION AT DOORWAY
SCALE: 3/4" = 1'-0"

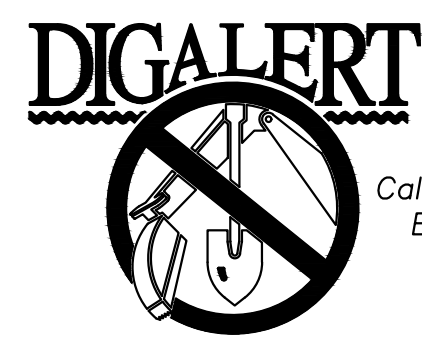


Call 2 Working Days Before You Dig! 811

BENCHMARK:
NATIONAL GEODETIC SURVEY BENCHMARK NO. 1311
1.4 MILES WEST OF BEAUMONT ON INTERSTATE 10 TO SAN TIMOTEY CANYON NEAR FRONTAGE ROAD ON SOUTH(WEST) SIDE OF INTERSTATE 10, 0.1 MILES SOUTHWEST ALONG FRONTAGE ROAD, SOUTH ACROSS THE ROAD FROM A GUY POLE 25.9 FEET SOUTH OF THE CENTERLINE OF FRONTAGE ROAD, 1.8 FEET WEST OF POWERPOLE AND 1.8 FEET EAST OF A WITNESS POST, INSIDE A 4 INCH PVC PIPE WITH SCREW PLUG 1 INCH ABOVE GROUND (ELEVATION = 2468.07). ALSO SHOWN ON HIGHWAY 69 // POTRERO BLVD. INTERCHANGE STATIC GPS PROJECT CONTROL DIAGRAM AND IDENTIFIED THEREON AS 3558 BM D33474 WHEN THE PUBLISHED ELEVATION = 2468.07 IS CORRECTED WITH A MEASURED ELEVATION = 2468.01, USED HEREON.
ELEV. 2468.01, (NVD '88), (STAMPED Q 1311 1978)

BY	MARK	DESCRIPTION	APPR.	DATE
ENGINEER		REVISIONS		CITY

Kimley»Horn
401 B Street, Suite 600, San Diego, CA 92101
Phone: (619) 234-9411
WWW.KIMLEY-HORN.COM

J. Brue
JUSTIN L. BRUE
E.C.E. 87614
8/23/2021

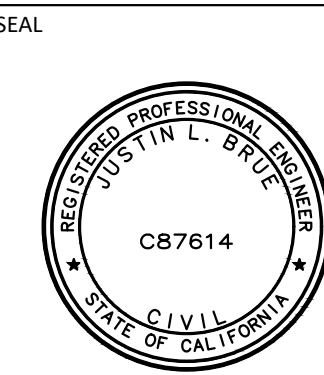

DESIGN BY: SLM
DRAWN BY: RC/SW
CHECKED BY: TW/SS
SCALE:
DATE:
JOB NUMBER: 195284001



Reviewed By: _____ Date: _____
Staff Engineer

Recommended for Approval By: *[Signature]* Date: 11/19/2021
Administrative Engineer


Approved By: *[Signature]* Date: 11/23/2021
City Engineer/Director of Public Works

CITY OF BEAUMONT, PUBLIC WORKS DEPARTMENT
ENGINEERING DIVISION
550E 6th St
Beaumont, CA 92223
TEL: (951) 789-8520 FAX: (951) 789-8526


CITY OF BEAUMONT, CALIFORNIA
IMPROVEMENT PLANS FOR:
**BEAUMONT CROSSROADS
LIFT STATION**
MCC BUILDING ELEVATION I

SHEET
27
OF 38 SHEETS
FILE NO:
3387

Plotted By: \w\lhuir, Sam, Sheet Set: BEAUMONT LIFT STATION, MCC BUILDING ELEVATION II, October 20, 2021, 10:49:05am, K:\SND_WATER\195284001_Beaumont Lift Station\Design\Plan Sheets - 2020\DELTA SET\195284001 - xST.dwg

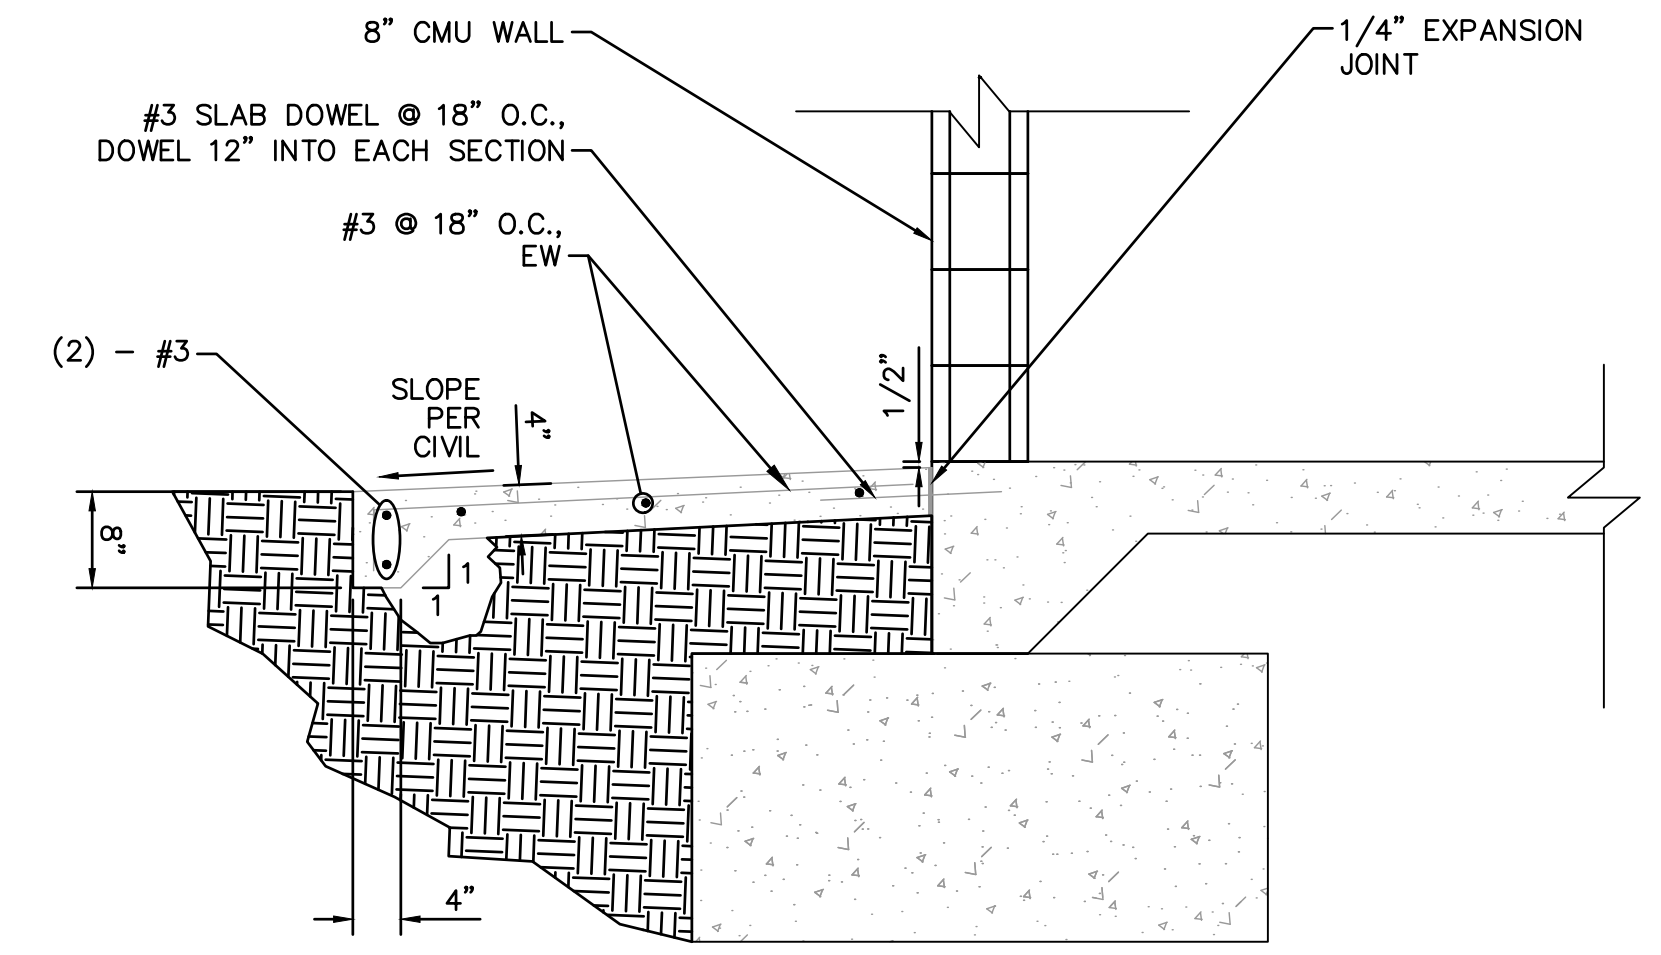


1
28 DOOR THRESHOLD FOOTING
SCALE: 3/4" = 1'-0"

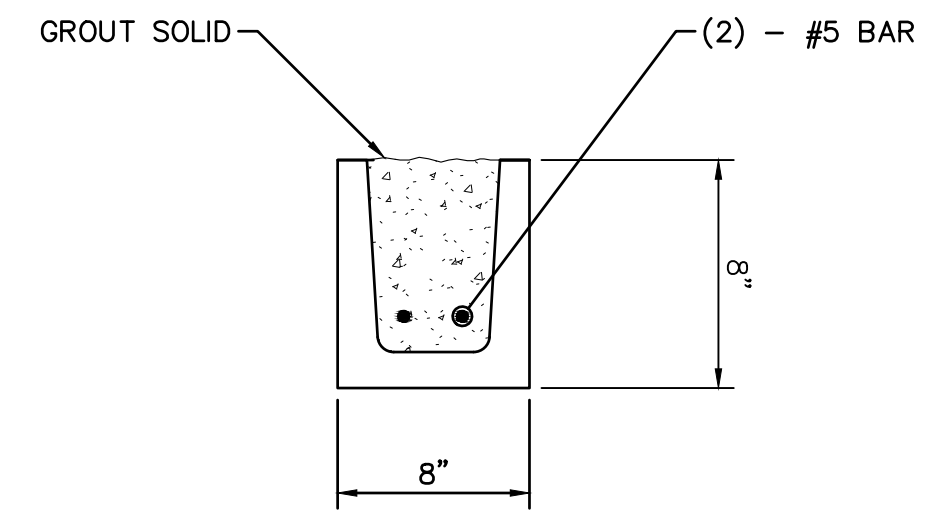

2
28 MASONRY BOND BEAM
SCALE: 1" = 1'-0"

2
28 MASONRY BOND BEAM
SCALE: 1" = 1'-0"

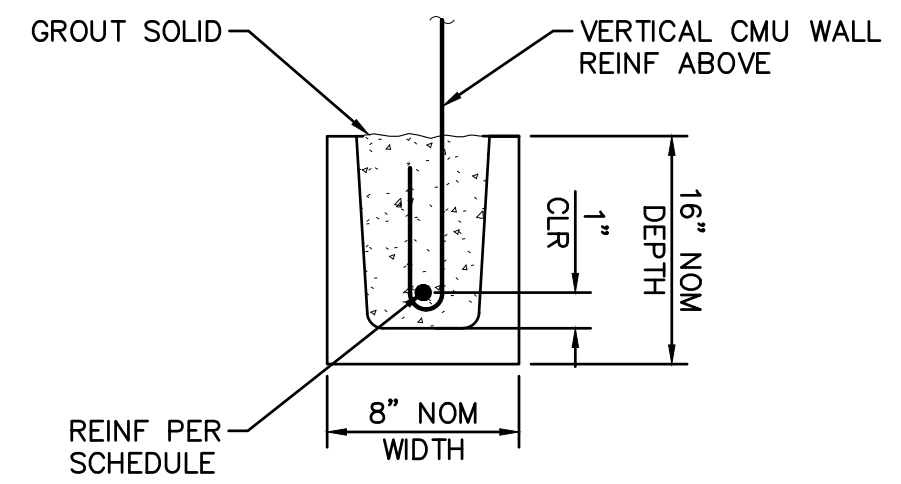


16 IN NOMINAL DEPTH LINTEL

CMU MASONRY LINTEL SCHEDULE (EXTERIOR WALLS)			
CLEAR OPENING WIDTH, W	BOND BEAM / LINTEL DEPTH	REINFORCING	MIN BEARING
W ≥ 6'-0"	16"	2 - #5	16"
W ≤ 6'-0"	16"	1 - #5	16"

- NOTES:
- EXTEND REINFORCING TO END OF BEARING AT EACH SIDE OF OPENING.
 - FILL ALL CELLS UNDER BEARING WITH GROUT AND (1) #5 VERT BARS CONT TO FOUNDATION, LOCATED DIRECTLY BELOW BEARING AT EACH SIDE OF LINTEL.
 - LINTELS SHALL BE SHORED UNTIL GROUT REACHES DESIGN COMPRESSIVE STRENGTH.
 - LINTEL SPANS BEYOND THE MAXIMUM INDICATED IN THE SCHEDULE REQUIRES SPECIAL DESIGN.

3
28 MASONRY LINTEL
SCALE: 1" = 1'-0"

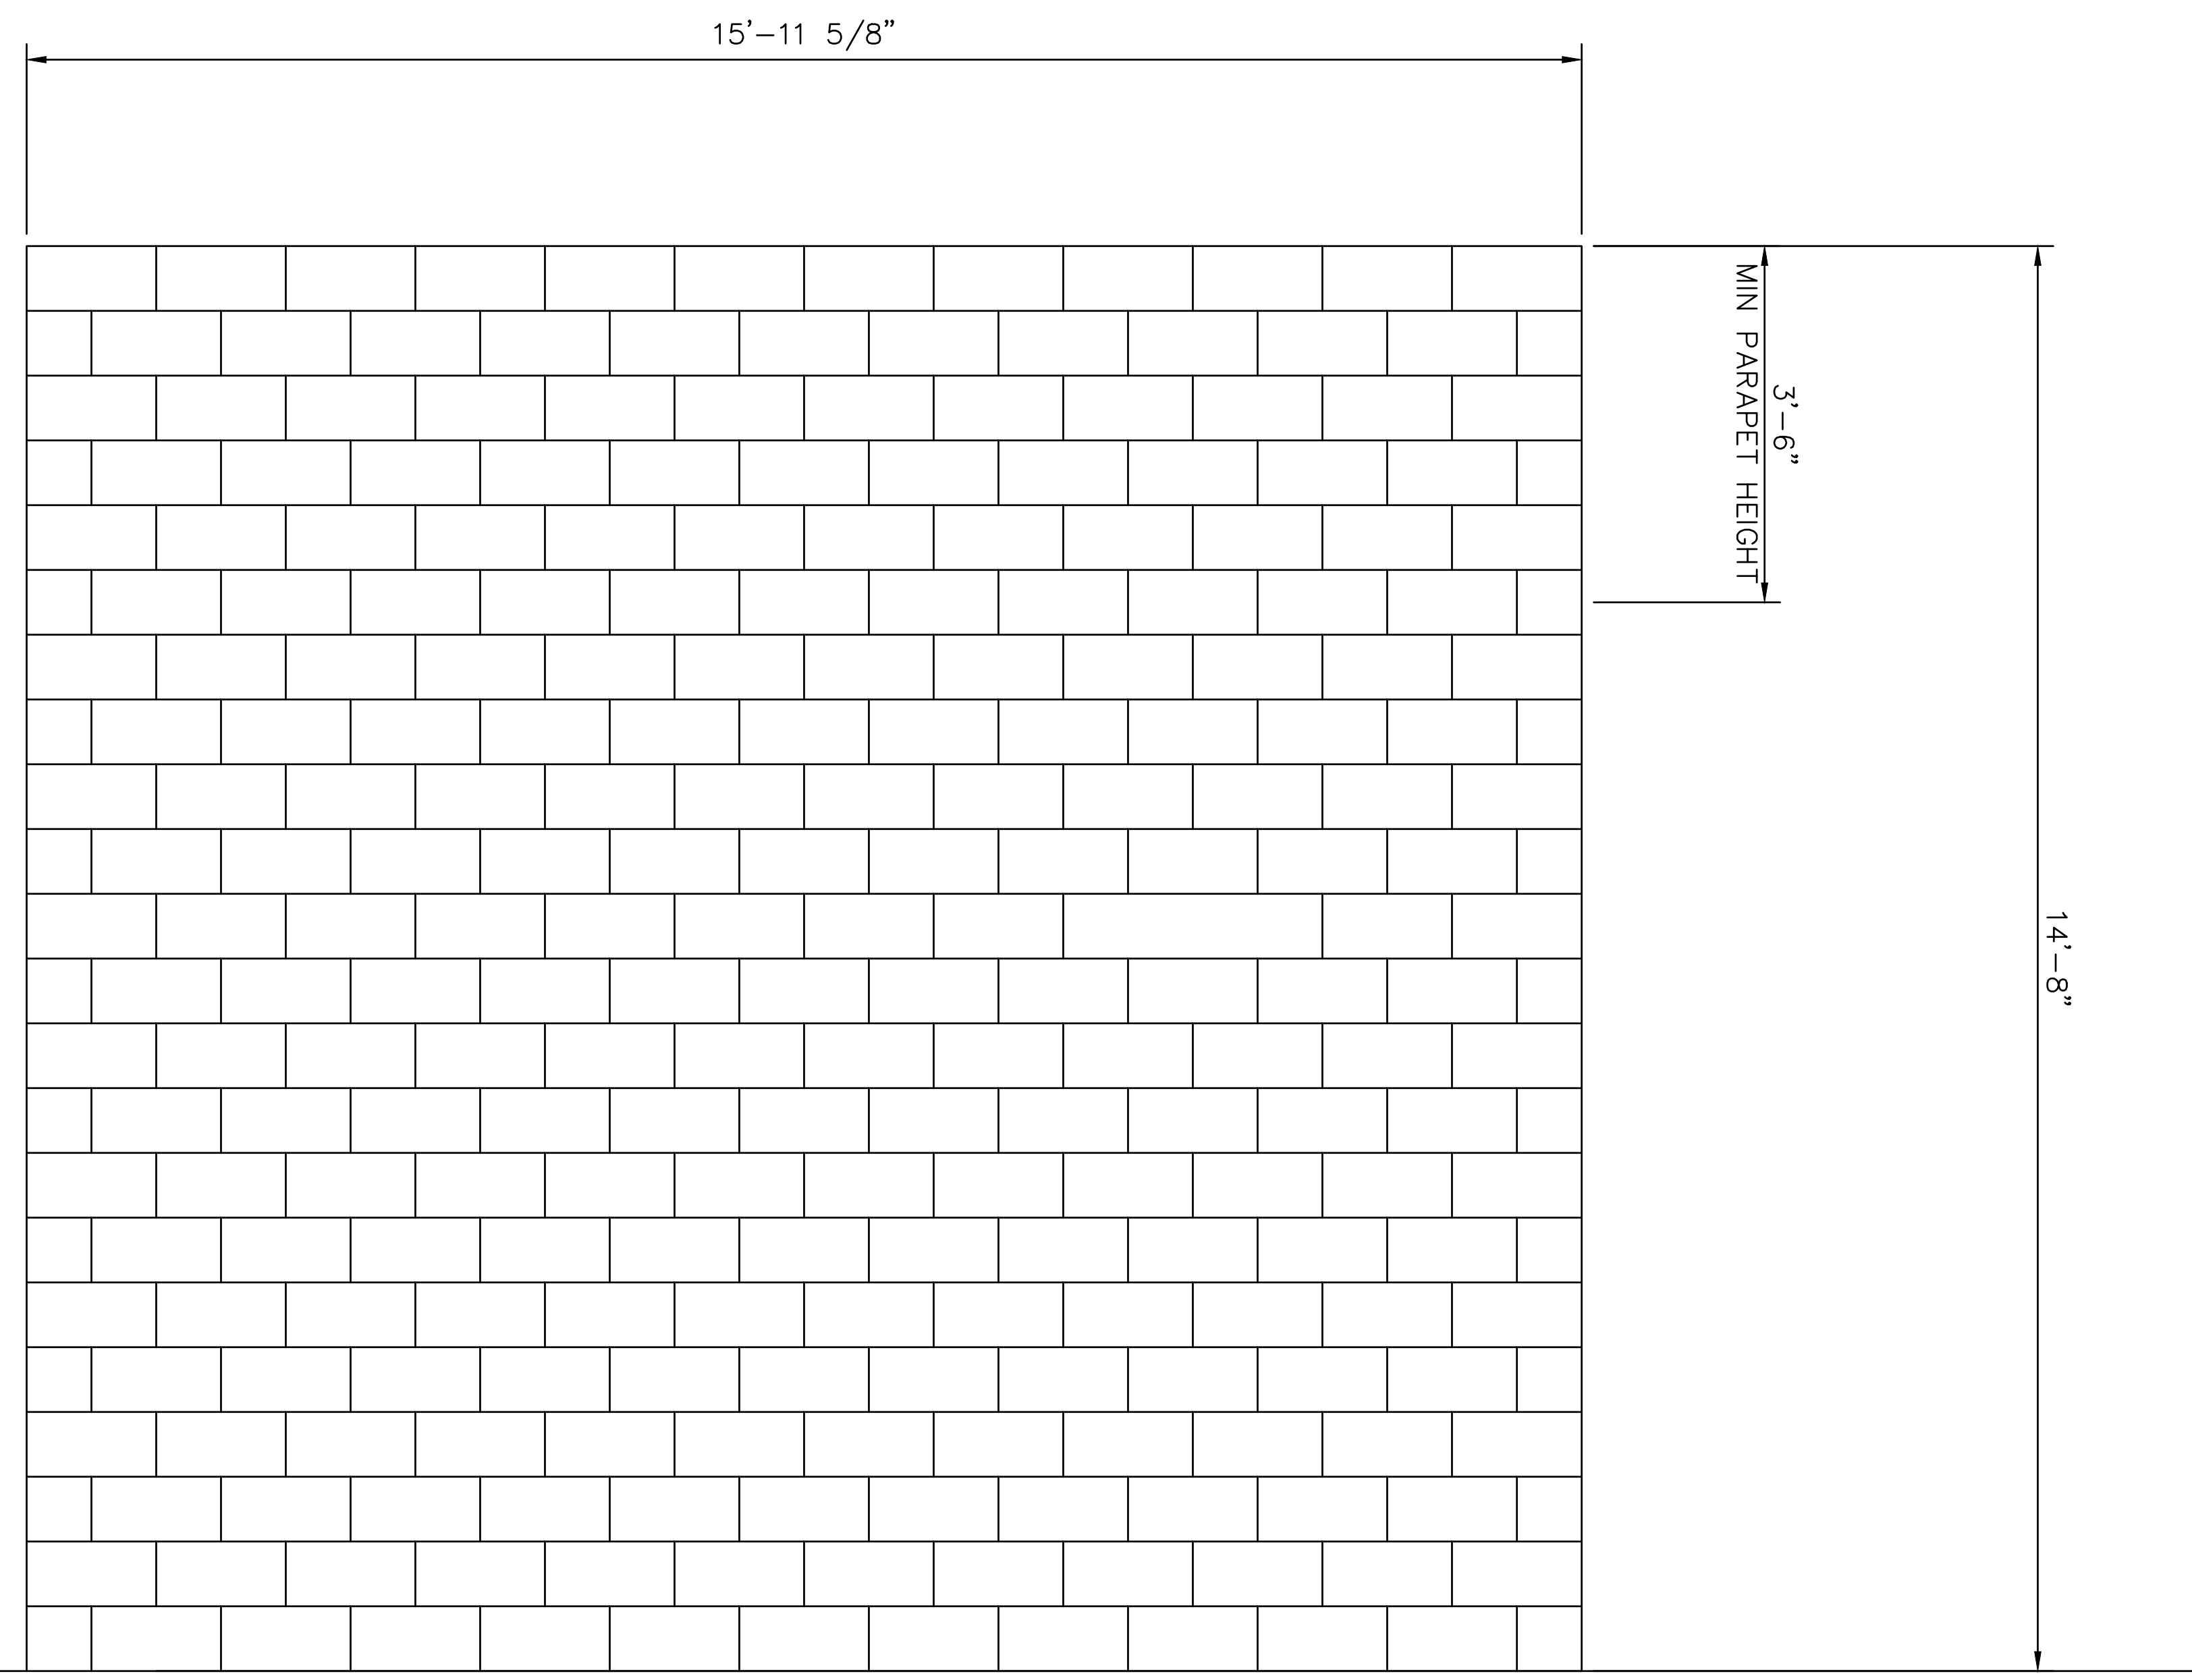

SEE GRADING PLAN ON SHEET 5 FOR ELEV.

SOUTH ELEVATION
SCALE: 3/4" = 1'-0"




BENCHMARK:
NATIONAL GEODETIC SURVEY BENCHMARK NO. Q 1311
1.4 MILES WEST OF BEAUMONT ON INTERSTATE 10 TO SAN TIMOTEO CANYON NEAR FRONTAGE ROAD ON SOUTH(WEST) SIDE OF INTERSTATE 10, 0.1 MILES SOUTHEAST ALONG FRONTAGE ROAD, SOUTH ACROSS THE ROAD FROM A GUY POLE 25.9 FEET SOUTH OF THE CENTERLINE OF FRONTAGE ROAD, 1.8 FEET WEST OF POWERPOLE AND 1.8 FEET EAST OF A WITNESS POST, INSIDE A 4 INCH PVC PIPE WITH SCREW PLUG 1 INCH ABOVE GROUND (ELEVATION = 2468.07). ALSO SHOWN ON HIGHWAY 69 // POTRERO BLVD. INTERCHANGE STATIC GPS PROJECT CONTROL DIAGRAM AND IDENTIFIED THEREON AS 3558 BM D33474 WHEN THE PUBLISHED ELEVATION = 2468.07 IS CORRECTED WITH A MEASURED ELEVATION = 2468.01, USED HEREON.
ELEV. 2468.01, (NVD '88), (STAMPED Q 1311 1978)

BY	MARK	DESCRIPTION	APPR.	DATE
ENGINEER		REVISIONS	CITY	

Kimley»Horn
401 B Street, Suite 600, San Diego, CA 92101
Phone: (619) 234-9411
WWW.KIMLEY-HORN.COM

Justin L. Brue
E.C.E. 87614

8/23/2021

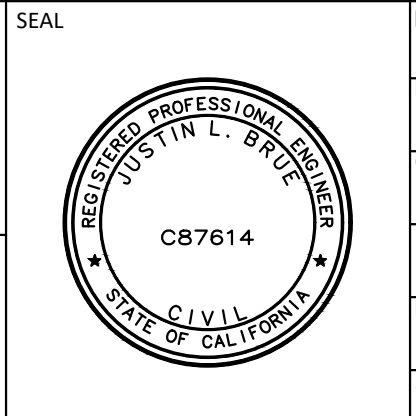

DESIGN BY: SLM
DRAWN BY: RC/SW
CHECKED BY: TW/SS
SCALE:
DATE:
JOB NUMBER: 195284001



Reviewed By: _____ Date: _____
Staff Engineer

Recommended for Approval By: *[Signature]* Date: 11/19/2021
Administrative Engineer

Approved By: *[Signature]* Date: 11/23/2021
City Engineer/Director of Public Works


CITY OF BEAUMONT, PUBLIC WORKS DEPARTMENT
ENGINEERING DIVISION

5506 6th St
Beaumont, CA 92223
TEL: (951) 769-8520 FAX: (951) 769-8528

CITY OF BEAUMONT, CALIFORNIA
IMPROVEMENT PLANS FOR:
**BEAUMONT CROSSROADS
LIFT STATION**
MCC BUILDING ELEVATION II


S H E E T
28
OF 38 SHEETS
FILE NO:
3387

Plotted By: \wulfrum, Sam, Sheet Set: BEAUMONT LIFT STATION, MCC BUILDING ELEVATION IV, October 20, 2021, 10:49:11am, K:\SND_WAY\ER195284001_Station\Design\Plan_Sheets - 2020\DELTA SET\195284001 - xst.dwg

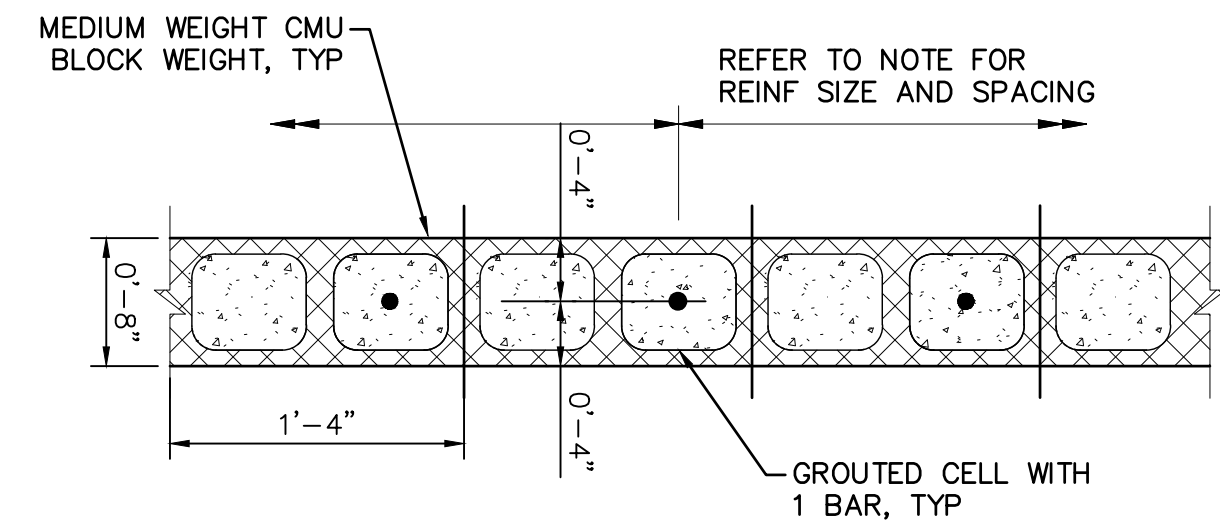


- NOTES:**
- UNLESS NOTED OTHERWISE ON THE DRAWINGS, REINFORCE ALL CMU WALL WITH (1) #5 BAR @ 24" O.C.
 - PROVIDE VERT REINF AND GROUT PER NOTE 1 IN THE ADJACENT 2 CELLS ON BOTH SIDES OF ALL OPENINGS & ENDINGS.
 - VERTICAL BARS ARE TO EXTEND A MIN OF 6" INTO THE BOND BEAM AT THE TOP OF WALL. BOND BEAMS SHALL BE REINFORCED WITH CONTINUOUS BARS ALONG BEAM PER TYPICAL DETAIL.
 - ALL CMU SHALL BE FULLY GROUTED.
 - PROVIDE AN OPEN BOTTOM BOND BEAM REINF WITH (1) #5 CONT BARS AT THE FOLLOWING LOCATIONS:
 - AT THE TOP OF ALL WALL ELEVATIONS.

1 TYPICAL CMU WALL REINF
SCALE: 1" = 1'-0"

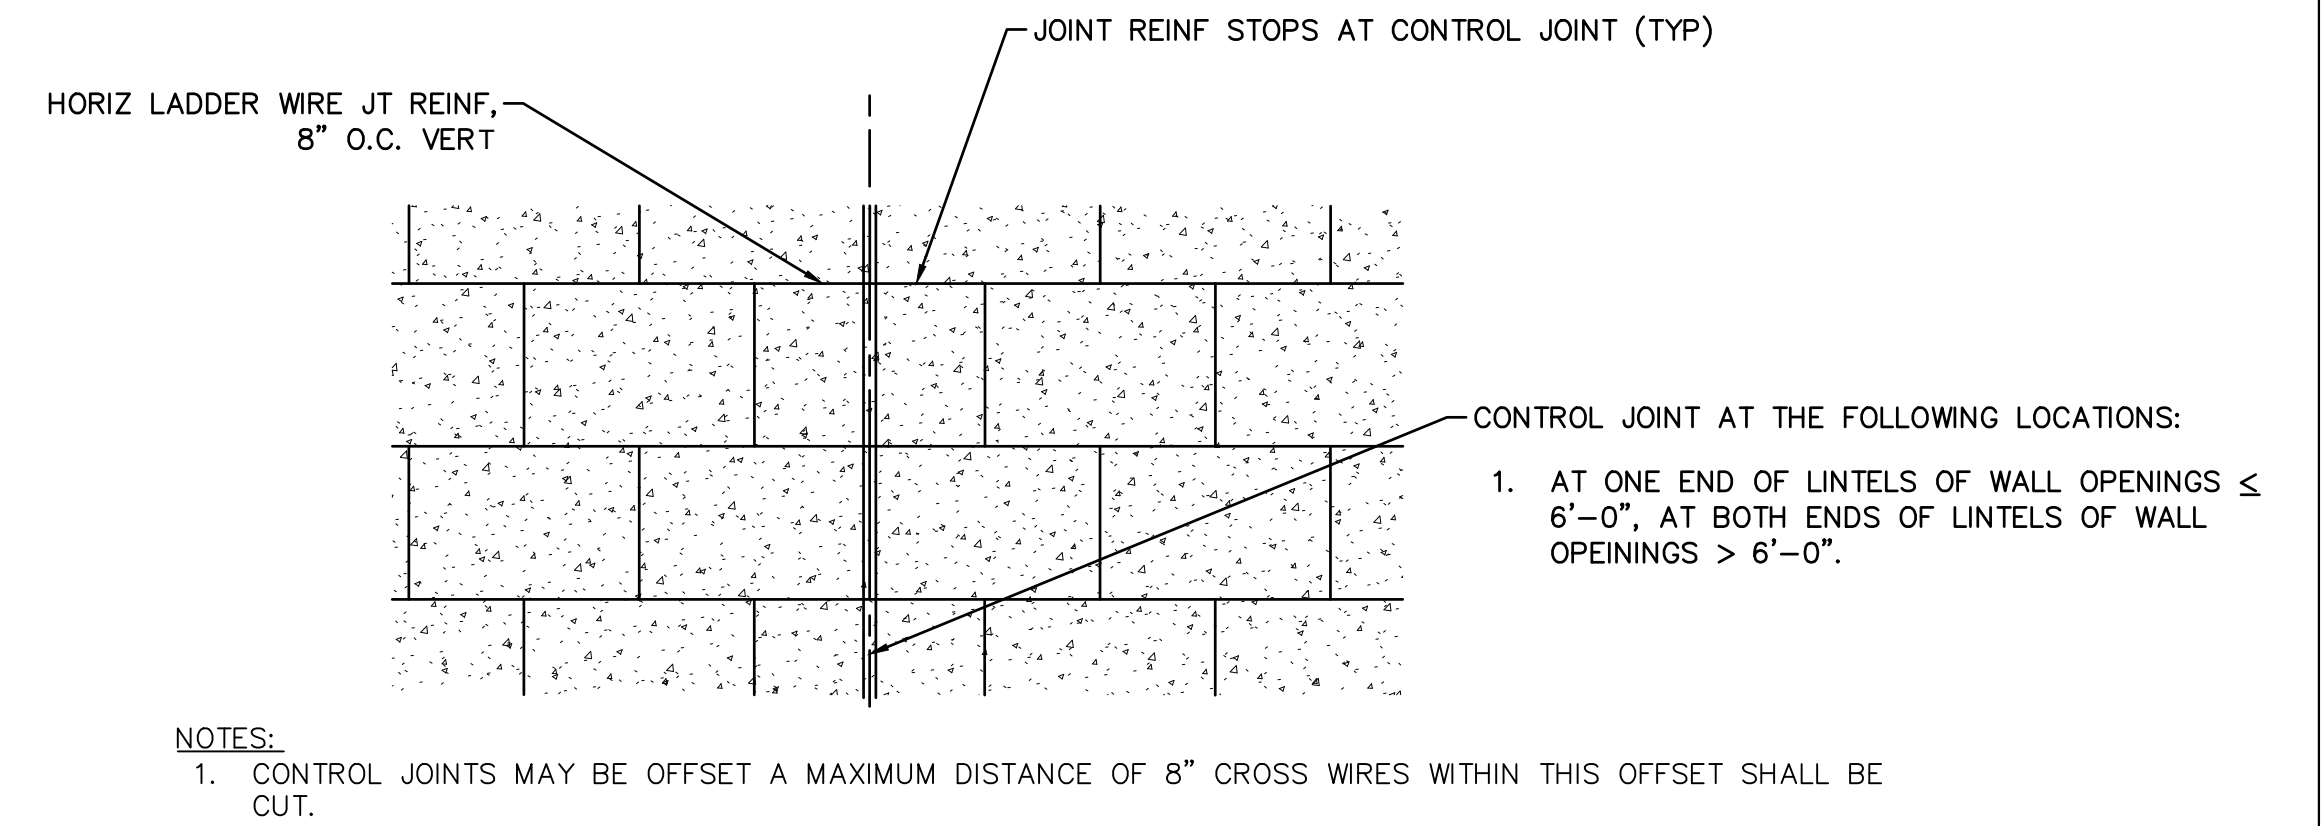


ELEVATION

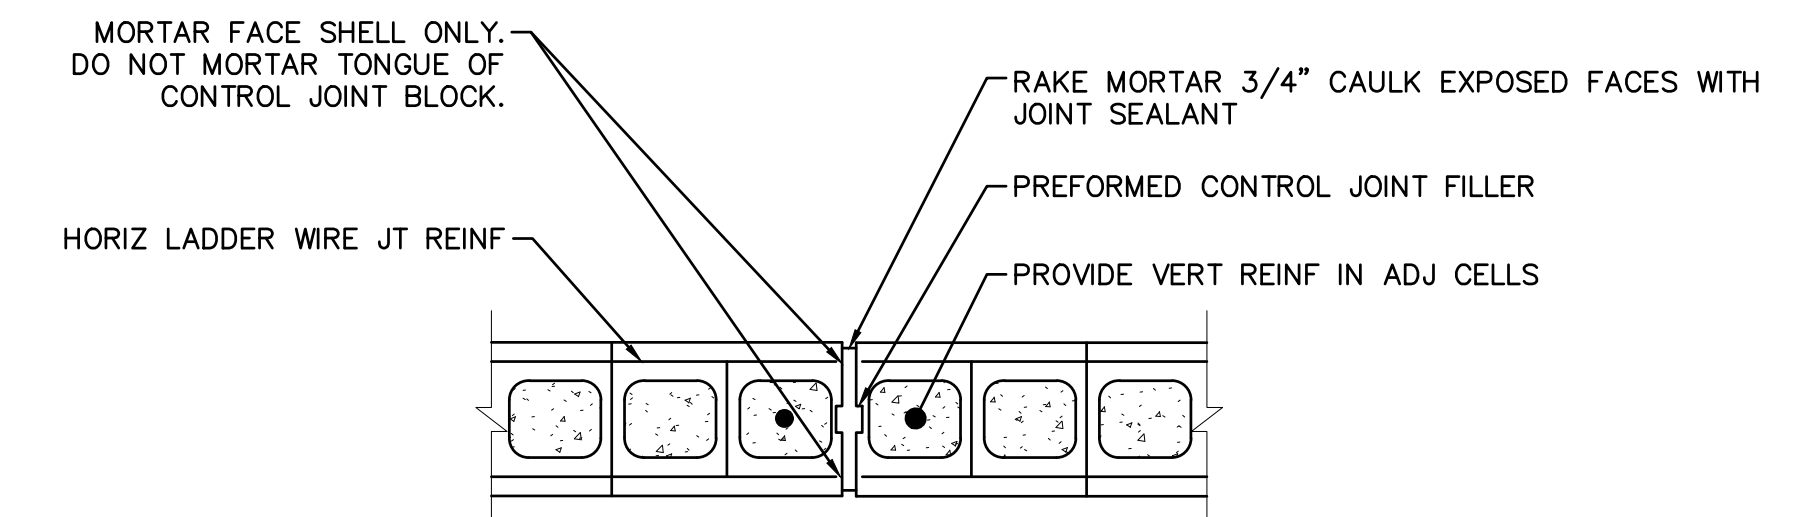

PLAN


2 CMU WALL CONTROL JOINT
SCALE: 1" = 1'-0"

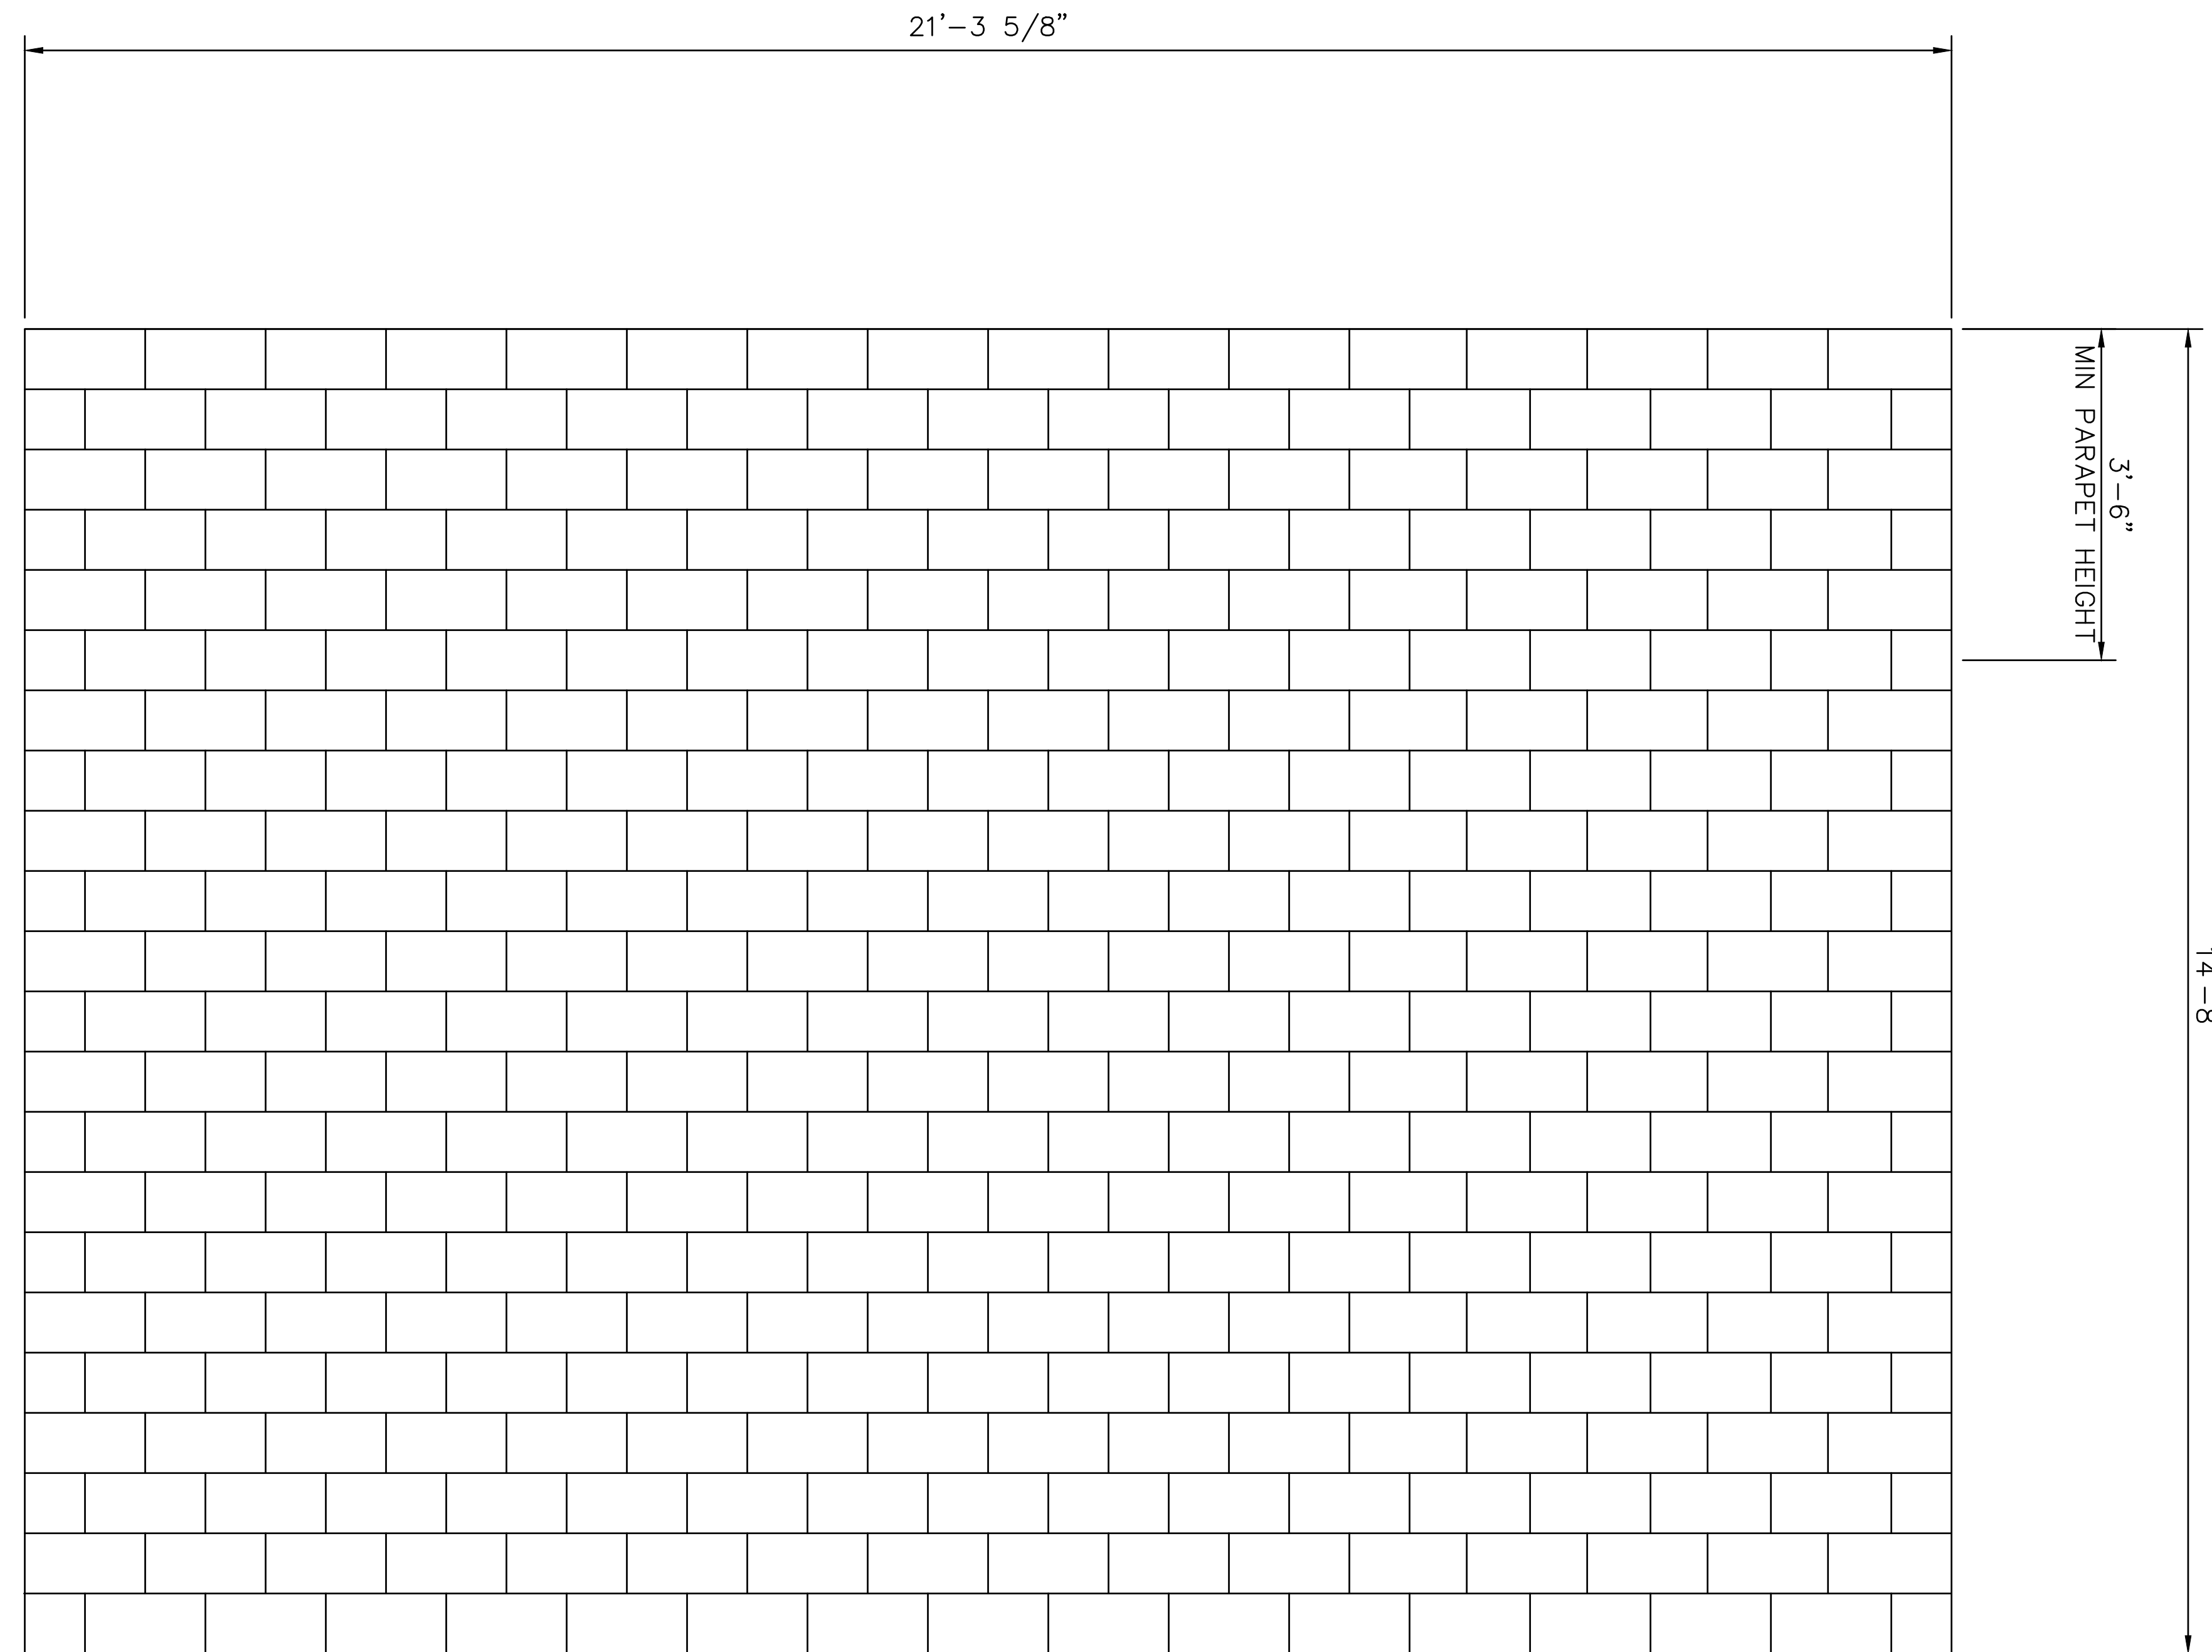

WEST ELEVATION

SCALE: 3/4" = 1'-0"

SEE GRADING PLAN ON SHEET 5 FOR ELEV

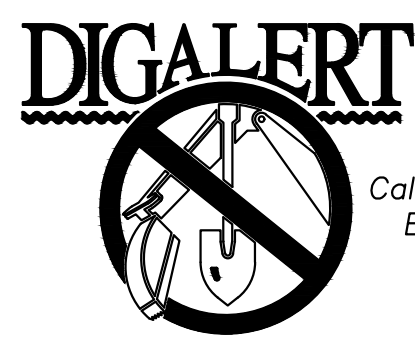

Call 2 Working Days Before You Dig! 811


BENCHMARK:
NATIONAL GEODETIC SURVEY BENCHMARK NO. Q 1311
1.4 MILES WEST OF BEAUMONT ON INTERSTATE 10 TO SAN TIMOTEO CANYON NEAR FRONTAGE ROAD ON SOUTH(WEST) SIDE OF INTERSTATE 10, 0.1 MILES SOUTHWEST ALONG FRONTAGE ROAD, SOUTH ACROSS THE ROAD FROM A GUY POLE 25.9 FEET SOUTH OF THE CENTERLINE OF FRONTAGE ROAD, 1.8 FEET WEST OF POWERPOLE AND 1.8 FEET EAST OF A WITNESS POST, INSIDE A 4 INCH PVC PIPE WITH SCREW PLUG 1 INCH ABOVE GROUND (ELEVATION = 2468.07). ALSO SHOWN ON HIGHWAY 69 // POTRERO BLVD. INTERCHANGE STATIC GPS PROJECT CONTROL DIAGRAM AND IDENTIFIED THEREON AS 3508 BM D3474 WHEN THE PUBLISHED ELEVATION = 2468.07 IS CORRECTED WITH A MEASURED ELEVATION = 2468.01, USED HEREON.
ELEV. 2468.01, (NVD '88), (STAMPED Q 1311 1978)

BY	MARK	DESCRIPTION	APPR.	DATE
ENGINEER		REVISIONS	CITY	

Kimley»Horn
401 B Street, Suite 600, San Diego, CA 92101
Phone: (619) 234-9411
WWW.KIMLEY-HORN.COM

J. Brue
JUSTIN L. BRUE
P.C.E. 87614

8/23/2021

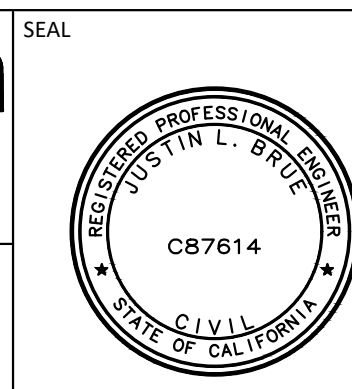

DESIGN BY: SLM
DRAWN BY: RC/SW
CHECKED BY: TW/SS
SCALE:
DATE:
JOB NUMBER: 195284001



Reviewed By: _____ Date: _____
Staff Engineer

Recommended for Approval By: *P. Harts* Date: 11/19/2021
Administrative Engineer

Approved By: *John D. Harts* Date: 11/23/2021
City Engineer/Director of Public Works


CITY OF BEAUMONT, PUBLIC WORKS DEPARTMENT
ENGINEERING DIVISION

550E 6th St
Beaumont, CA 92223
TEL: (951) 789-8520 FAX: (951) 789-8526


CITY OF BEAUMONT, CALIFORNIA
IMPROVEMENT PLANS FOR:
**BEAUMONT CROSSROADS
LIFT STATION**
MCC BUILDING ELEVATION IV

SHEET
30
OF 38 SHEETS
FILE NO:
3387


Plotted By: V:\m\luc... Sheet: S:\BEAUMONT LIFT STATION STRUCTURAL DETAILS 1 October 20, 2021 10:49:13am K:\SND_WATER\195284001 Beaumont Lift Station\Design\Plan Sheets - 2020\DELTA SET\195284001 - vst.dwg

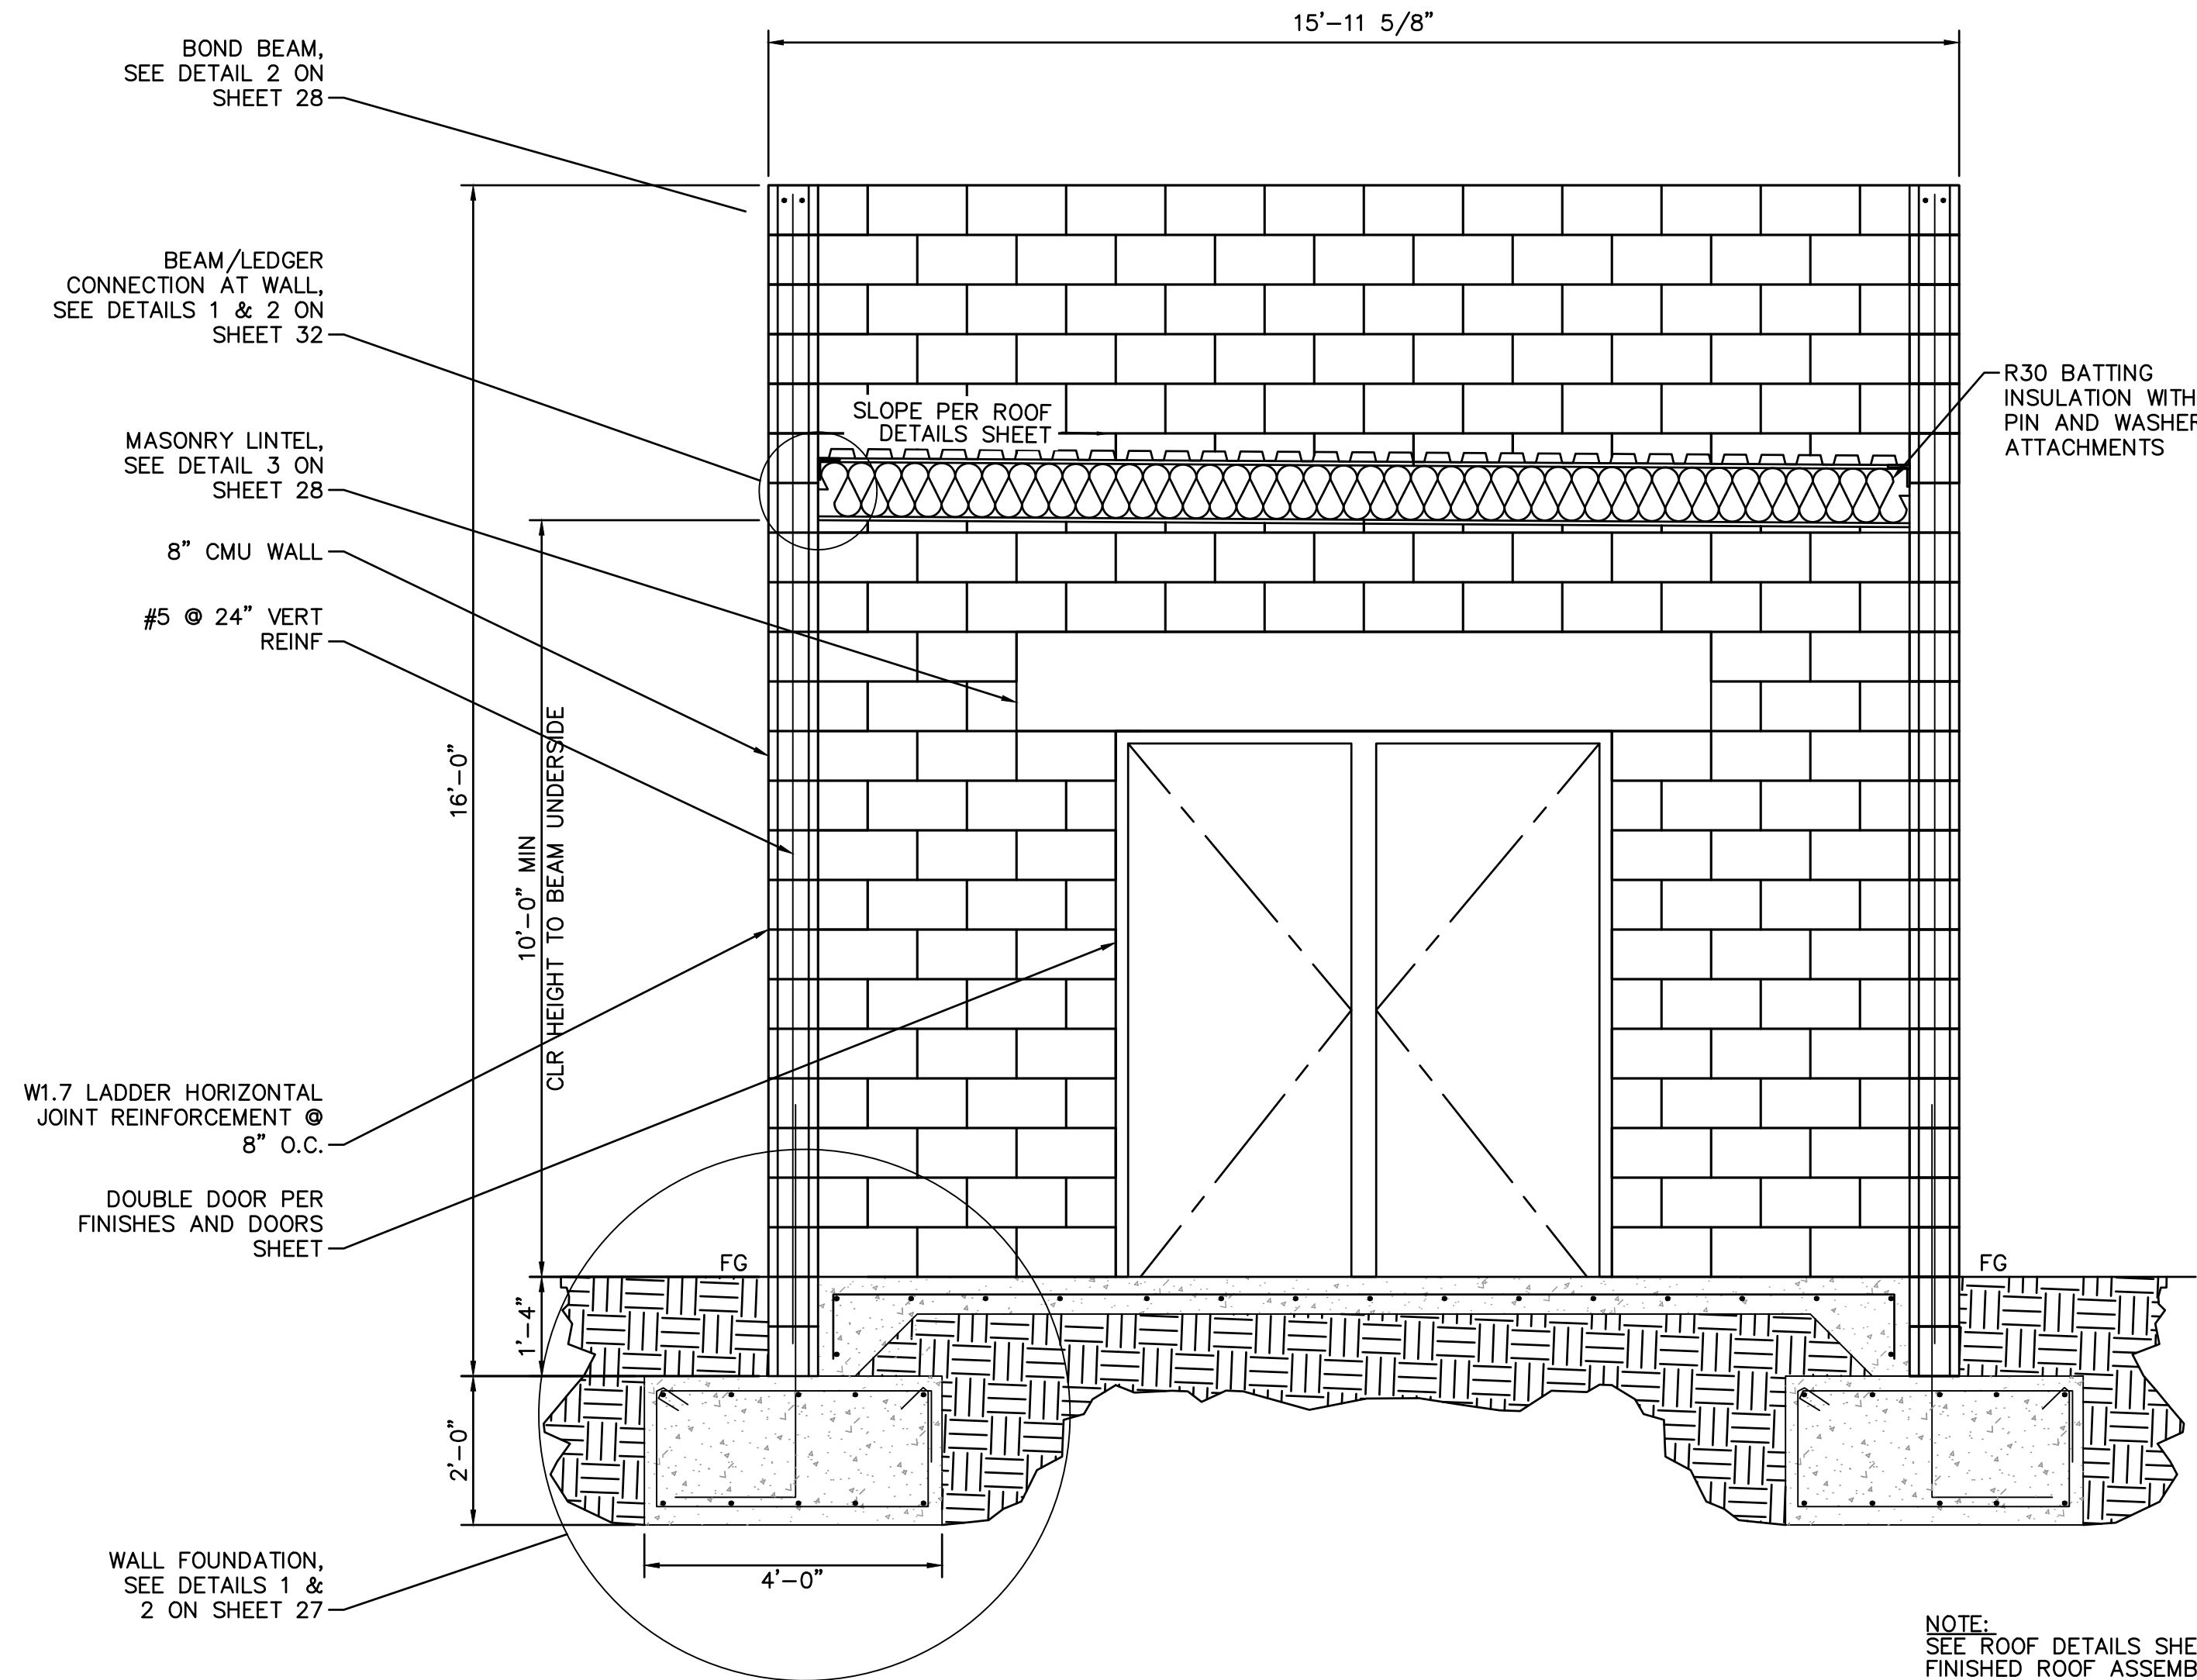


1 BUILDING WIDTH SECTION
 SCALE: 1/2" = 1'-0"

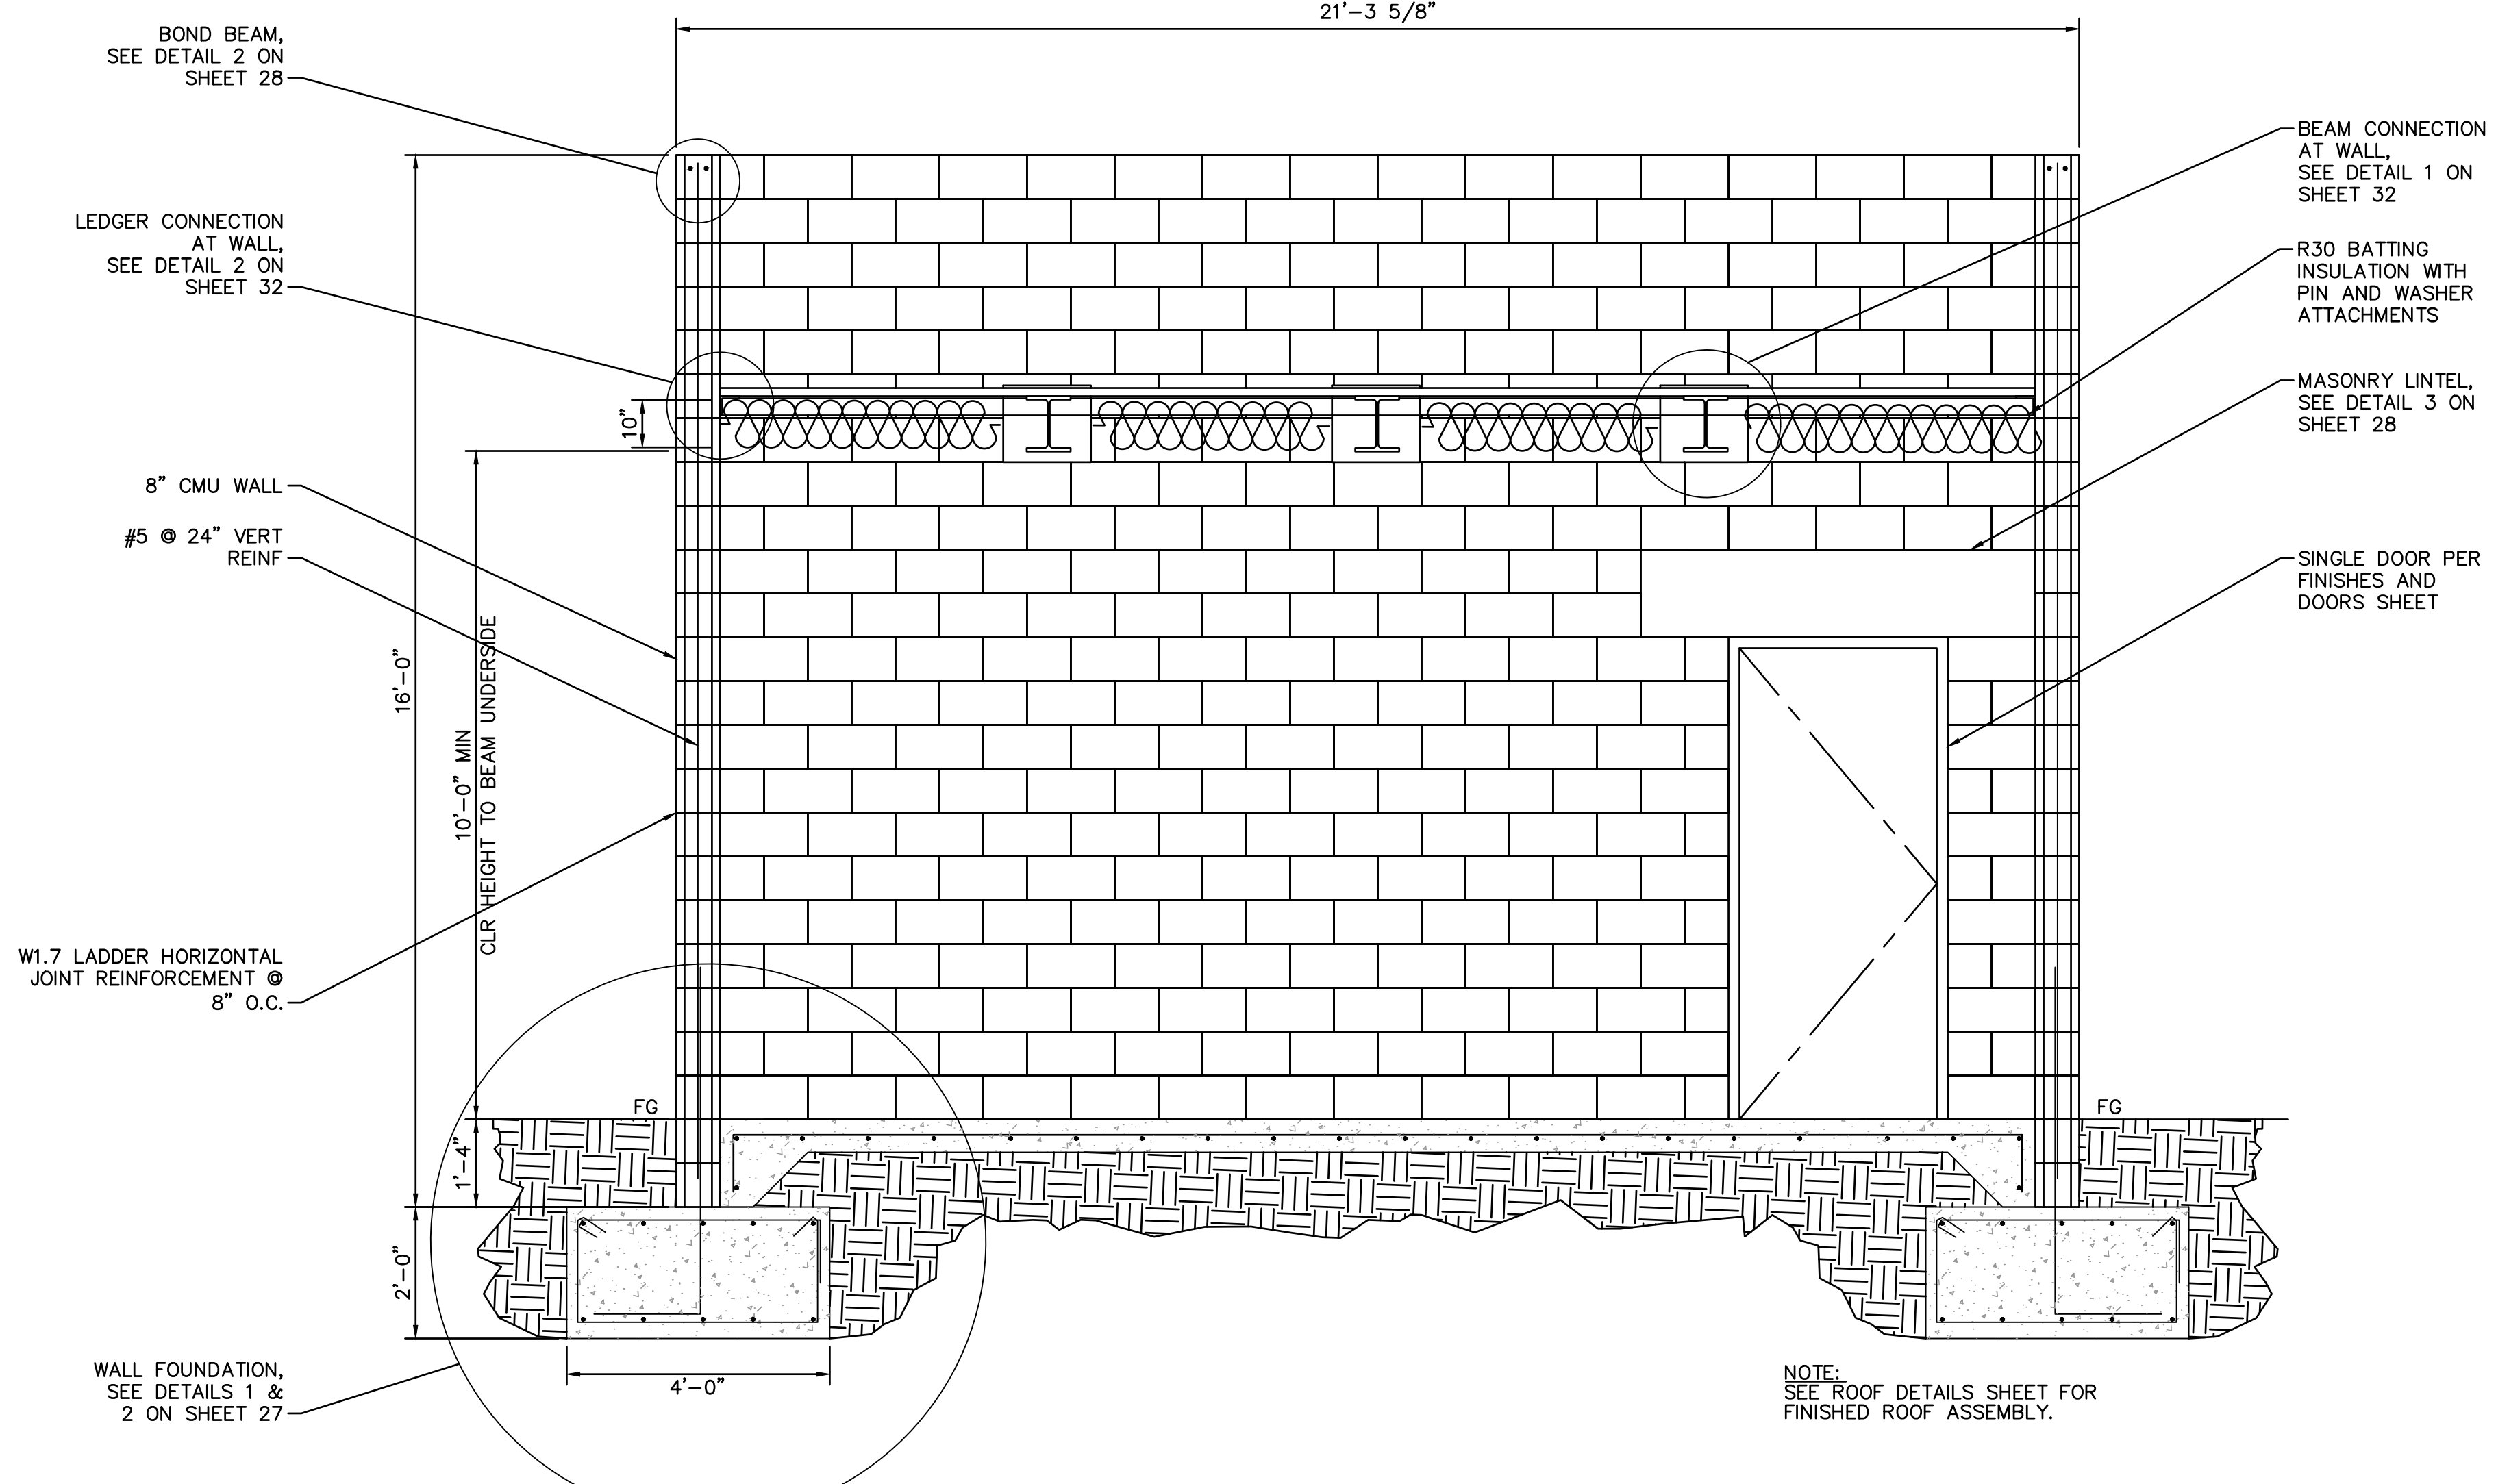

2 BUILDING LENGTH SECTION
 SCALE: 1/2" = 1'-0"

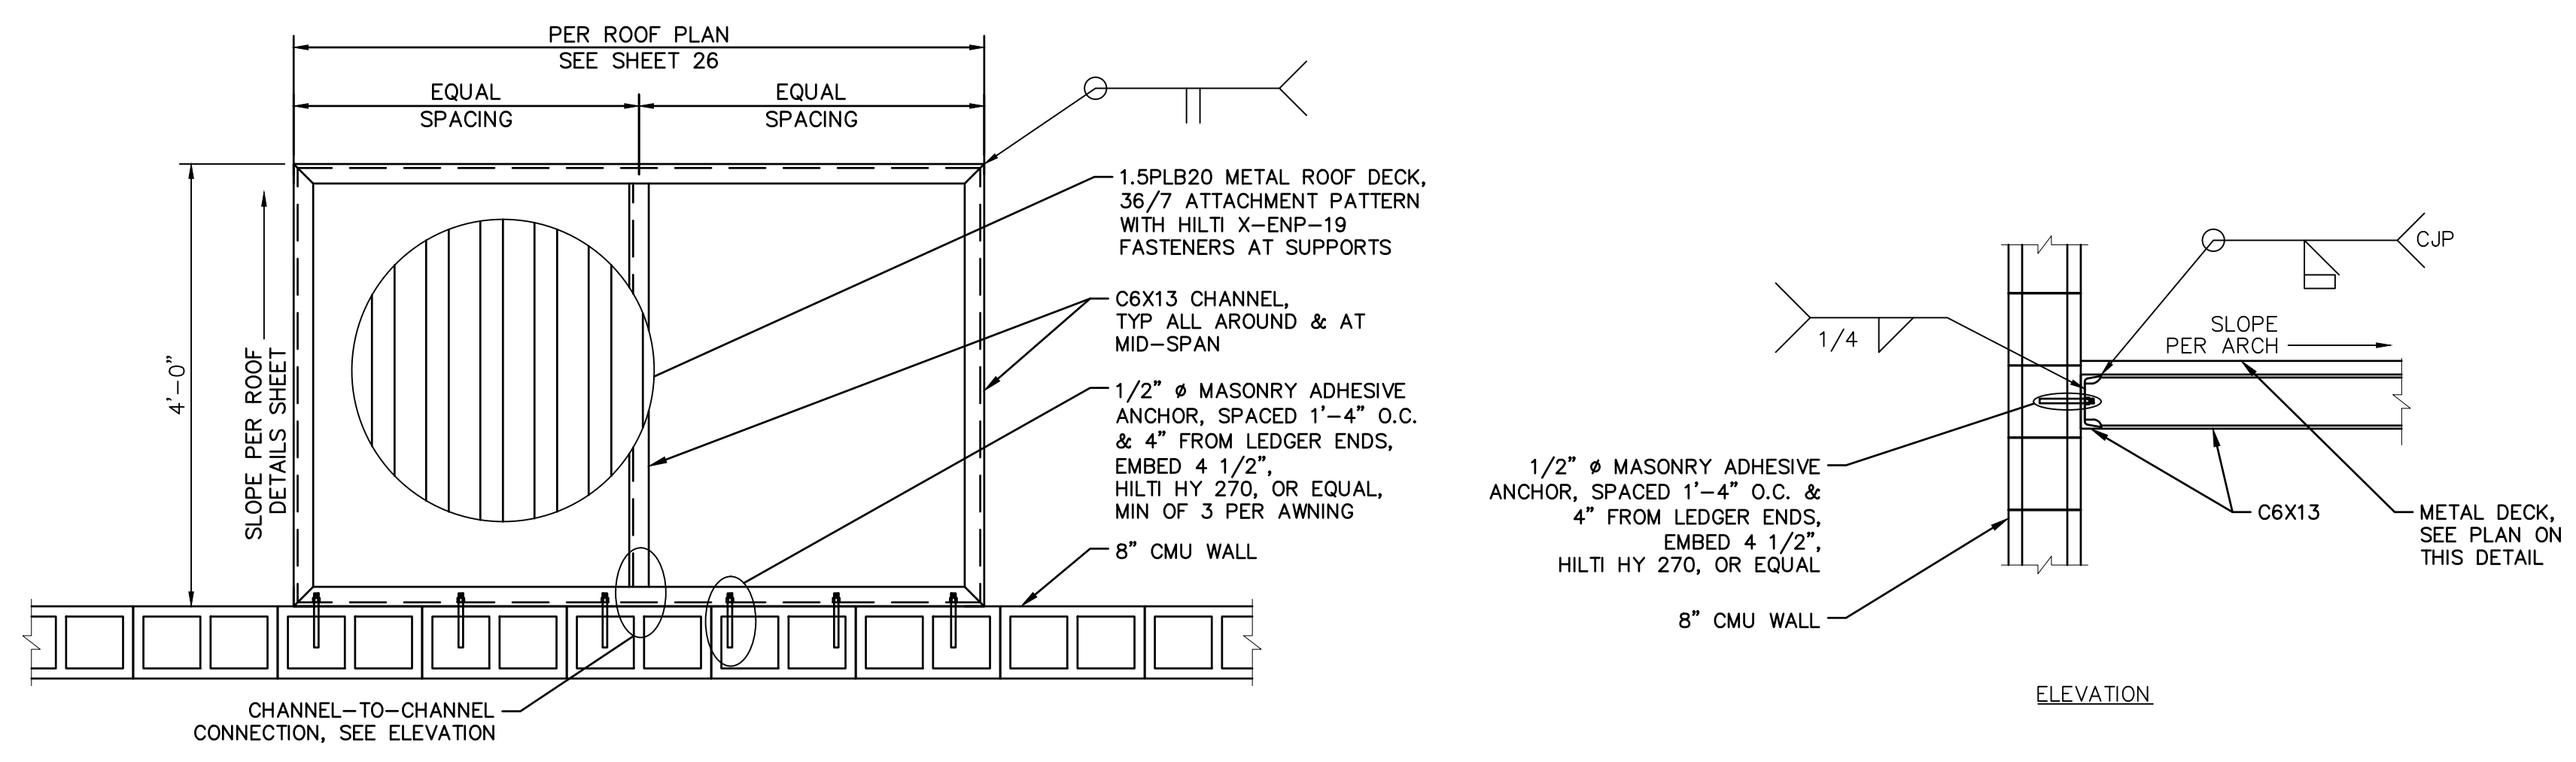

3 STEEL AWNING AT DOORS
 SCALE: 3/4" = 1'-0"

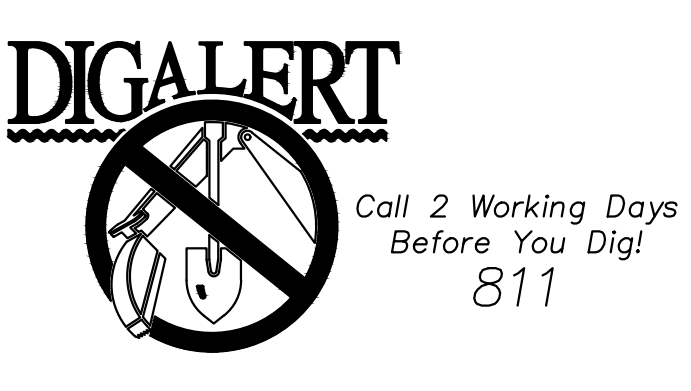


BENCHMARK:
 NATIONAL GEODETIC SURVEY BENCHMARK NO. 1311
 1.4 MILES WEST OF BEAUMONT ON INTERSTATE 10 TO SAN TIMOTEO CANYON NEAR FRONTAGE ROAD ON SOUTH (WEST) SIDE OF INTERSTATE 10, 0.1 MILES SOUTHWEST ALONG FRONTAGE ROAD, SOUTH ACROSS THE ROAD FROM A GUY POLE 25.9 FEET SOUTH OF THE CENTERLINE OF FRONTAGE ROAD, 1.8 FEET WEST OF POWERPOLE AND 1.8 FEET EAST OF A WITNESS POST, INSIDE A 4 INCH PVC PIPE WITH SCREW PLUG 1 INCH ABOVE GROUND (ELEVATION = 2468.07). ALSO SHOWN ON HIGHWAY 69 / POTRERO BLVD. INTERCHANGE STATIC GPS PROJECT CONTROL DIAGRAM AND IDENTIFIED THEREON AS 3558 BM D3474 WHEN THE PUBLISHED ELEVATION = 2468.07 IS CORRECTED WITH A MEASURED ELEVATION = 2468.01, USED HEREON.
 ELEV. 2468.01, (NVD '88), (STAMPED Q 1311 1978)

BY	MARK	DESCRIPTION	APPR.	DATE
ENGINEER		REVISIONS		CITY

Kimley»Horn
 401 B Street, Suite 600, San Diego, CA 92101
 Phone: (619) 234-9411
 WWW.KIMLEY-HORN.COM

JUSTIN L. BRUE
 P.E., C.E. 87614
 8/23/2021

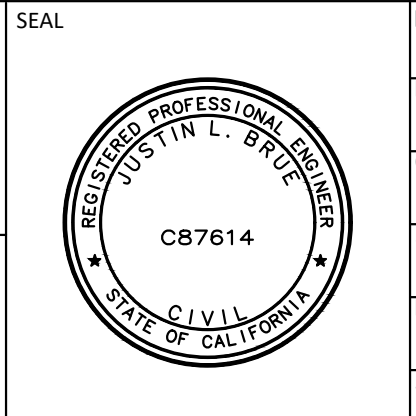

DESIGN BY: SLM
 DRAWN BY: RC/SW
 CHECKED BY: TW/SS
 SCALE: _____
 DATE: _____
 JOB NUMBER: 195284001


Reviewed By: _____ Date: _____
 Recommended for Approval By: _____ Date: 11/19/2021
 Approved By: _____ Date: 11/23/2021
 City Engineer/Director of Public Works

CITY OF BEAUMONT, CALIFORNIA
 IMPROVEMENT PLANS FOR:
BEAUMONT CROSSROADS LIFT STATION
 STRUCTURAL DETAILS I


SHEET
31
 OF 38 SHEETS
 FILE NO.: 3387

CITY OF BEAUMONT, PUBLIC WORKS DEPARTMENT
 ENGINEERING DIVISION
 550E 6th St
 Beaumont, CA 92223
 TEL: (951) 769-8520 FAX: (951) 769-8526

Plotted By: J. VanHise, Sam Sheet Set: BEAUMONT LIFT STATION - STRUCTURAL DETAILS II, October 20, 2021, 10:49:17am K:\ISND_WATER\195284001\Beaumont Lift Station\Design\Plan Sheets - 2020\DELTA SET\195284001 - AST.dwg

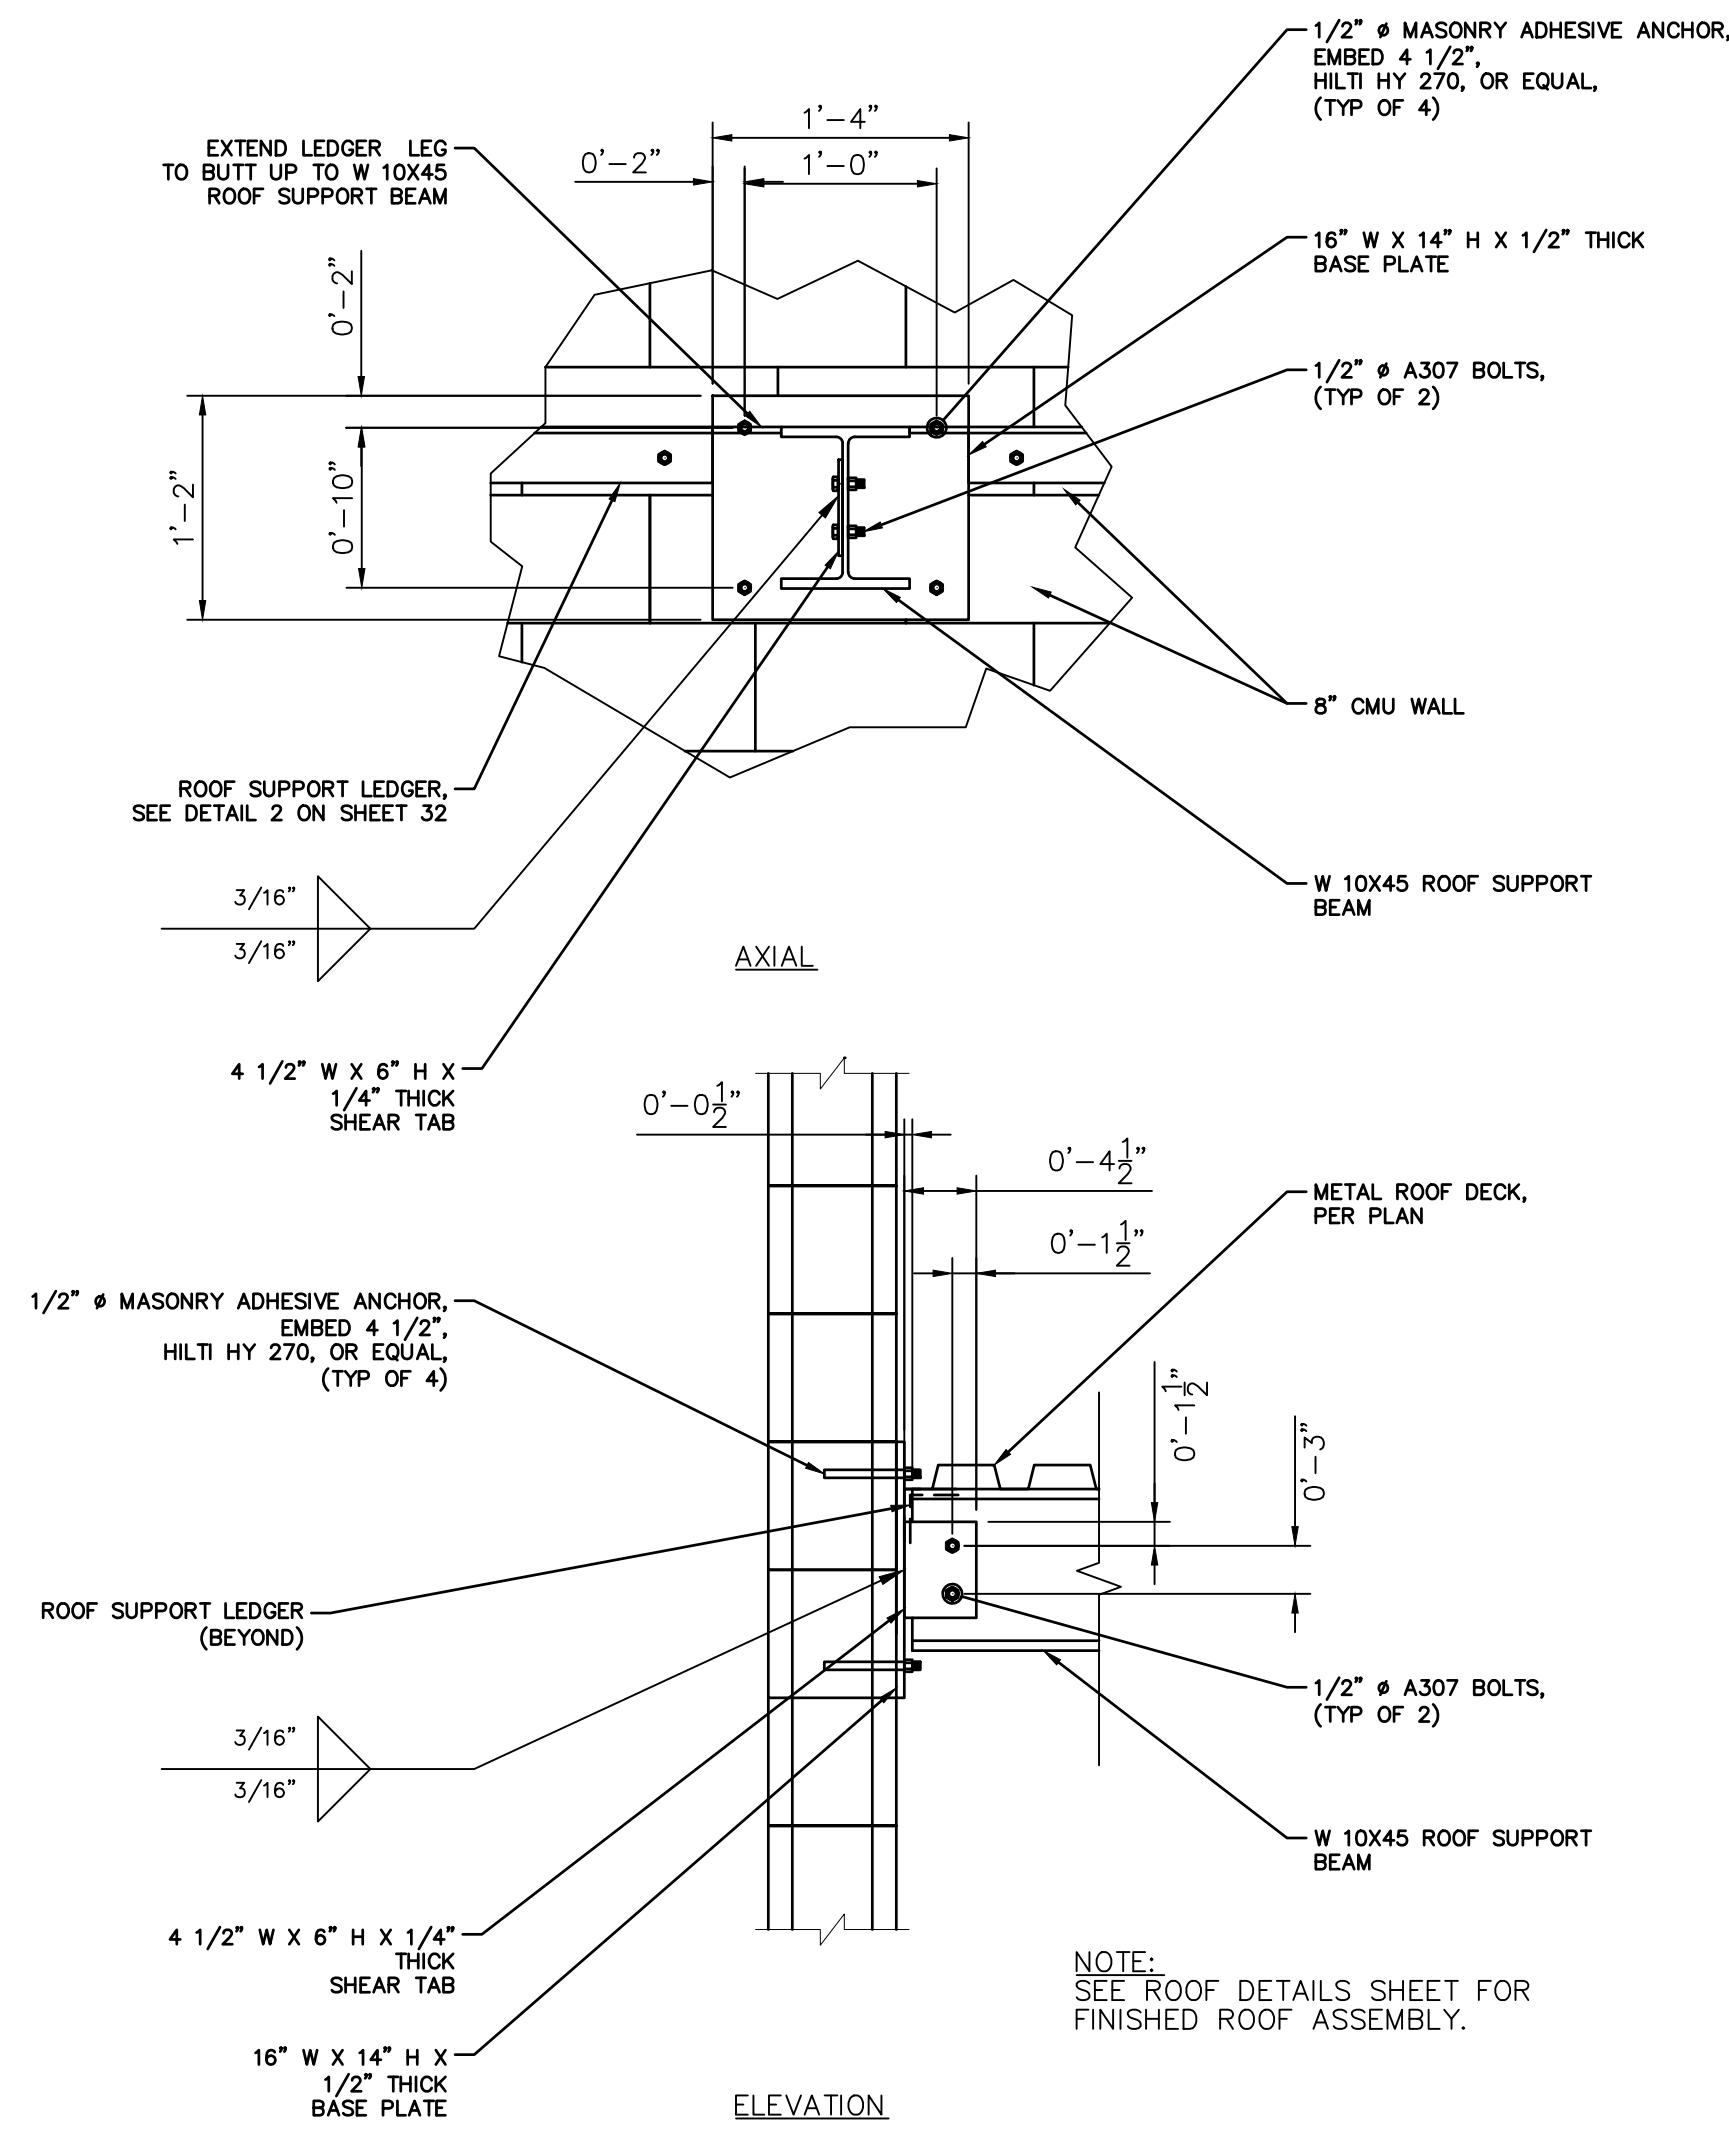

1
32 BEAM CONNECTION DETAIL
SCALE: 3/4" = 1'-0"

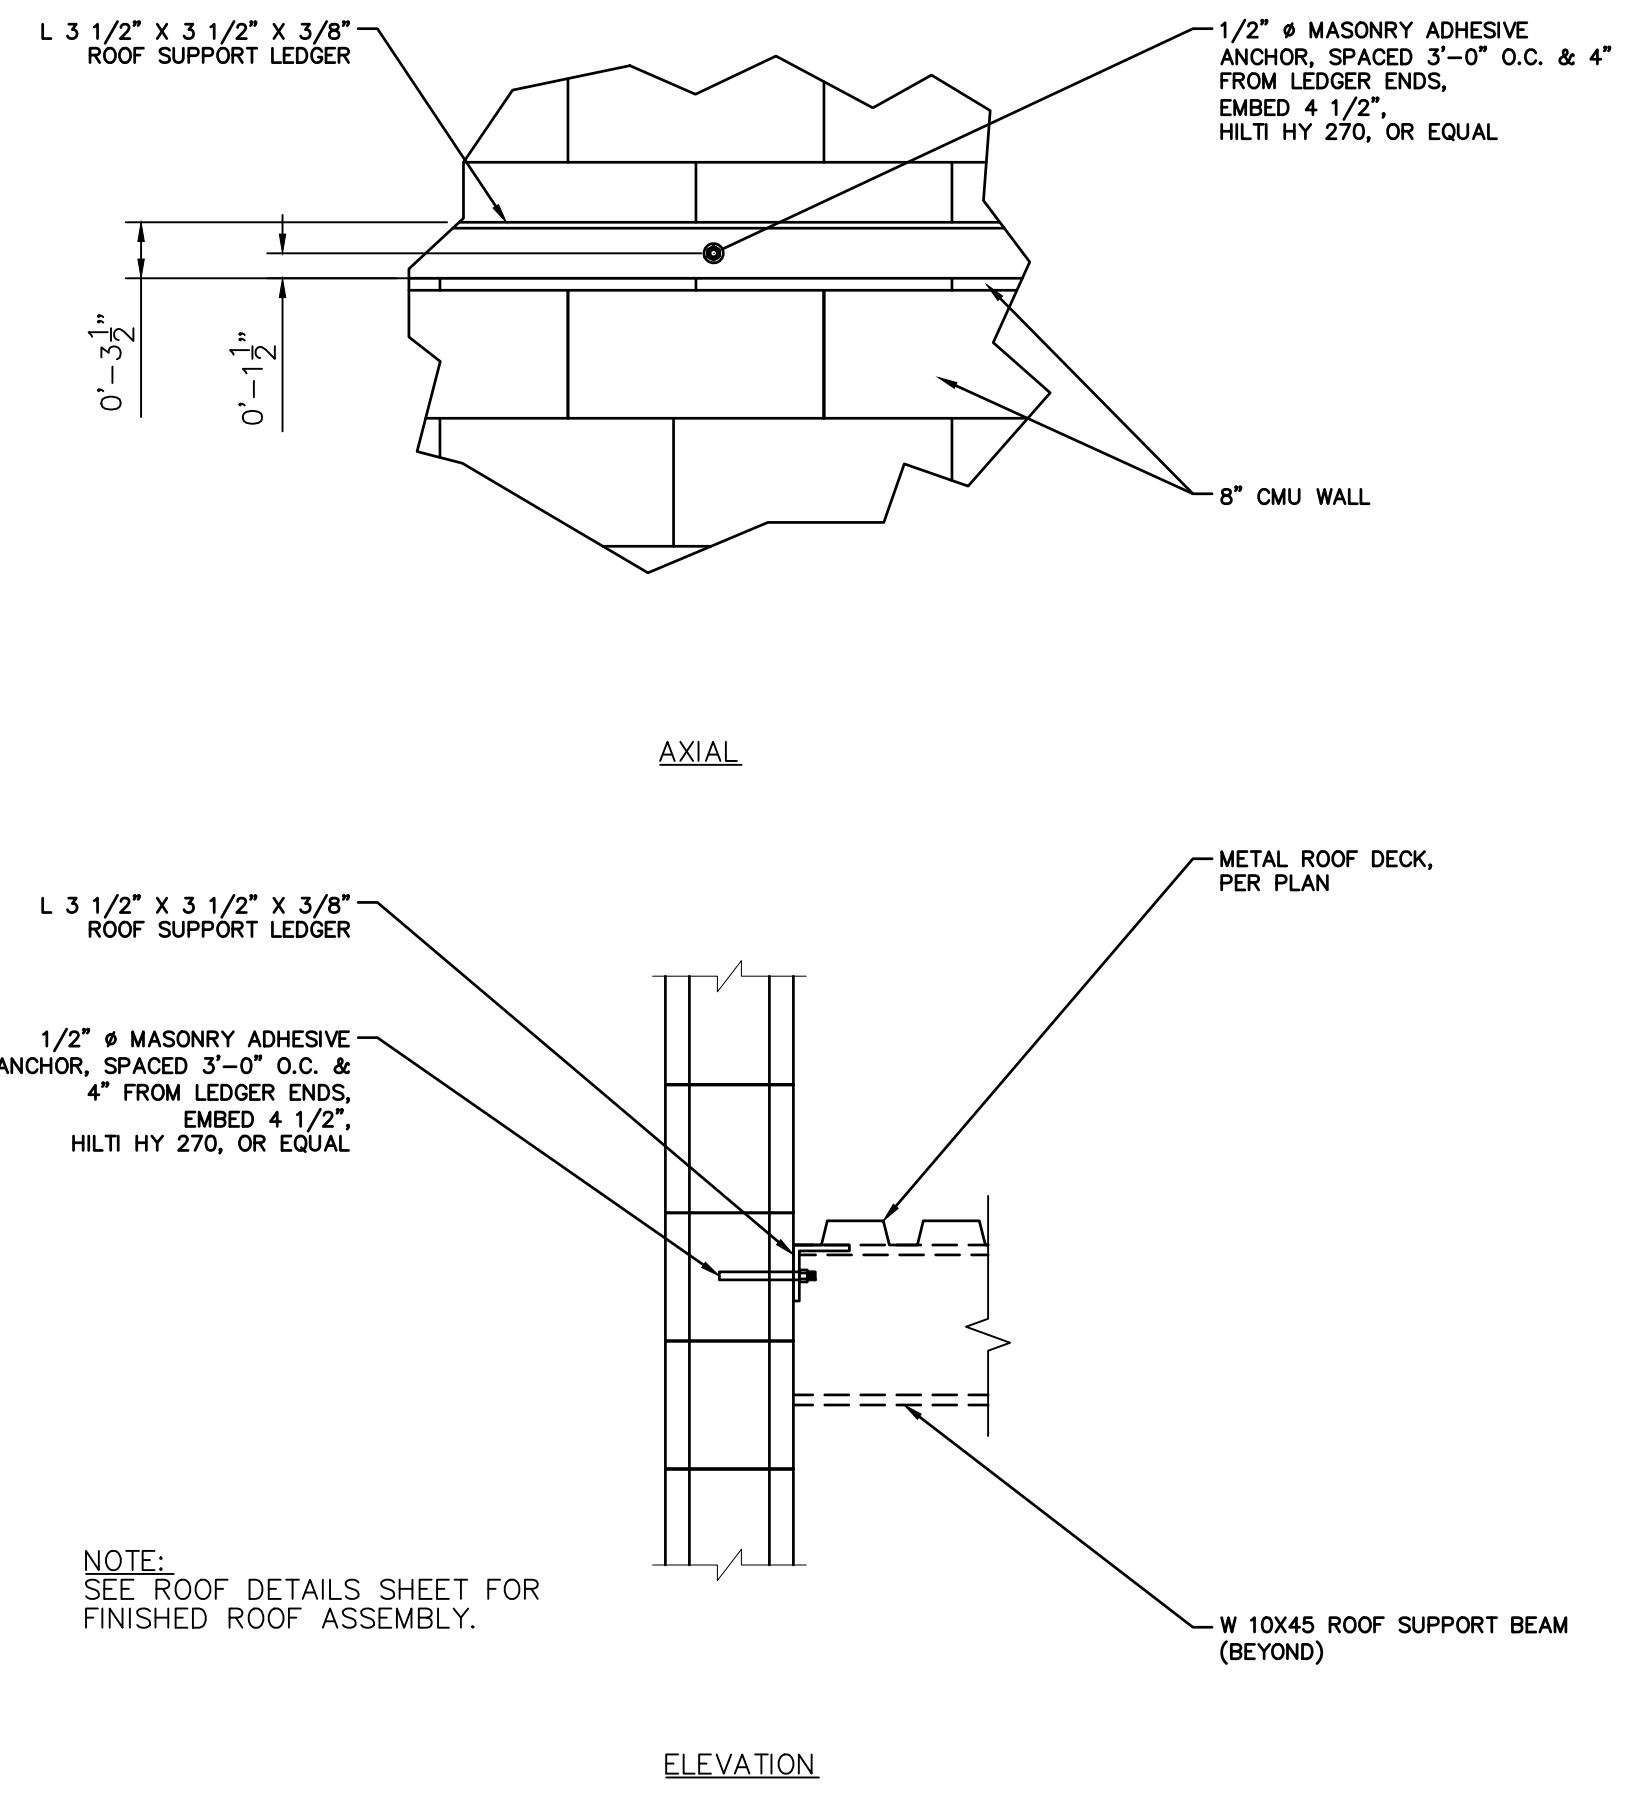

2
32 LEDGER CONNECTION DETAIL
SCALE: 3/4" = 1'-0"

BENCHMARK:
NATIONAL GEODETIC SURVEY BENCHMARK NO. Q 1311
1.4 MILES WEST OF BEAUMONT ON INTERSTATE 10 TO SAN TIMOTEY CANYON NEAR FRONTAGE ROAD ON SOUTH (WEST) SIDE OF INTERSTATE 10, 0.1 MILES SOUTHEAST ALONG FRONTAGE ROAD, SOUTH ACROSS THE ROAD FROM A GUY POLE 25.9 FEET SOUTH OF THE CENTERLINE OF FRONTAGE ROAD, 1.6 FEET WEST OF POWERPOLE AND 1.6 FEET EAST OF A WITNESS POST, INSIDE A 4 INCH PVC PIPE WITH SCREW PLUG 1 INCH ABOVE GROUND (ELEVATION = 2468.07). ALSO SHOWN ON HIGHWAY 60 // POTRERO BLVD. INTERCHANGE STATIC GPS PROJECT CONTROL DIAGRAM AND IDENTIFIED THEREON AS 3558 BM D03474 WHEN THE PUBLISHED ELEVATION = 2468.07 IS CORRECTED WITH A MEASURED ELEVATION = 2468.01, USED HEREON.
ELEV. 2468.01, (NVD '88), (STAMPED Q 1311 1978)

BY	MARK	DESCRIPTION	APPR.	DATE
ENGINEER		REVISIONS		CITY

Kimley»Horn
401 B Street, Suite 600, San Diego, CA 92101
Phone: (619) 234-9411
WWW.KIMLEY-HORN.COM

J. Brue
JUSTIN L. BRUE
P.C.E. 87614
8/23/2021



DESIGN BY: SLM
DRAWN BY: RC/SW
CHECKED BY: TW/SS
SCALE:
DATE:
JOB NUMBER: 195284001



Reviewed By: _____ Date: _____
Staff Engineer

Recommended for Approval By: *P. Harts* Date: 11/19/2021
Administrative Engineer


Approved By: *John D. Harts* Date: 11/23/2021
City Engineer/Director of Public Works

CITY OF BEAUMONT, PUBLIC WORKS DEPARTMENT
ENGINEERING DIVISION
550E 6th St, Beaumont, CA 92223
TEL: (951) 769-8520 FAX: (951) 769-8526

CITY OF BEAUMONT, CALIFORNIA
IMPROVEMENT PLANS FOR:
BEAUMONT CROSSROADS
LIFT STATION
STRUCTURAL DETAILS II



SHEET
32
OF 38 SHEETS
FILE NO.: 3387

Plotted By: v:\mwh\lwr_sam Sheet Set: BEAUMONT LIFT STATION - WET WELL SLAB October 20, 2021 10:49:21am K:\USD_WATERS\195284001 Beaumont Lift Station\Design\Plan Sheets - 2020\DELTA SET\195284001 - xst.dwg

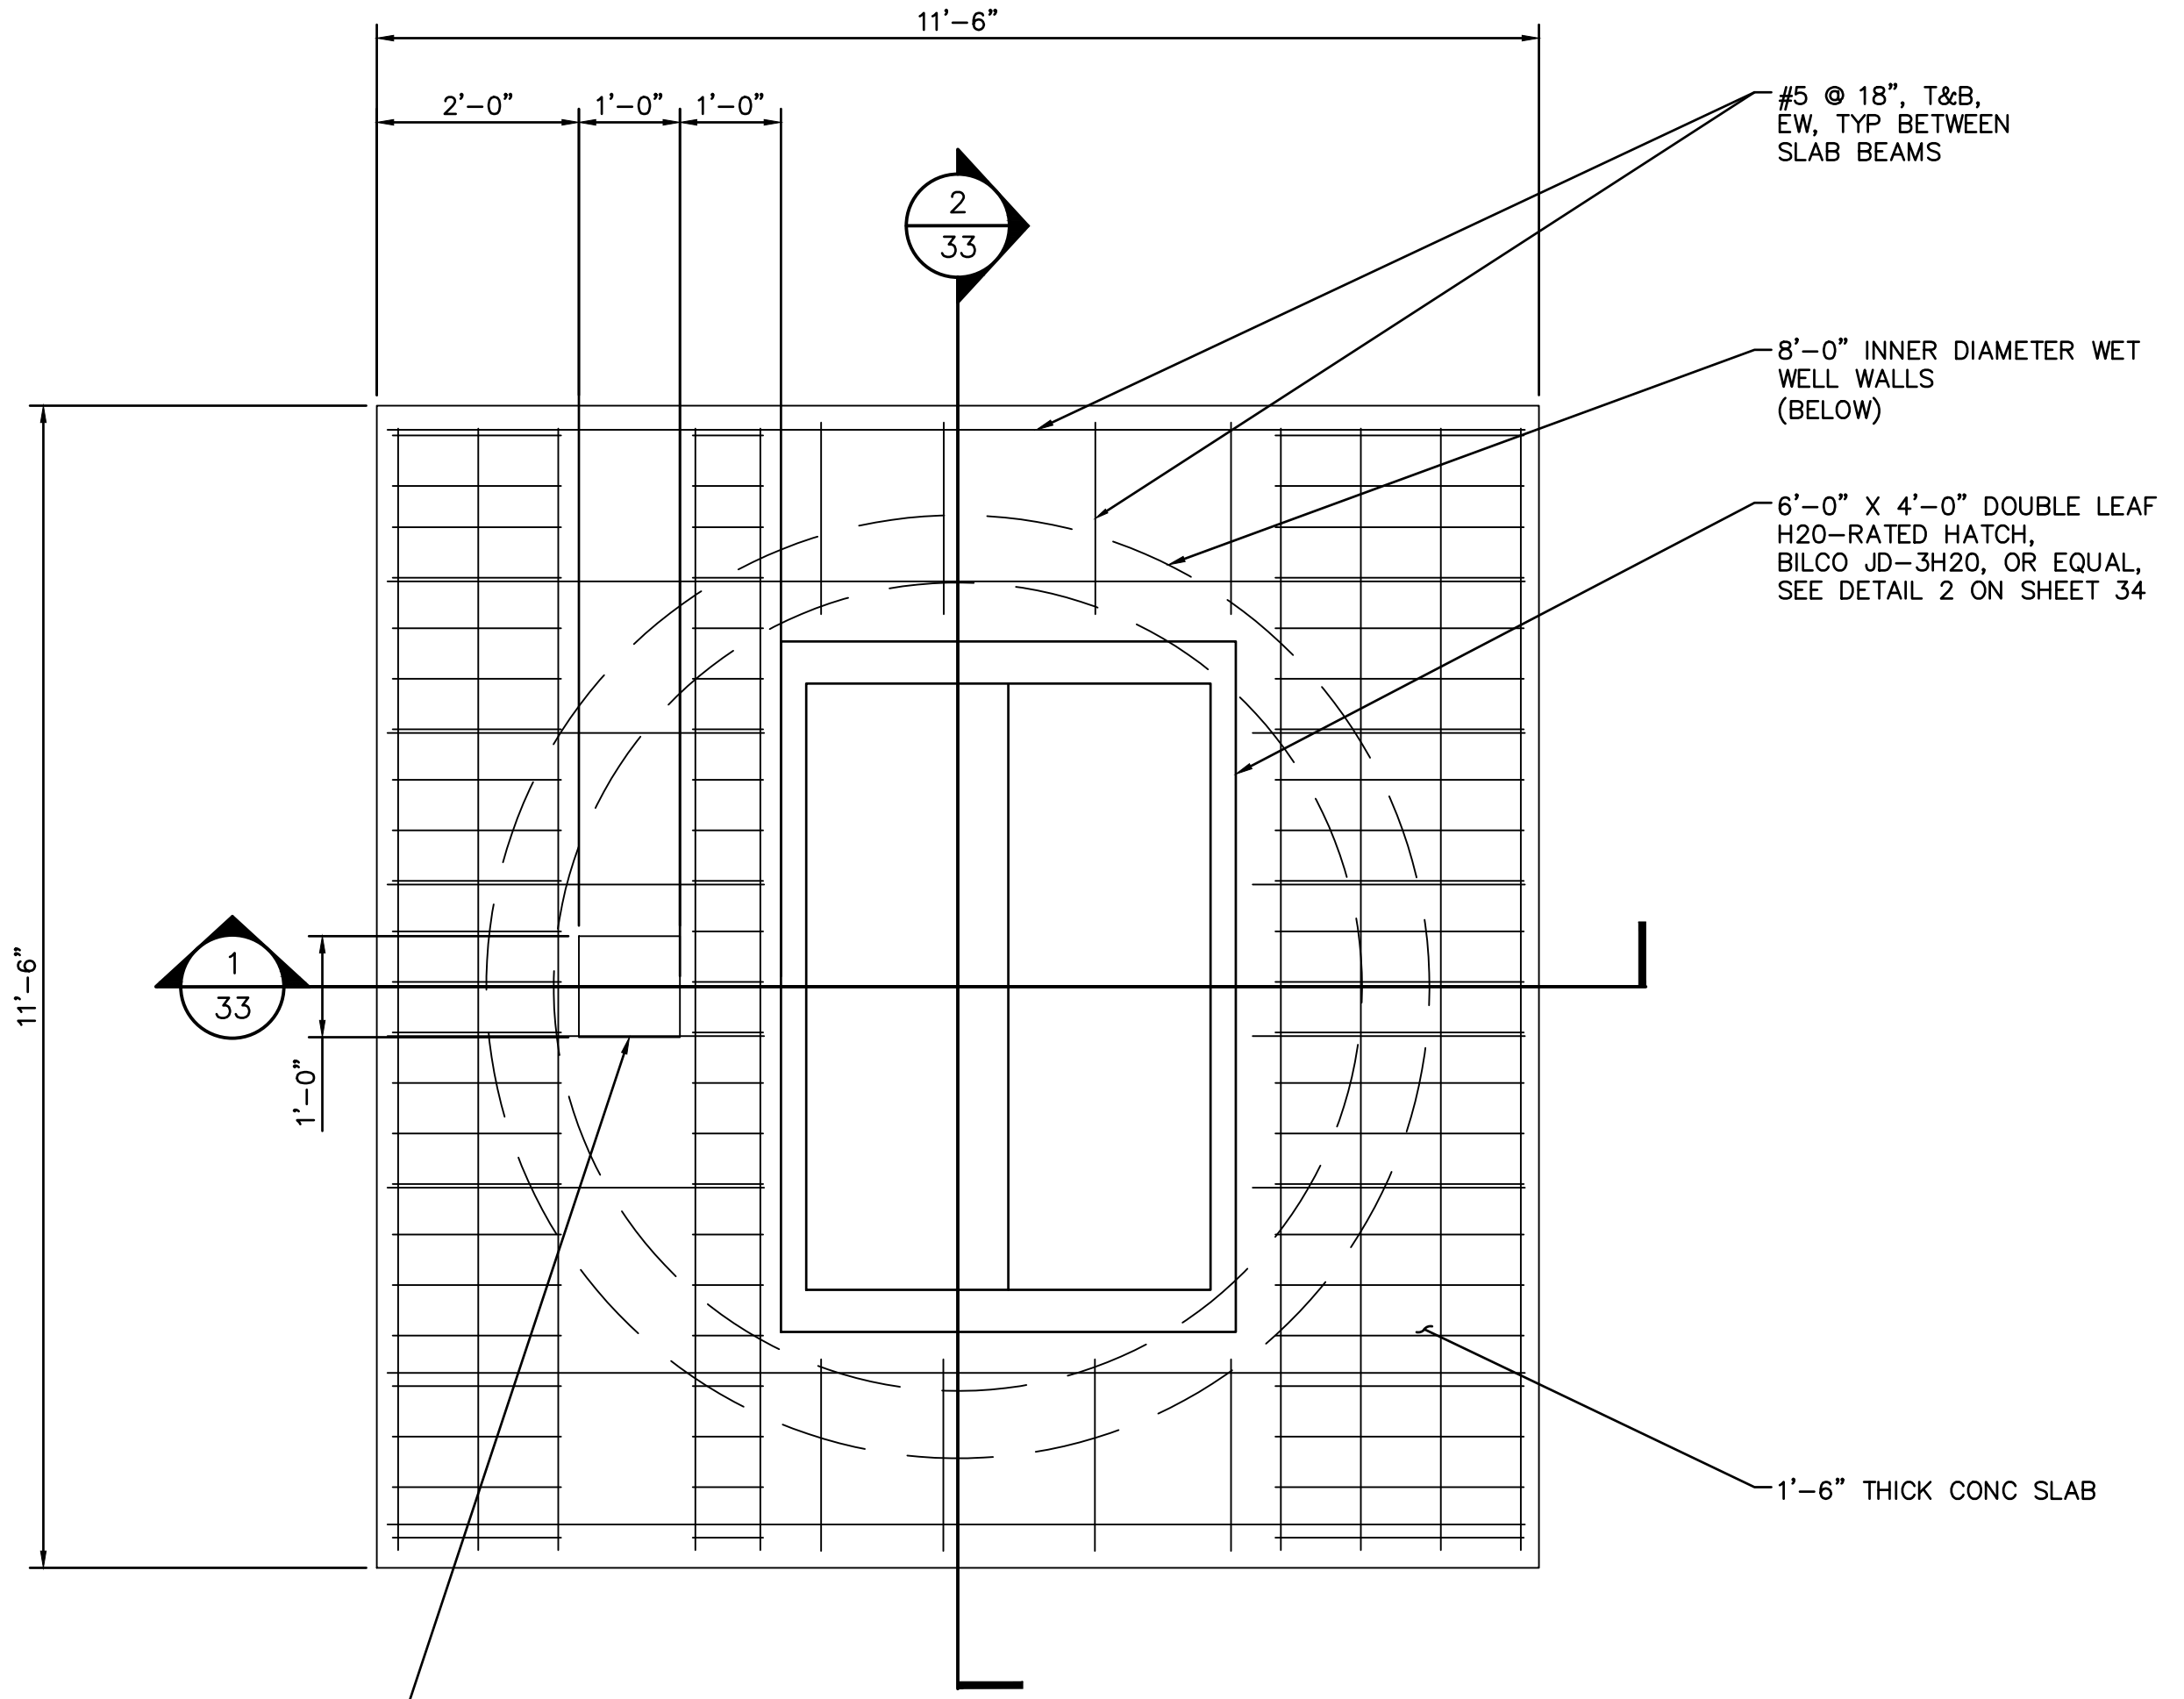


WET WELL ROOF SLAB

SCALE: 1" = 20'

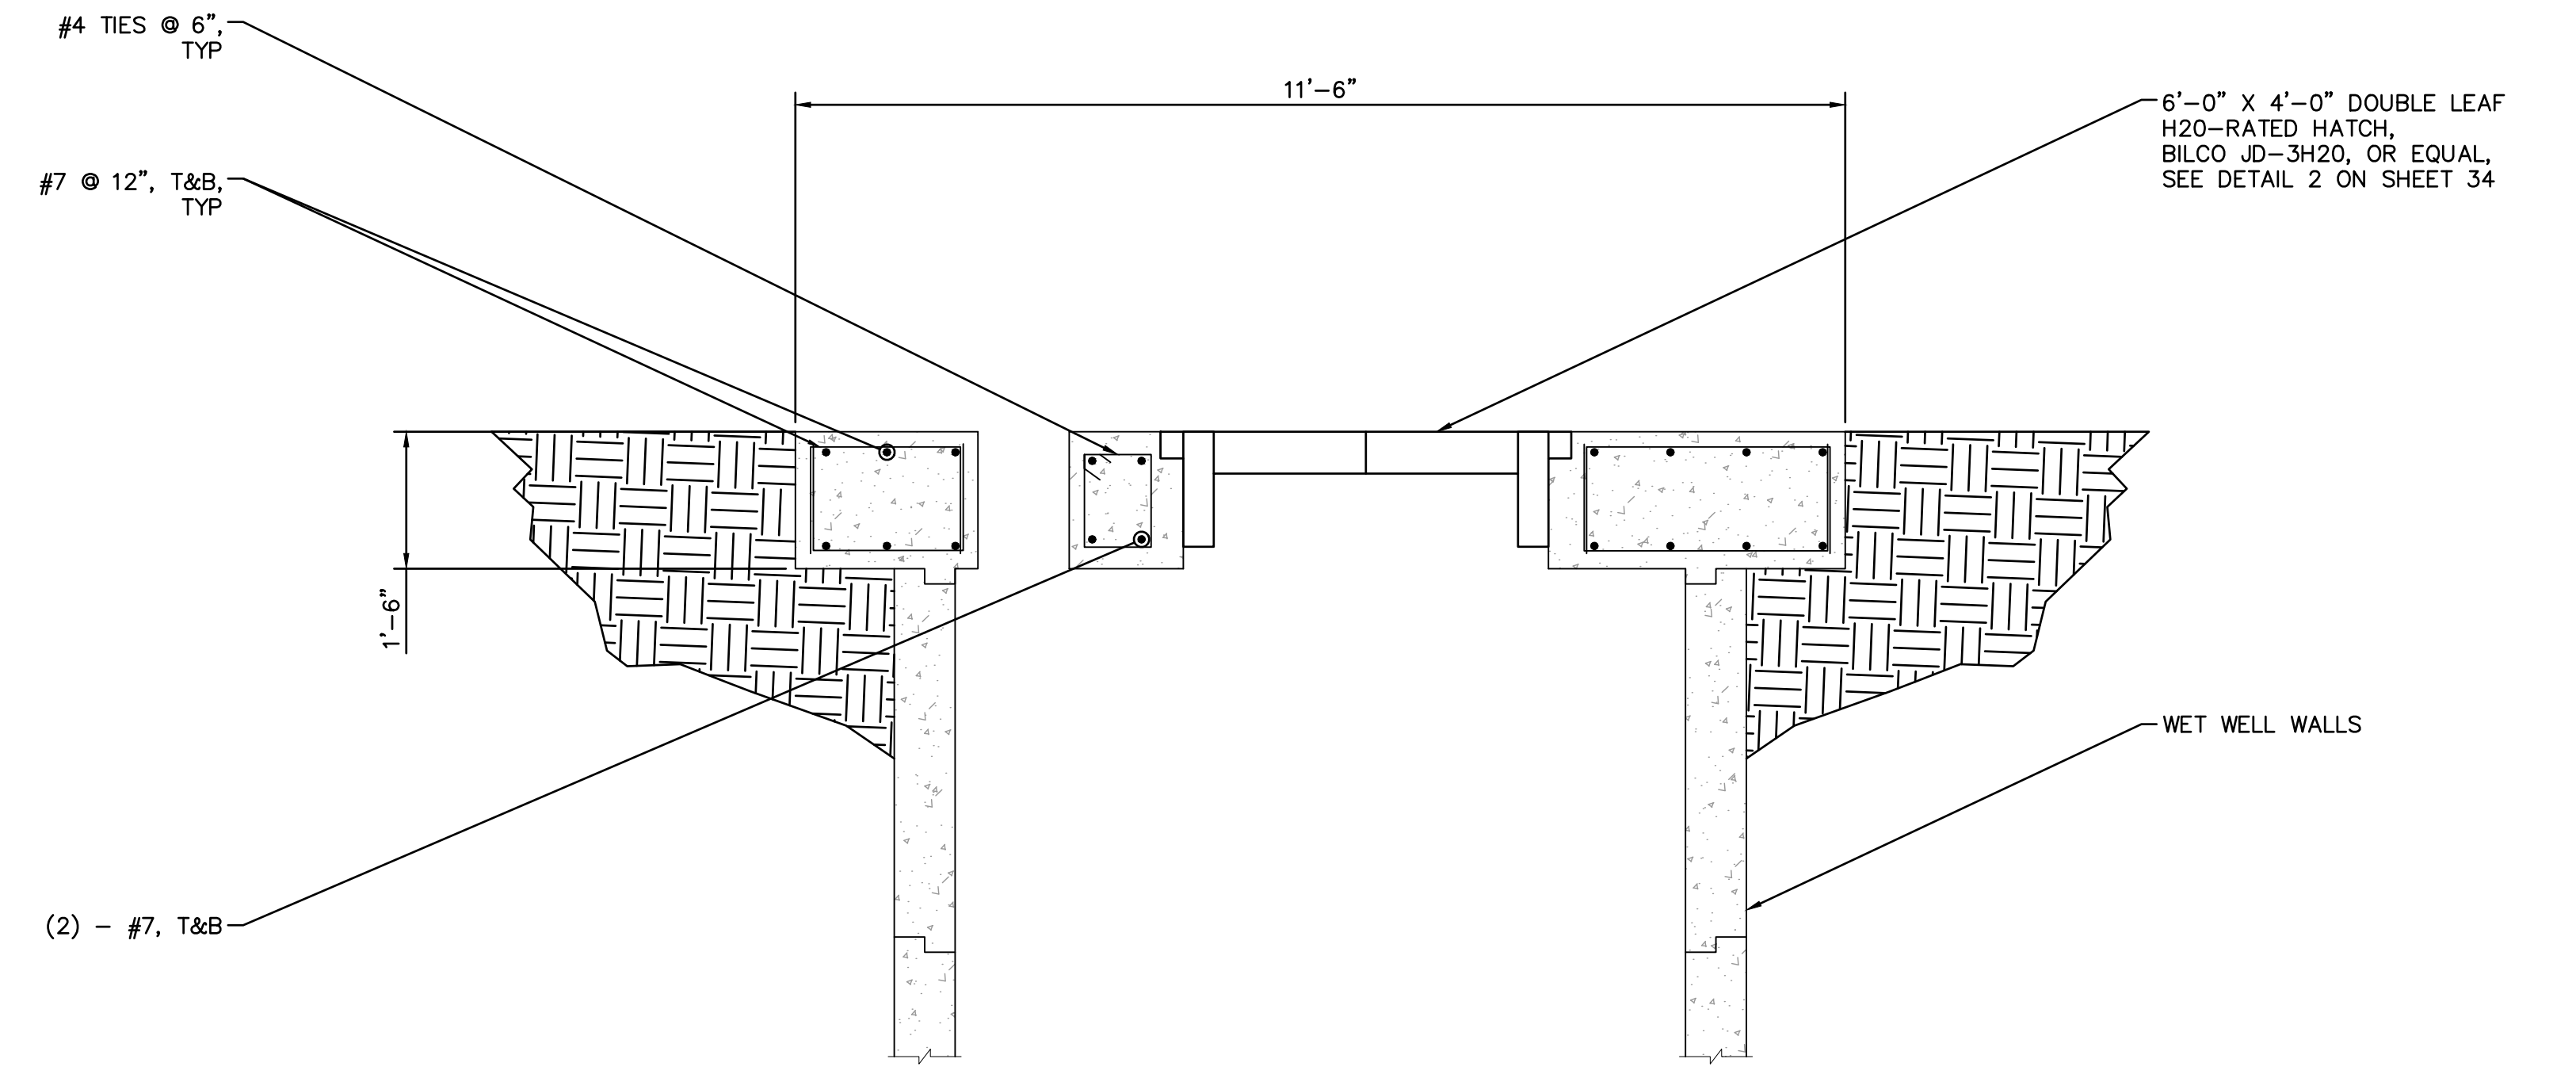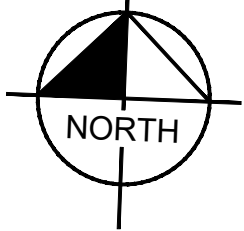

1 WET WELL ROOF SLAB SECTION
SCALE: 1" = 20'

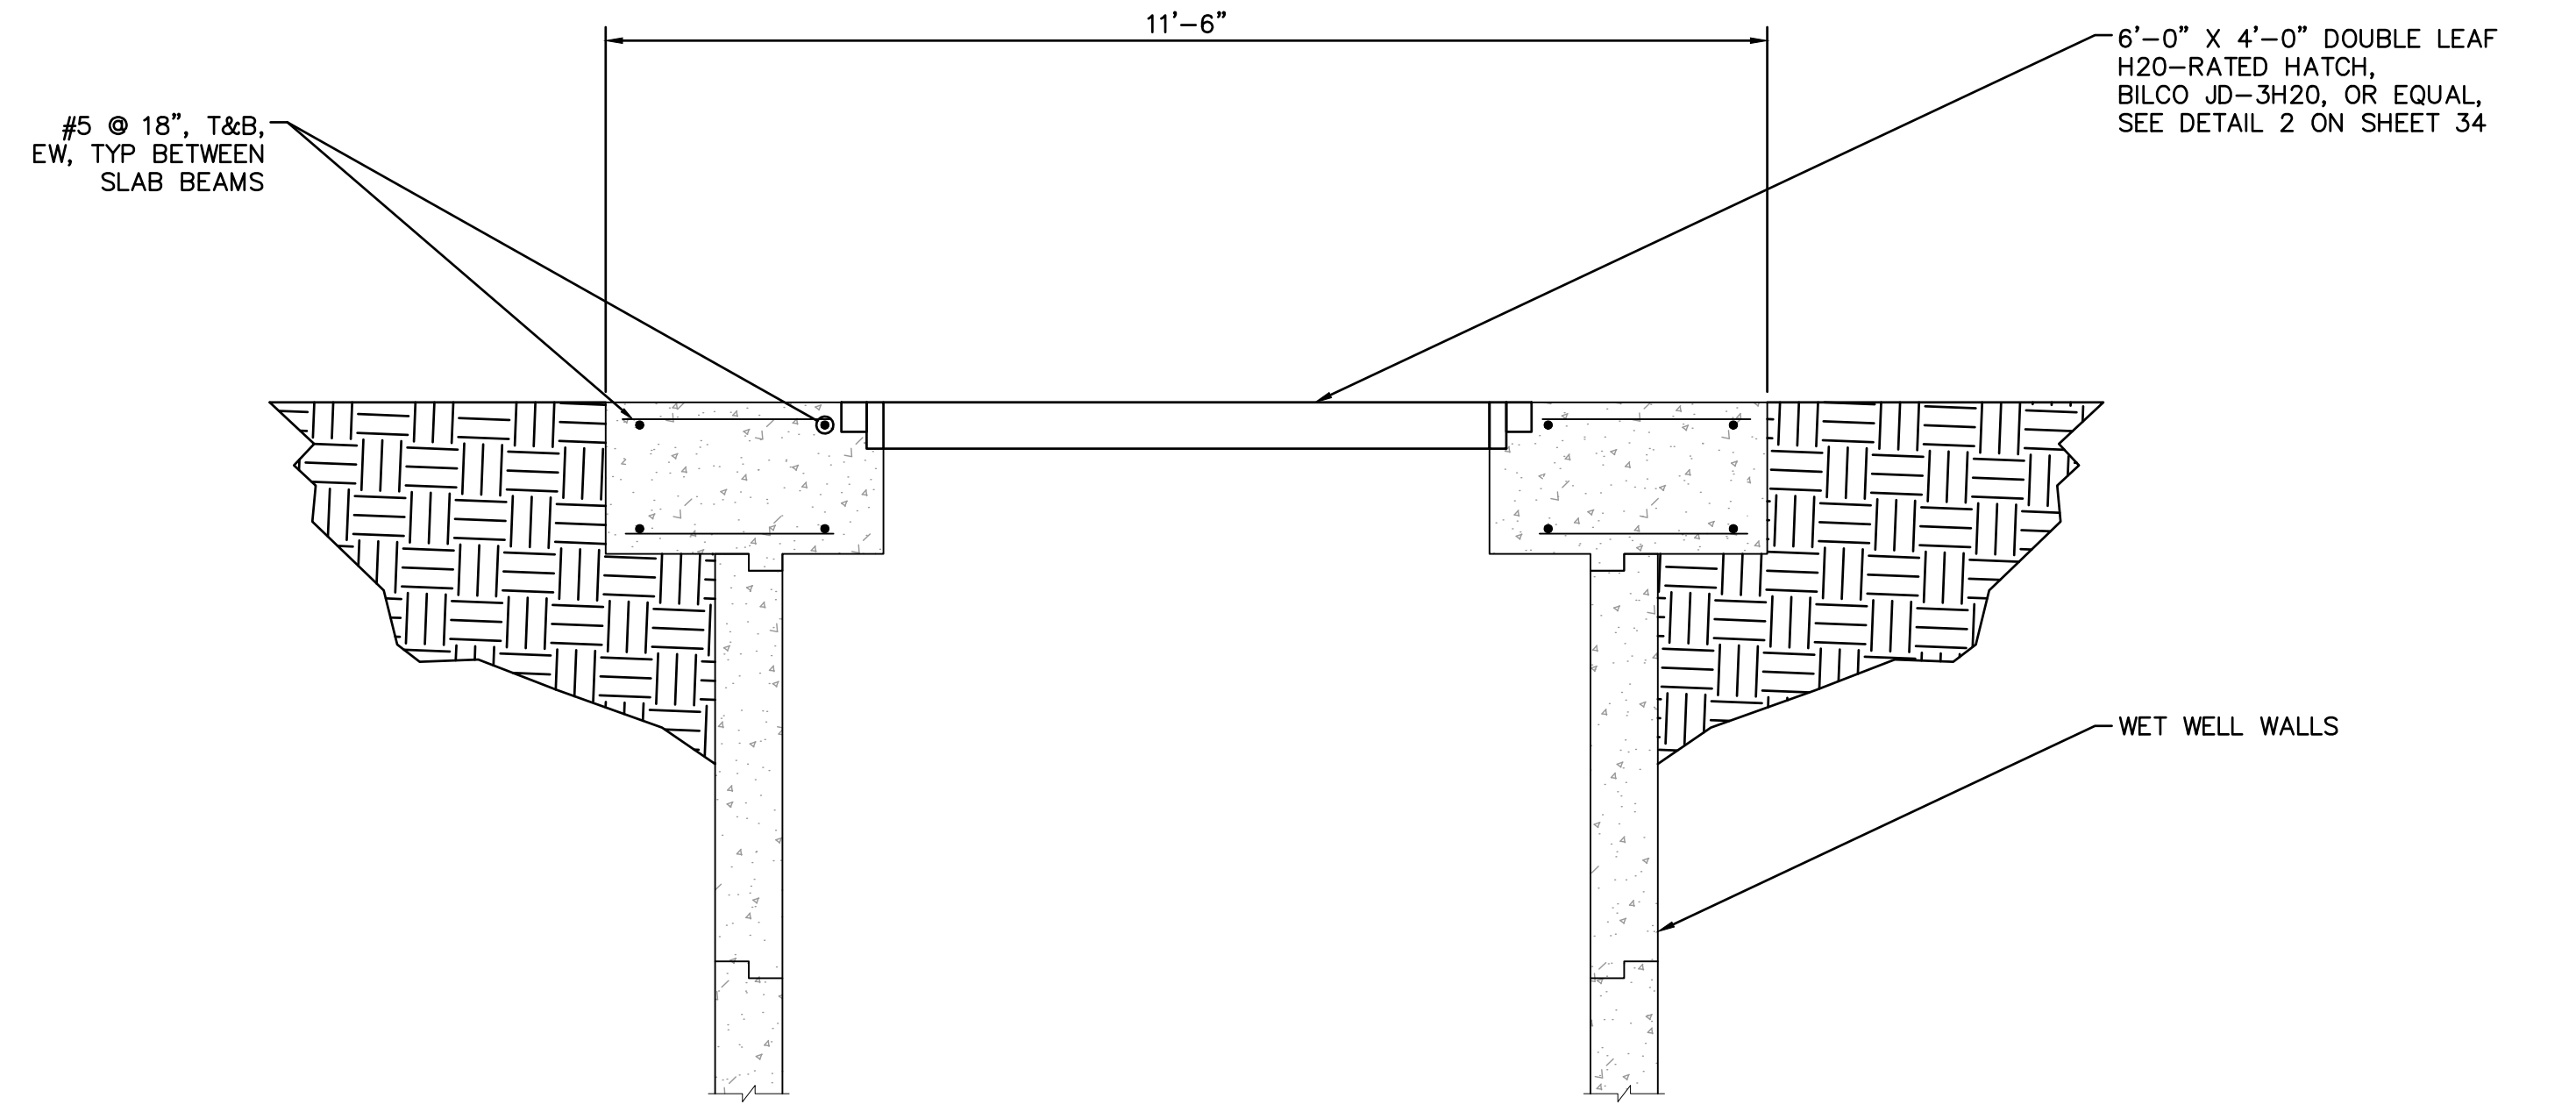

2 WET WELL ROOF SLAB SECTION
SCALE: 1" = 20'




BENCHMARK:
NATIONAL GEODETIC SURVEY BENCHMARK NO. Q 1311
1.4 MILES WEST OF BEAUMONT ON INTERSTATE 10 TO SAN TIMOTEO CANYON NEAR FRONTAGE ROAD ON SOUTH(WEST) SIDE OF INTERSTATE 10, 0.1 MILES SOUTHEAST ALONG FRONTAGE ROAD, SOUTH ACROSS THE ROAD FROM A GUY POLE 25.9 FEET SOUTH OF THE CENTERLINE OF FRONTAGE ROAD, 1.8 FEET WEST OF POWERPOLE AND 1.8 FEET EAST OF A WITNESS POST, INSIDE A 4 INCH PVC PIPE WITH SCREW PLUG 1 INCH ABOVE GROUND (ELEVATION = 2468.07). ALSO SHOWN ON HIGHWAY 69 / POTRERO BLVD. INTERCHANGE STATIC GPS PROJECT CONTROL DIAGRAM AND IDENTIFIED THEREON AS 3538 BM D3474 WHEN THE PUBLISHED ELEVATION = 2468.07 IS CORRECTED WITH A MEASURED ELEVATION = 2468.01, USED HEREON.
ELEV. 2468.01, (NVD '88), (STAMPED Q 1311 1978)

BY	MARK	DESCRIPTION	APPR.	DATE
ENGINEER		REVISIONS		CITY

Kimley»Horn
401 B Street, Suite 600, San Diego, CA 92101
Phone: (619) 234-9411
WWW.KIMLEY-HORN.COM

Justin L. Brue
JUSTIN L. BRUE
P.C.E. 87614 8/23/2021

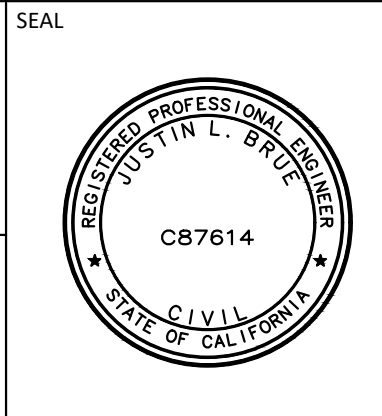

DESIGN BY: SLM
DRAWN BY: RC/SW
CHECKED BY: TW/SS
SCALE: [blank]
DATE: [blank]
JOB NUMBER: 195284001




Reviewed By: _____ Date: _____
Staff Engineer
Recommended for Approval By: *[Signature]* Date: 11/19/2021
Administrative Engineer
Approved By: *[Signature]* Date: 11/23/2021
City Engineer/Director of Public Works

CITY OF BEAUMONT, PUBLIC WORKS DEPARTMENT
ENGINEERING DIVISION
550E 6th St
Beaumont, CA 92223
TEL: (951) 769-8520 FAX: (951) 769-8528

CITY OF BEAUMONT, CALIFORNIA
IMPROVEMENT PLANS FOR:
**BEAUMONT CROSSROADS
LIFT STATION**
WET WELL SLAB


SHEET
33
OF 38 SHEETS
FILE NO:
3387

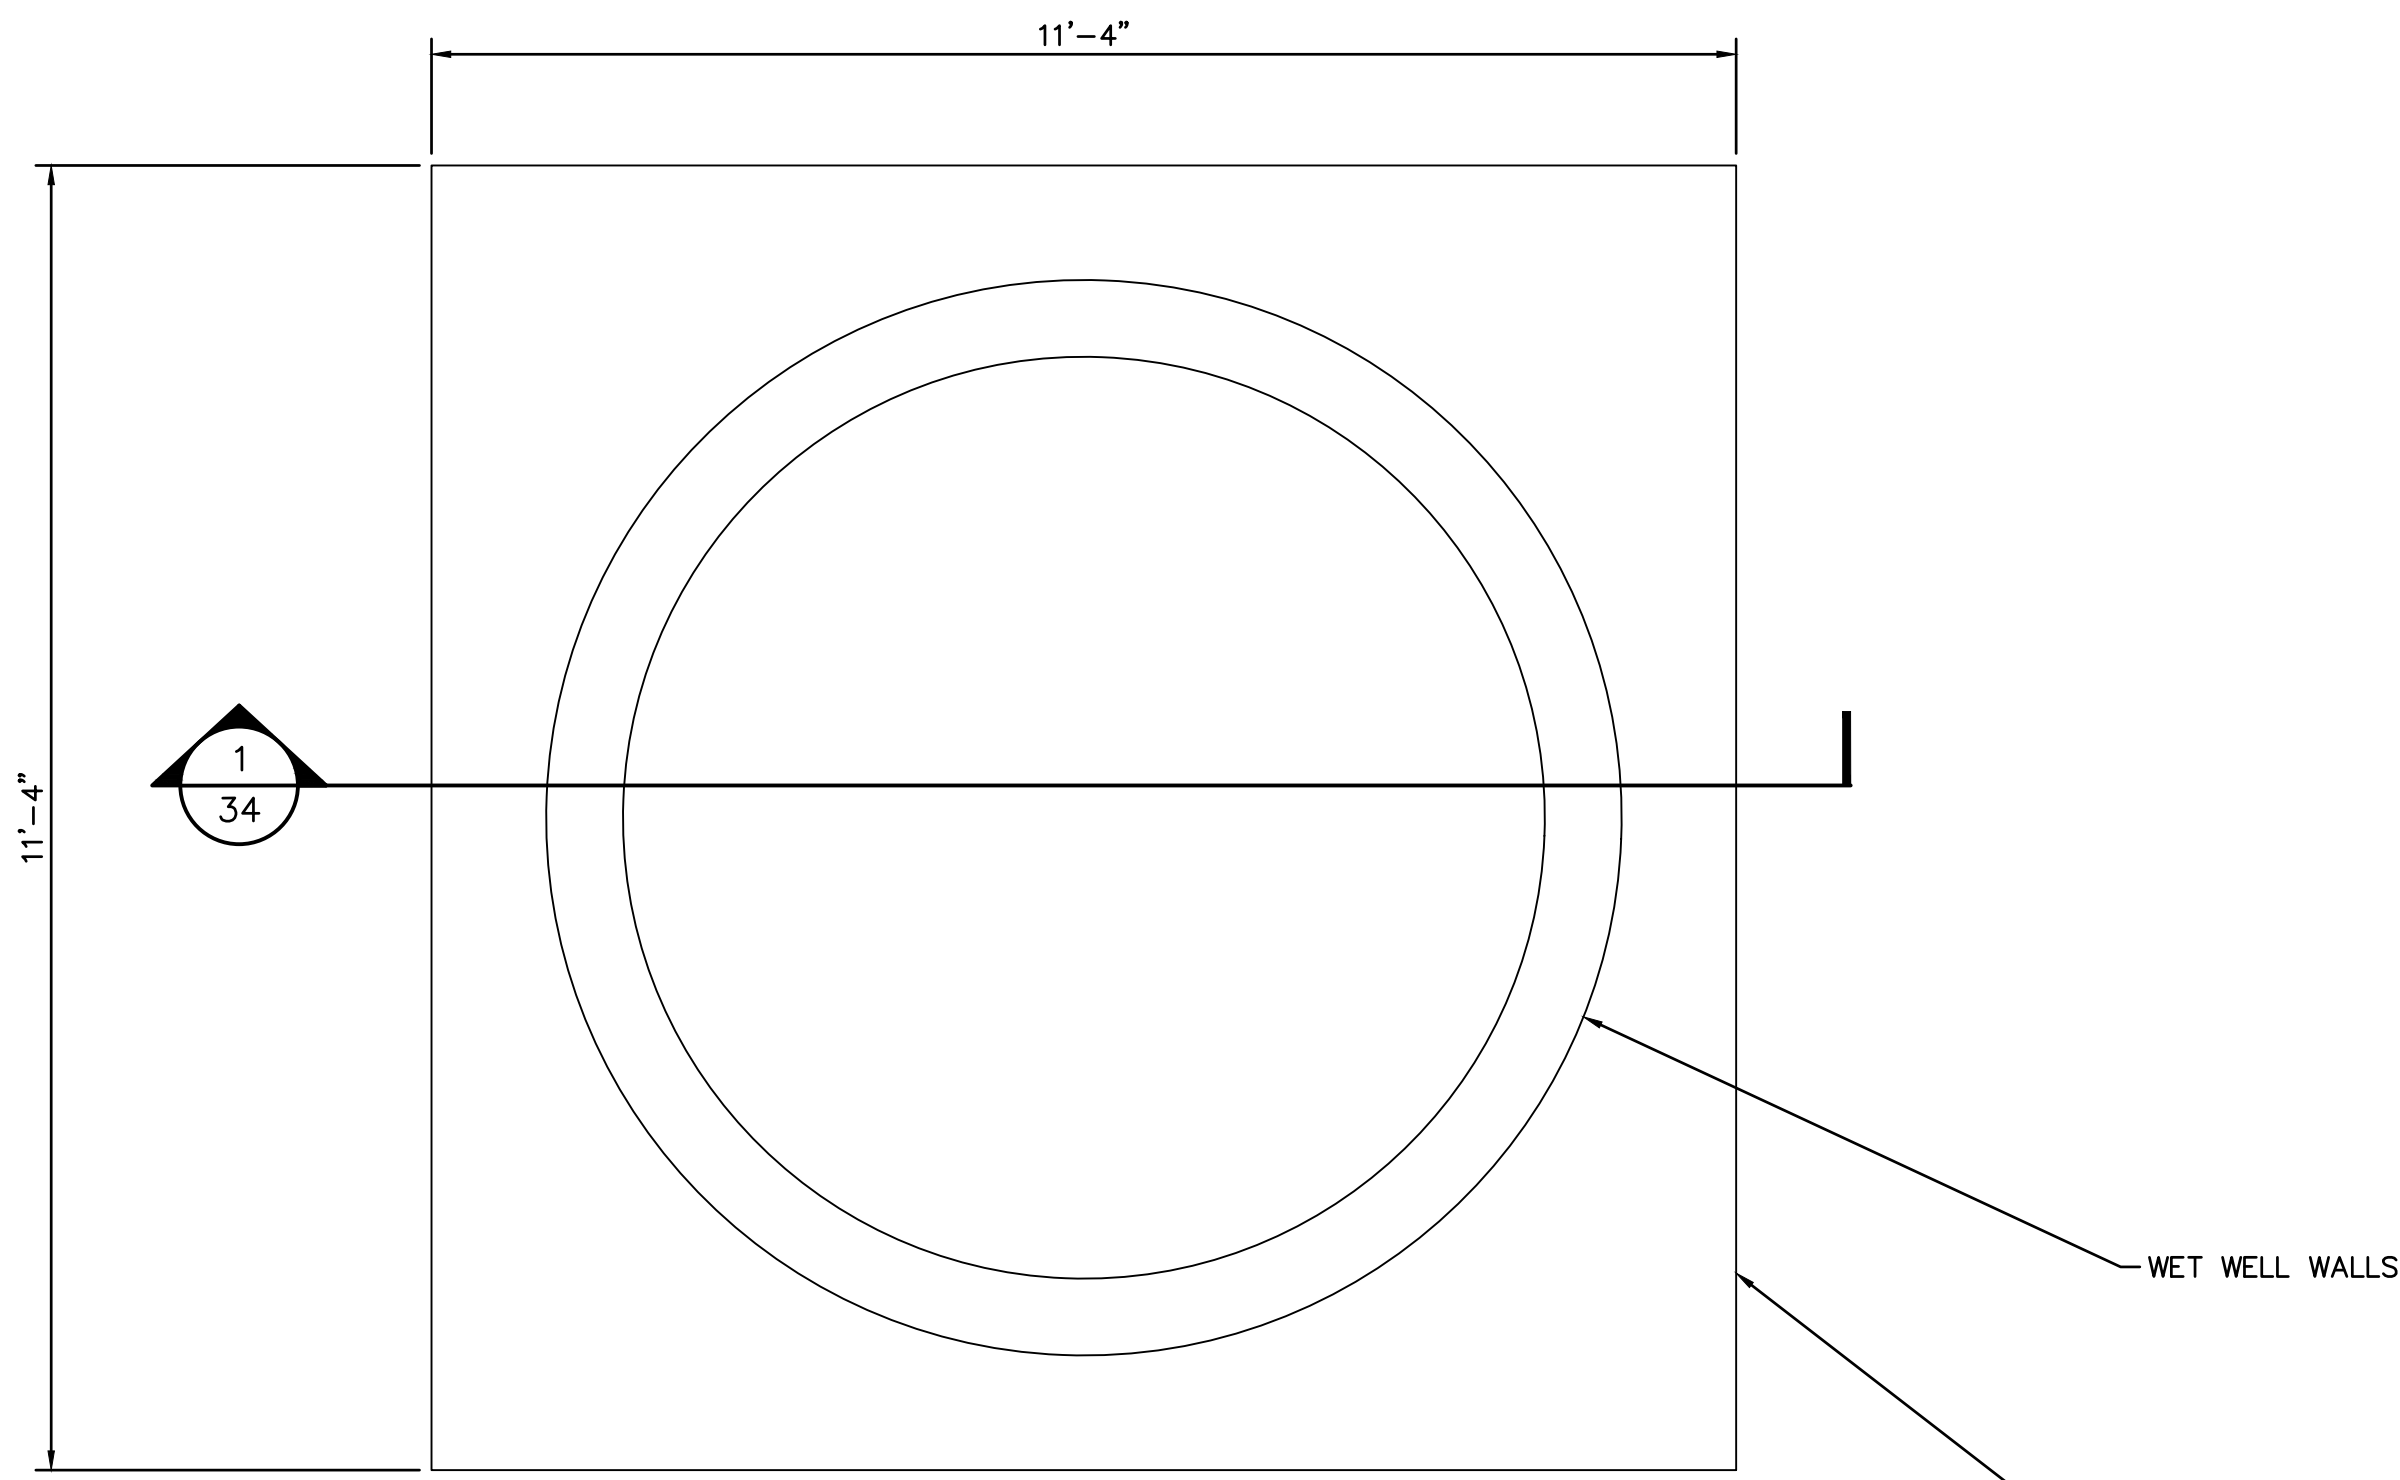


WET WELL WALLS
1'-6" THICK WET WELL BOTTOM SLAB

WET WELL BOTTOM SLAB




SCALE: 1" = 20'

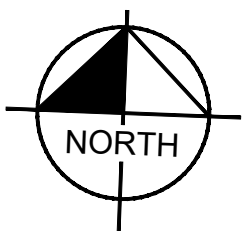

1) Please follow detail S-1B from EMWD for the wet well slab with a revised dimension of 12'-0" square and update rebar reinforcement to match S-1B using 8' embedment, #6 @ 12" OC top and bottom each way, #5's @ 12" OC and 2' thick foundation slab.

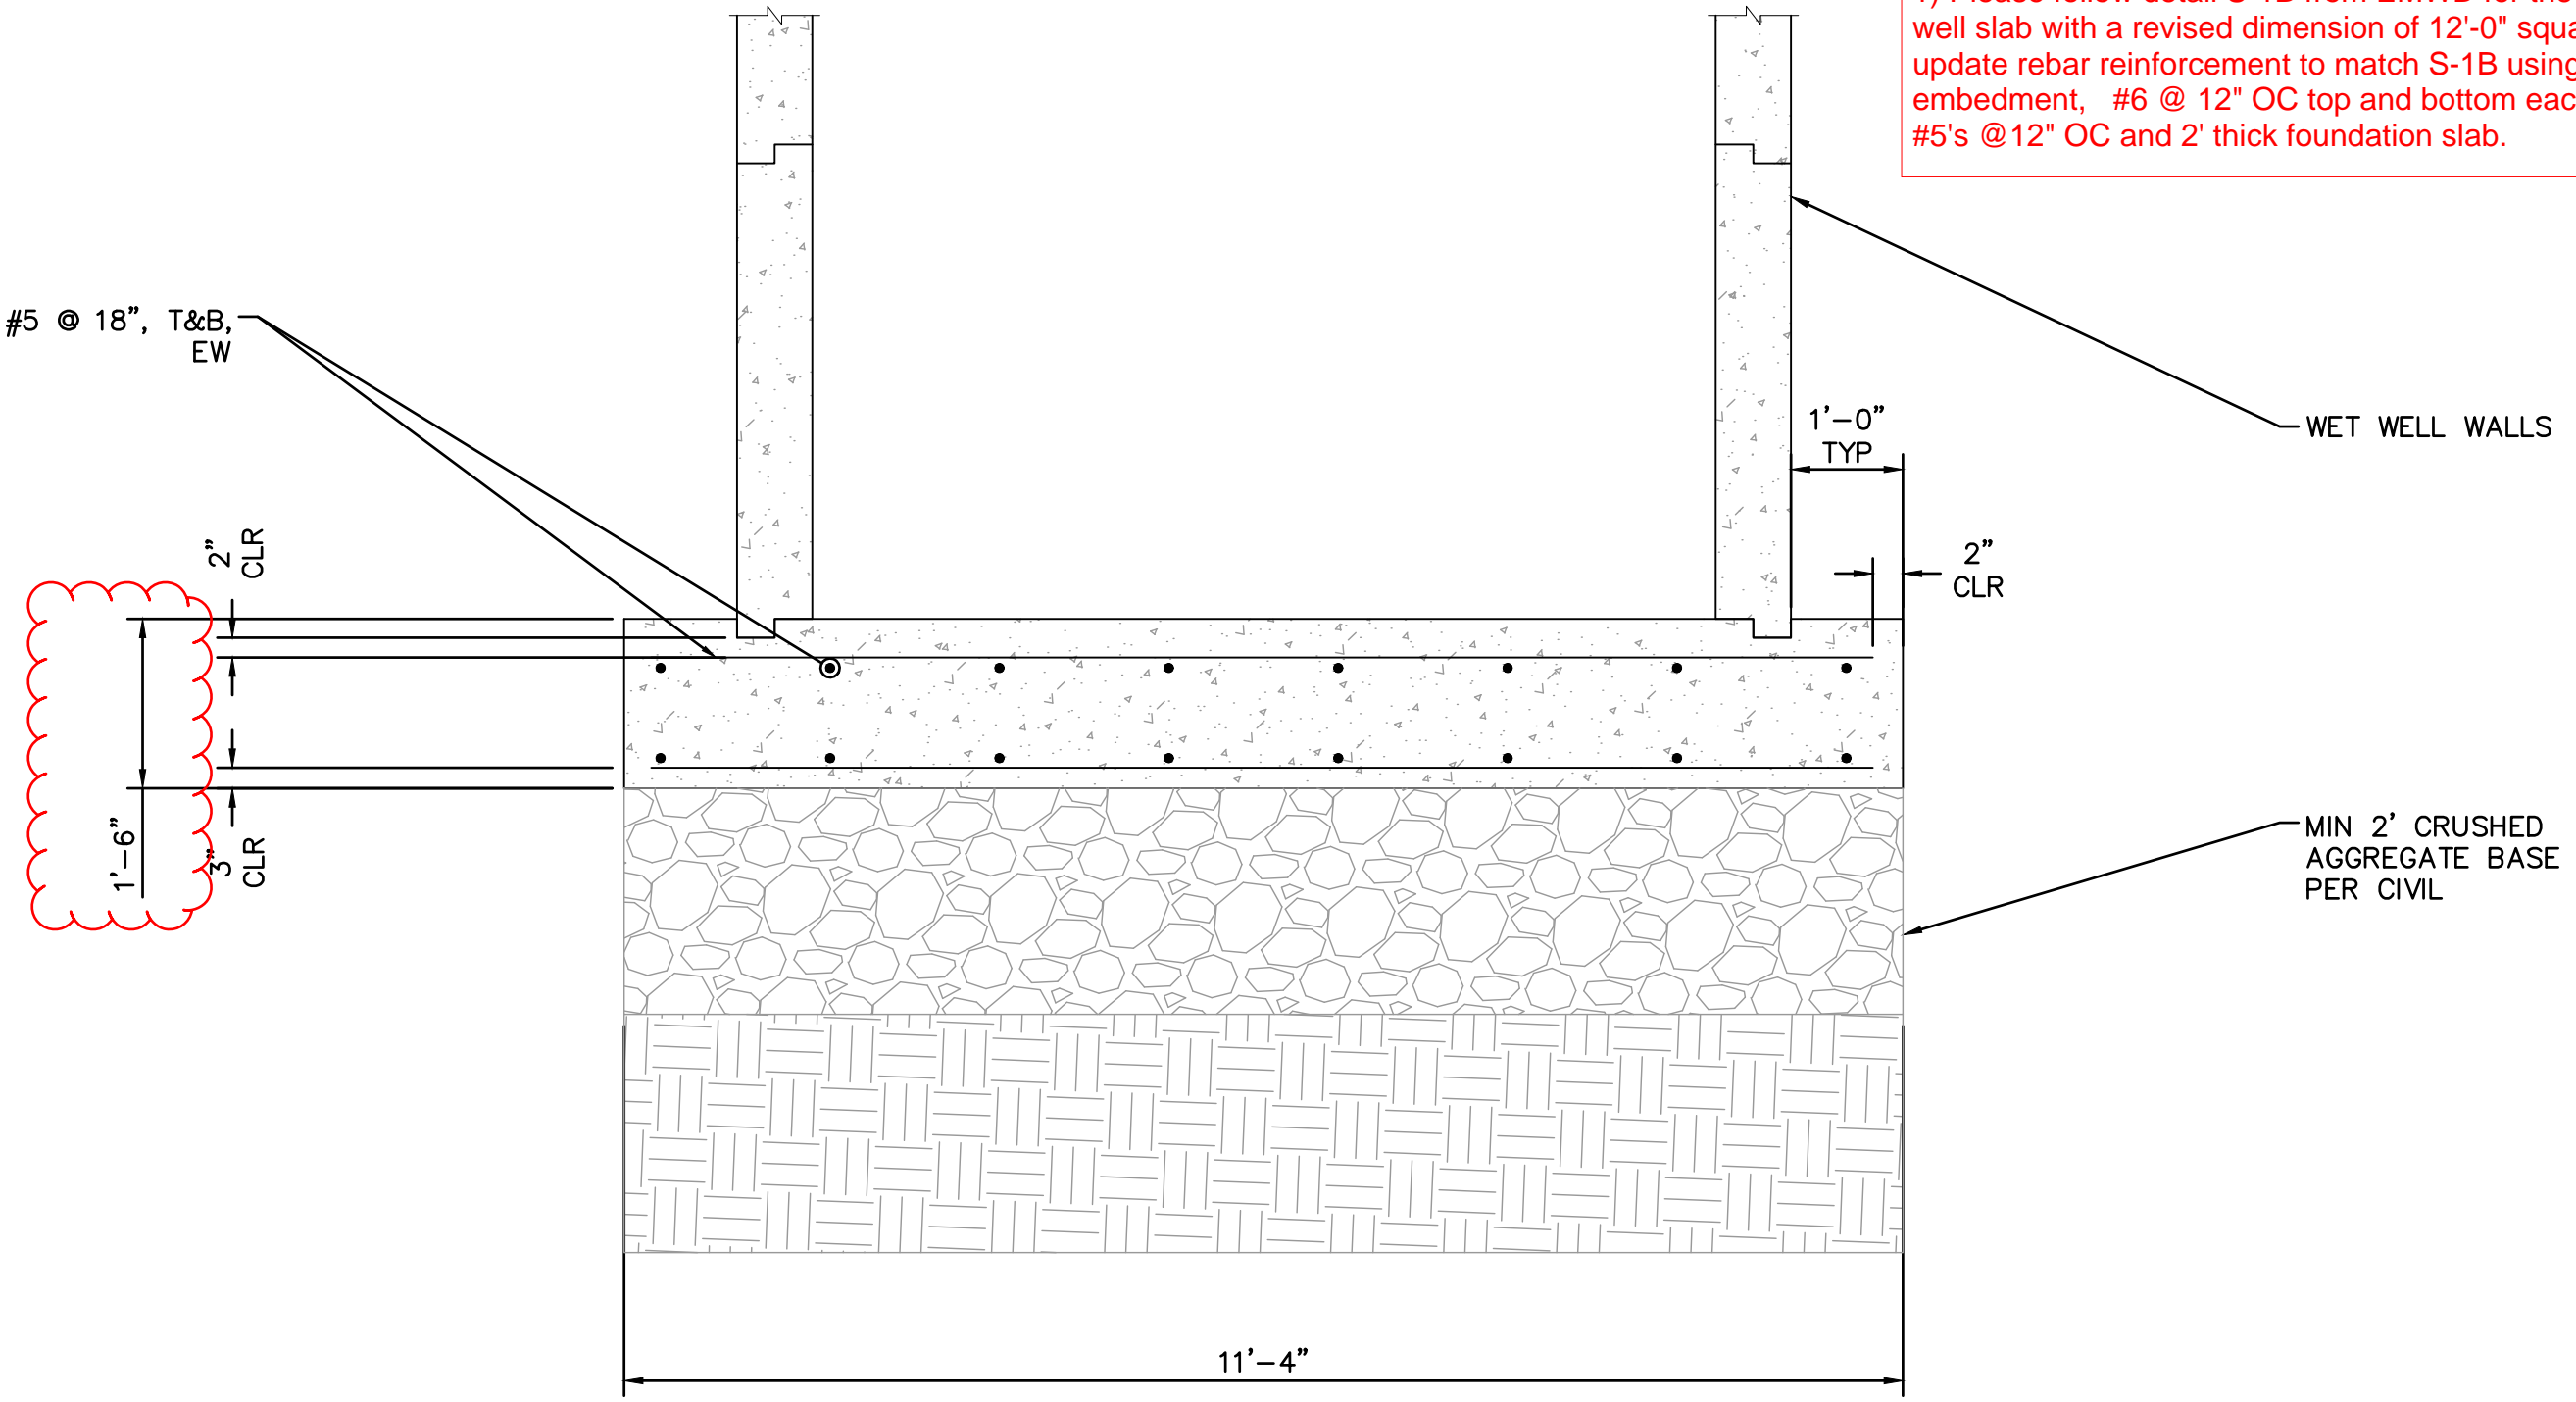

1
34 WET WELL BOTTOM SLAB SECTION
SCALE: 1" = 20'

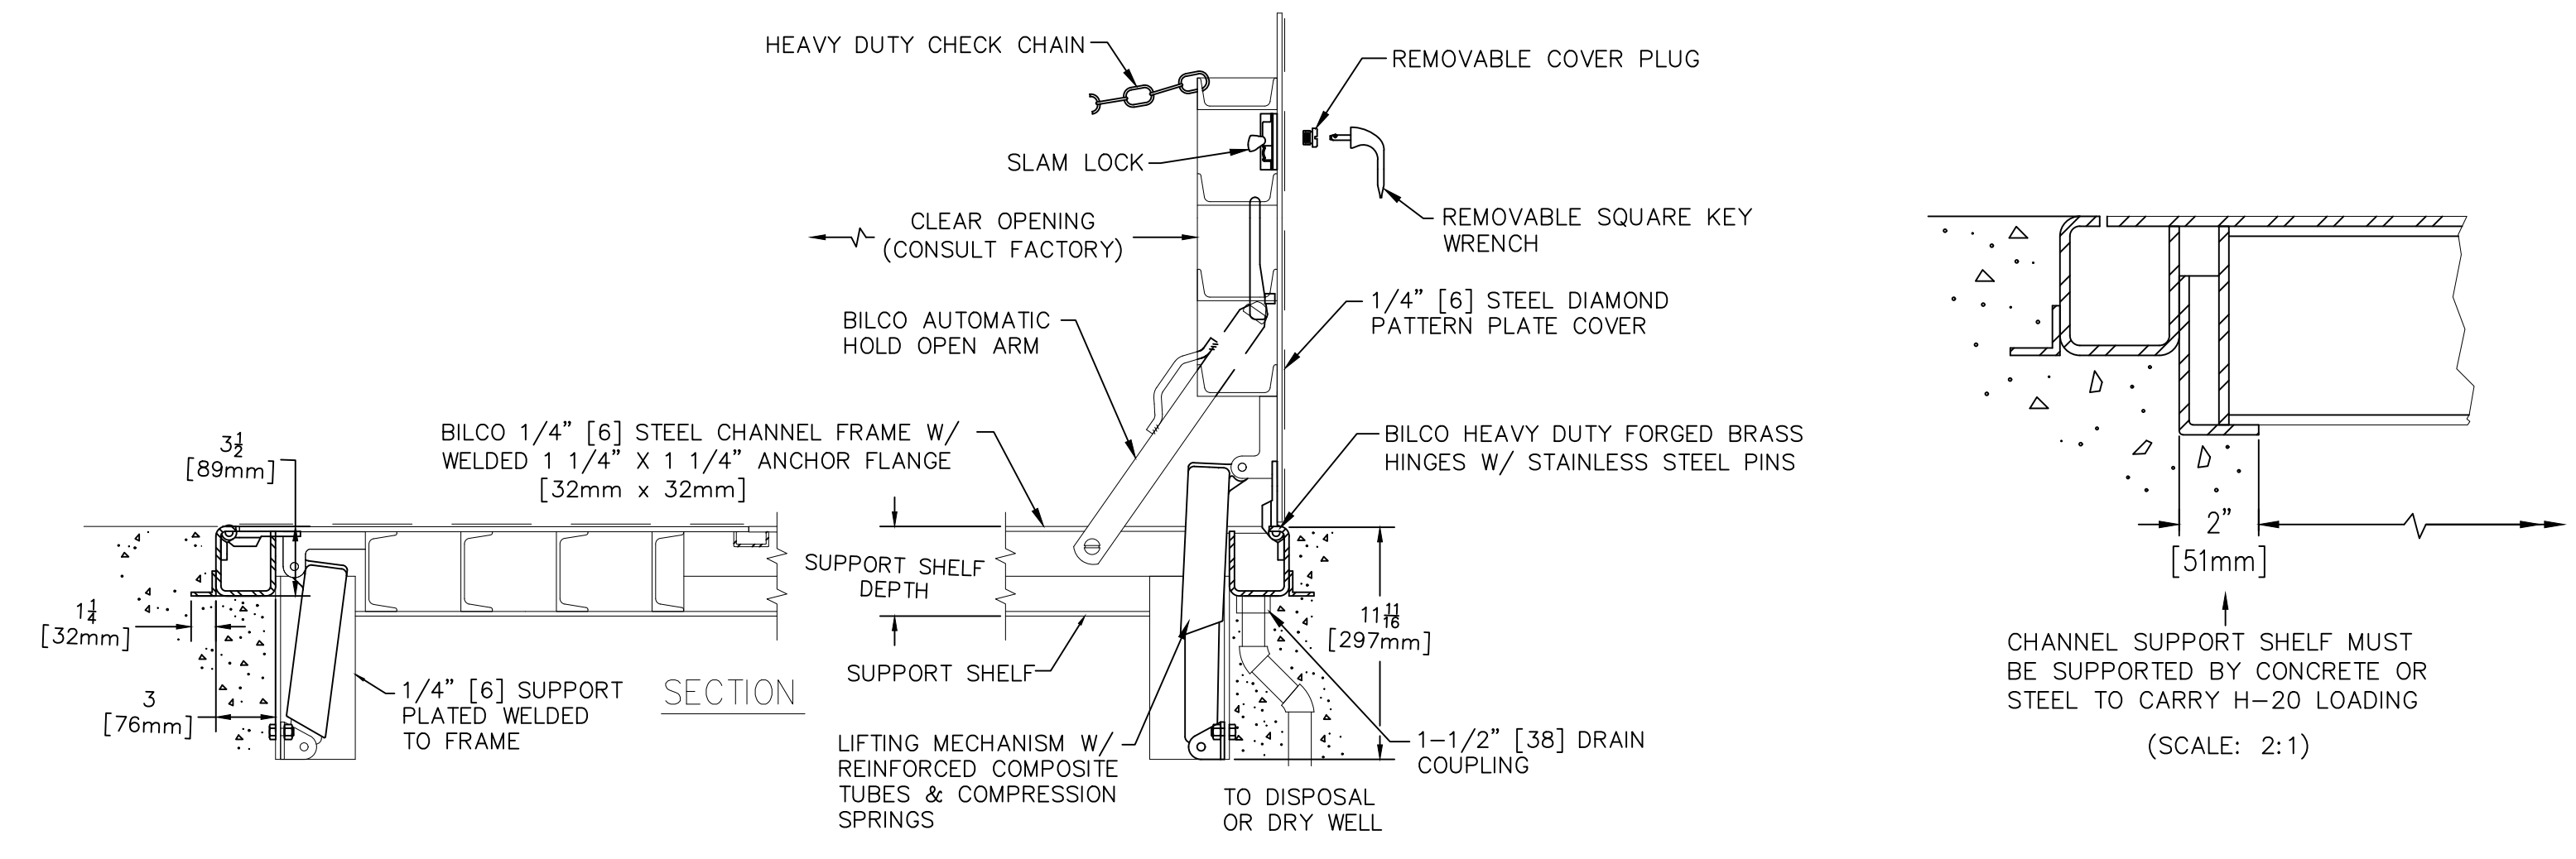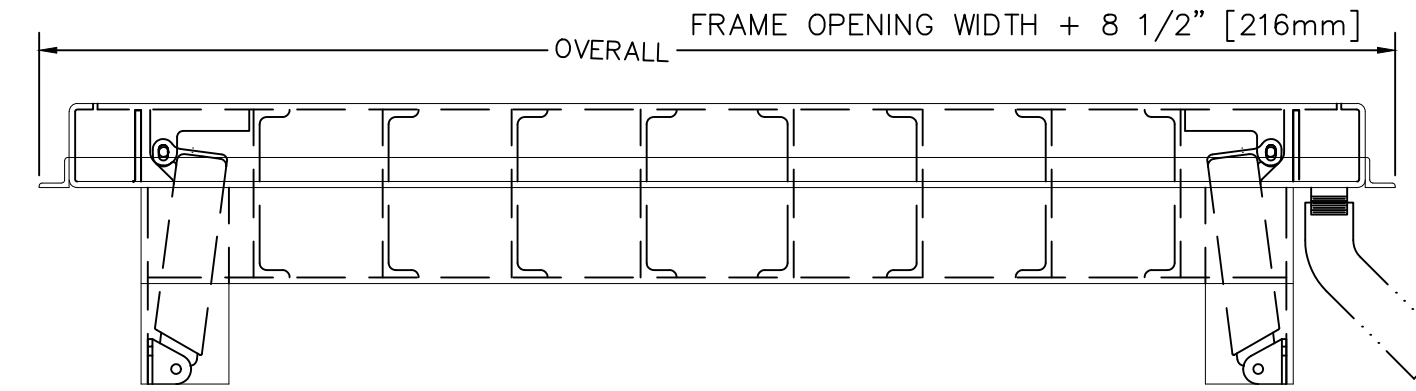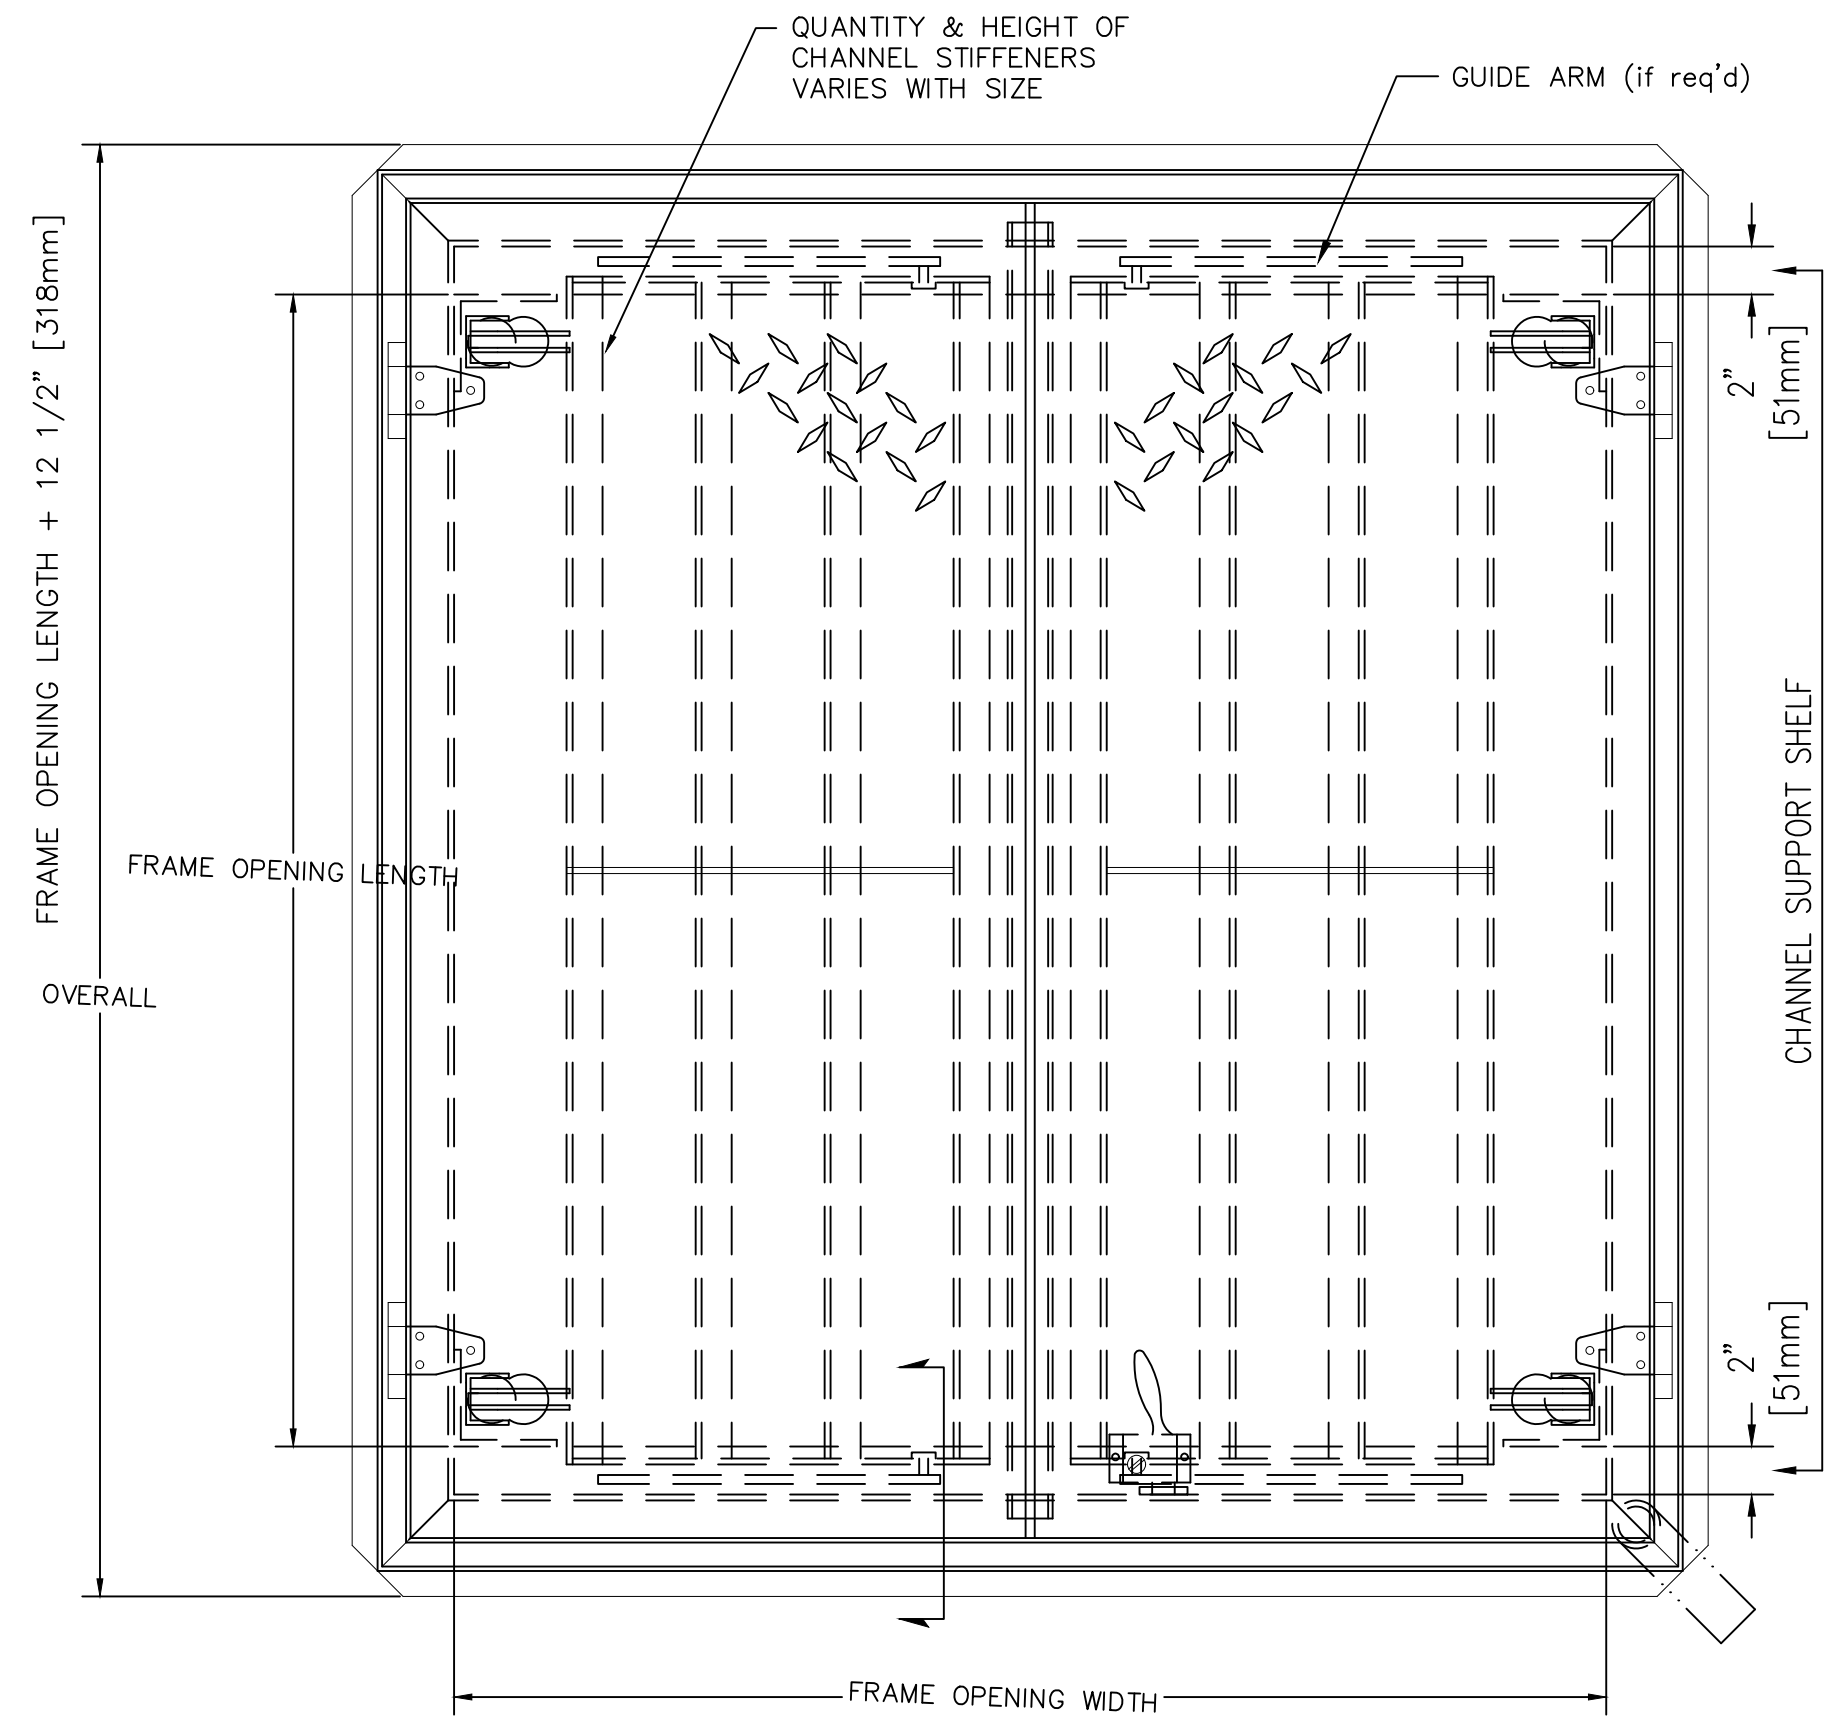

2
34 WET WELL HATCH DETAILS
SCALE: 1-1/2" = 1'-0"




BENCHMARK:
NATIONAL GEODETIC SURVEY BENCHMARK NO. 1311
1.4 MILES WEST OF BEAUMONT ON INTERSTATE 10 TO SAN TIMOTEO CANYON NEAR FRONTAGE ROAD ON SOUTH (WEST) SIDE OF INTERSTATE 10, 0.1 MILES SOUTHWEST ALONG FRONTAGE ROAD, SOUTH ACROSS THE ROAD FROM A GUY POLE 25.9 FEET SOUTH OF THE CENTERLINE OF FRONTAGE ROAD, 1.8 FEET WEST OF POWERPOLE AND 1.8 FEET EAST OF A WITNESS POST, INSIDE A 4 INCH PVC PIPE WITH SCREW PLUG 1 INCH ABOVE GROUND (ELEVATION = 2468.07). ALSO SHOWN ON HIGHWAY 60 / POTRERO BLVD. INTERCHANGE STATIC GPS PROJECT CONTROL DIAGRAM AND IDENTIFIED THEREON AS 3508 BM D3474 WHEN THE PUBLISHED ELEVATION = 2468.07 IS CORRECTED WITH A MEASURED ELEVATION = 2468.01, USED HEREON.
ELEV. 2468.01, (NVD '88), (STAMPED Q 1311 1978)

BY	MARK	DESCRIPTION	APPR.	DATE
ENGINEER		REVISIONS		CITY

Kimley»Horn
401 B Street, Suite 600, San Diego, CA 92101
Phone: (619) 234-9411
WWW.KIMLEY-HORN.COM

J. Brue
JUSTIN L. BRUE
P.C.E. 87614
8/23/2021

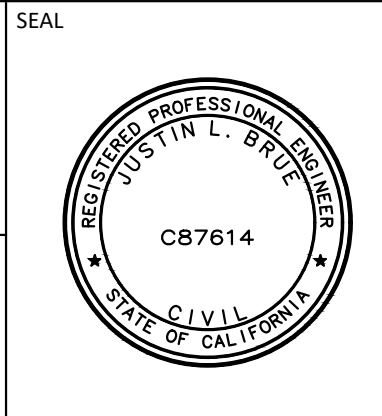

DESIGN BY: SLM
DRAWN BY: RC/SW
CHECKED BY: TW/SS
SCALE:
DATE:
JOB NUMBER: 195284001



Reviewed By: _____ Date: _____
Staff Engineer

Recommended for Approval By: *[Signature]* Date: 11/19/2021
Administrative Engineer



Approved By: *[Signature]* Date: 11/23/2021
City Engineer/Director of Public Works

CITY OF BEAUMONT, PUBLIC WORKS DEPARTMENT
ENGINEERING DIVISION
550E 6th St
Beaumont, CA 92223
TEL: (951) 769-8520 FAX: (951) 769-8526


CITY OF BEAUMONT, CALIFORNIA
IMPROVEMENT PLANS FOR:
**BEAUMONT CROSSROADS
LIFT STATION**
WET WELL SLAB II

SHEET
34
OF 38 SHEETS
FILE NO:
3387

Plotted By: \\vml\user\stam Sheet Set: BEAUMONT LIFT STATION WET WELL SLAB II October 20, 2021 10:49:23am K:\ISND_WATER\195284001 Beaumont Lift Station\Design\Plan Sheets - 2020\DELTA SET\195284001 - .dwt.dwg

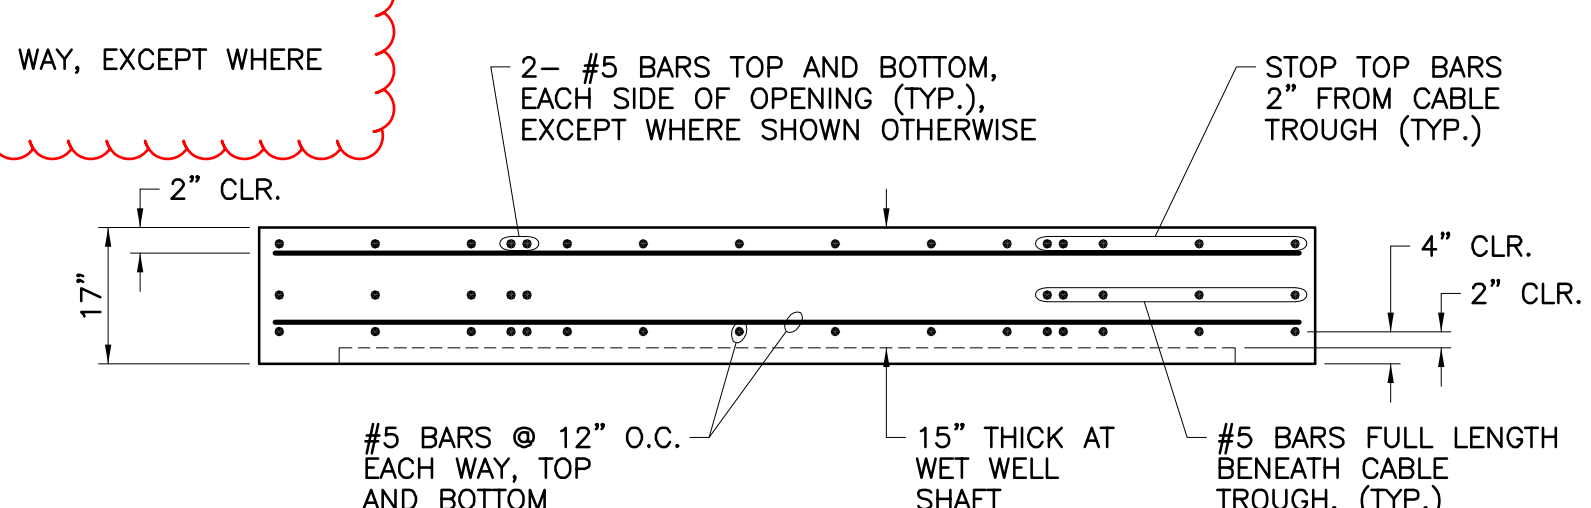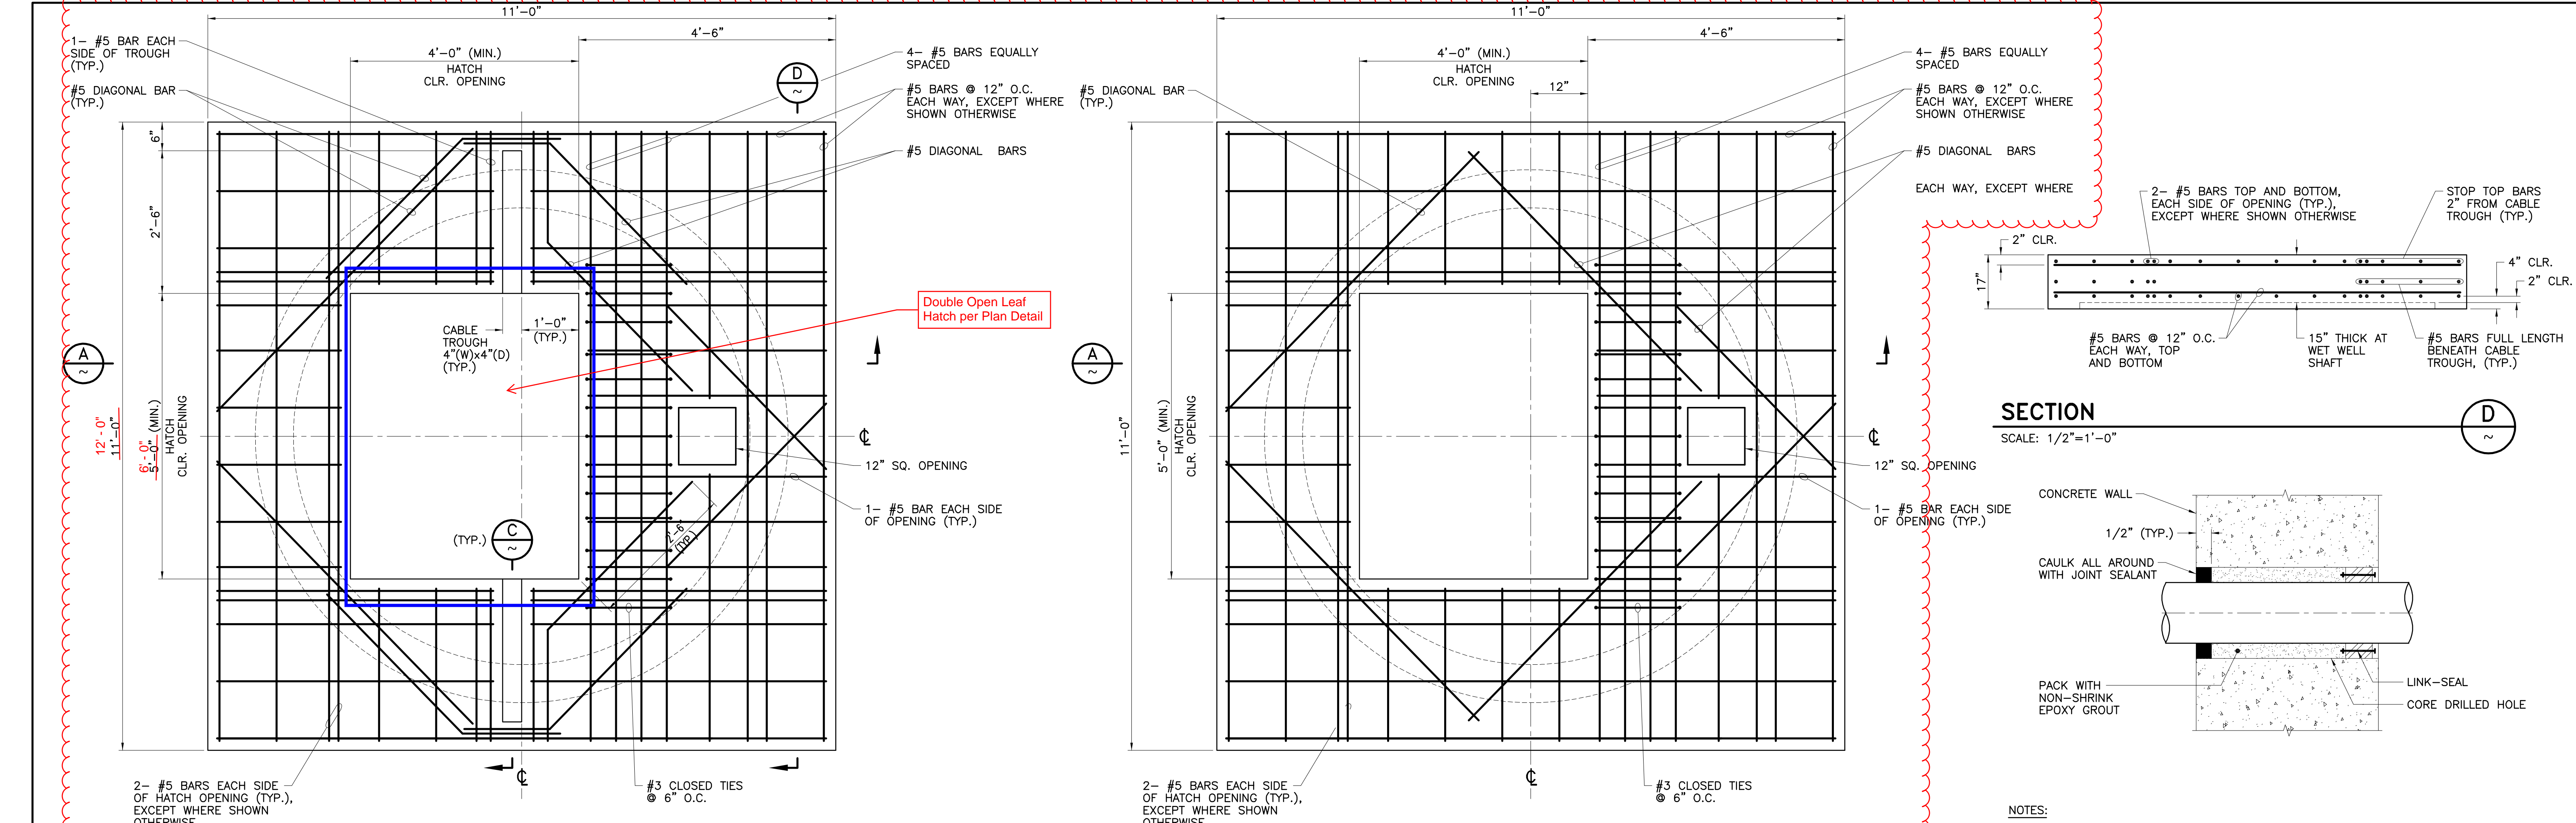

SECTION
SCALE: 1/2"=1'-0"

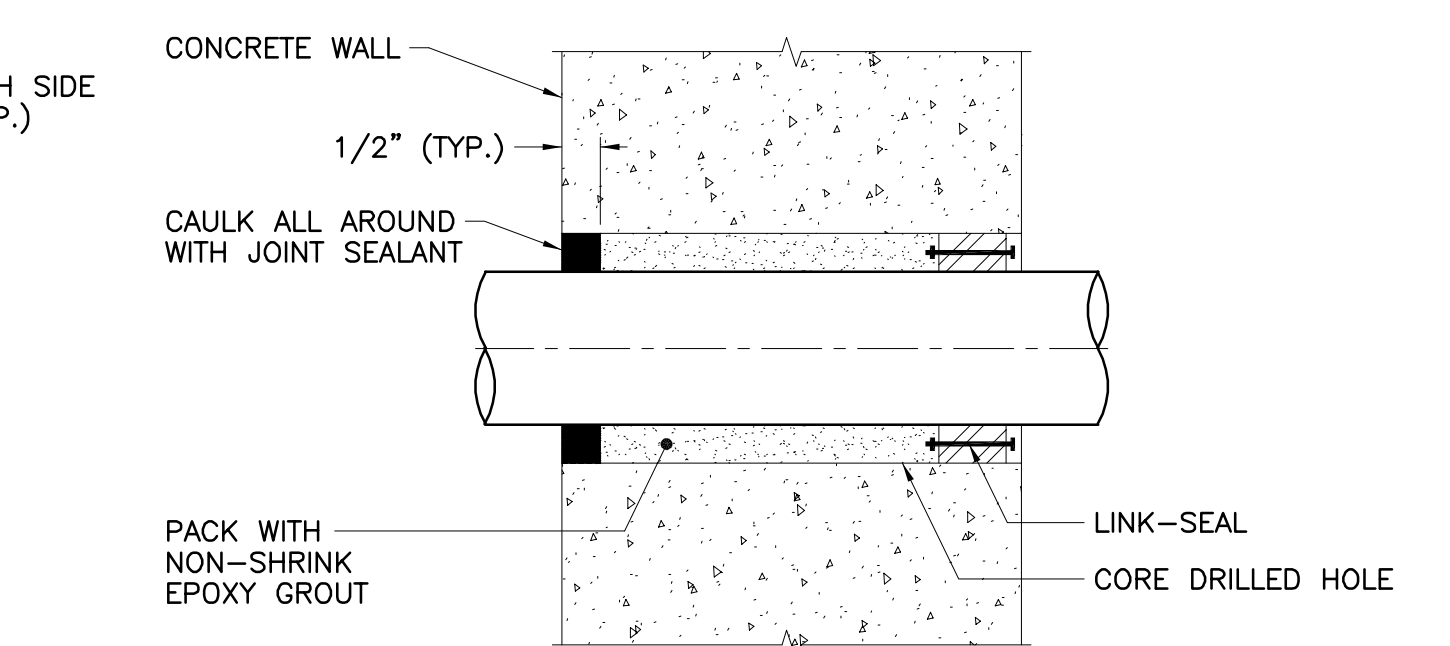

FOUNDATION BLOCKOUT DETAIL
N.T.S.

- NOTES:**
- HATCH FRAME AND CABLE TROUGH FRAME NOT SHOWN FOR CLARITY.
 - WET WELL ROOF MAY BE CAST-IN-PLACE ON TOP OF WET WELL OR IT MAY BE PRECAST ONSITE AND LIFTED INTO PLACE. FOR PRECAST ROOF, CONTRACTOR SHALL BE RESPONSIBLE FOR DESIGN AND CONSTRUCTION OF ALL NECESSARY LIFTING DEVICES/SYSTEMS.


- NOTES:**
- HATCH FRAME NOT SHOWN FOR CLARITY.
 - WET WELL ROOF MAY BE CAST-IN-PLACE ON TOP OF WET WELL OR IT MAY BE PRECAST ONSITE AND LIFTED INTO PLACE. FOR PRECAST ROOF, CONTRACTOR SHALL BE RESPONSIBLE FOR DESIGN AND CONSTRUCTION OF ALL NECESSARY LIFTING DEVICES/SYSTEMS.

- NOTES:**
- JOINT SEALANT SHALL BE TWO COMPONENT, POLYURETHANE ELASTOMERIC SEALANT, SIKAFLEX-2C NS, AS MANUFACTURED BY SIKA, OR EQUAL. PROVIDE BACKER ROD OR TAPE AT BACK OF JOINT SEALANT.
 - LINK-SEAL SHALL BE LOCATED ON SIDE OF WALL/SLAB THAT WILL BE PERMANENTLY ACCESSIBLE. LINK-SEAL SHALL BE FOR CORROSION SERVICE WITH EPDM RUBBER AND STAINLESS STEEL BOLTS AND NUTS, AS MANUFACTURED BY GPT INDUSTRIES, OR EQUAL. SLEEVE DIAMETER SHALL BE PER MANUFACTURERS RECOMMENDATION.


**WET WELL TOP MAT ROOF
REINFORCING PLAN FOR 8'-0" WET WELL**
SCALE: 3/4"=1'-0"

**WET WELL BOTTOM MAT ROOF
REINFORCING PLAN FOR 8'-0" WET WELL**
SCALE: 3/4"=1'-0"


TYPICAL PIPE PENETRATION DETAIL
N.T.S.

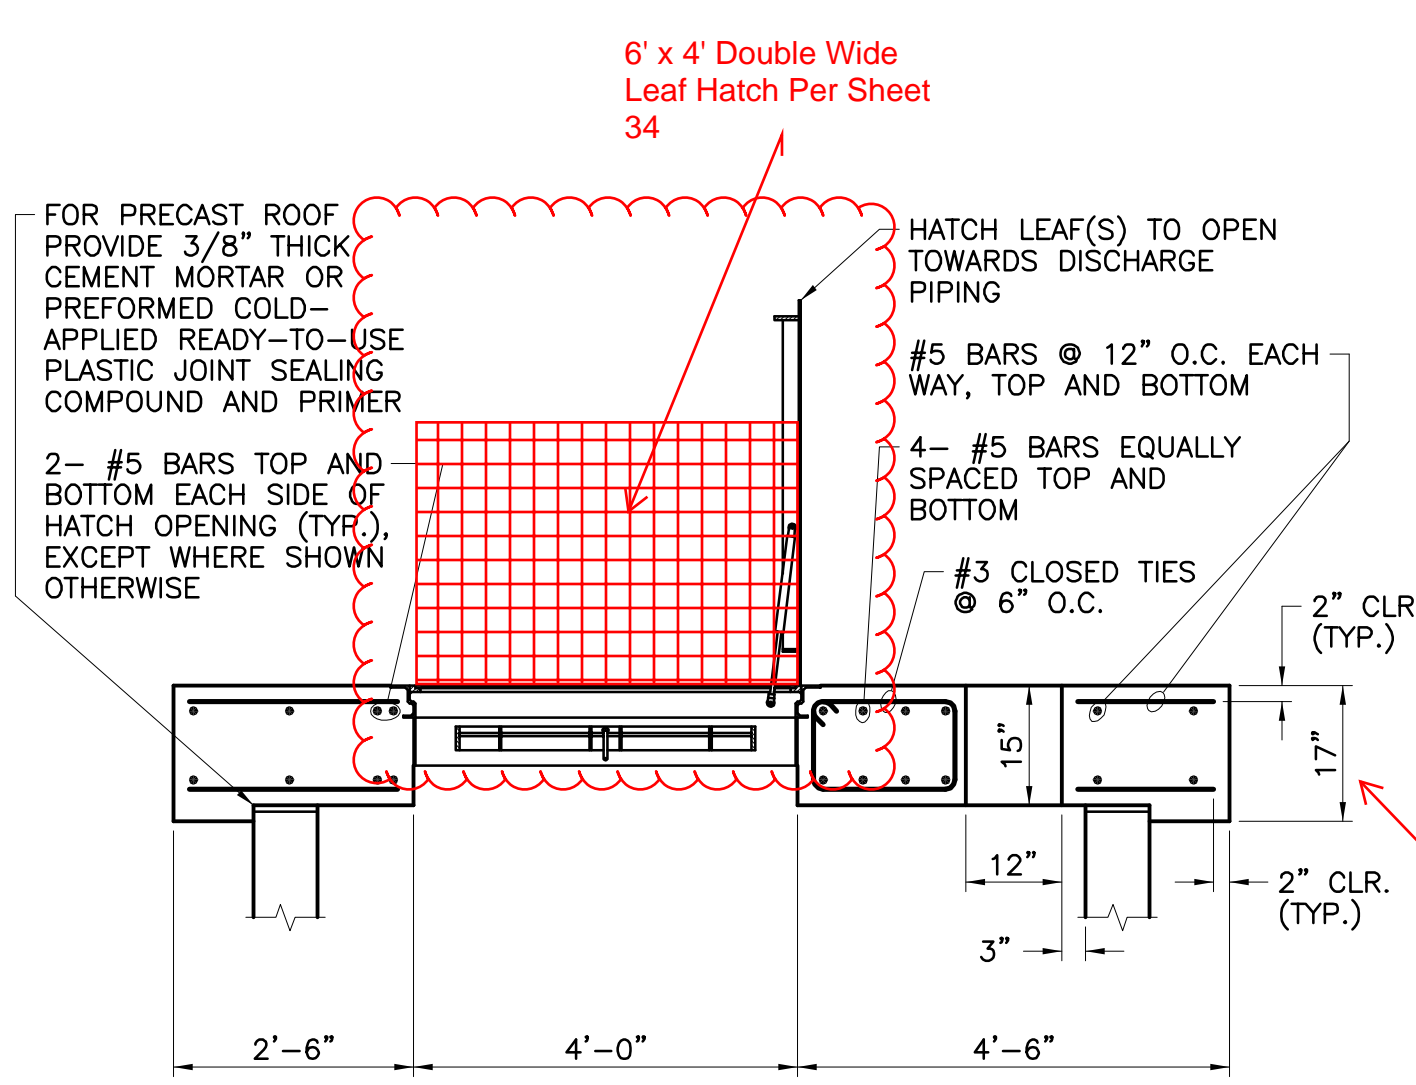


WET WELL ROOF SECTION
SCALE: 1/2"=1'-0"

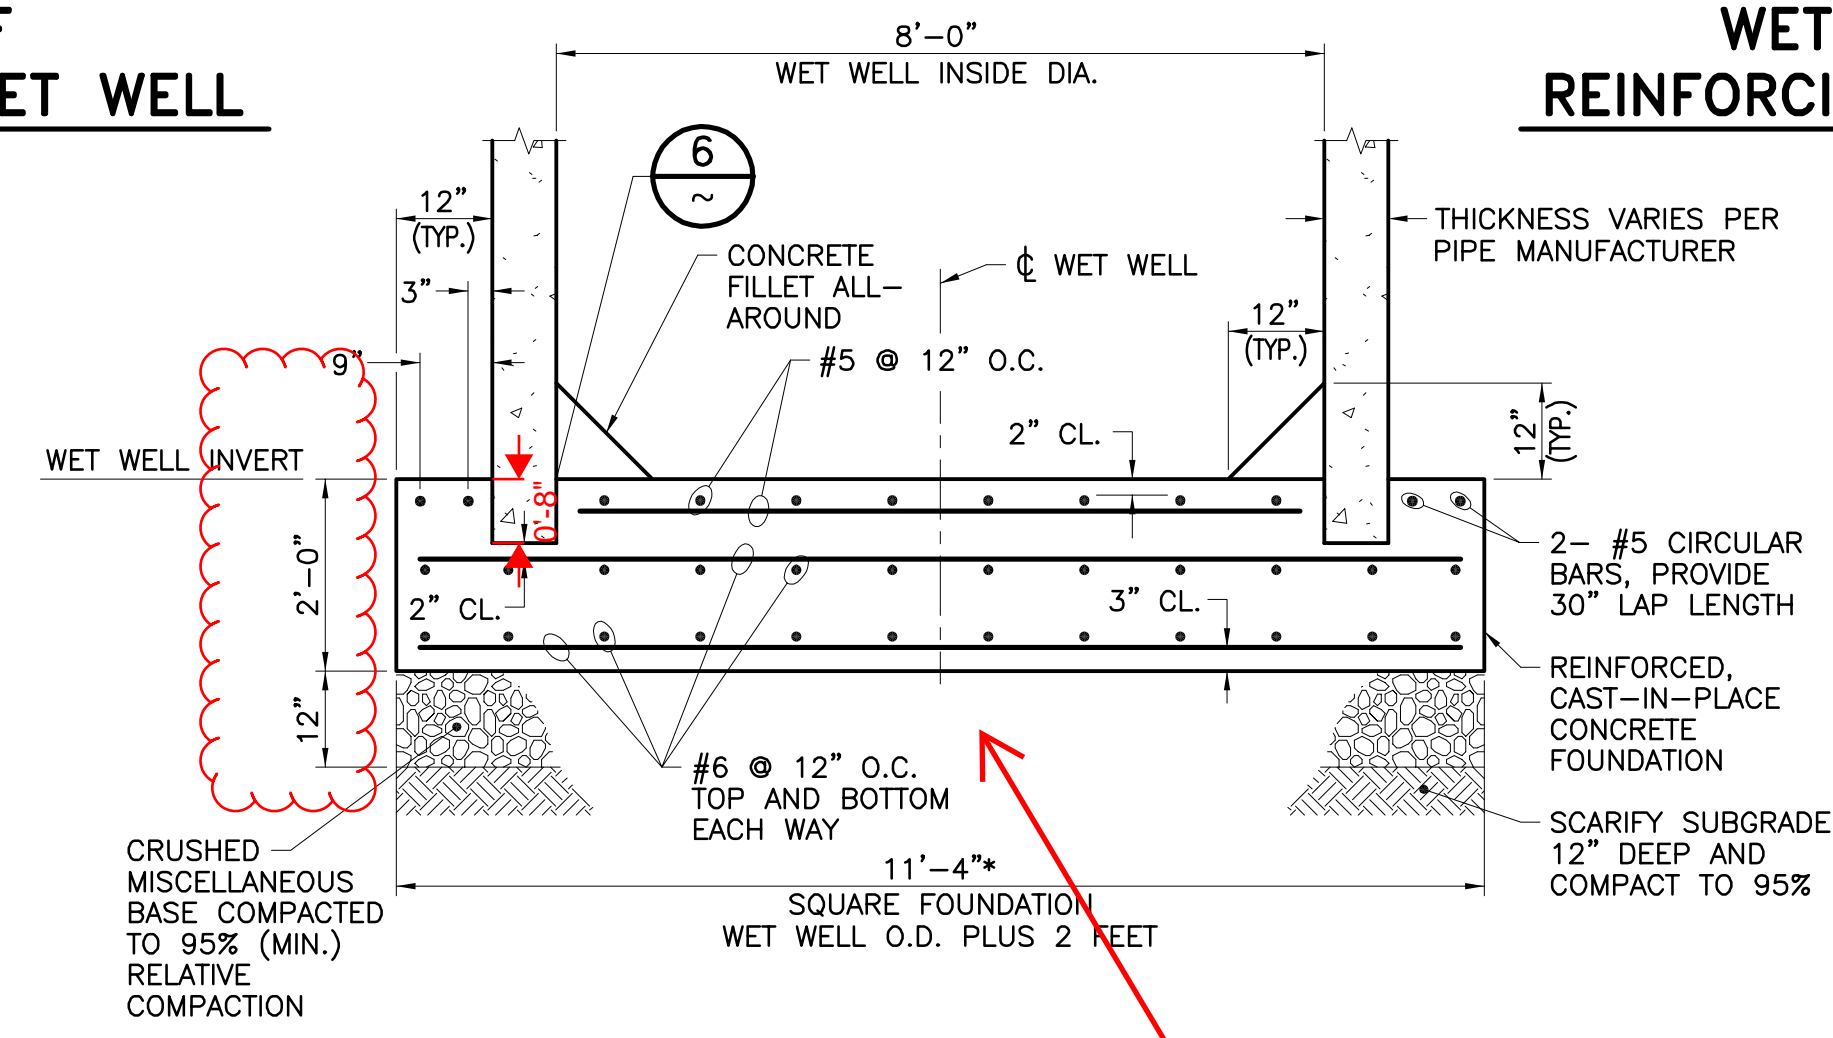

WET WELL FOUNDATION SECTION
SCALE: 1/2"=1'-0"

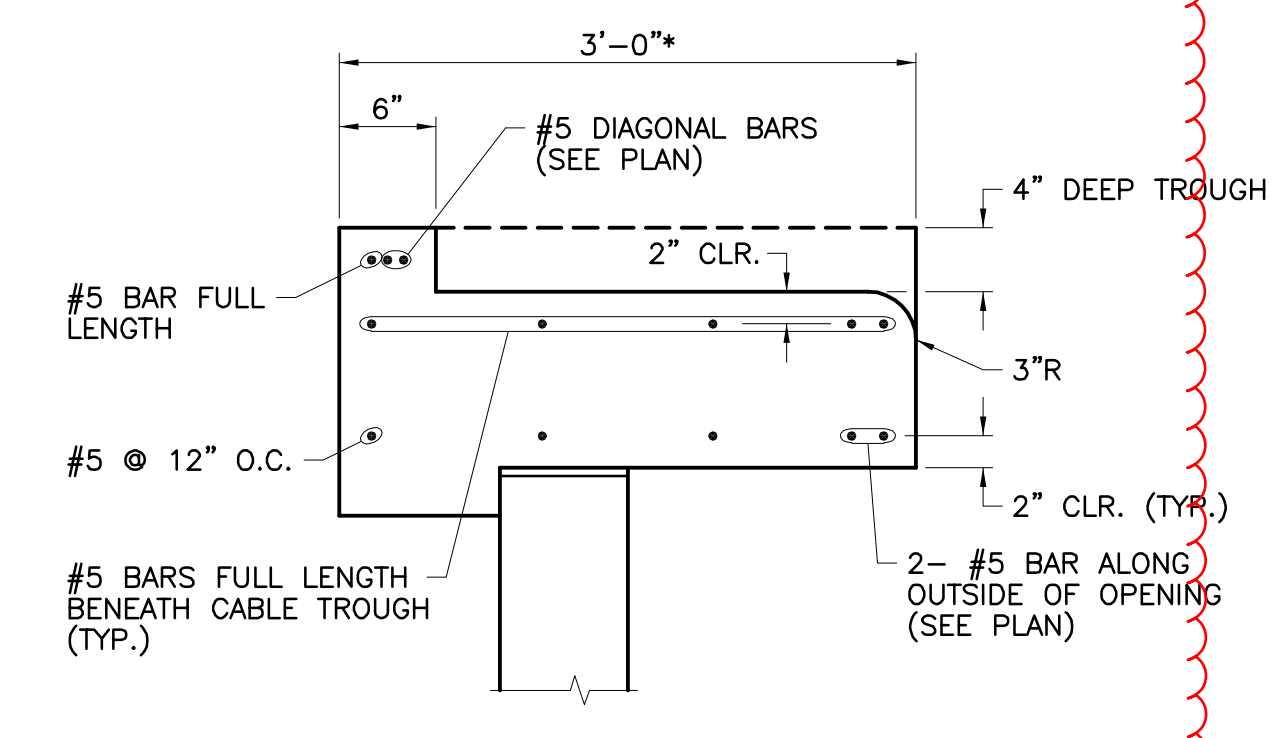

SECTION
SCALE: 1/2"=1'-0"

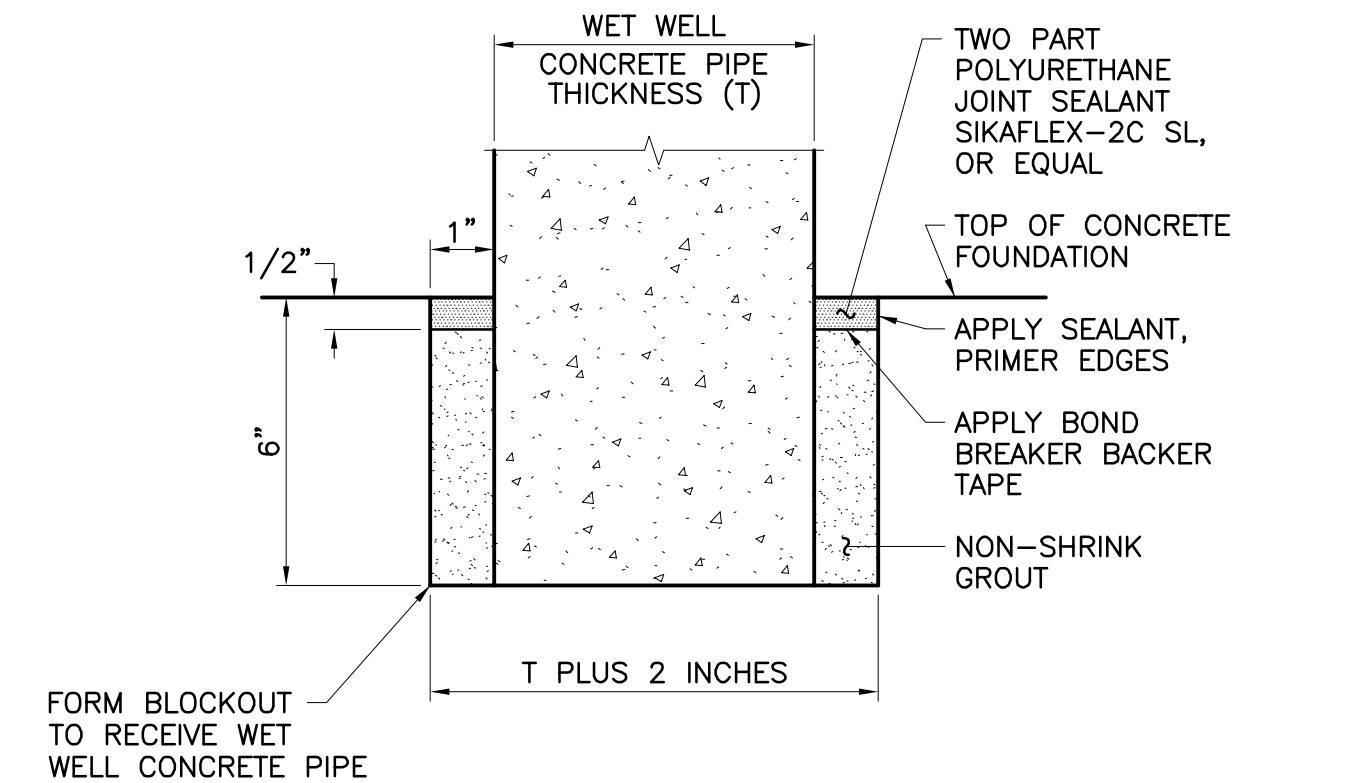

FOUNDATION BLOCKOUT DETAIL
N.T.S.

1) Please follow detail S-1B from EMWD for the wet well slab with a revised dimension of 12'-0" square and update rebar reinforcement to match S-1B using 8" embedment, #6 @ 12" OC top and bottom each way, #5 @ 12" OC and 2" thick foundation slab.

DWG. NO.: 041101-01-03-01b FILE NO.: 491-53 UPDATE BY: TMM PROJ. ENG.: JPM PLOT DATE: 07/16/21 PLOT TIME: 9:41AM PLOT SCALE: 1=1

<p>KRIEGER & STEWART Engineering Consultants 3602 University Avenue • Riverside, CA 92501 www.kriegerandstewart.com • 951-684-6900</p>	<p>REGISTERED PROFESSIONAL ENGINEER J. P. MACPEECK No. 37263 STATE OF CALIFORNIA CIVIL</p>	<p>APPROVED BY: Corey F. Wallace 05/10/21 DIRECTOR OF DEVELOPMENT SERVICES</p>		<p>APPROVED BY: Armando G. Arroyo 05/10/21 PROJECT MANAGER</p>		<p>DESIGNED PES 05/10/21 DRAWN TMM 05/10/21 TRACED JPM 05/10/21 CHECKED JPM 05/10/21 SUBMITTED</p>		<p>EASTERN MUNICIPAL WATER DISTRICT RIVERSIDE COUNTY, CALIFORNIA</p>		<p>I.D. S.A. W.O. C.O. COORD. SHT. OF D- S-1B</p>	
		<p>APPROVED BY: JPM 05/10/21 REGISTERED ENGINEER No. 37263 DATE 05/10/21</p>		<p>REFERENCES SMALL SEWAGE LIFT STATION GUIDELINES, STANDARD DRAWINGS, AND SPECIFICATIONS</p>		<p>APPROVALS</p>		<p>SCALE: N/A</p>		<p>SEWAGE LIFT STATION (TRACT) WET WELL STRUCTURAL PLANS, SECTIONS, AND DETAILS (260 GPM TO 500 GPM CAPACITY)</p>	

MECHANICAL SPECIFICATIONS

A. GENERAL

- THE INFORMATION INDICATED ON THESE DRAWINGS AS EXISTING IS BASED UPON INFORMATION TAKEN FROM AS-BUILT DRAWINGS, AND FIELD INVESTIGATION. THE PLANS DO NOT GUARANTEE ACCURACY BUT ARE ONLY AN INDICATION OF EXISTING CONDITIONS. IT IS THE CONTRACTOR'S RESPONSIBILITY TO FIELD VERIFY EXACT CONDITIONS SUCH AS EQUIPMENT PLACEMENT, DUCTWORK (SIZE, ROUTING, AND ELEVATION), PIPING (SIZE, ROUTING, AND ELEVATION), ETC. THE DRAWINGS ARE INTENDED TO PROVIDE THE CONTRACTOR AN INDICATION OF THE SYSTEM INSTALLED IN THE FACILITY TO DATE. IT WILL BE THE CONTRACTOR'S RESPONSIBILITY TO MAKE ADJUSTMENTS TO THE DRAWING INFORMATION AS REQUIRED TO MATCH EXISTING FIELD CONDITIONS.
- THE CONTRACTOR SHALL INSTALL THE NEW EQUIPMENT, ROOF CURB, AND PIPING AROUND ALL EXISTING OBSTACLES INCLUDING: ELECTRICAL CONDUIT, DOMESTIC WATER PIPING, WASTE AND VENT PIPING, ACID WASTE AND VENT PIPING, AND FIRE SPRINKLER PIPING. PROVIDE OFFSETS TO AVOID RELOCATION OF OTHER UTILITIES. RELOCATE UTILITIES IF THEY ARE IN CONFLICT WITH THE MECHANICAL SYSTEM INSTALLATION, CAUSE DEVIATIONS IN THE DESIGN INTENT, UNSATISFACTORY OPERATION, NOISY CONDITIONS, OR INTERFERE WITH MAINTENANCE. IT IS THE MECHANICAL CONTRACTOR'S RESPONSIBILITY TO COORDINATE ANY UTILITY RELOCATION WITH THE APPROPRIATE SUBCONTRACTOR.
- PROVIDE ALL NECESSARY LABOR, MATERIALS, EQUIPMENT, SERVICES AND INSURANCES TO COMPLETE THE HEATING AND AIR CONDITIONING WORK WITHIN THE FULL INTENT OF THE DRAWINGS AND SPECIFICATIONS CONTAINED HEREON AND TO THE ENTIRE SATISFACTION OF THE ENGINEER.
- PROVIDE ALL PERMITS AND FEES AS REQUIRED FOR THE MECHANICAL WORK.
- CONTRACTOR SHALL VISIT THE SITE AND BECOME FAMILIAR WITH THE PROJECT BEFORE BIDDING.
- ALL WORK SHALL BE IN ACCORDANCE WITH THE 2018 INTERNATIONAL BUILDING CODE (IBC), 2018 INTERNATIONAL ENERGY CONSERVATION CODE (IECC), 2018 INTERNATIONAL FIRE CODE (IFC), 2018 UNIFORM MECHANICAL CODE (UMC), 2018 UNIFORM PLUMBING CODE (UPC), 2017 NATIONAL ELECTRICAL CODE (NEC), NATIONAL FIRE PROTECTION ASSOCIATION (NFPA) STANDARDS, AND ALL OTHER APPLICABLE CODES, RULES, AND LOCAL REQUIREMENTS.
- GUARANTEE ALL WORK AND MATERIALS FOR A PERIOD OF ONE YEAR.
- ALL DIMENSIONS AND MEASUREMENTS SHALL BE VERIFIED AT THE JOBSITE BEFORE FABRICATION AND/OR INSTALLATION OF THE EQUIPMENT.
- PROVIDE AND INSTALL ALL EQUIPMENT, PIPING, AND CONTROLS AS SHOWN ON THE DRAWINGS.

B. SUBMITTALS

- ELECTRONIC SUBMITTALS IN A PDF FORMAT, IN LIEU OF PAPER COPIES, WILL BE ACCEPTABLE.
- SUBSTITUTED ITEMS SHALL BE SUBMITTED WITH MANUFACTURER'S DESCRIPTIVE DATA AND MUST SHOW EQUALITY TO EQUIPMENT SPECIFIED. INFORMATION ON SUBSTITUTED ITEMS MUST BE COMPLETE, INCLUDING, BUT NOT LIMITED TO: DESIGN, CONSTRUCTION MATERIALS, CONSTRUCTION QUALITY, AND SOUND LEVELS. ENGINEER WILL NOT RESEARCH INFORMATION REQUIRED TO COMPARE EQUIPMENT. ENGINEER RESERVES THE RIGHT TO REQUIRE SPECIFIED EQUIPMENT.
- SUBMIT MANUFACTURER'S DESCRIPTIVE DATA WITHIN TEN (10) WORKING DAYS AFTER AWARD OF THE CONTRACT. MATERIALS AND EQUIPMENT SHALL NOT BE ORDERED PRIOR TO SUBMITTAL APPROVAL. ALLOW TEN (10) WORKING DAYS AFTER RECEIPT OF SUBMITTALS IN THE ENGINEER'S OFFICE BEFORE REVIEWED SUBMITTALS WILL BE RETURNED.
- UPON COMPLETION OF THE PROJECT, AND PRIOR TO FINAL ACCEPTANCE PAYMENT, SUBMIT AS-BUILT DRAWINGS AND OPERATING AND MAINTENANCE INSTRUCTIONS.

C. WORKMANSHIP

- ALL WORK TO BE PERFORMED BY QUALIFIED PERSONNEL NORMALLY ENGAGED IN THE RESPECTIVE LINE OF WORK.
- PERFORM ALL WORK IN A MANNER NOT TO DISTURB THE NORMAL OPERATION OF THE BUILDING.
- COORDINATE ALL WORK WITH THE OWNER'S REPRESENTATIVE.
- COORDINATE ALL WORK WITH THE OTHER TRADES.
- THE MECHANICAL CONTRACTOR IS RESPONSIBLE FOR PERFORMING ALL WORK ACCEPTABLE TO THE OWNER'S REPRESENTATIVE.

D. DEMOLITION

- DEMOLITION WORK SHALL NOT CREATE ANY DUST PROBLEMS IN THE WORKING SPACES.

E. CUTTING, PATCHING, AND PAINTING

- ALL CUTTING AND PATCHING TO BE PERFORMED BY THE GENERAL CONTRACTOR.
- CUTTING OF ALL OPENINGS SHALL BE COORDINATED WITH THE OWNER'S ENGINEERING REPRESENTATIVE.
- WALL SURFACES SHALL BE PRIMED AND PAINTED. PAINT TYPE AND COLOR SHALL BE AS SPECIFIED BY THE OWNER'S REPRESENTATIVE.

F. PRODUCT HANDLING

- USE ALL MEANS NECESSARY TO PROTECT ALL MATERIALS AND EQUIPMENT BEFORE, DURING, AND AFTER INSTALLATION AND TO PROTECT THE MATERIALS AND WORK OF THE OTHER TRADES.
- IN THE EVENT OF DAMAGE, IMMEDIATELY MAKE ALL REPAIRS AND REPLACEMENTS NECESSARY TO THE APPROVAL OF THE ENGINEER AND AT NO ADDITIONAL COST TO THE OWNER.

G. SEISMIC RESTRAINTS

- ALL EQUIPMENT, PIPING, AND CONDUIT SHALL BE SEISMICALLY RESTRAINED PER THE 2018 IBC.
- REFERENCES: INTERNATIONAL BUILDING CODE (IBC) SECTION 1613.1, AMERICAN SOCIETY OF CIVIL ENGINEERS (ASCE 7) SECTION 13.6, SHEET METAL AND AIR CONDITIONING CONTRACTOR'S NATIONAL ASSOCIATION (SMACNA) SEISMIC RESTRAINT MANUAL, AND AMERICAN SOCIETY OF PLUMBING ENGINEERS (ASPE) PLUMBING ENGINEERING DESIGN HANDBOOK.

H. EQUIPMENT

- EQUIPMENT SHALL BE AS SPECIFIED IN THE EQUIPMENT SCHEDULE OR AN APPROVED EQUAL IF NOTED.
- INSTALL EQUIPMENT PER MANUFACTURER'S INSTRUCTIONS.
- CONTRACTOR SHALL PROVIDE ALL PENETRATION OPENINGS IN ROOF FOR ALL PIPING AND CONDUIT REQUIREMENTS.
- ALL UNITS ON ROOF SHALL BE SET ON LEVEL CURBS OR SUPPORTS AT ROOF.
- SECURELY FASTEN ALL EQUIPMENT TO PREVENT MOVEMENT DUE TO WIND OR SEISMIC FORCES.

N. PIPING

- EQUIPMENT DRAIN PIPING TO BE TYPE 'M' HARD DRAWN COPPER WITH WROT COPPER FITTINGS. USE 95/5 SOLDER. SLOPE PIPING 1/8" PER FOOT TOWARDS DRAIN.

T. REFRIGERANT PIPING

- REFRIGERANT PIPING SHALL BE ACR COPPER. LINESET INSULATION TO BE INCLUDED BY MANUFACTURER.
- ALL JOINTS SHALL BE BRAZED WITH SIL-FOS OR EQUAL UNDER A NITROGEN PURGE.
- CHARGING OF SYSTEM: TEST ALL REFRIGERANT PIPING WITH 150 PSI CHARGE OF NITROGEN AFTER FIRST ISOLATING ANY CONTROLS, ETC., THAT ARE NOT RATED FOR 150 PSI. TEST ALL JOINTS WITH A SOAP SOLUTION. EVACUATE SYSTEM AND CHARGE SYSTEM WITH REFRIGERANT. RETEST SYSTEM WITH AN ELECTRONIC GAS DETECTOR. MAKE ALL FINAL ADJUSTMENTS TO REFRIGERANT SYSTEM AS REQUIRED.
- AFTER SYSTEM HAS BEEN LEAK TESTED AND CHARGED, INSULATE ALL SUCTION PIPING WITH RUBATEX R-180 FS OR EQUAL 1/2" THICK CLOSED CELL FOAM INSULATION MEETING ALL NFPA REQUIREMENTS FOR SMOKE DENSITY AND FLAME SPREAD.
- ALL OUTDOOR SECTIONS SHALL BE COATED WITH AN ULTRAVIOLET AND WEATHER RESISTIVE COATING.

U. OTHER MATERIAL

- ALL OTHER MATERIAL, NOT SPECIFICALLY DESCRIBED BUT REQUIRED FOR A COMPLETE JOB, SHALL BE NEW AND FIRST QUALITY, FURNISHED AND INSTALLED BY THE MECHANICAL CONTRACTOR.

W. IDENTIFICATION

- PLASTIC NAMEPLATES: LAMINATED THREE LAYER WITH ENGRAVED BLACK LETTERS ON A LIGHT CONTRASTING BACKGROUND COLOR. INSTALL PLASTIC NAMEPLATES WITH CORROSION RESISTANT MECHANICAL FASTENERS OR ADHESIVE.

Y. RELATED WORK

- ELECTRICAL CONTRACTOR TO PROVIDE AND INSTALL ALL POWER WIRING AND EQUIPMENT DISCONNECTS, UNLESS INCLUDED WITH EQUIPMENT, TO MAKE SYSTEM OPERATIONAL.

Z. CONTROLS

- THERMOSTATS TO BE FURNISHED AND INSTALLED BY HVAC CONTRACTOR.

MECHANICAL SYMBOL LIST

(NOTE: ALL OF THE SYMBOLS INDICATED BELOW MAY NOT APPEAR ON THIS PROJECT)

	RL	REFRIGERANT LIQUID PIPING	CLG	CEILING
	RS	REFRIGERANT SUCTION PIPING	DB	DRY BULB TEMPERATURE
	U	UNION	DDC	DIRECT DIGITAL CONTROL
	P.D.	PIPING TEE DOWN	DL	DOOR LOUVER
	P.U.	PIPING TEE UP	DN	DOWN
	P.U.	PIPING ELBOW UP	(E)	EXISTING
	P.D.	PIPING ELBOW DOWN	EAT	ENTERING AIR TEMPERATURE
		BRANCH - TOP CONNECTION	EDB	ENTERING DRY BULB
		BRANCH - BOTTOM CONNECTION	F	DEGREES FARENHEIT
	OR	ARROW INDICATES DIRECTION OF FLOW	F.A.	FROM ABOVE
	P.O.C.	POINT OF CONNECTION - NEW ITEMS TO EXISTING ITEMS	F.B.	FROM BELOW
	S.A.	SUPPLY AIR DUCT DOWN	FT.	FEET
	S.A.	SUPPLY AIR DUCT UP	LAT	LEAVING AIR TEMPERATURE
	R.A.	RETURN AIR DUCT DOWN	HVAC	HEATING, VENTILATION, AND AIR CONDITIONING
	R.A.	RETURN AIR DUCT UP	MAX	MAXIMUM
	E.A.	EXHAUST AIR DUCT DOWN	MBH	BRITISH THERMAL UNITS PER HOUR (THOUSANDS)
	E.A.	EXHAUST AIR DUCT UP	MIN	MINIMUM
	S.A.D.	SUPPLY AIR DIFFUSER WITH FLEX CONNECTION	(N)	NEW
	R.A.G.	RETURN AIR GRILLE OPEN TO CEILING SPACE	NFPA	NATIONAL FIRE PROTECTION ASSOCIATION
	EQ #	MECHANICAL EQUIPMENT INDICATED (SEE SCHEDULE)	RL / RS	REFRIGERANT LIQUID LINE / REFRIGERANT SUCTION LINE
	T	THERMOSTAT	S.E.E.R.	SEASONAL ENERGY EFFICIENCY RATIO
	R	ROOM TEMPERATURE SENSOR	SP	STATIC PRESSURE
	ACR	AIR CONDITIONING AND REFRIGERATION	STD	STANDARD
	AFF	ABOVE FINISHED FLOOR	T	TEMPERATURE
	AFG	ABOVE FINISHED GRADE	T.A.	TO ABOVE
	BDD	BACKDRAFT DAMPER	T.B.	TO BELOW
	BTUH	BRITISH THERMAL UNITS PER HOUR	TYP	TYPICAL
	CFM	CUBIC FEET PER MINUTE	WB	WET BULB TEMPERATURE


SPLIT SYSTEM SCHEDULE

CU	OUTDOOR UNIT											FE	INDOOR UNIT				COOLING CAPACITY		HEATING CAPACITY		ELECTRICAL		
	MANUFACTURER	MODEL	AMBIENT DESIGN ('F DB/WB)	OPERATING WEIGHT (LBS)	SEER	HSPF	ELECTRICAL			MANUFACTURER	MODEL		AIRFLOW (CFM)	OPERATING WEIGHT (LBS)	TOTAL CAPACITY (MAX MBH)	TOTAL CAPACITY (MAX MBH)	ELECTRICAL						
							VOLTS/ØHz	MCA	MOCP								VOLTS/ØHz	MCA	MOCP				
1	TRANE	4TWA4	104/70	248	15	-	208/3/60	21	35	1	TRANE	TAM8A	1925	163	50.8	42	208/1/60	8	15				

GENERAL NOTES:
 1. ALL CAPACITIES LISTED ARE AT 0 FEET ELEVATION
 2. PROVIDE AND INSTALL MANUFACTURER'S REFRIGERANT LINESET Exp. 6/30/23
 3. SET FAN SPEED TO MEDIUM

STANDARD FEATURES:
 1. REFRIGERANT SHALL BE R-410A
 2. INVERTER VARIABLE SPEED COMPRESSOR
 3. MINIMUM LINE LENGTH OF 9.8 FEET, MAX LINE LENGTH OF 49.2 FEET WITH NO ADDITIONAL REFRIGERANT REQUIRED, AND MAX ELEVATION OF 23 FEET

OPTIONS:
 A. PROVIDE AND INSTALL MANUFACTURER'S PROGRAMMABLE T-STAT
 B. -

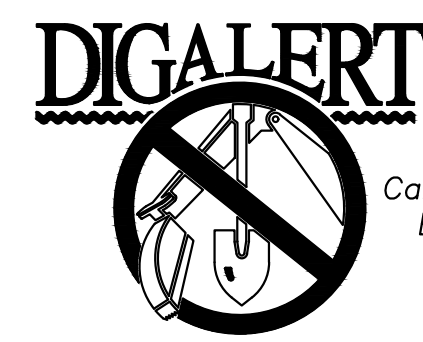

BENCHMARK:
 NATIONAL GEODETIC SURVEY BENCHMARK NO. 1311
 1.4 MILES WEST OF BEAUMONT ON INTERSTATE 10 TO SAN TIMOTEO CANYON NEAR FRONTAGE ROAD ON SOUTH(WEST) SIDE OF INTERSTATE 10, 0.1 MILES SOUTHWEST ALONG FRONTAGE ROAD, SOUTH ACROSS THE ROAD FROM A GUY POLE 25.9 FEET SOUTH OF THE CENTERLINE OF FRONTAGE ROAD, 1.8 FEET WEST OF POWERPOLE AND 1.8 FEET EAST OF A WITNESS POST, INSIDE A 4 INCH PVC PIPE WITH SCREW PLUG 1 INCH ABOVE GROUND (ELEVATION = 2468.07). ALSO SHOWN ON HIGHWAY 69 / POTRERO BLVD. INTERCHANGE STATIC GPS PROJECT CONTROL DIAGRAM AND IDENTIFIED THEREON AS 3558 BM D34374 WHENEN THE PUBLISHED ELEVATION = 2468.07 IS CORRECTED WITH A MEASURED ELEVATION = 2468.01, USED HEREON.
 ELEV. 2468.01, (NVD '88), (STAMPED Q 1311 1978)

Kimley»Horn
 401 B Street, Suite 600, San Diego, CA 92101
 Phone: (619) 234-9411
 WWW.KIMLEY-HORN.COM

SEAL: REGISTERED PROFESSIONAL ENGINEER MATTHEW C. MYRES 33152 Exp. 6/30/23 MECHANICAL STATE OF CALIFORNIA

DESIGN BY: SLM
 DRAWN BY: RC/SW
 CHECKED BY: TW/SS
 SCALE: DATE: JOB NUMBER: 195284001




Reviewed By: _____ Date: _____
 Recommended for Approval By: _____ Date: 11/19/2021
 Approved By: _____ Date: 11/23/2021

CITY OF BEAUMONT, CALIFORNIA
 IMPROVEMENT PLANS FOR:
BEAUMONT CROSSROADS LIFT STATION

CITY OF BEAUMONT, PUBLIC WORKS DEPARTMENT
 ENGINEERING DIVISION
 550E 6th St
 Beaumont, CA 92223
 TEL: (951) 769-8520 FAX: (951) 769-8526

SHEET 35 OF 38 SHEETS FILE NO: 3387

Plotted By: W\winthier, Sam - Sheet Set: BEAUMONT LIFT STATION Building Floorplan - October 20, 2021 10:51:18am K:\NSD_WATER\195284001 Beaumont Lift Station\DesignPlan Sheets - 2020 DELTA SET\195284001 - MF.dwg

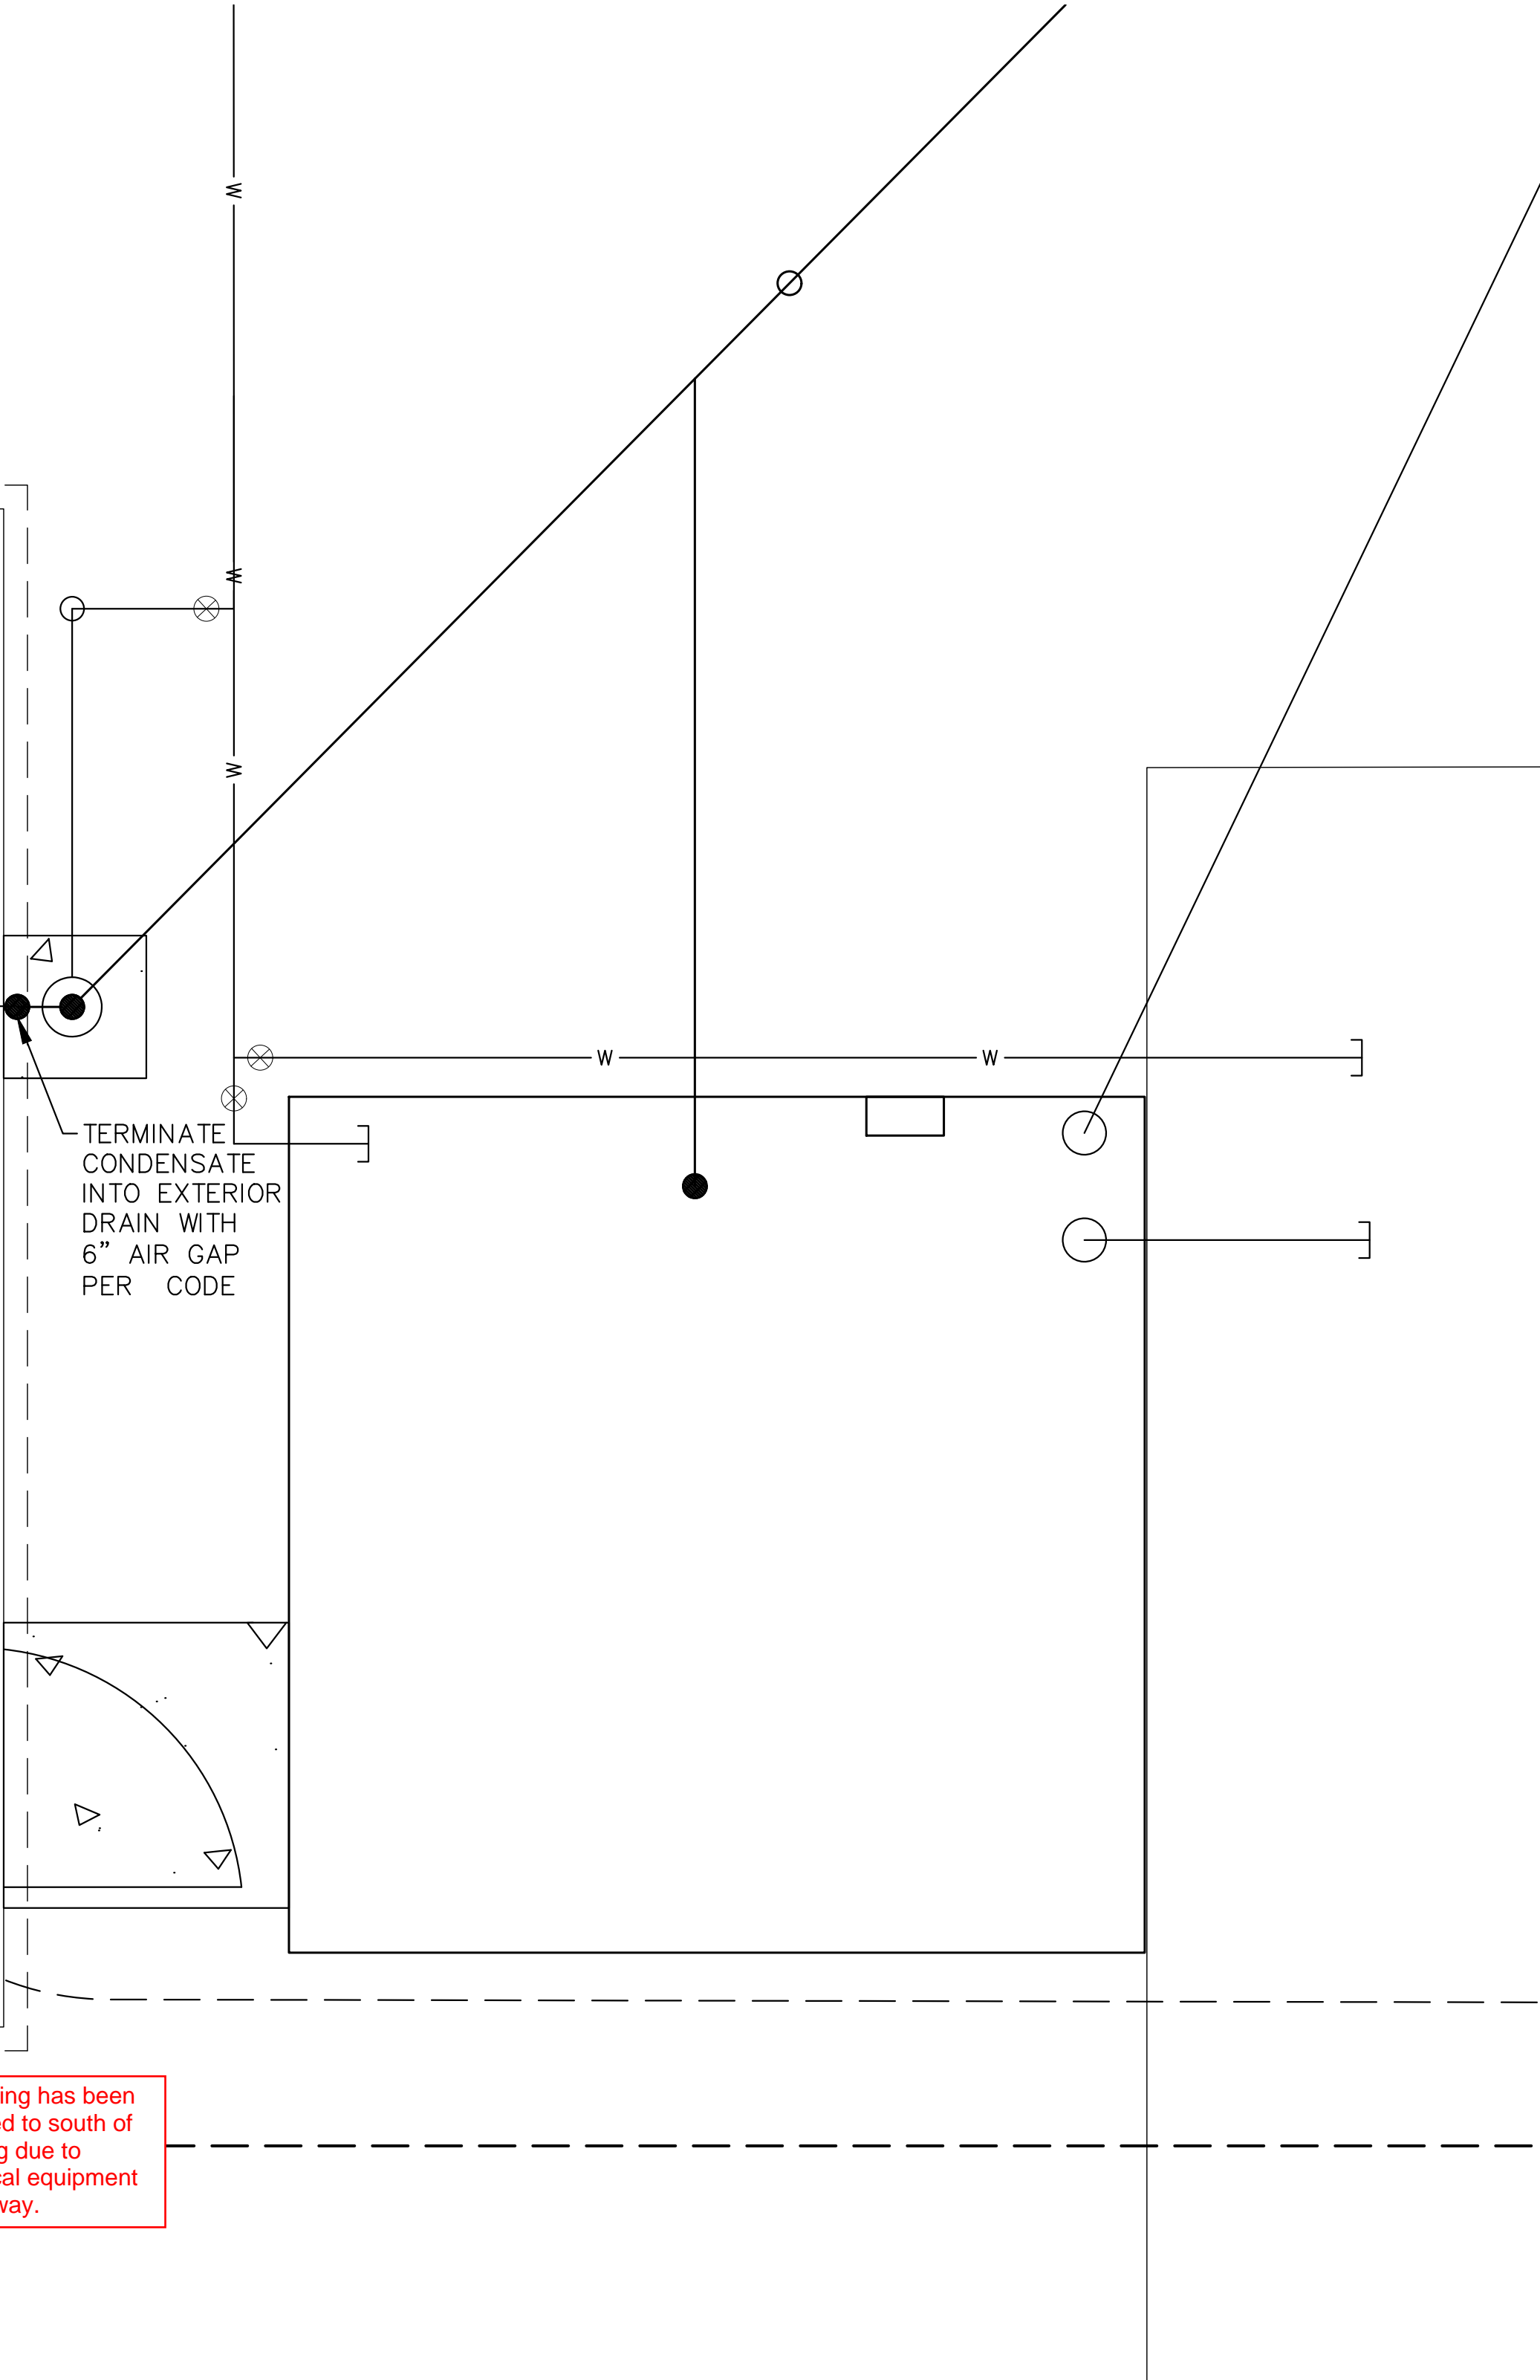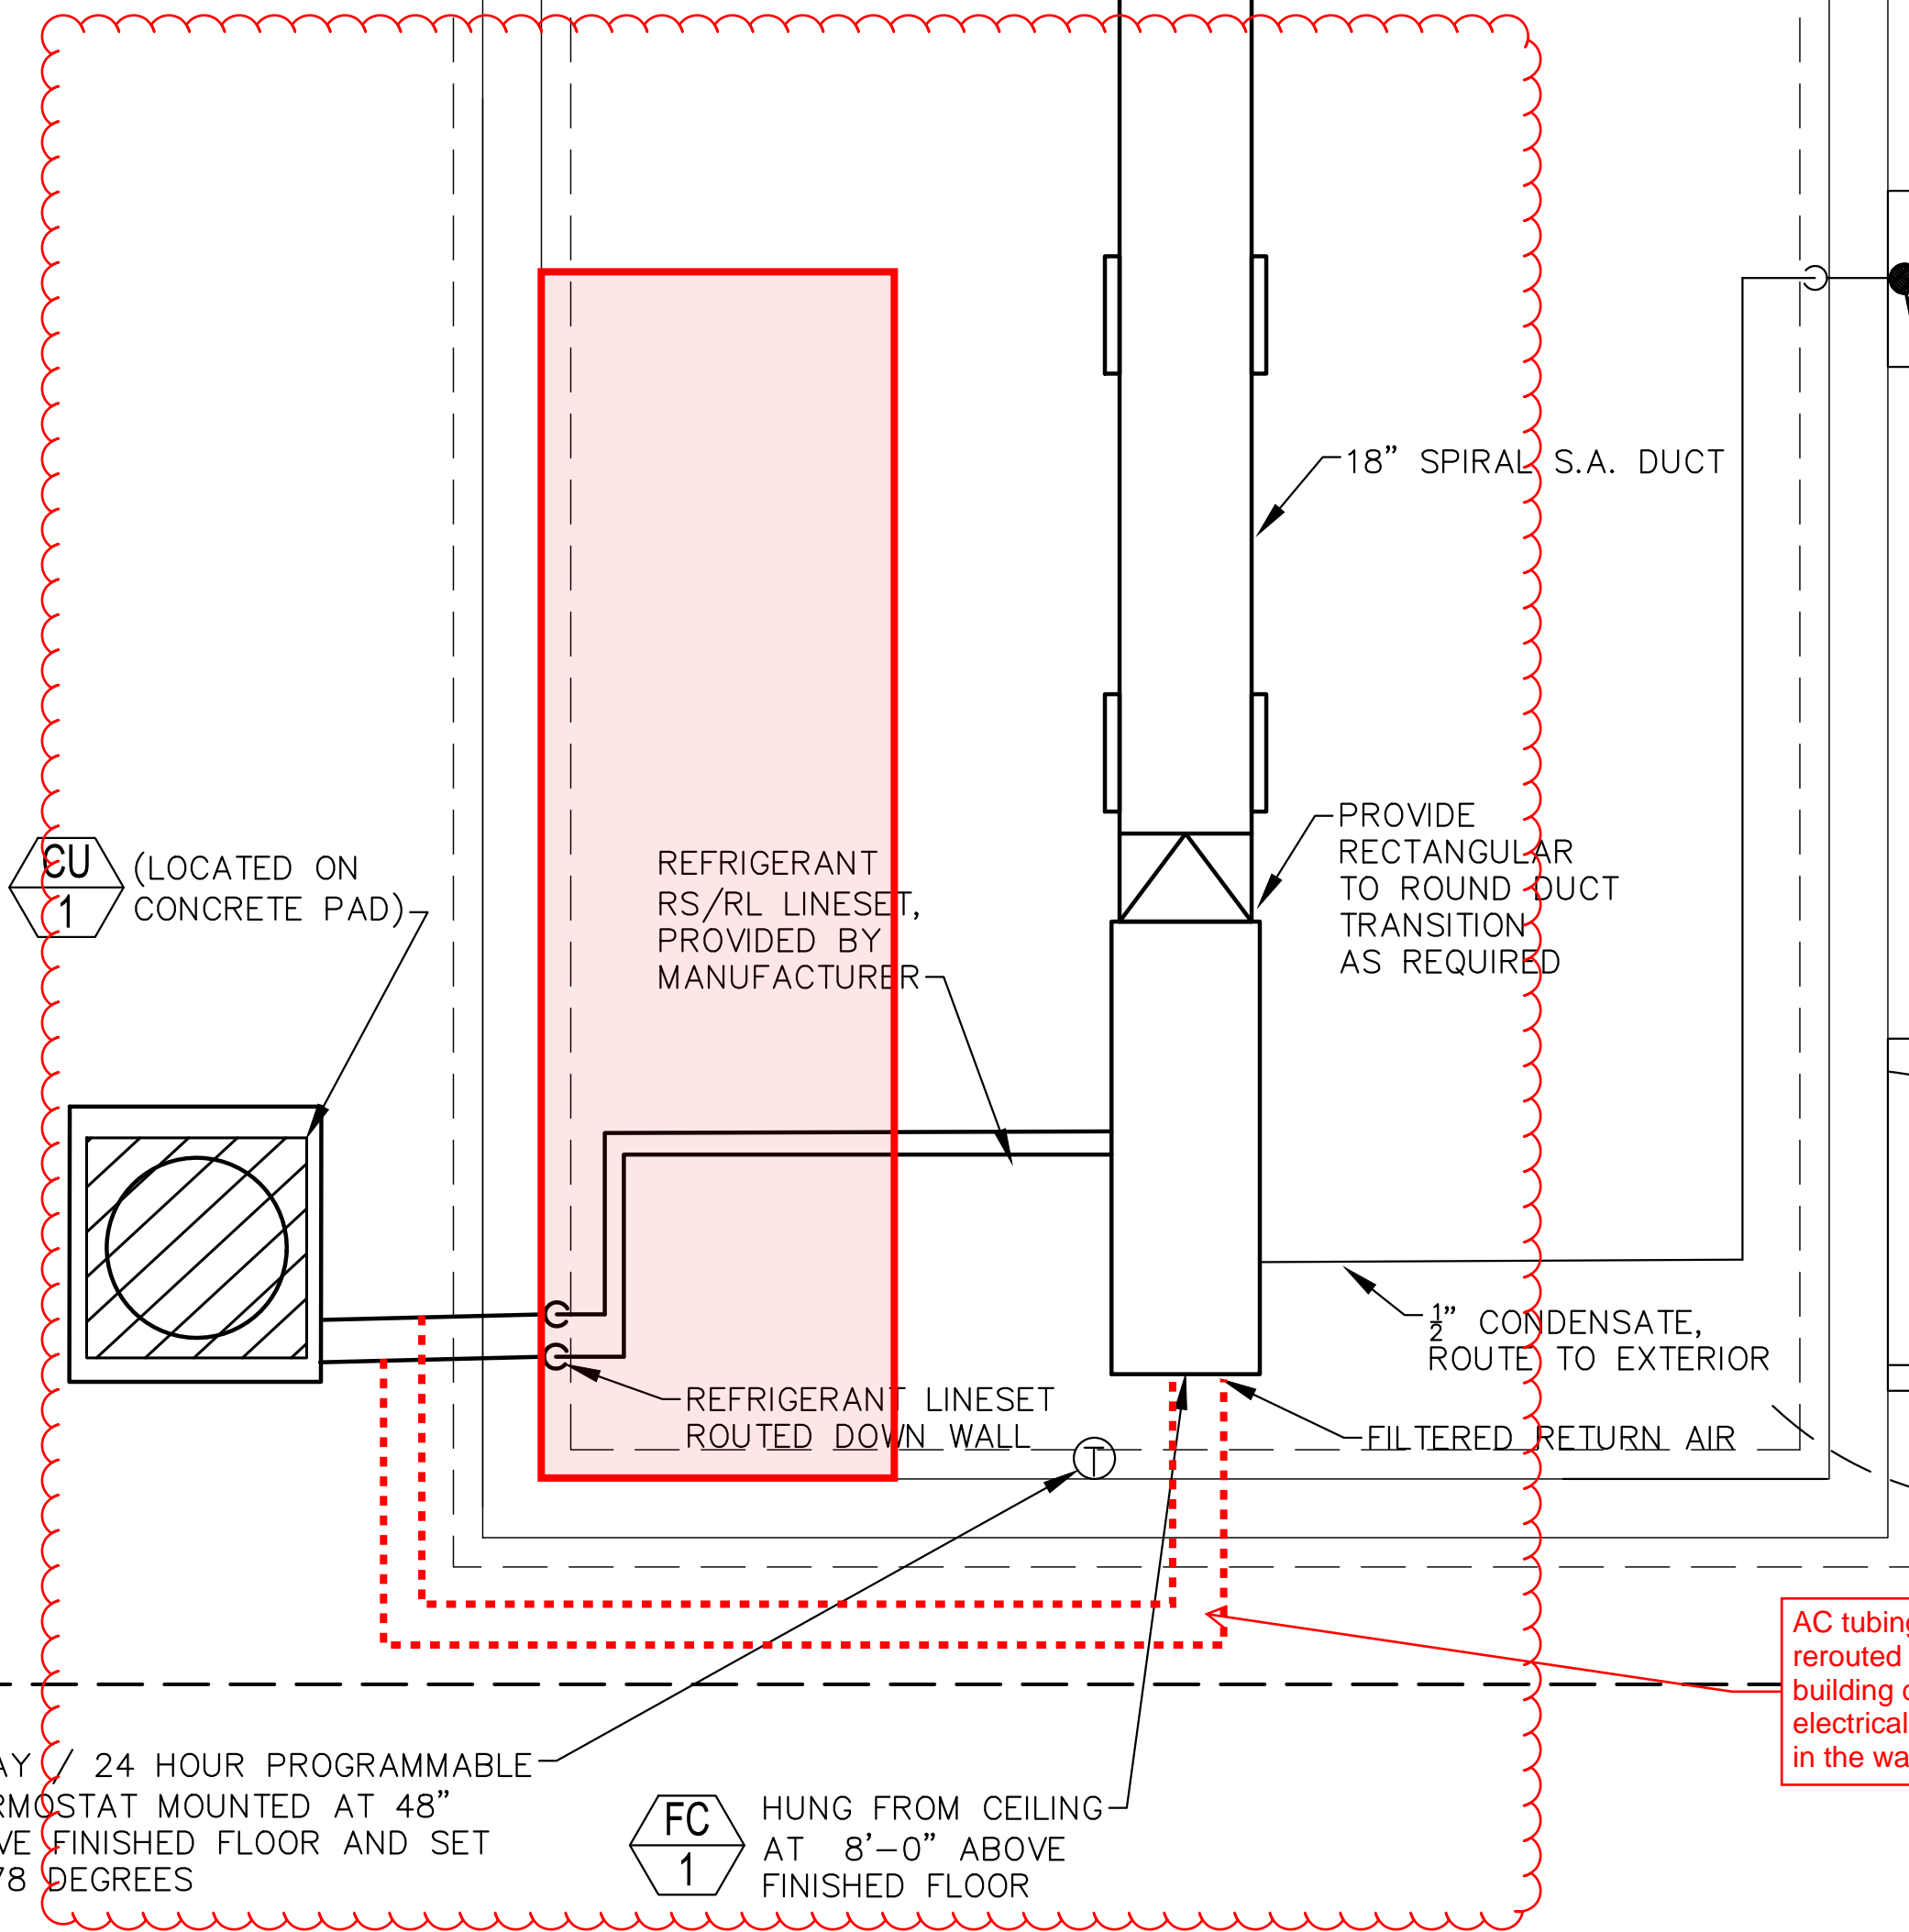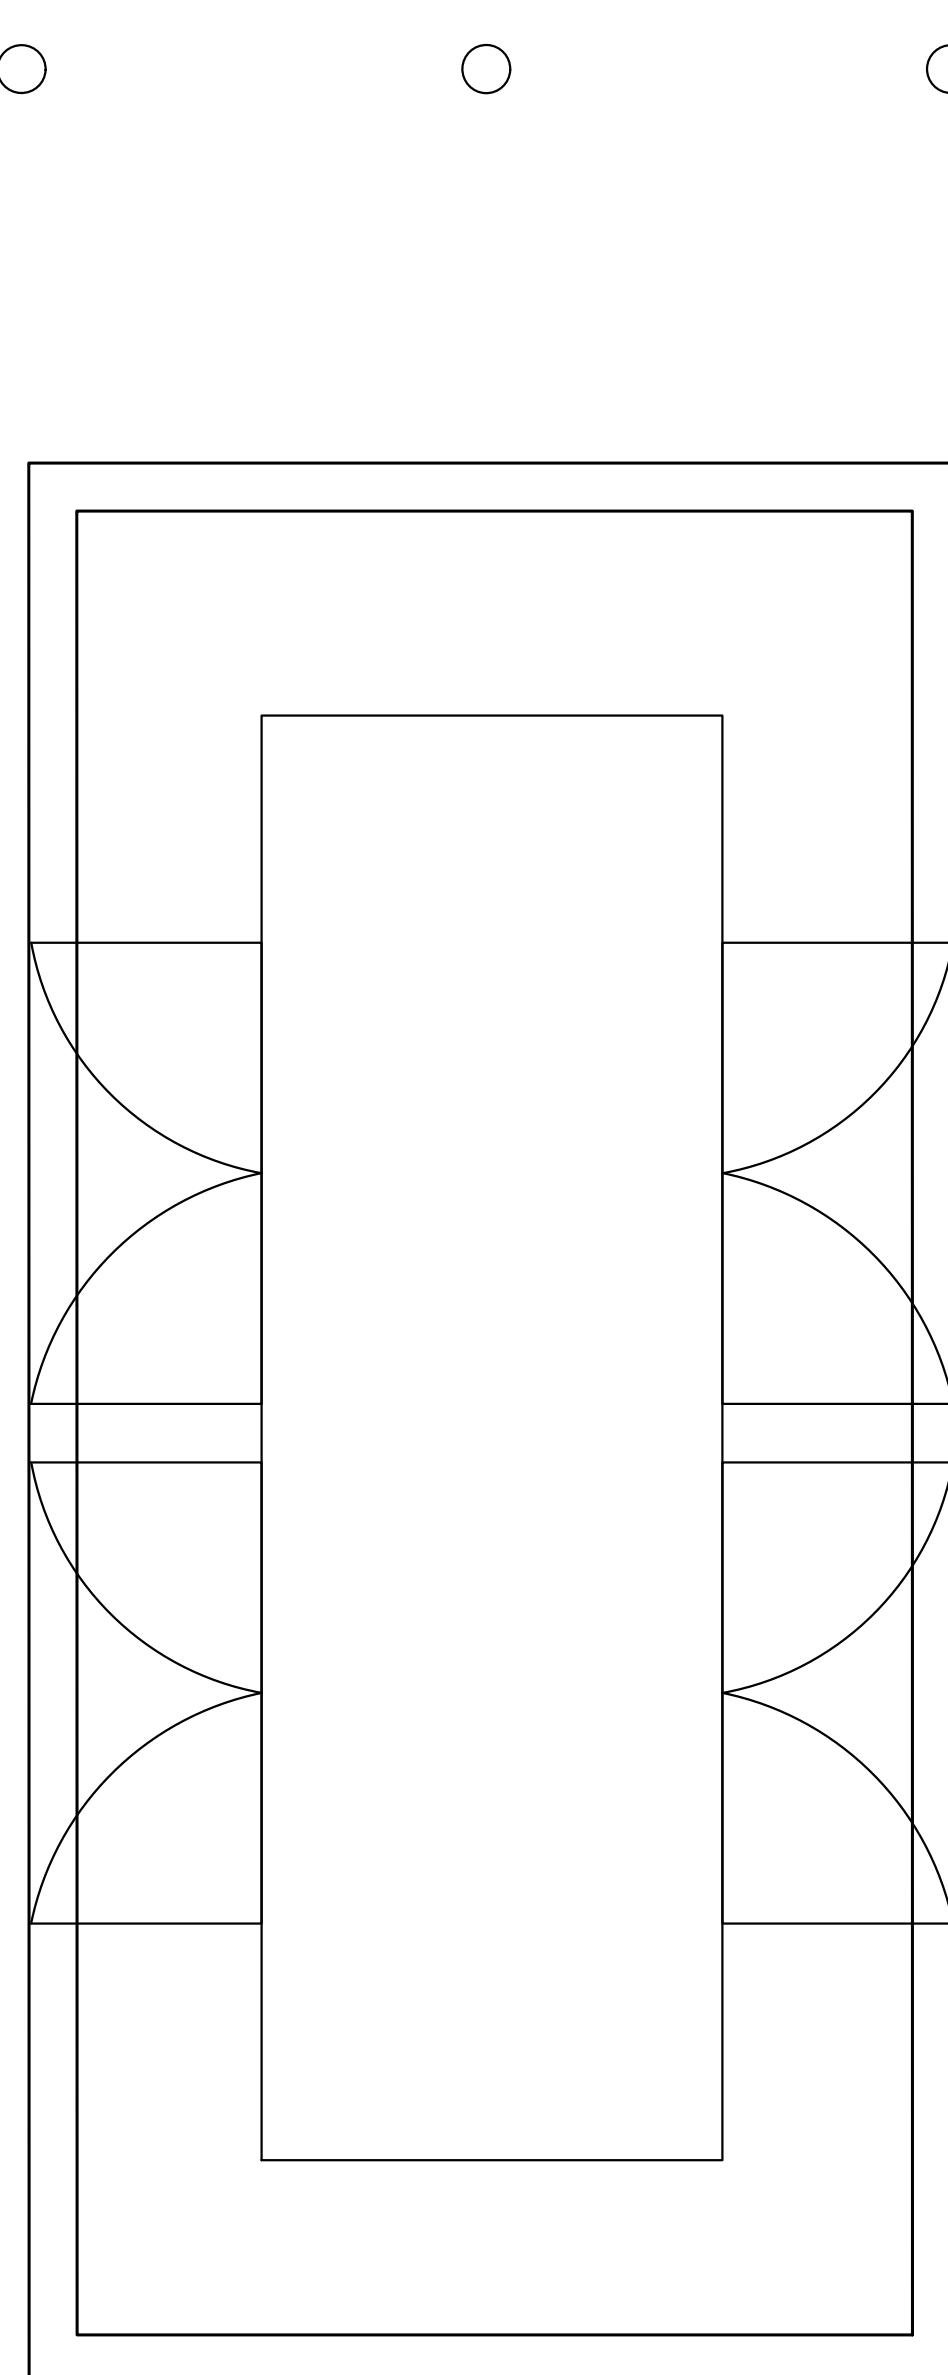



7 DAY / 24 HOUR PROGRAMMABLE THERMOSTAT MOUNTED AT 48" ABOVE FINISHED FLOOR AND SET AT 78 DEGREES

FC 1 HUNG FROM CEILING AT 8'-0" ABOVE FINISHED FLOOR

AC tubing has been rerouted to south of building due to electrical equipment in the way.

1 MCC BUILDING - MECHANICAL FLOOR PLAN

36 SCALE: 1/2" = 1'

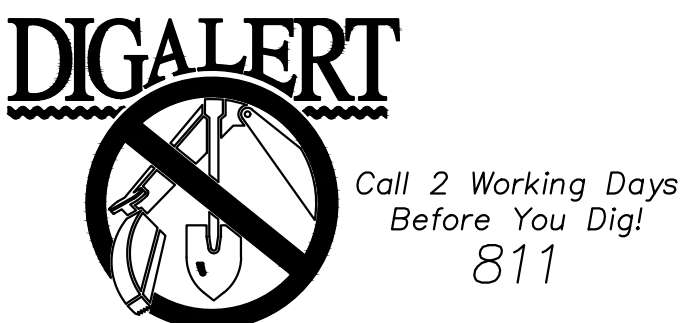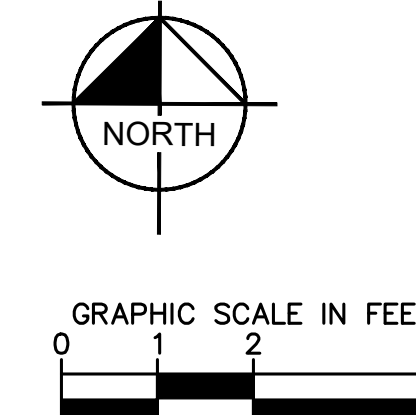

BENCHMARK:
NATIONAL GEODETIC SURVEY BENCHMARK NO. Q 1311
1.4 MILES WEST OF BEAUMONT ON INTERSTATE 10 TO SAN TIMOTEY CANYON NEAR FRONTAGE ROAD ON SOUTH(WEST) SIDE OF INTERSTATE 10, 0.1 MILES SOUTHWEST ALONG FRONTAGE ROAD, SOUTH ACROSS THE ROAD FROM A GUY POLE 25.9 FEET SOUTH OF THE CENTERLINE OF FRONTAGE ROAD, 1.8 FEET WEST OF POWERPOLE AND 1.8 FEET EAST OF A WITNESS POST, INSIDE A 4 INCH PVC PIPE WITH SCREW PLUG 1 INCH ABOVE GROUND (ELEVATION = 2468.07). ALSO SHOWN ON HIGHWAY 69 / POTRERO BLVD. INTERCHANGE STATIC GPS PROJECT CONTROL DIAGRAM AND IDENTIFIED THEREON AS 3538 BM D34374 WHEREIN THE PUBLISHED ELEVATION = 2468.07 IS CORRECTED WITH A MEASURED ELEVATION = 2468.01, USED HEREON.
ELEV. 2468.01, (NVD '88), (STAMPED Q 1311 1978)

BY	MARK	DESCRIPTION	APPR.	DATE
REVISIONS				
CITY				

Kimley»Horn
401 B Street, Suite 600, San Diego, CA 92101
Phone: (619) 234-9411
WWW.KIMLEY-HORN.COM
MATHIEW C. MYRES
R.C.E. 33152
8/23/2021




DESIGN BY: SLM
DRAWN BY: RC/SW
CHECKED BY: TW/SS
SCALE:
DATE:
JOB NUMBER: 195284001




Reviewed By: _____ Staff Engineer Date: _____
Recommended for Approval By: *[Signature]* Administrative Engineer Date: 11/19/2021
Approved By: *[Signature]* City Engineer/Director of Public Works Date: 11/23/2021
CITY OF BEAUMONT, PUBLIC WORKS DEPARTMENT
ENGINEERING DIVISION
550E 6th St
Beaumont, CA 92223
TEL: (951) 789-8520 FAX: (951) 789-8528

CITY OF BEAUMONT, CALIFORNIA
IMPROVEMENT PLANS FOR:
BEAUMONT CROSSROADS LIFT STATION
MECHANICAL FLOORPLAN


S H E E T
36
OF 38 SHEETS
FILE NO.: 3387

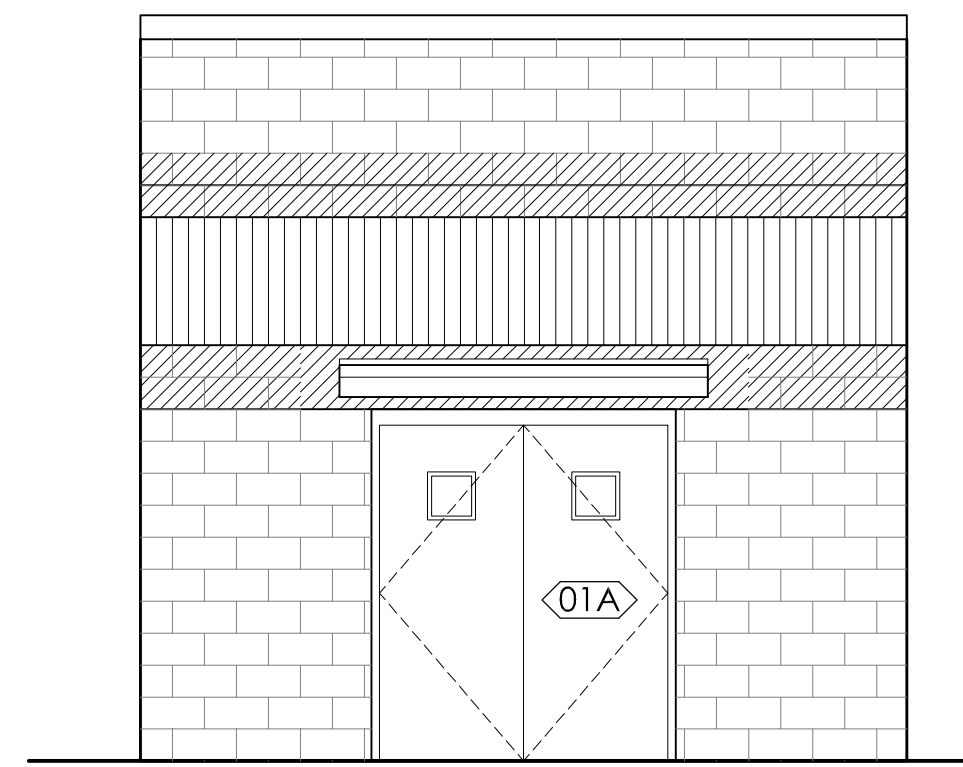


NORTH ELEVATION

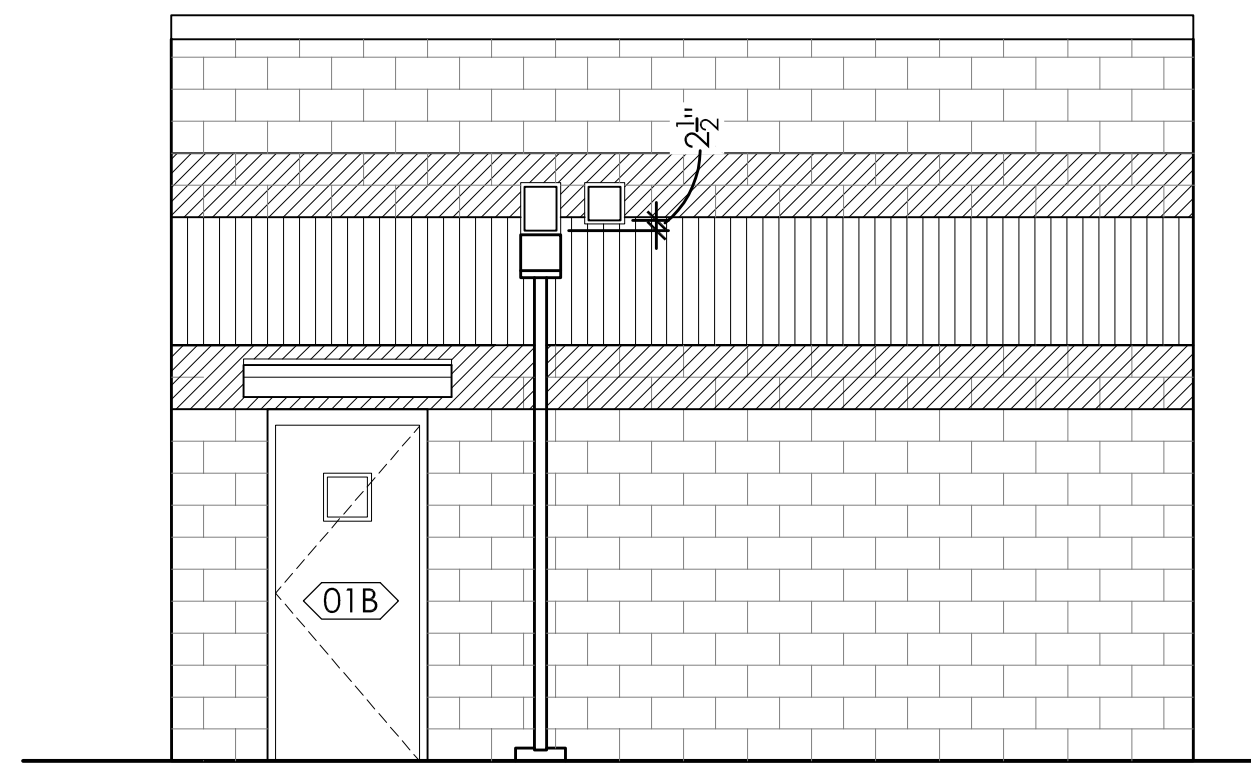

SOUTH ELEVATION

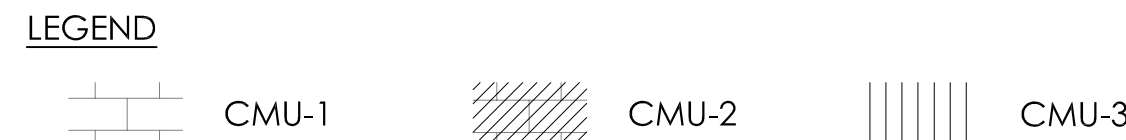


EXTERIOR FINISH ELEVATIONS

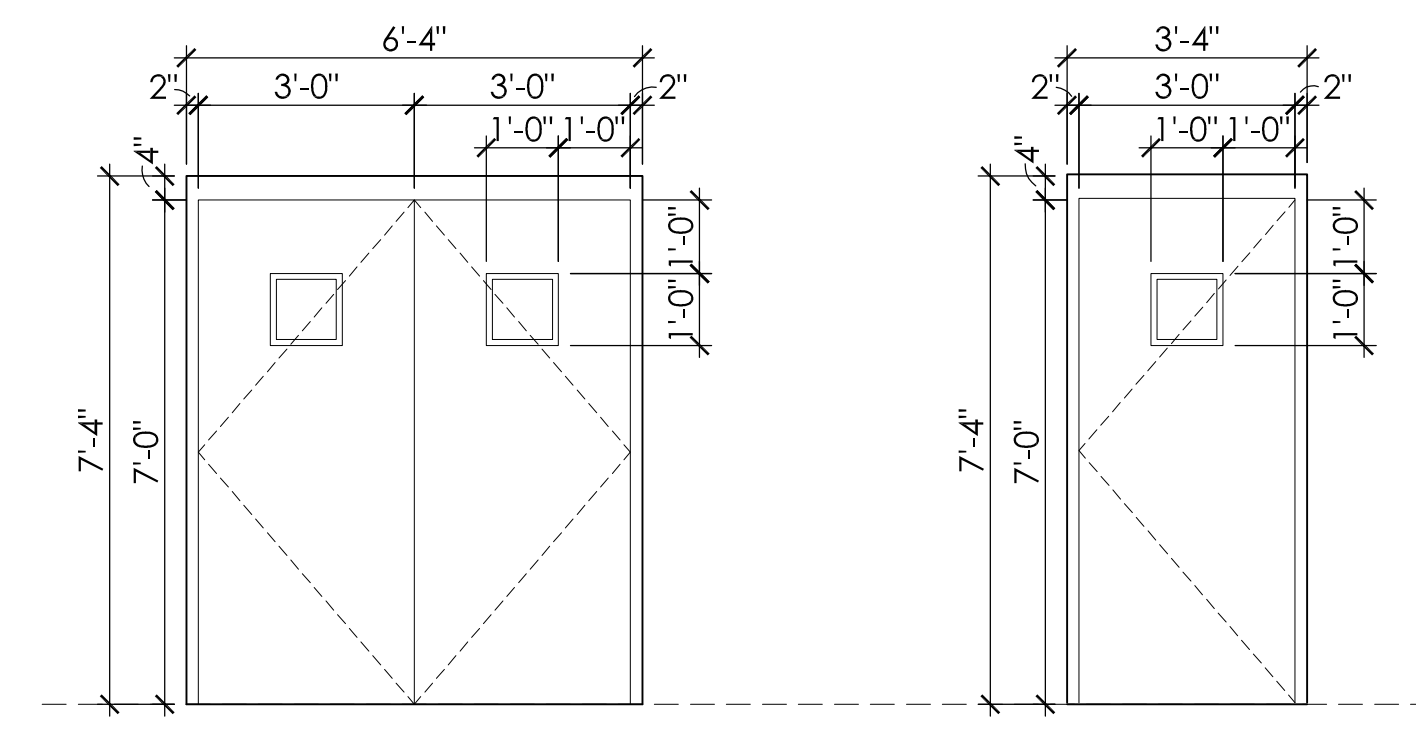

TYPE A HM PAIR WITH 1/2" CLEAR INSULATED LITE
TYPE B HM PAIR WITH 1/2" CLEAR INSULATED LITE

SCALE: 1/4" = 1'-0"

SCALE: 3/8" = 1'-0"

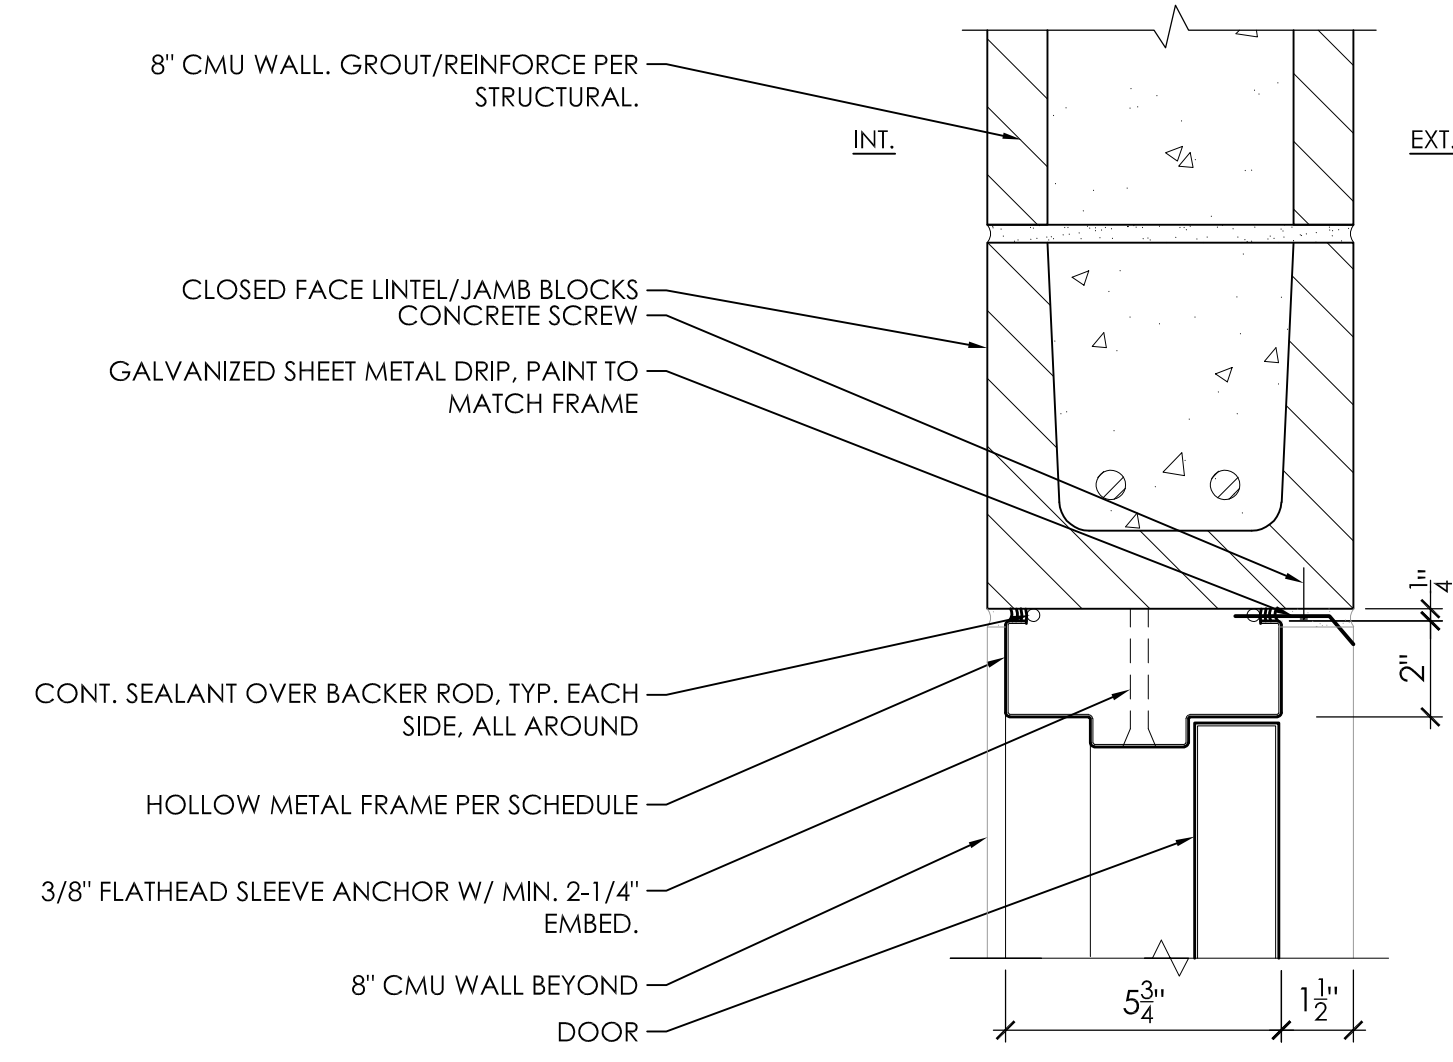

SCALE: 3" = 1'-0"

CODE	MATERIAL NAME	MANUFACTURER	PRODUCT	COLOR	SIZE	NOTES
CMU-1	SPLIT FACE CMU	ANGELUS BLOCK CO, INC.	-	SANDSTONE	8X8X16	PROVIDE ANTI-GRAFFITI COATING
CMU-2	PRECISION CMU	ANGELUS BLOCK CO, INC.	-	SANDSTONE	8X8X16	PROVIDE ANTI-GRAFFITI COATING
CMU-3	SPLIT RIBBED CMU - 4 RIB	ANGELUS BLOCK CO, INC.	-	SANDSTONE	8X8X16	PROVIDE ANTI-GRAFFITI COATING
PT-1	PAINT	SHERWIN WILLIAMS	-	SW 7548 PORTICO	-	DOORS, FRAMES, FLASHING, OVERHANG FRAME

DOOR SCHEDULE													
MARK	TYPE	DOOR			FRAME				FIRE RATING LABEL	HARDWARE SET #	COMMENTS		
		WIDTH	HEIGHT	THICKNESS	MAT.	FIN.	MAT.	FIN.				HEAD	JAMB
01A	1	6'-0"PR	7'-0"	1-3/4"	HM	PT-1	HM	PT-1	3/THIS SHEET	5/THIS SHEET	4/THIS SHEET	1	
01B	2	3'-0"	7'-0"	1-3/4"	HM	PT-1	HM	PT-1	3/THIS SHEET	5/THIS SHEET	4/THIS SHEET	2	

MANUFACTURER'S ABBREVIATIONS
 BE BEST ACCESS SYSTEMS/LOCKS, CYLINDERS
 NA NATIONAL GUARD GASKETS, THRESHOLDS
 ST STANLEY HINGES
 TR TRIMCO FLUSH BOLTS, FLAT GOODS

FINISH LIST
 628/652 SATIN CHROME
 630 SATIN STAINLESS STEEL
 689 PAINTED ALUMINUM

OPTION LIST
 B4E BEVELED FOUR EDGES - KICK PLATES (TRIMCO)
 CS COUNTER SINKING - KICK PLATES (TRIMCO)
 SSMS/EA STAINLESS MACHINE SCREWS/EXPANSION ANCHORS (NGP)
 SMS-TEKSELF-DRILLING MACHINE SCREWS (NGP)


DOOR HARDWARE SET 1 - EXTERIOR PAIR
 6 HINGES FBB199 1/2 X 4 1/2 NRP 630 ST
 2 FLUSH BOLTS 3917-12 626 TR
 1 LOCKSET 45H-7D15H PATD 626 BE
 2 CLOSER/STOP HD7016 SDS 689 BE
 2 KICK PLATE K0050 10" X 2" LDW B4E CS 630 TR
 1 DRIP CAP 16 A FHW SMS-TEKS NA
 1 GASKETING 700 NA SMS-TEKS NA
 1 ASTRAGAL GASKET 5040 B NA
 2 DOOR SWEEP 200 NA SMS-TEKS NA
 1 SADDLE THRESHOLD 426 SSMS/EA NA
 DO NOT CUT WEATHERSTRIP - TEMPLATE HARDWARE ACCORDINGLY. ASTRAGAL ON INACTIVE LEAF BY DOOR MANUFACTURER. VERIFY THRESHOLD APPLICATION.

DOOR HARDWARE SET 2 - EXTERIOR SINGLE
 3 HINGES FBB199 1/2 X 4 1/2 NRP 630 ST
 1 LOCKSET 45H-7D15H PATD 626 BE
 1 CLOSER/STOP HD7016 SDS 689 BE
 1 KICK PLATE K0050 10" X 2" LDW B4E CS 630 TR
 1 DRIP CAP 16 A FHW SMS-TEKS NA
 1 GASKETING 700 NA SMS-TEKS NA
 1 DOOR SWEEP 200 NA SMS-TEKS NA
 1 SADDLE THRESHOLD 426 SSMS/EA NA
 DO NOT CUT WEATHERSTRIP - TEMPLATE HARDWARE ACCORDINGLY. VERIFY THRESHOLD APPLICATION.

DOOR HARDWARE NOTES:

- Provide hardware for all openings, whether specified or not, in compliance with NFPA Standard No. 80, proper operation and local building code requirements. Where required, provide only hardware which has been tested and listed by UL or FM for types and sizes of doors required and complies with requirements of door and door frame labels. Label hardware, as required, for compliance with pressure testing criteria as dictated in IBC.
- Provide hardware which meets or exceeds handicap accessibility per local building code requirements. Conform to the Americans with Disabilities Act (ADA) of 1990 as amended by the D.O.J. September 15, 2010, as adopted by the Authority Having Jurisdiction (AHJ).
- Base Metals: Produce hardware units of basic metal and forming method indicated, using manufacturer's standard metal alloy, composition, temper and hardness, but in no case of lesser (commercially recognized) quality than specified for applicable hardware units by applicable ANSI A156 series standard for each type hardware item and with ANSI A156.18 for finish designations indicated. Do not furnish "optional" materials or forming methods for those indicated, except as otherwise specified.
- Fasteners: Provide hardware manufactured to conform to published templates, generally prepared for machine screw installation. Do not provide hardware which has been prepared for self tapping sheet metal screws, except as specifically indicated.
 - Screws: Furnish screws for installation, with each hardware item. Provide Phillips flat head screws except as otherwise indicated. Finish exposed (exposed under any condition) screws to match hardware finish or, if exposed in surfaces of other work, to match finishes of such other work as closely as possible, including "prepared for paint" in surfaces to receive painted finish.
 - Concealed Fasteners: Provide concealed fasteners for hardware units which are exposed when door is closed, except to extent no standard units of type specified are available with concealed fasteners. Do not use thru-bolts for installation where bolt head or nut on opposite face is exposed in other work, except where it is not feasible to adequately reinforce the work. In such cases, provide sleeves for each thru-bolt or use sex screw fasteners.
- Hinges: Manufacturer - Stanley; Substitutions - Hager, McKinney. Provide only template produced units. Furnish Phillips flat head or machine screws for installation of units. Finish screw heads to match surface of hinges.
- Lock cylinders: Manufacturer - Best Cormax Patented; Approved Substitutions - Match existing system - coordinate with the City of Beaumont. All lock cylinders shall be equipped with 7-pin tumbler small format interchangeable core lock cylinders. The interchangeable core shall be removable by a special control key. The control key shall have no cuts in common with grandmaster keys which operate with a shear line completely independent from the shear line of the grandmaster, master, and operating keys. All cores shall have a special limited keyway and shall be removable without removing the cylinder, knob, or core housing of any type lock or lockset. The removable core shall be instantly interchangeable without modification for use in any lock throughout the system. Provide brass construction cores for the construction period. Plastic construction cores are not acceptable. Construction cores shall remain the property of the hardware supplier and will be returned upon incorporation of the permanent key system. Cylinders shall utilize the manufacturer's patented Cormax keyway. Construct lock cylinder parts from brass/bronze, stainless steel, or nickel silver.
- Keys, keying, and key control: Provide keys of nickel silver only. Deliver keys to the Owner's representative. Send masterkeys to Owner via U.S. registered mail direct from hardware supplier. Comply with Owner's written instructions for masterkeying and, except as otherwise indicated, provide individual change keys for each lock which is not designated to be keyed alike with a group of related locks. Grandmaster key all cylinder items to coordinate with the Owner's new patented masterkey system. Permanently inscribe each key with the notation "DO NOT DUPLICATE". Provide cylinder units with concealed key control and keys with visual key control.

- Locksets, latchsets, and privacy sets: Manufacturer - Best 45H; Substitutions - Dorma M9000. Provide manufacturer's standard wrought box strike for each latch or lock bolt. Provide dust-proof strikes for foot bolts, except where not available. At these locations, provide manufacturer's standard recessed strike. Provide roller type strikes where recommended by lock, latch or bolt manufacturer. Provide 3/4" minimum throw of mortise type latches and deadbolts used. Cylindrical latches will be 1/2" minimum. Comply with UL requirements for throw of bolts and latch bolts on rated fire openings. Locks and latches shall be warranted for a period of five years.
- Closers: Manufacturer - Best HD7016; Substitutions - Stanley QDC100. Except as otherwise specifically indicated, comply with the manufacturer's recommendations for size of door control unit, depending on the size of the door, exposure to weather and anticipated frequency of use. Provide manufacturer's standard through bolt attachment at all applications. Provide parallel arms for all overhead closers, except as otherwise indicated. Provide drop plates as needed to prevent glazing interference. Mount all closers to the maximum allowable degree of opening by the closer manufacturer's template. Where closer arms incorporate dead stop features, mount closers to the maximum degree of opening available before conflict with adjacent structures. If not apparent on the contract documents, verify the use of open space with the Architect or Owner's Representative to determine the maximum allowable degree of opening. Door closers and related hardware shall be warranted for a period of twenty-five years.
- Protection plates: Manufacturers - Trimco; Substitutions - Hager, Tice. Provide manufacturer's standard exposed and countersunk Phillips head fasteners for door trim units; either machine screws or self tapping sheet metal type screws per manufacturer's recommendations for application to the specified door construction. Fabricate protection plates (armor, kick or mop) not more than 2" less than door width on stop side and not more than 1" less than door width on pull side, by the height indicated. Stainless Steel, 18 gauge (0.050) thick. Satin finish, US32D (630), beveled four edges (B4E).
- Gaskets and sweeps: Manufacturer - National Guard; Substitutions - Pemko, Reese. Except as otherwise indicated, provide continuous weatherstripping at each edge of every exterior door leaf. Provide non-corrosive fasteners as recommended by the manufacturer for applications indicated. Replaceable seal strips: Provide only those units where resilient or flexible seal strip is easily replaceable and readily available from stocks maintained by the manufacturer. Perimeter weatherstripping: Flexible, hollow neoprene bulb or loop insert, conforming to MIL R 6055, Class II, Grade 40. Where two types of perimeter gaskets are specified, apply them not to conflict and per gasket manufacturer's recommendations. Weatherstripping at Door Bottoms: Provide door bottoms consisting of contact type resilient insert and metal housing of design and size indicated. Gaskets and sweeps shall be warranted for a period of three years.
- Thresholds: Manufacturer - National Guard; Substitutions - Pemko, Reese. Except as otherwise indicated provide standard metal threshold unit of type, size and profile as detailed or scheduled. All thresholds will be supplied with the SIA abrasive finish unless noted otherwise. Where there is conflict between scheduled thresholds and details, details shall have precedence. Revise details only if necessary to comply with handicap accessibility requirements. Notify the Architect of such required modifications. Verify threshold details or conditions at all openings to ensure that the openings receive proper applications for weather seal or floor transition whether specified or not. Thresholds and related items shall be warranted for a period of three years, abrasive coatings shall be warranted for a period of ten years.

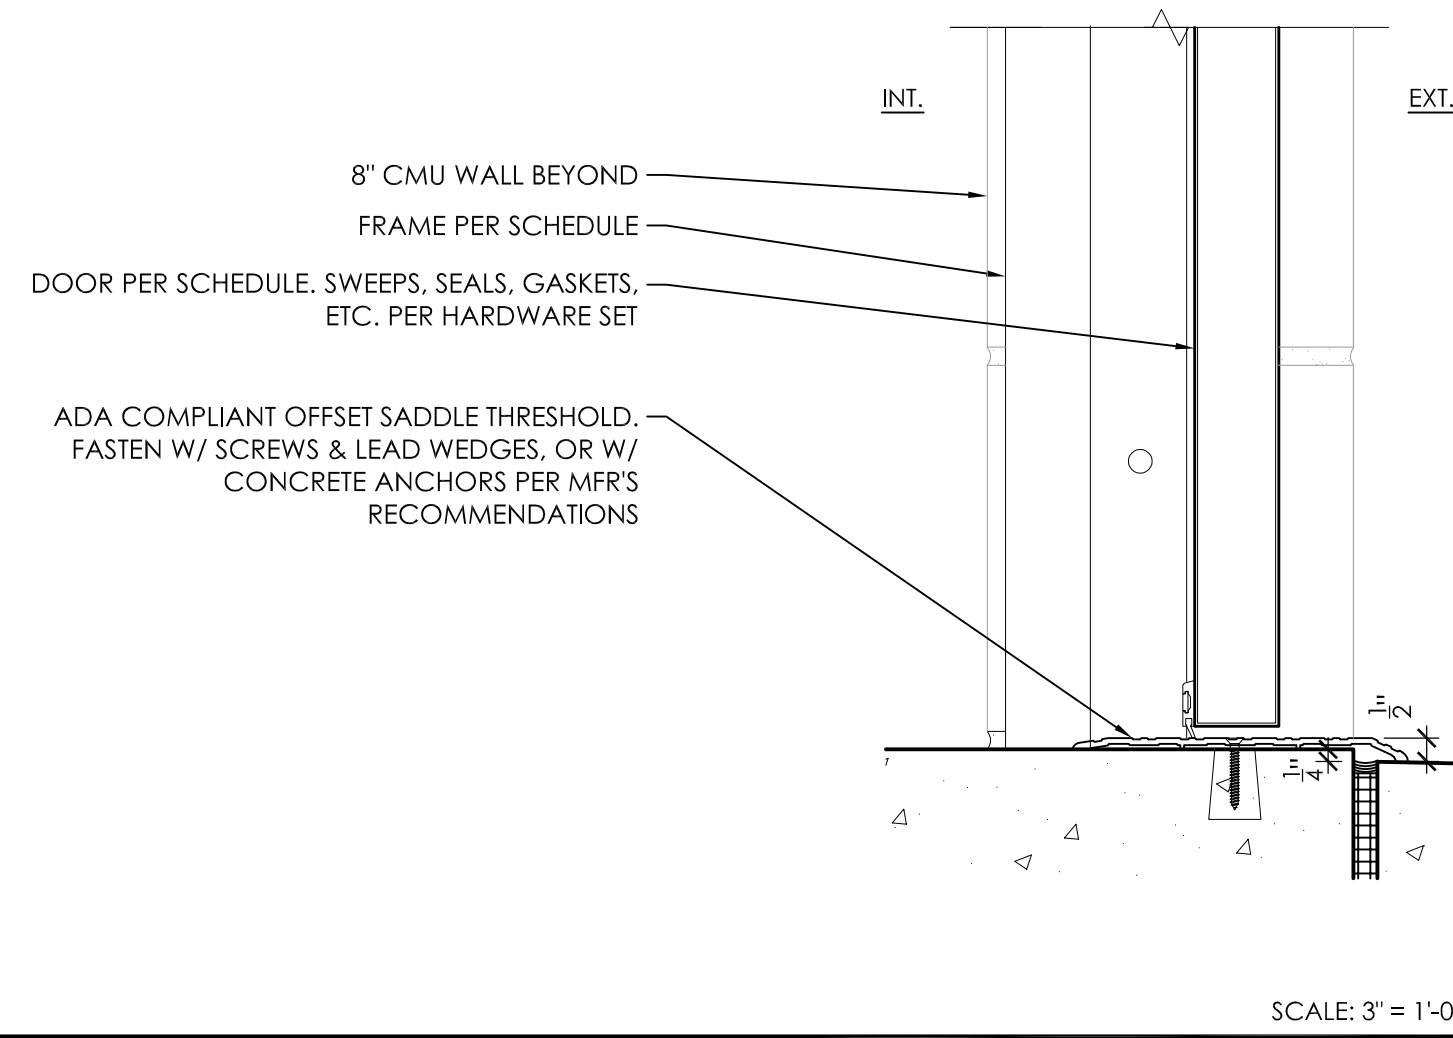

SCALE: 3" = 1'-0"

BENCHMARK:
 NATIONAL GEODEIC SURVEY BENCHMARK NO. 1311
 1.4 MILES WEST OF BEAUMONT ON INTERSTATE 10 TO SAN TIMOTEO CANYON NEAR FRONTAGE ROAD ON SOUTH(WEST) SIDE OF INTERSTATE 10, 0.1 MILES SOUTHWEST ALONG FRONTAGE ROAD, SOUTH ACROSS THE ROAD FROM A GUY POLE 25.9 FEET SOUTH OF THE CENTERLINE OF FRONTAGE ROAD, 1.8 FEET WEST OF POWERPOLE AND 1.5 FEET EAST OF A WITNESS POST, INSIDE A 4 INCH PVC PIPE WITH SCREEN PLUS 1 INCH ABOVE GROUND (ELEVATION = 2468.07). ALSO SHOWN ON "HIGHWAY 60 / POTRERO BLVD. INTERCHANGE STATIC GPS PROJECT CONTROL DIAGRAM" AND IDENTIFIED THEREON AS 3508 BM D94274 WHEREIN THE PUBLISHED ELEVATION = 2468.07 IS CORRECTED WITH A MEASURED ELEVATION = 2468.01, USED HEREON.
 ELEV. 2468.01, (NVD '88), (STAMPED Q 1311 1978)

BY	MARK	DESCRIPTION	APPR.	DATE
ENGINEER		REVISIONS		CITY

Platt/Whitelaw Architects, Inc.
 4034 30TH STREET
 SAN DIEGO, CALIFORNIA 92104

DESIGN BY: SLM
 DRAWN BY: RC/SW
 CHECKED BY: TW/SS
 SCALE: 1/4" = 1'-0"
 DATE: 11/19/2021
 JOB NUMBER: 195284001

Reviewed By: _____ Date: _____
 Recommended for Approval By: _____ Date: 11/19/2021
 Approved By: _____ Date: 11/23/2021



CITY OF BEAUMONT, PUBLIC WORKS DEPARTMENT
 ENGINEERING DIVISION

CITY OF BEAUMONT, CALIFORNIA
 IMPROVEMENT PLANS FOR:
 BEAUMONT CROSSROADS LIFT STATION


37 OF 38 SHEETS
 FILE NO: 3387

FINISHES AND DOORS


Plotted By: Kvelov, Sheet Set: BEAUMONT LIFT STATION, Layout: A1 Finishes and Doors, August 12, 2021, 12:29:56pm, J:\0111 Beaumont Lift Station\03-Drawings\Beaumont Lift Station\Sheets\A1 Finishes and Doors.dwg

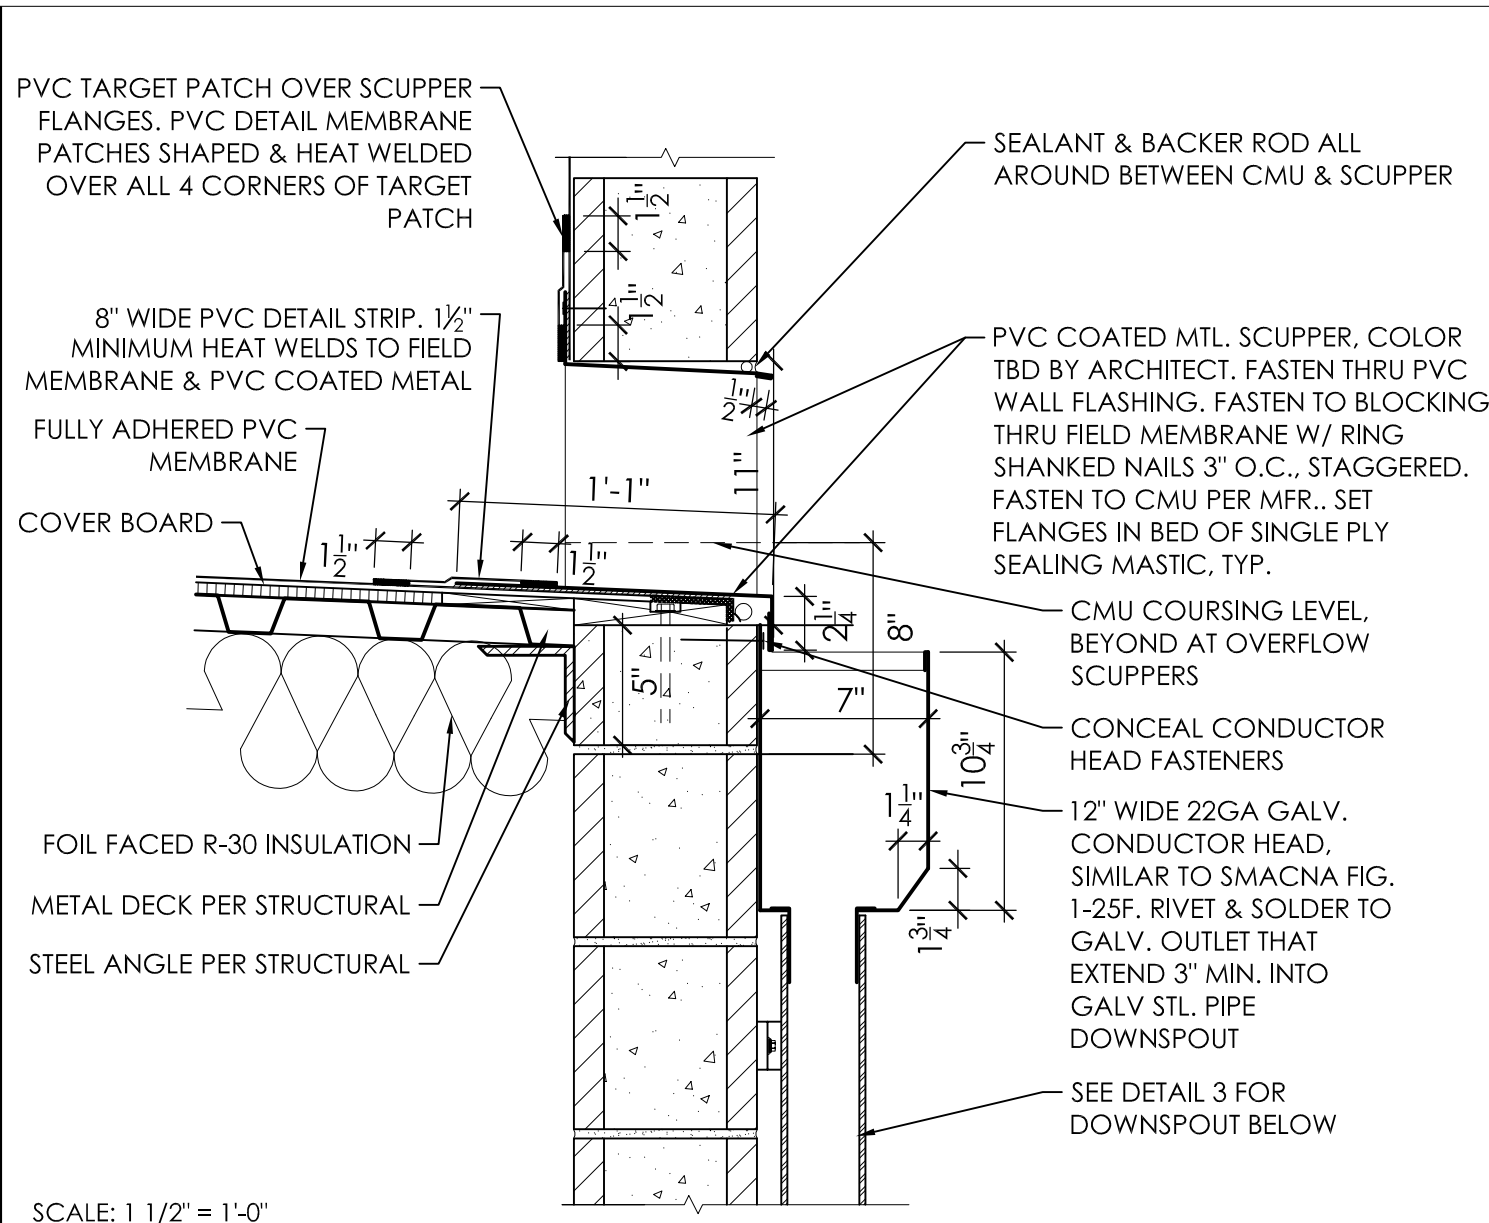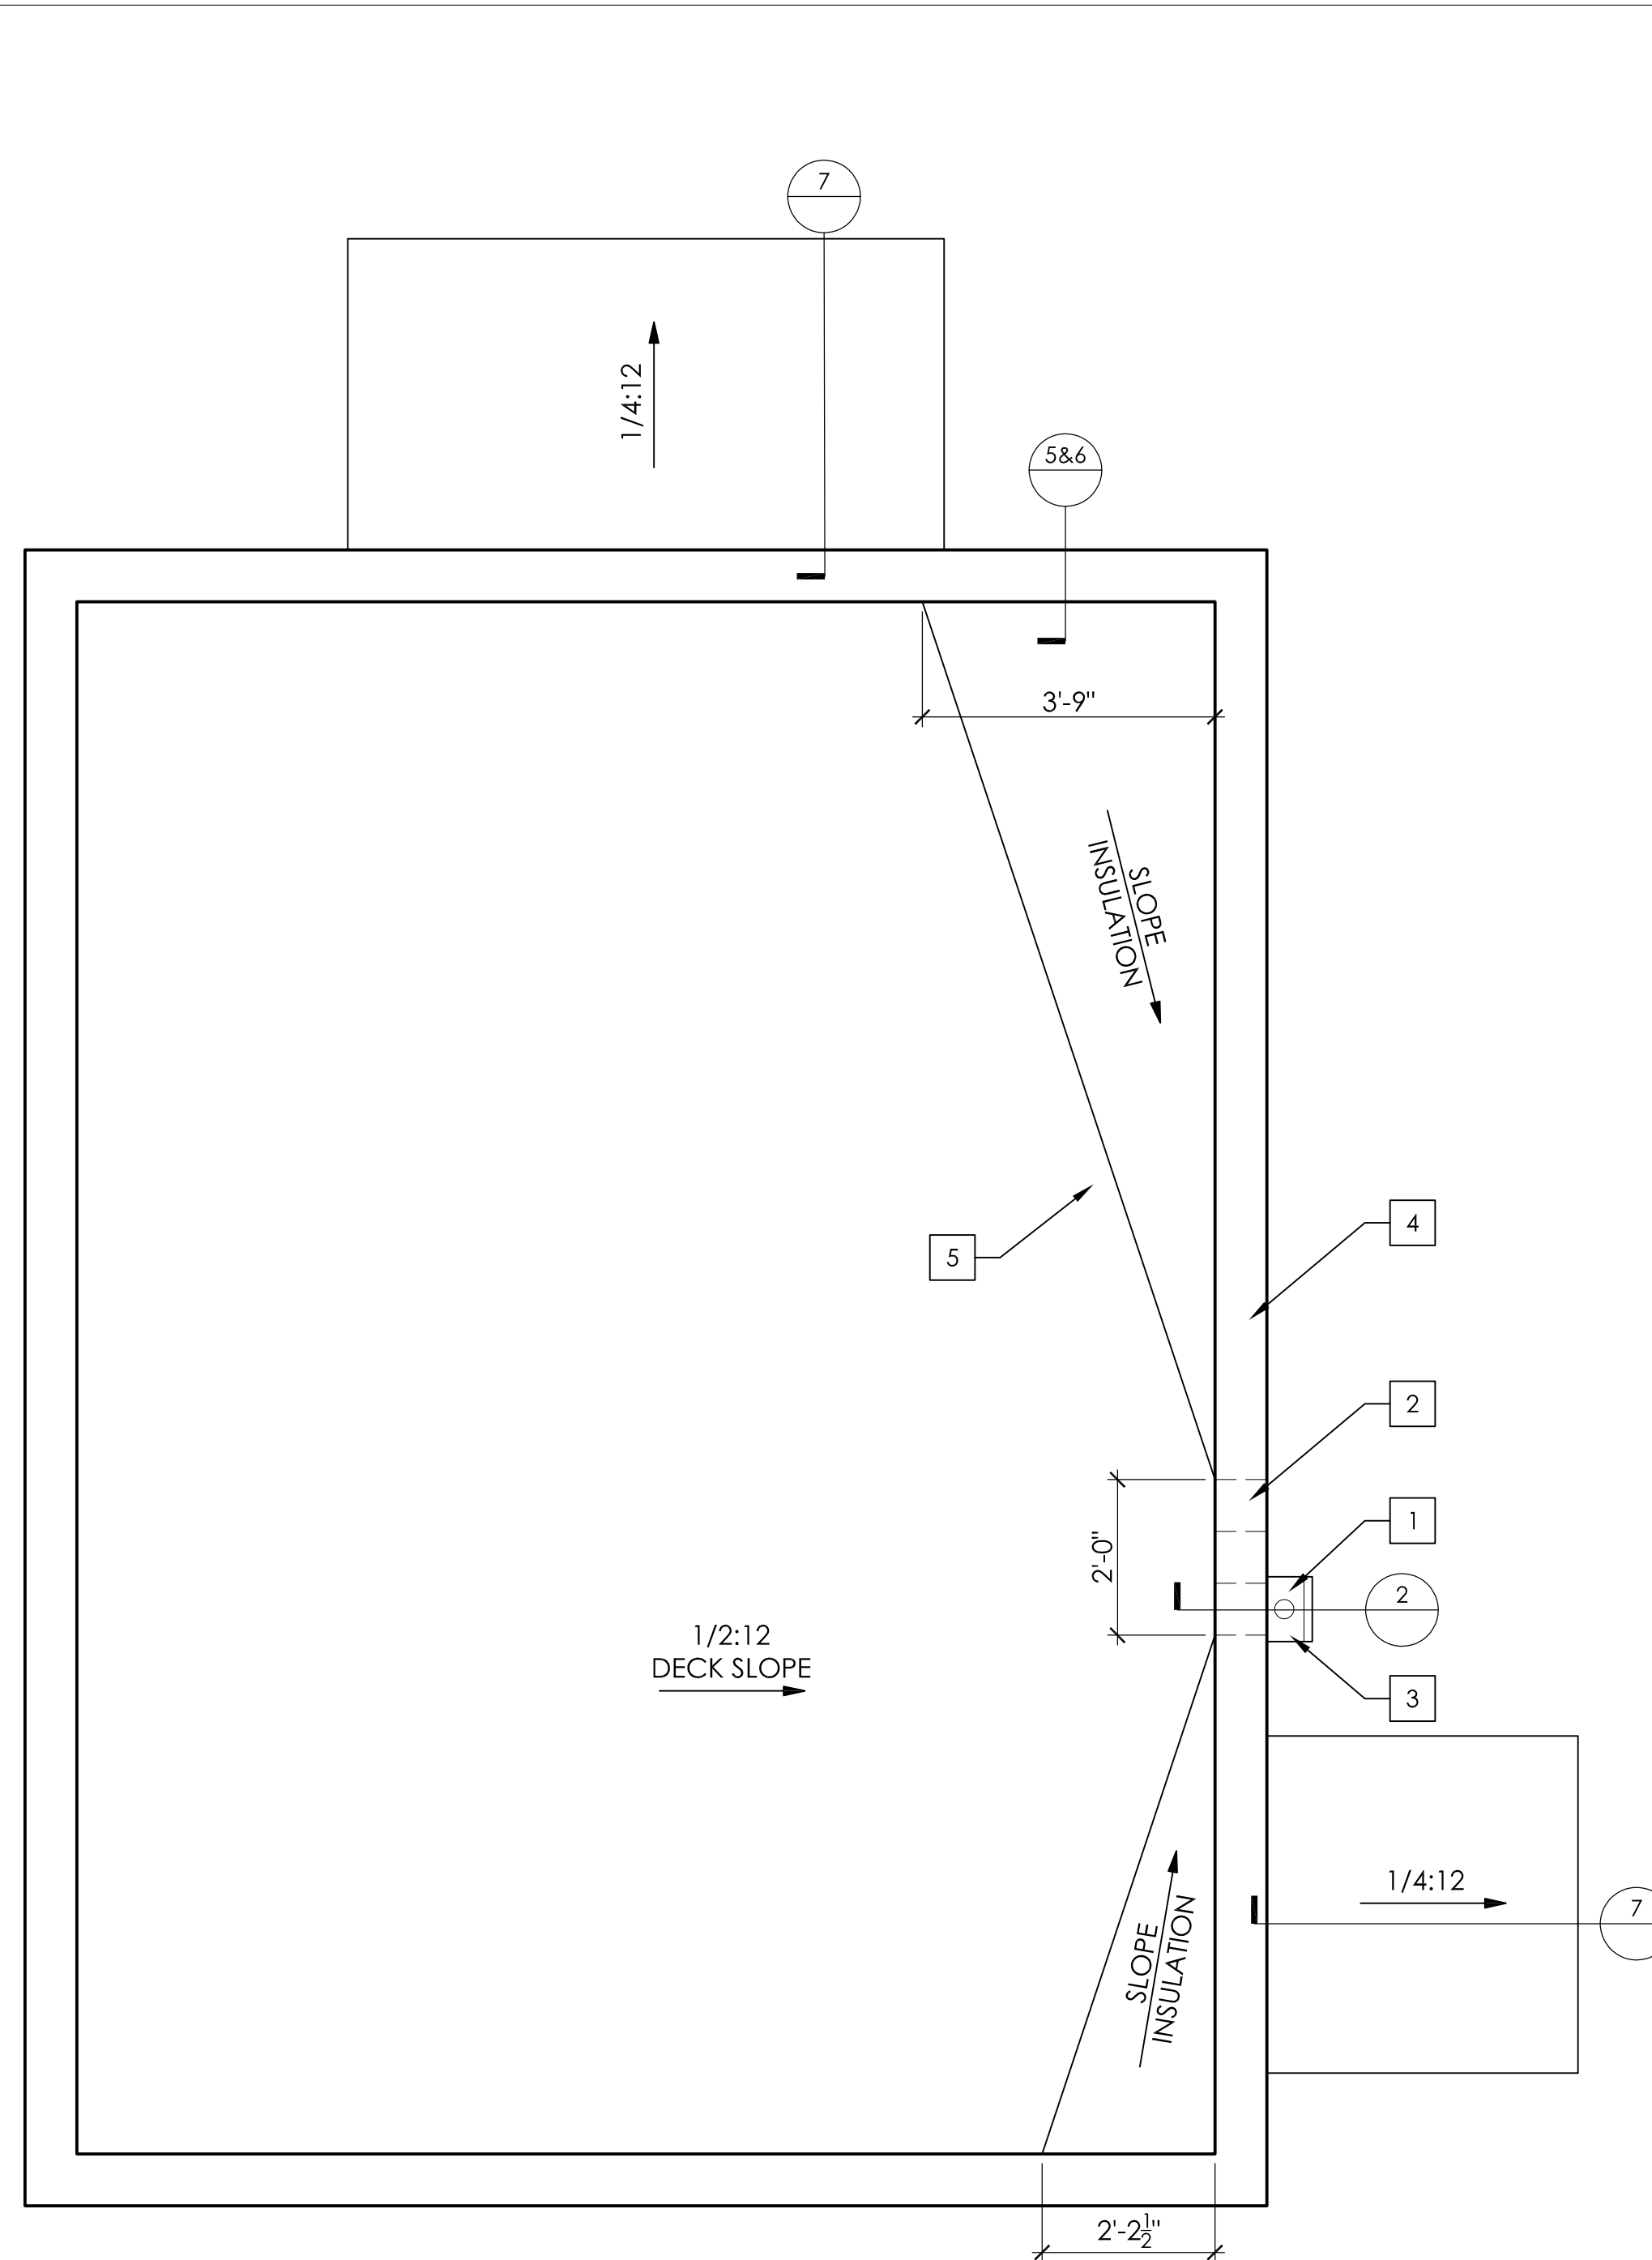


1 SCUPPER DETAIL (OVERFLOW SIMILAR)

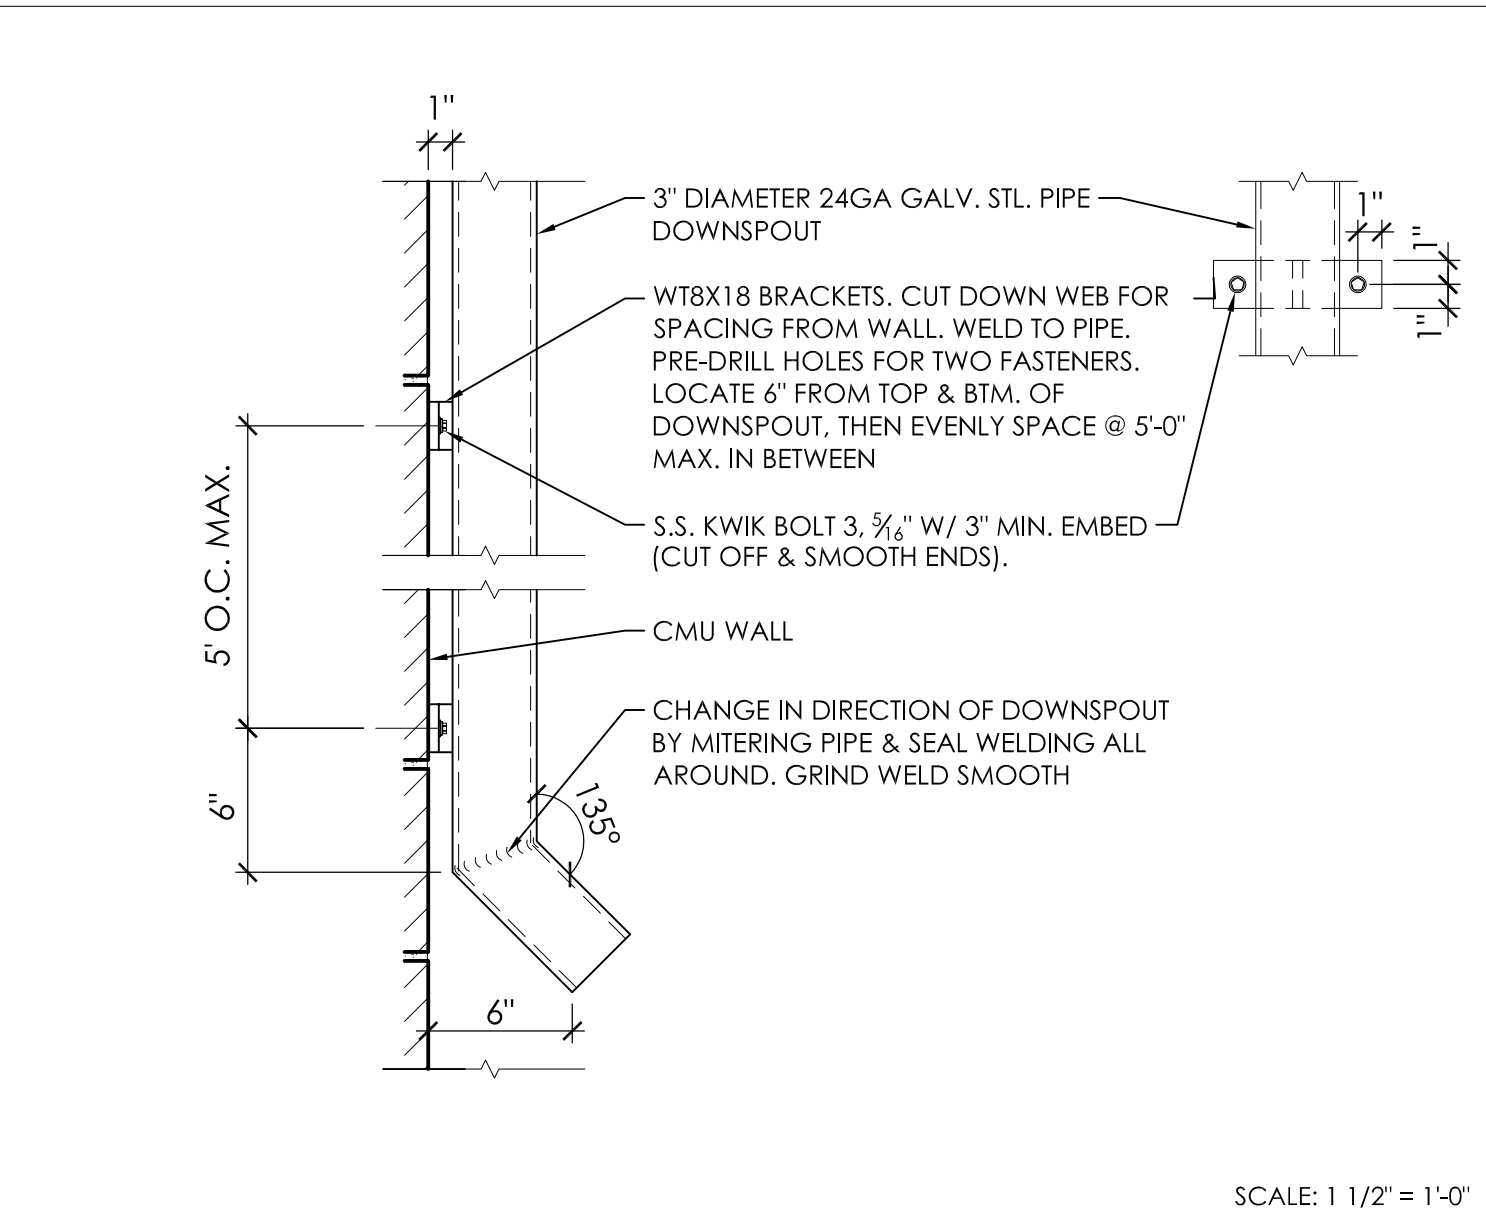


2 DOWNSPOUT DETAIL

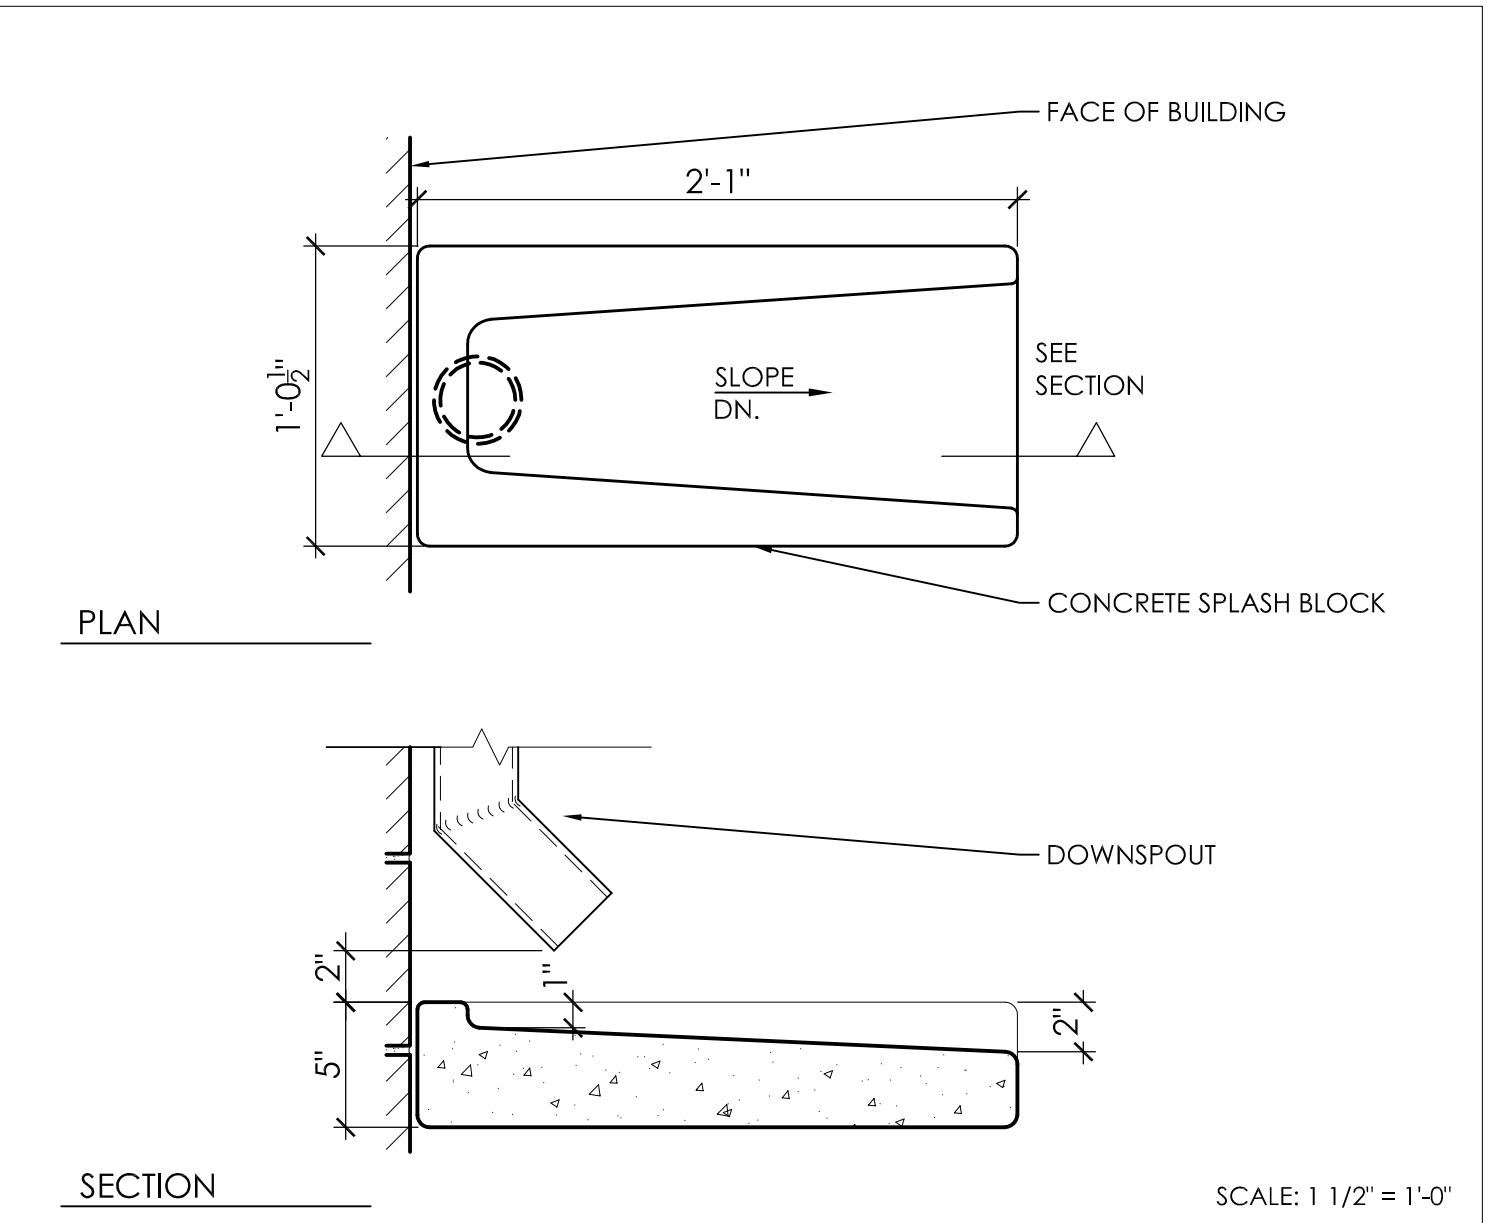


3 SPLASH BLOCK DETAIL

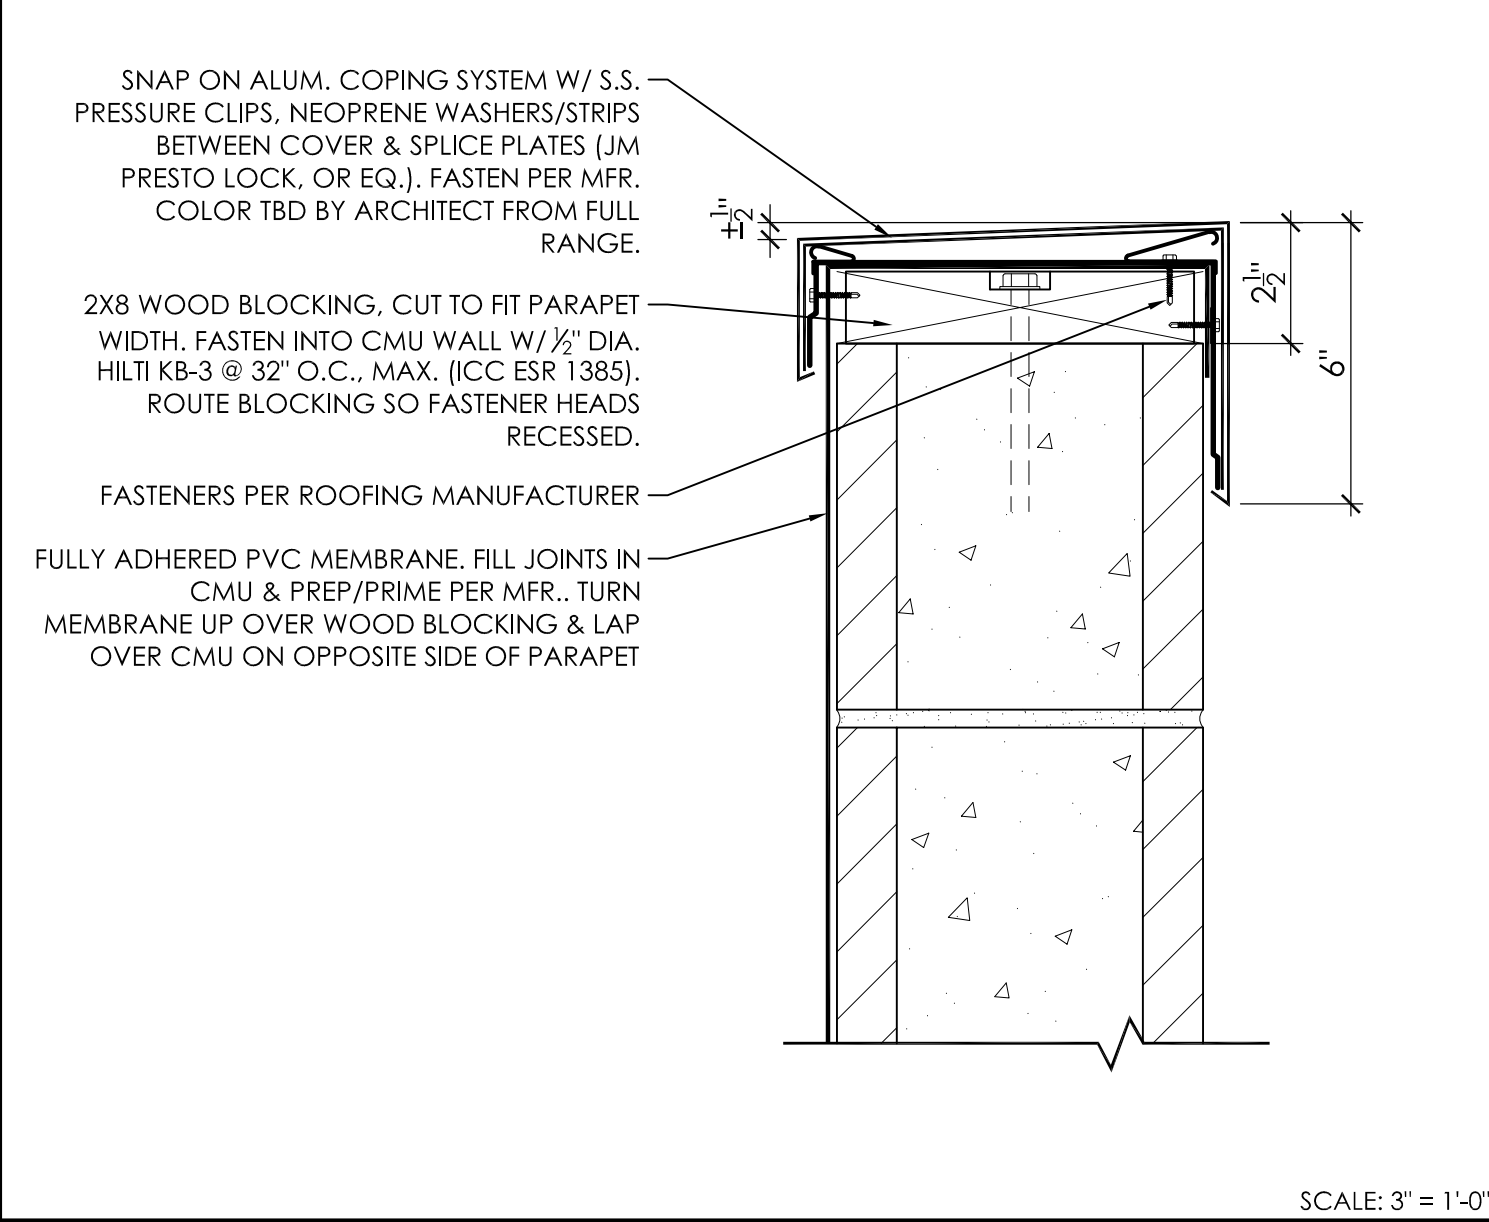

4 PARAPET COPING

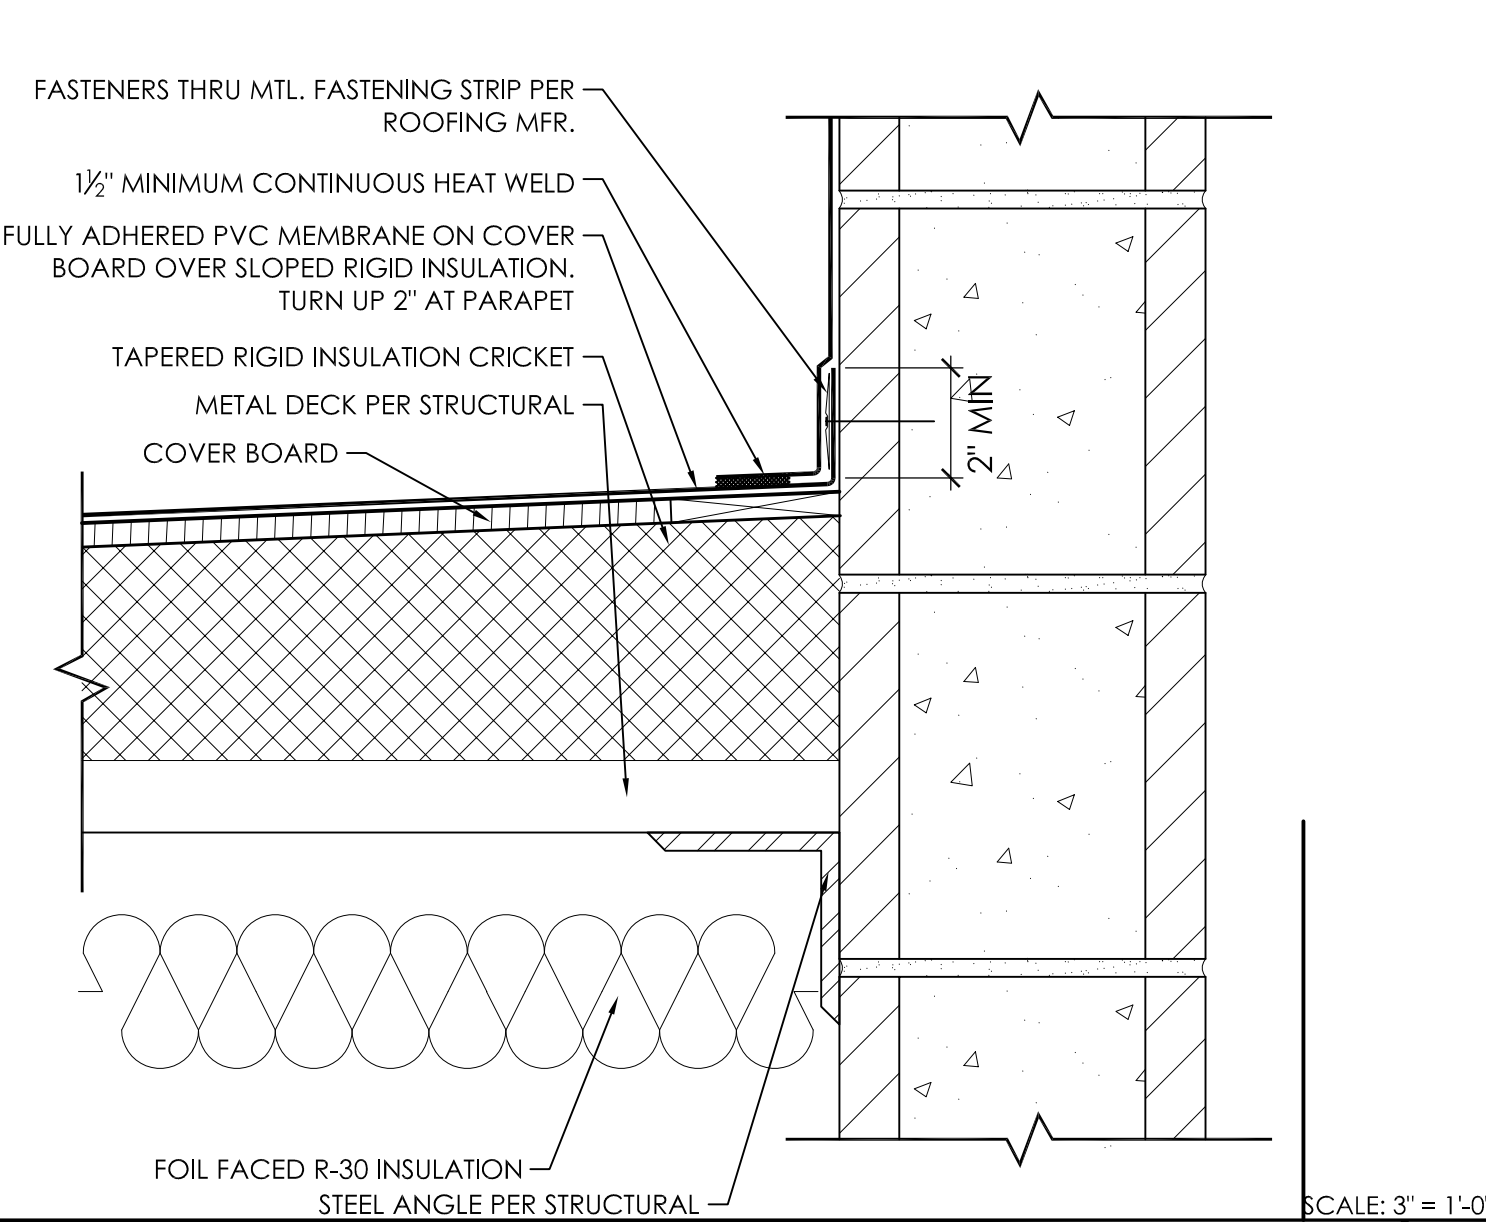


5 PARAPET BASE DETAIL

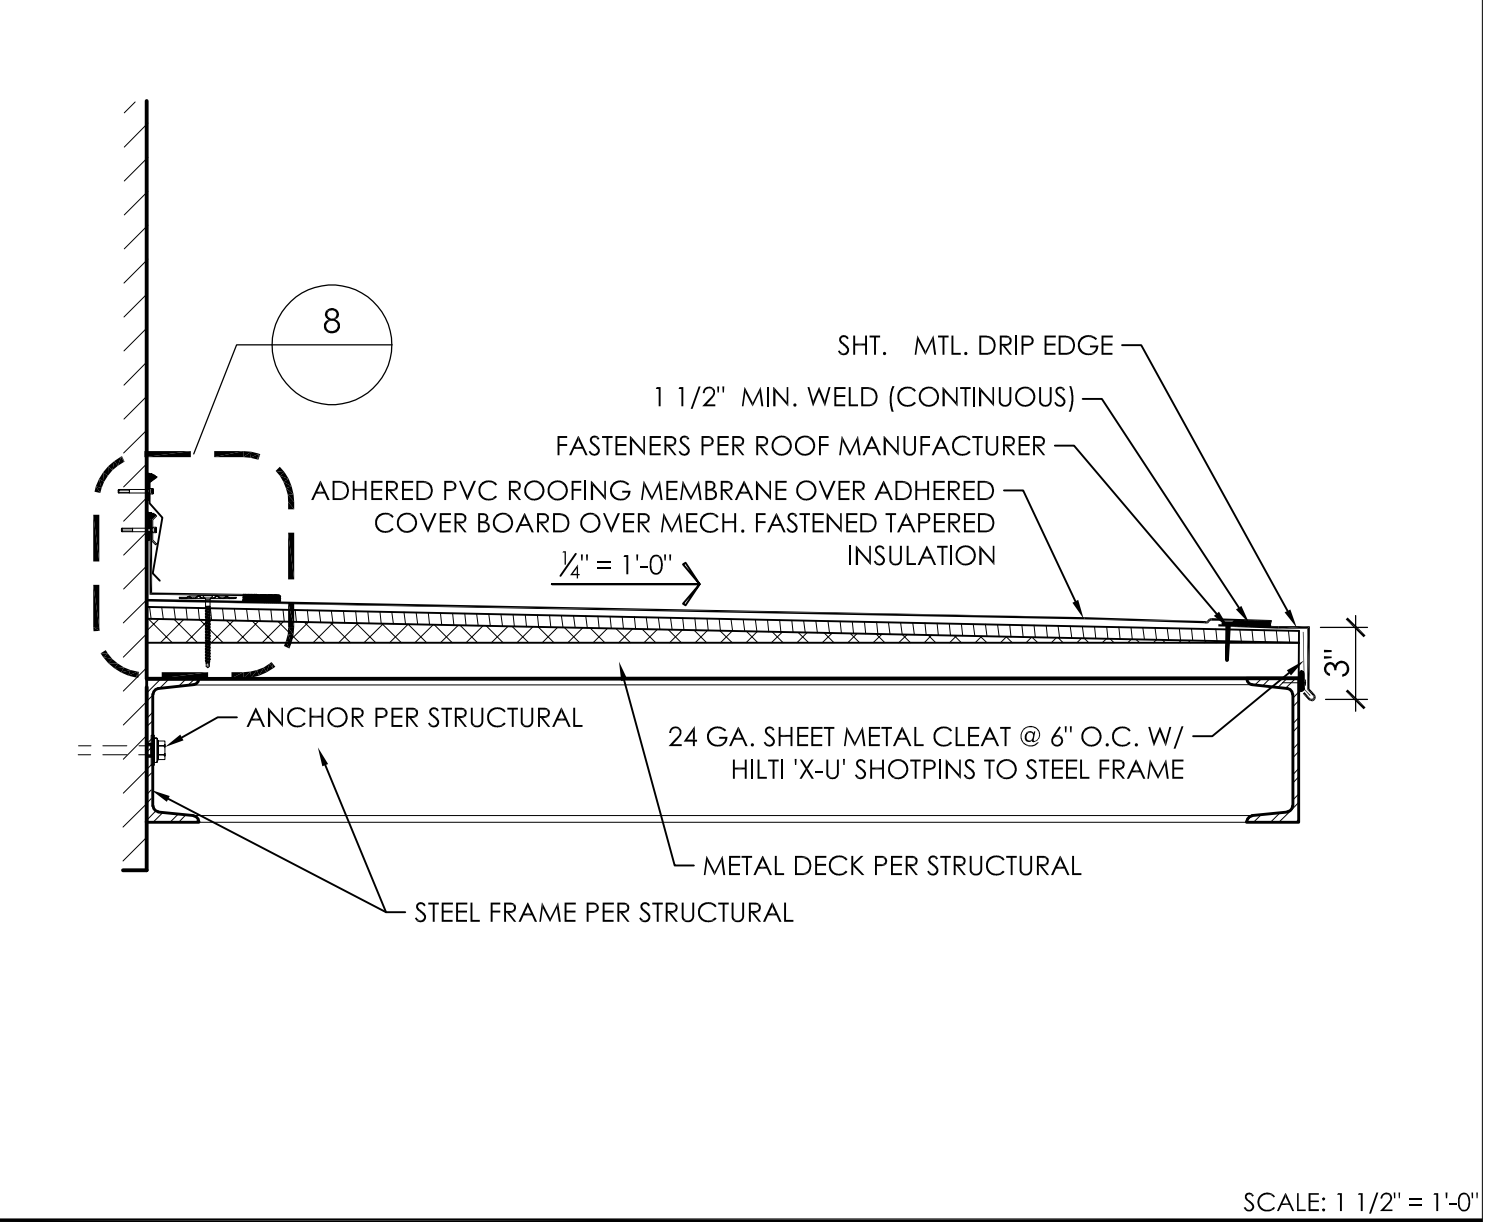

6 OVERHANG DETAIL

- KEYNOTES**
- 1 SCUPPER OPENING PER DETAIL 2 THIS SHEET
 - 2 OVERFLOW OPENING PER DETAIL 2 THIS SHEET, SIMILAR
 - 3 CONDUCTOR HEAD & DOWNSPOUT PER DETAILS 2,3,&4 THIS SHEET
 - 4 ALUMINUM COPING SYSTEM PER DETAIL 5 THIS SHEET
 - 5 CRICKET
 - 6 OVERHANG

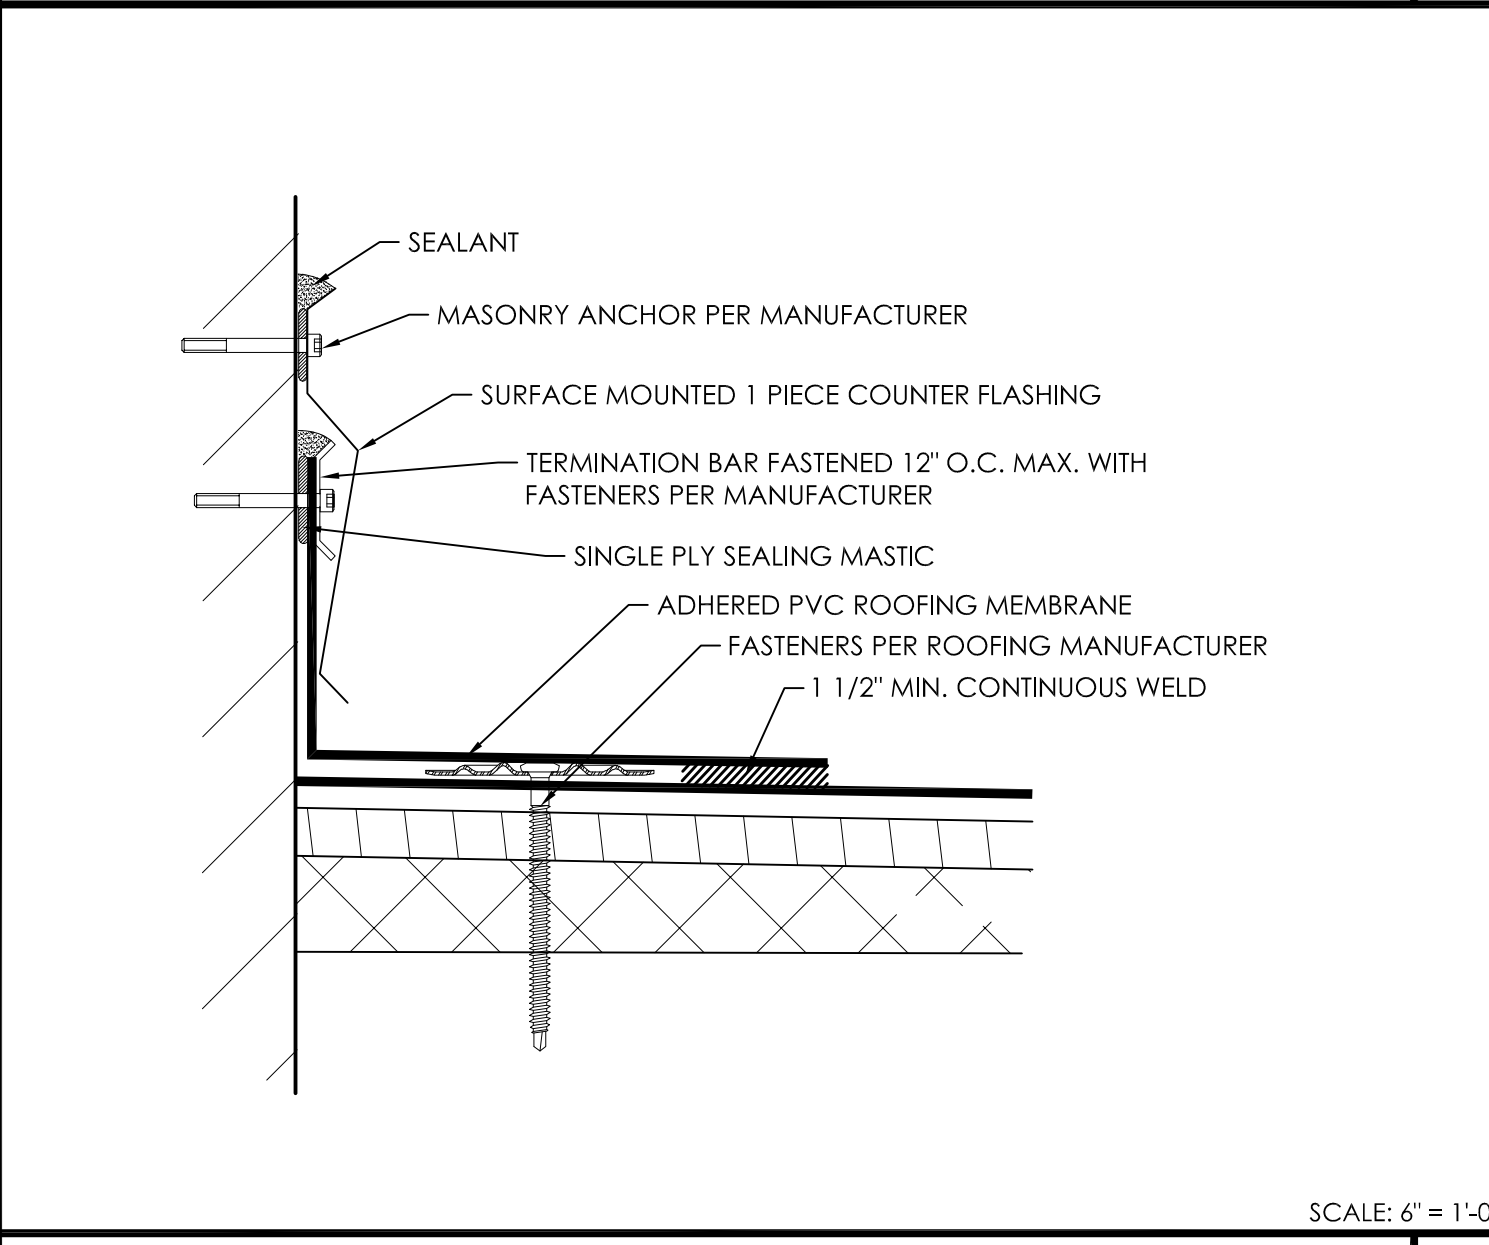

7 OVERHANG @ WALL



8 OVERHANG @ WALL

ROOF PLAN

BENCHMARK:
 NATIONAL GEODEIC SURVEY BENCHMARK NO. 10 1311
 1.4 MILES WEST OF BEAUMONT ON INTERSTATE 10 TO SAN TIMOTEO CANYON NEAR FRONTAGE ROAD ON (SOUTH) WEST SIDE OF INTERSTATE 10, 0.1 MILES SOUTHWEST ALONG FRONTAGE ROAD, SOUTH ACROSS THE ROAD FROM A GUY POLE 25.9 FEET SOUTH OF THE CENTERLINE OF FRONTAGE ROAD, 1.8 FEET WEST OF POWERPOLE AND 1.5 FEET EAST OF A WITNESS POST, INSIDE A 4 INCH PVC PIPE WITH SCREEN PLUS 1 INCH ABOVE GROUND (ELEVATION = 2468.07). ALSO SHOWN ON "HIGHWAY 60 / POTRERO BLVD. INTERCHANGE STATIC GPS PROJECT CONTROL DIAGRAM" AND IDENTIFIED THEREON AS 3508 BM 093474 WHEREIN THE PUBLISHED ELEVATION = 2468.07 IS CORRECTED WITH A MEASURED ELEVATION = 2468.01, USED HEREON.
 ELEV. 2468.01, (NVD '88), (STAMPED Q 1311 1978)

BY	MARK	DESCRIPTION	APPR.	DATE
ENGINEER		REVISIONS		CITY

Platt/Whitelaw Architects, Inc.
 4034 30TH STREET
 SAN DIEGO, CALIFORNIA 92104

NAVEEN WAREY AIA

DESIGN BY: SLM
 DRAWN BY: RC/SW
 CHECKED BY: TW/SS
 SCALE: DATE: JOB NUMBER: 195284001

Reviewed By: _____ Date: _____
 Staff Engineer

Recommended for Approval By: *[Signature]* Date: 11/19/2021
 Administrative Engineer

Approved By: *[Signature]* Date: 11/23/2021
 City Engineer/Director of Public Works

CITY OF BEAUMONT, PUBLIC WORKS DEPARTMENT
 ENGINEERING DIVISION

550E. 6th St
 Beaumont, CA 92223
 TEL: (951) 769-8520 FAX: (951) 769-8526

CITY OF BEAUMONT, CALIFORNIA
 IMPROVEMENT PLANS FOR:
 BEAUMONT CROSSROADS
 LIFT STATION

ROOF DETAILS

38 OF 38 SHEETS
 FILE NO: 3387

Plotted By: Kevon Sheet Sht: BEAUMONT LIFT STATION Layout: A2 Roof Details August 12, 2021 12:30:57pm J:\0811 Beaumont Lift Station\03-Drawing\Beaumont Lift Station\Sheets\A2 Roof Details.dwg