


Approved SP - Per Development Agreement				
Designation	PA	Acreage	Unit Count	Density
MDR	20A	37.7	127	3.4
MHDR	20B	24.5	125	5.1
MDR	20C	47.6	164	3.4
Totals		109.8	416	4.0

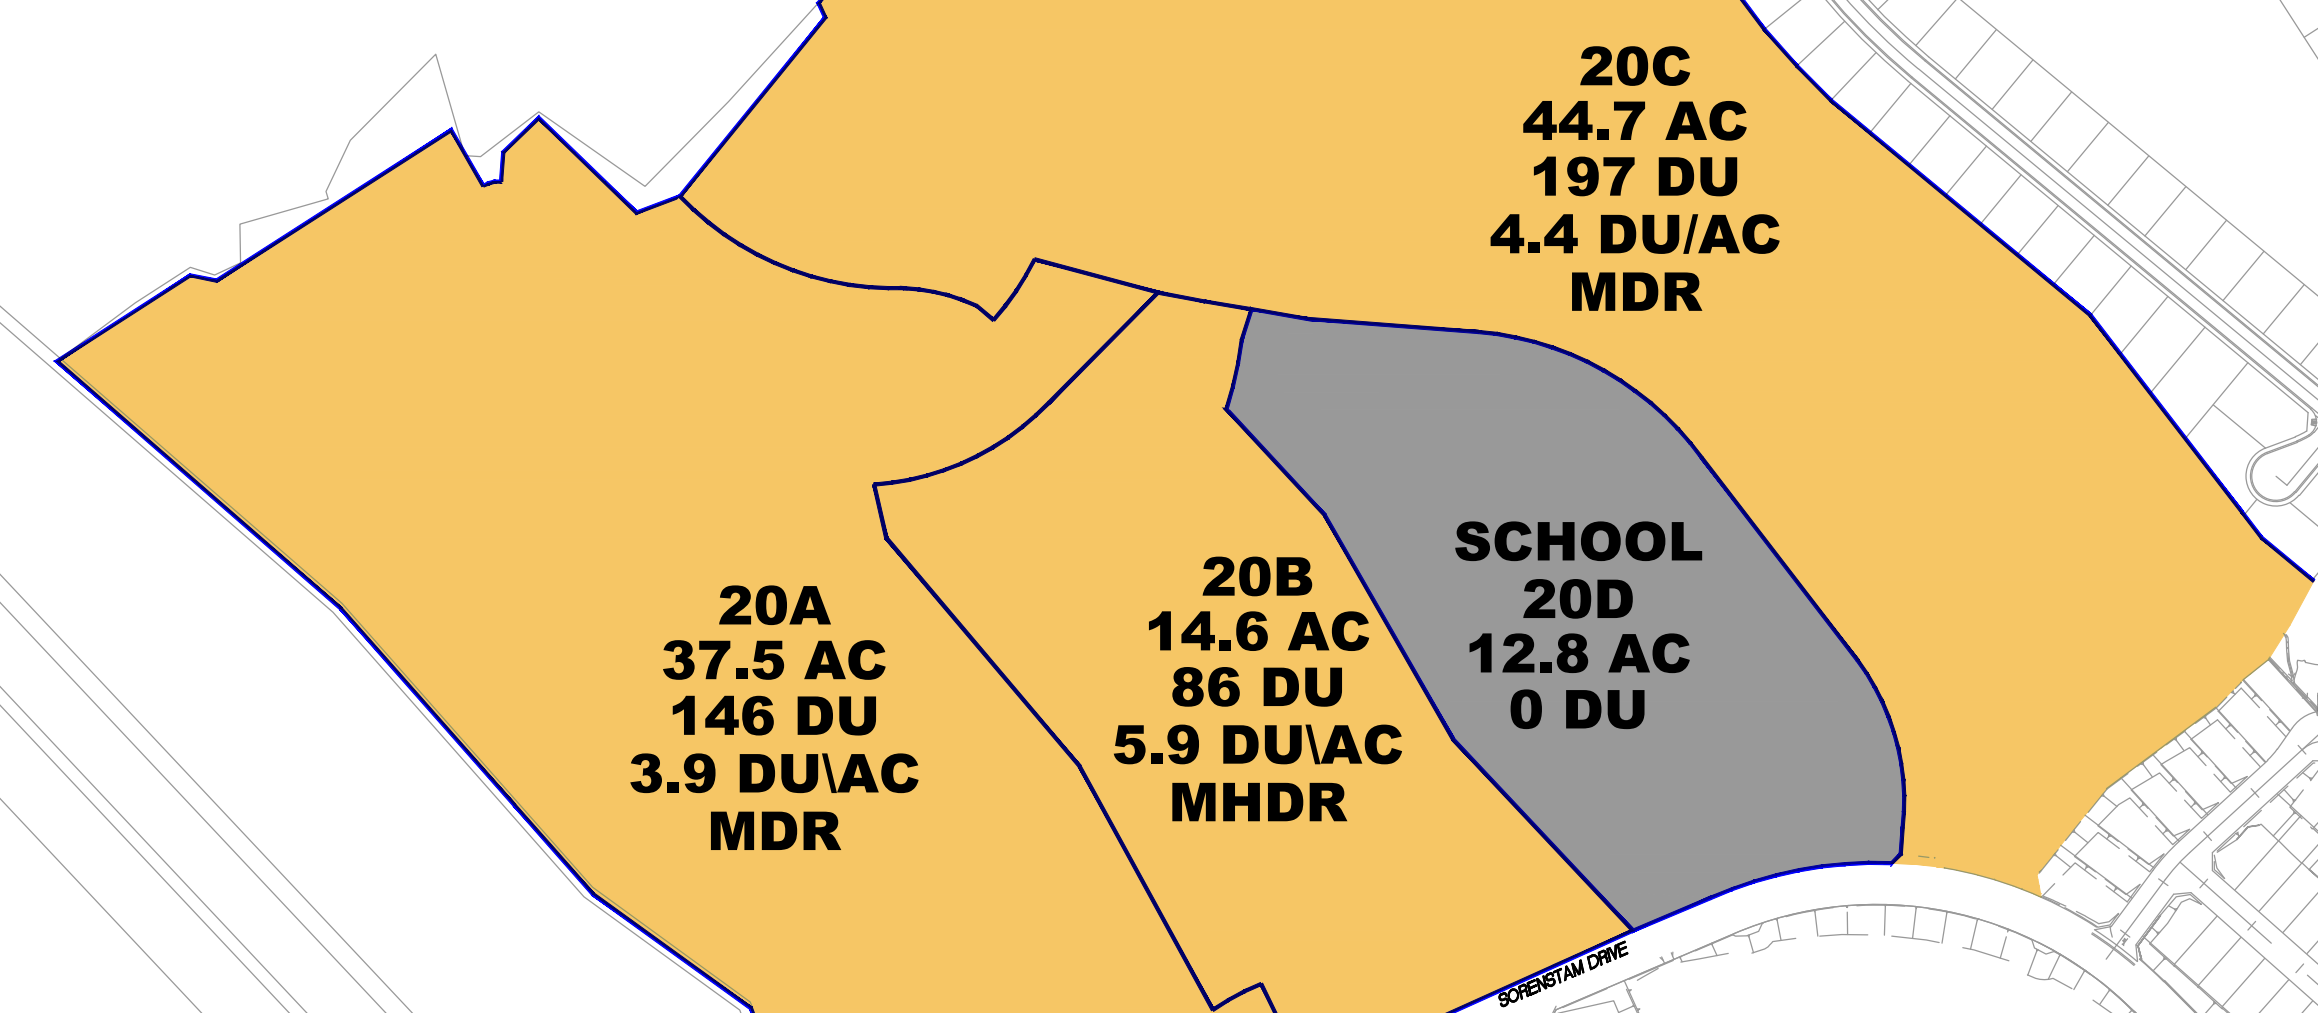

Proposed SPA				
Designation	PA	PA Acreage	Unit Count	Density
MDR	20A	37.5	146	3.9
MHDR	20B	14.6	86	5.9
MDR	20C	44.7	197	4.4
School	20D	12.8	0	0
Totals		109.6	429	4.7

APPROVED PLANNING AREAS

PROPOSED PLANNING AREAS

FAIRWAY CANYON PA-20 APPROVED VS PROPOSED EXHIBIT

