


Approved SP - Per Development Agreement				
Designation	PA	Acreage	Unit Count	Density
MDR	20A	37.7	127	3.4
MHDR	20B	24.5	125	5.1
MDR	20C	47.6	164	3.4
<b>Totals</b>		<b>109.8</b>	<b>416</b>	<b>4.0</b>

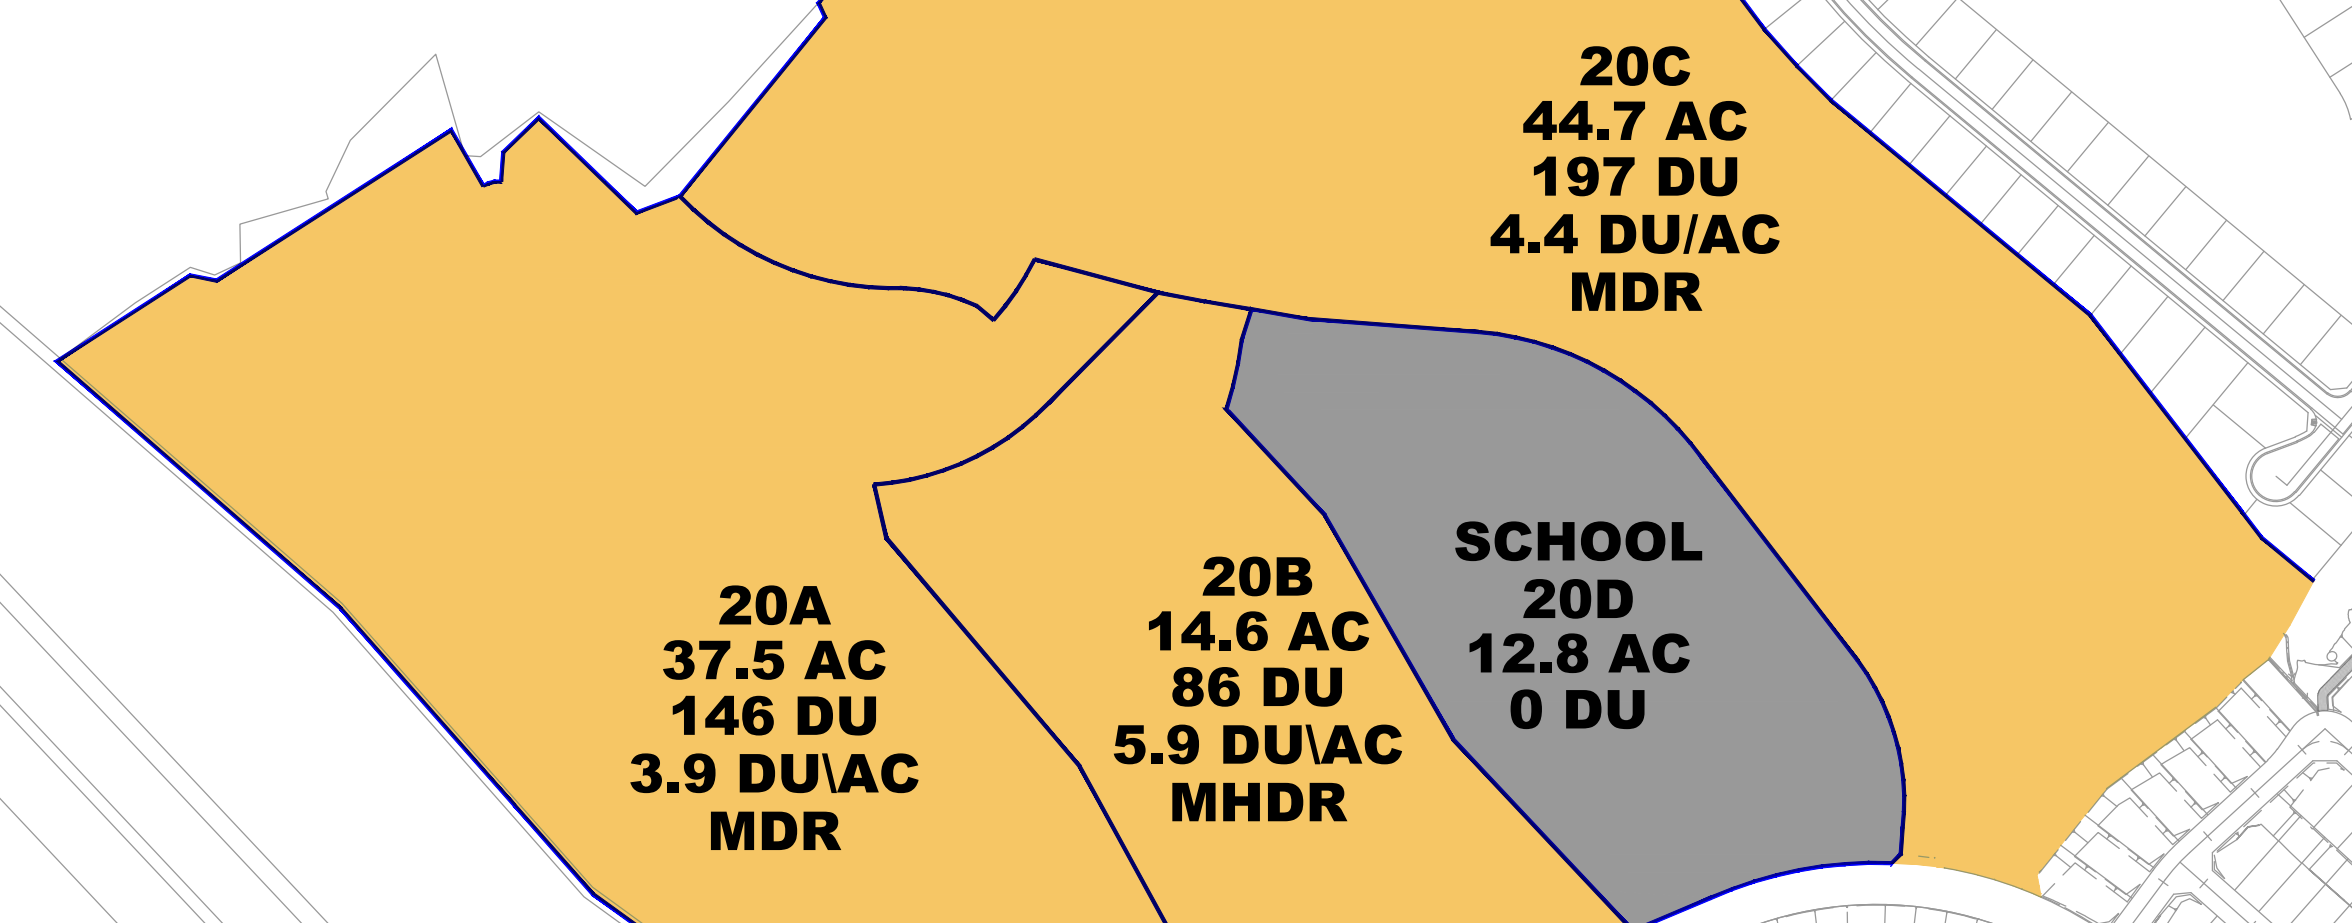

Proposed SPA				
Designation	PA	PA Acreage	Unit Count	Density
MDR	20A	37.5	146	3.9
MHDR	20B	14.6	86	5.9
MDR	20C	44.7	197	4.4
School	20D	12.8	0	0
<b>Totals</b>		<b>109.6</b>	<b>429</b>	<b>4.7</b>

APPROVED PLANNING AREAS

PROPOSED PLANNING AREAS

# FAIRWAY CANYON PA-20 APPROVED VS PROPOSED EXHIBIT

